




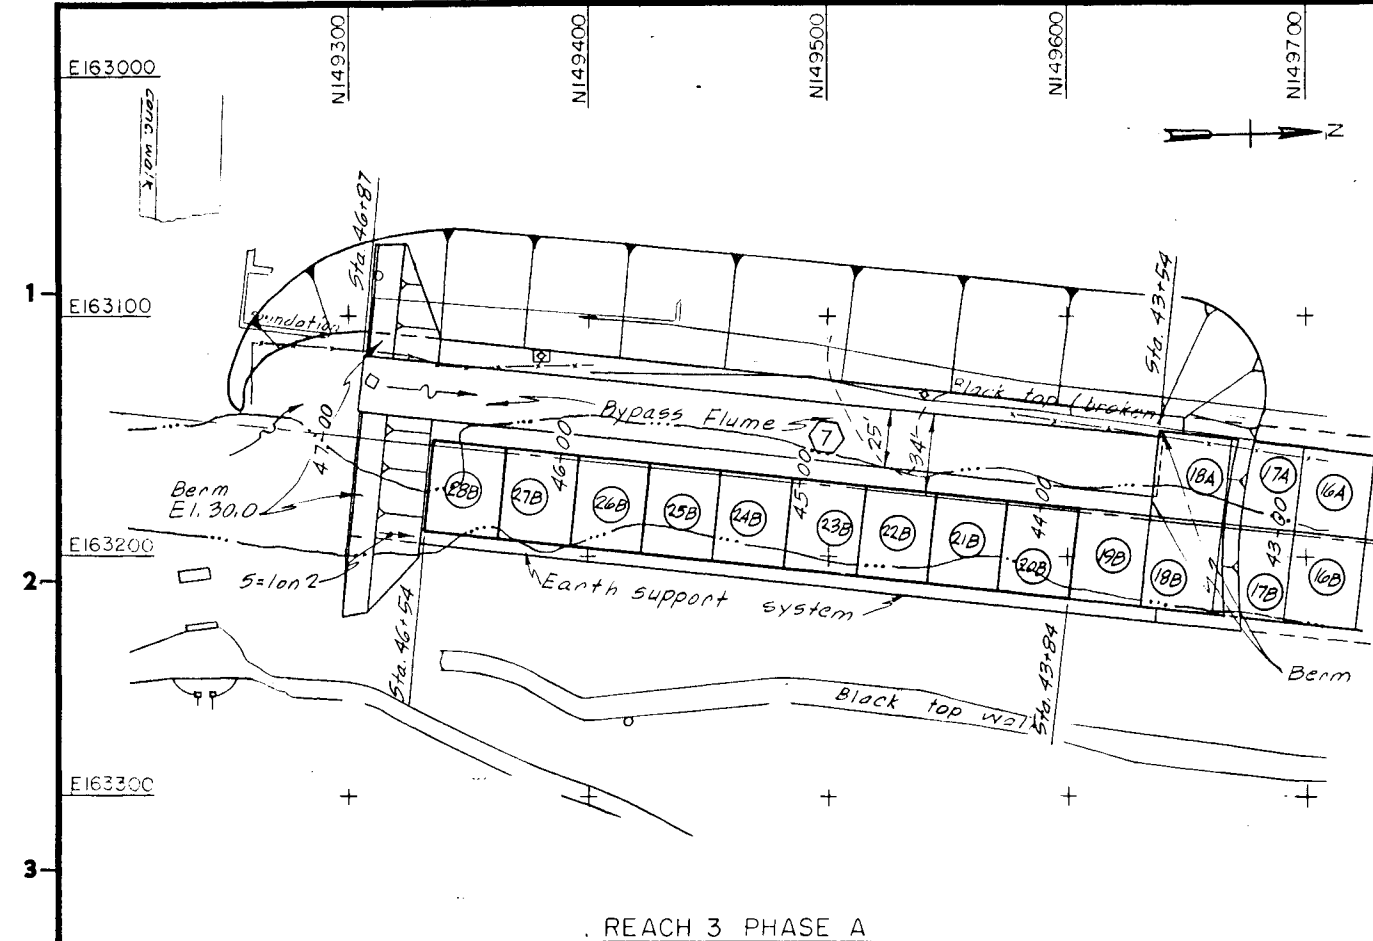


REACH 3 PHASE A

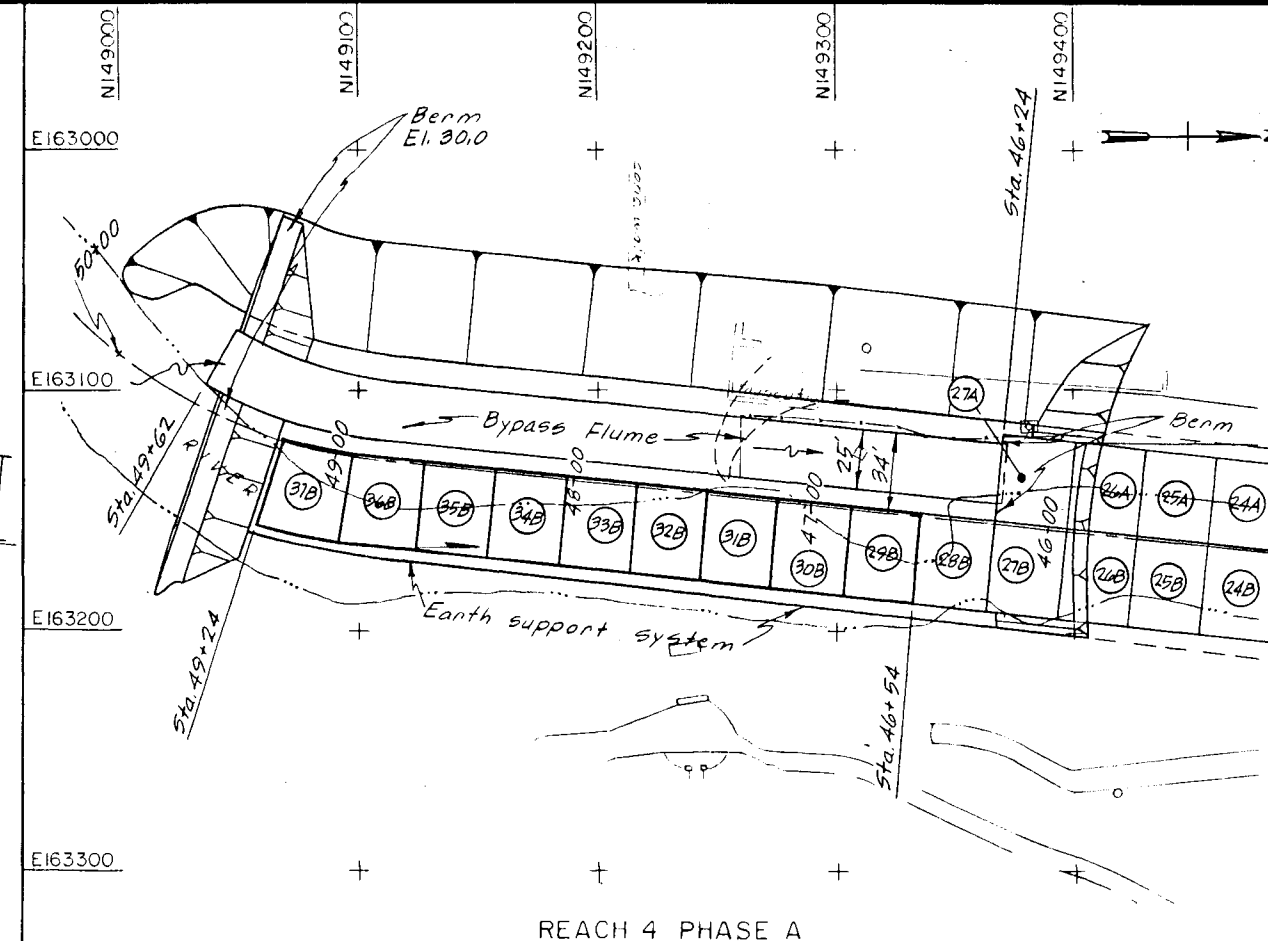


REACH 4 PHASE A

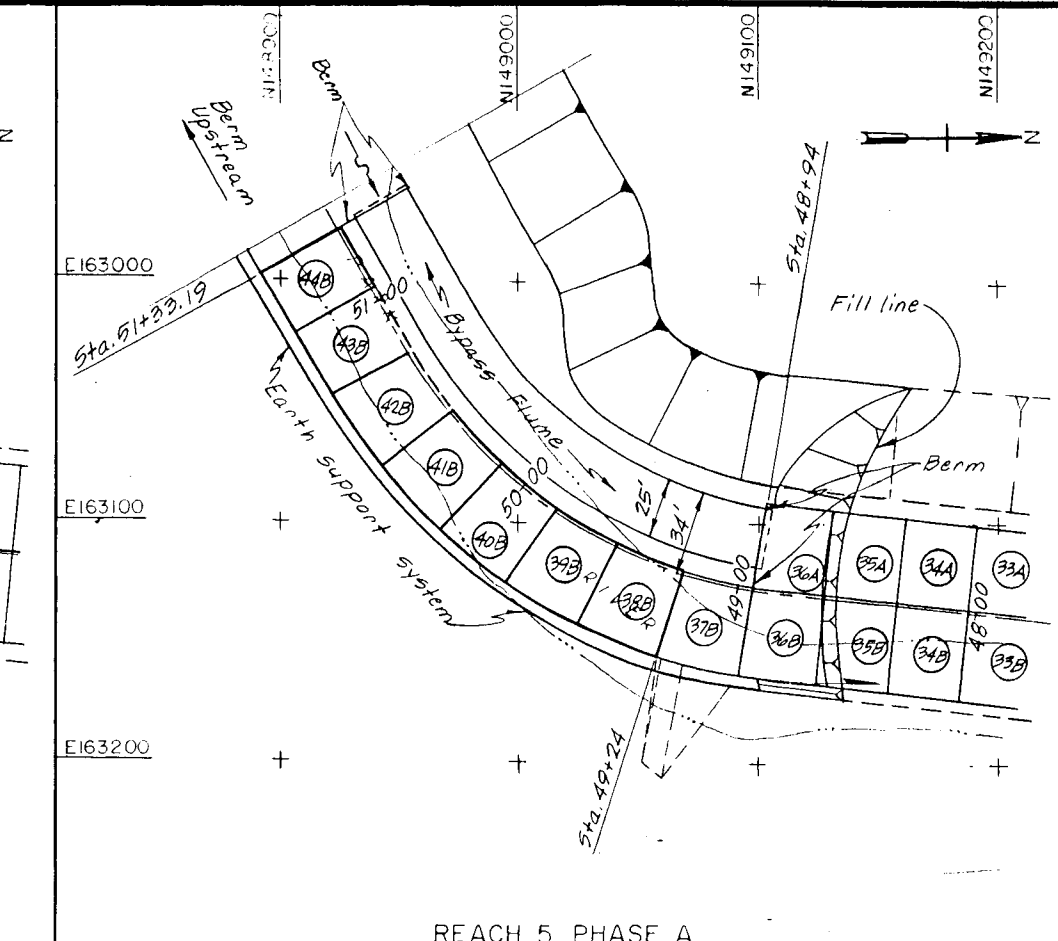


REACH 5 PHASE A

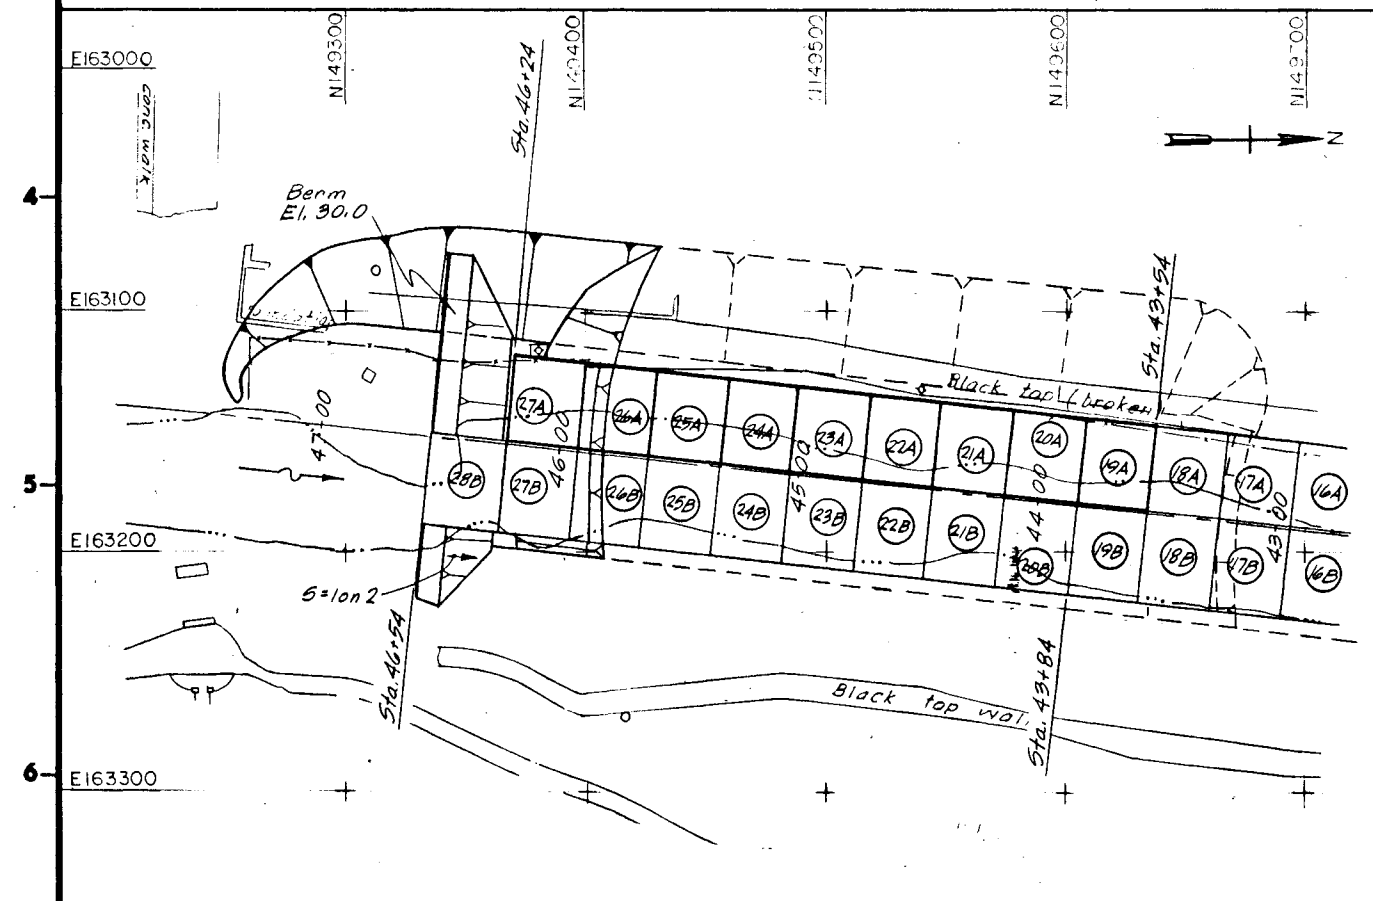


REACH 3 PHASE B

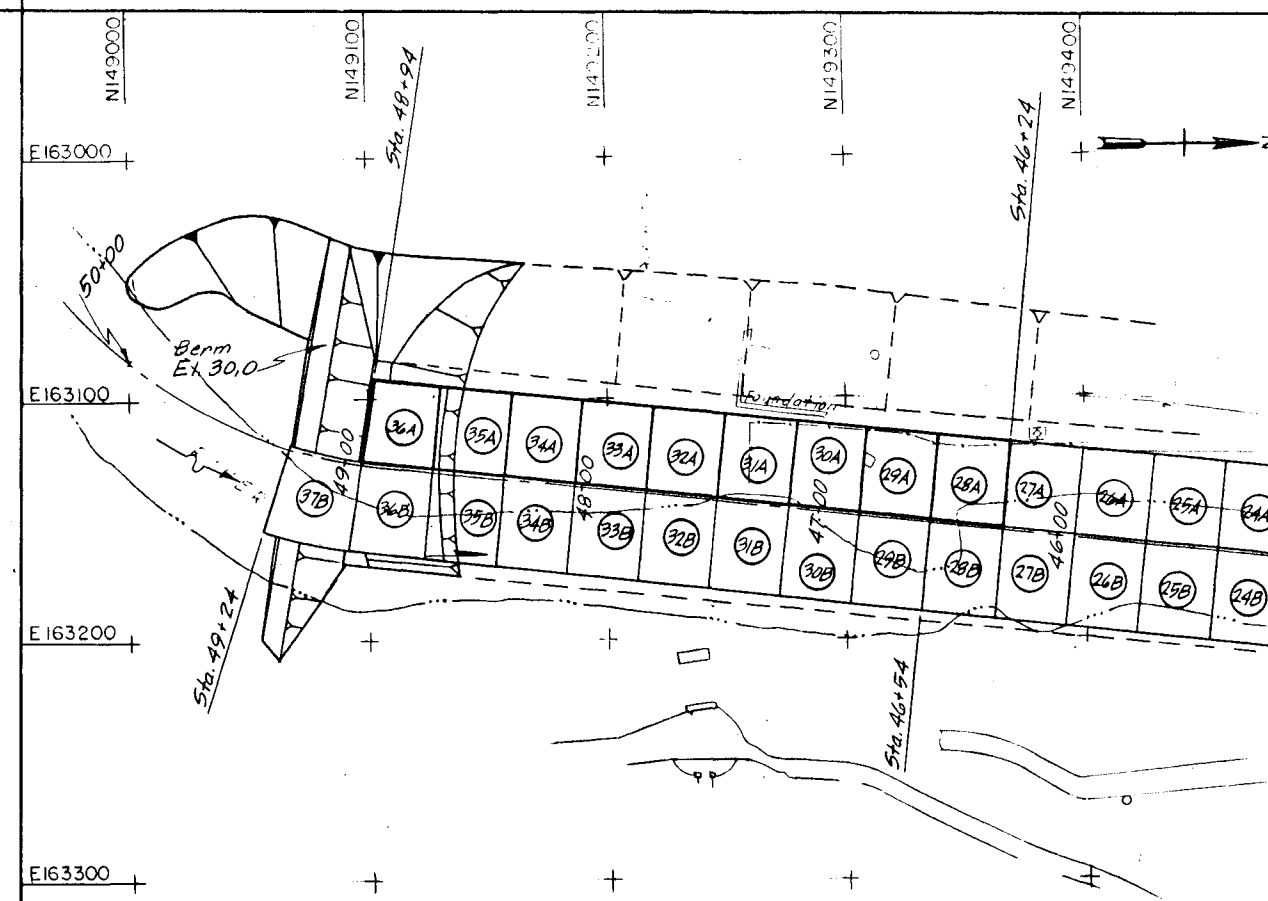

REACH 4 PHASE B

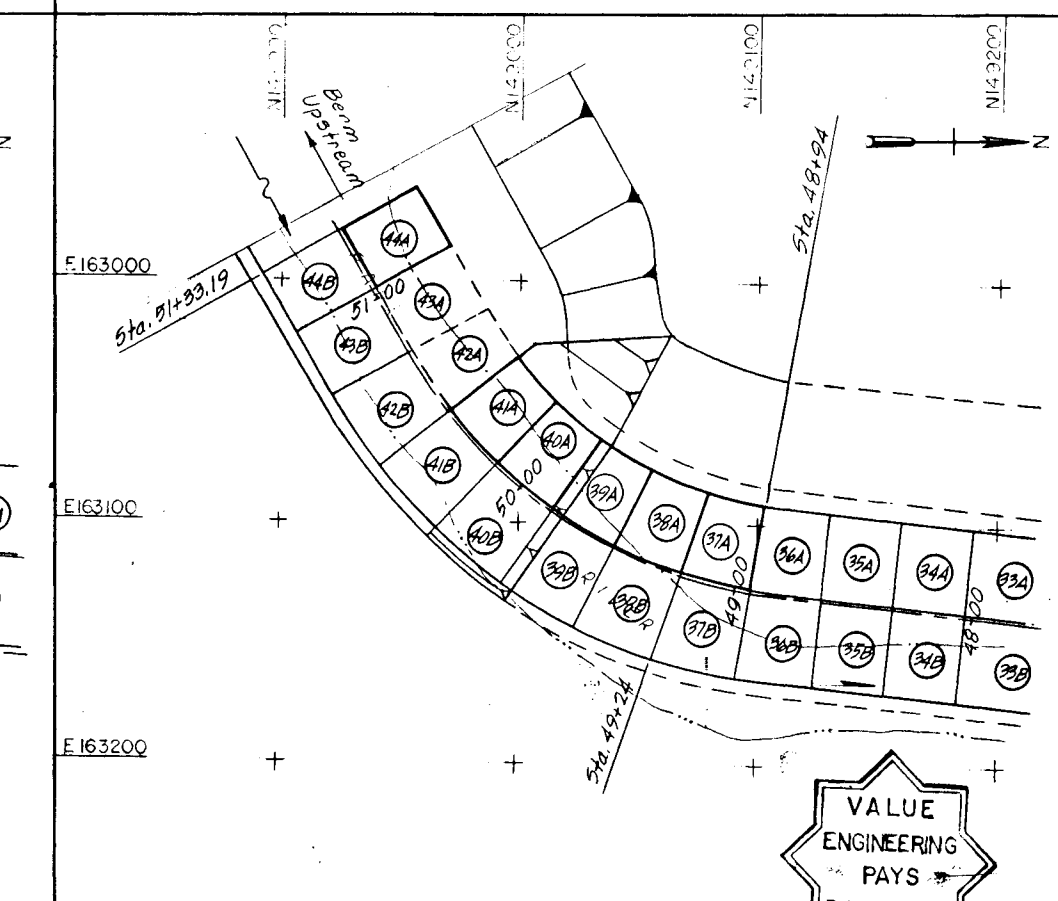

REACH 5 PHASE B

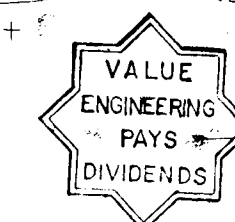

REACH 3 PHASE A

1. Install earth support system along right side of conduit.
2. Excavate for and install flume left side of conduit.
3. Install berms and divert river through flume.
4. Excavate for and construct Monoliths No. 20B thru 28B.

REACH 3 PHASE B

1. Remove berm right side and install berm left side and force river through completed barrel.
2. Remove by-pass flume.
3. Excavate for and construct Monoliths No. 19A thru 27A.
4. Remove berms and allow river to flow through completed conduit.

REACH 4 PHASE A

1. Install earth support system along right side of conduit.
2. Excavate for and install flume left side of conduit.
3. Install berms and divert river through flume.
4. Excavate for and construct Monoliths No. 29B thru 37B.

REACH 4 PHASE B

1. Remove berm right side and install berm left side and force river through completed barrel.
2. Remove by-pass flume.
3. Excavate for and construct Monoliths No. 28A thru 36A.
4. Remove berms and allow river to flow through completed conduit.

PLANS

SCALE: 1" = 40'

REACH 5 PHASE A

1. Install earth support system along right side of conduit.
2. Excavate for and install flume left side of conduit to Junction structure.
3. Install berms and divert river from Junction structure through flume.
4. Excavate for and construct Monoliths No. 38B thru 44B, except upper portion of centerline of Monoliths No. 42B and 43B.

REACH 5 PHASE B


1. Remove berm right side and install berm left side and force river through completed barrel.
2. Remove by-pass flume.
3. Excavate for and construct Monoliths No. 37A thru 44A, except side walls of Monoliths No. 42A and 43A.
4. Remove berms and allow river to flow through completed conduit.

NOTES:

1. For General Notes see Sheet 2.
2. For Typ. Conduit Sects see Sheets 26 thru 31.
3. For Grading Plan see Sheets 34 and 35.
4. For Diversion of Water for Junction structure see sheet 44.
5. Description of phases are looking downstream.
6. For Typ. Diversion Sects. see Sheet 112.



GRAPHIC SCALES

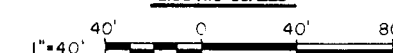

As Built Drawing

Contract No. DACW 33-76-C-0098

REVISION	DATE	DESCRIPTION	BY

DES. BY R.C. L.R.L. ETC.		SUBMITTED CHIEF, LAYOUT SECTION	
APPROVED CHIEF, PROJECT BRANCH		APPROVED CHIEF, ENGINEERING DIVISION	

DEPARTMENT OF THE ARMY NEW ENGLAND DIVISION CORPS OF ENGINEERS WALTHAM, MASS.		WATER RESOURCES DEVELOPMENT PROJECT PARK RIVER LOCAL PROTECTION BOX CONDUIT AT SECTION 4 DIVERSION OF WATER NO. 2	
HARTFORD		CONNECTICUT	
DATE MARCH 1976		DATE MARCH 1976	
SCALE: 1" = 40'		SPEC. NO. DACW 33-76-B-0040	
DRAWING NUMBER PAR - I		SHEET 33	