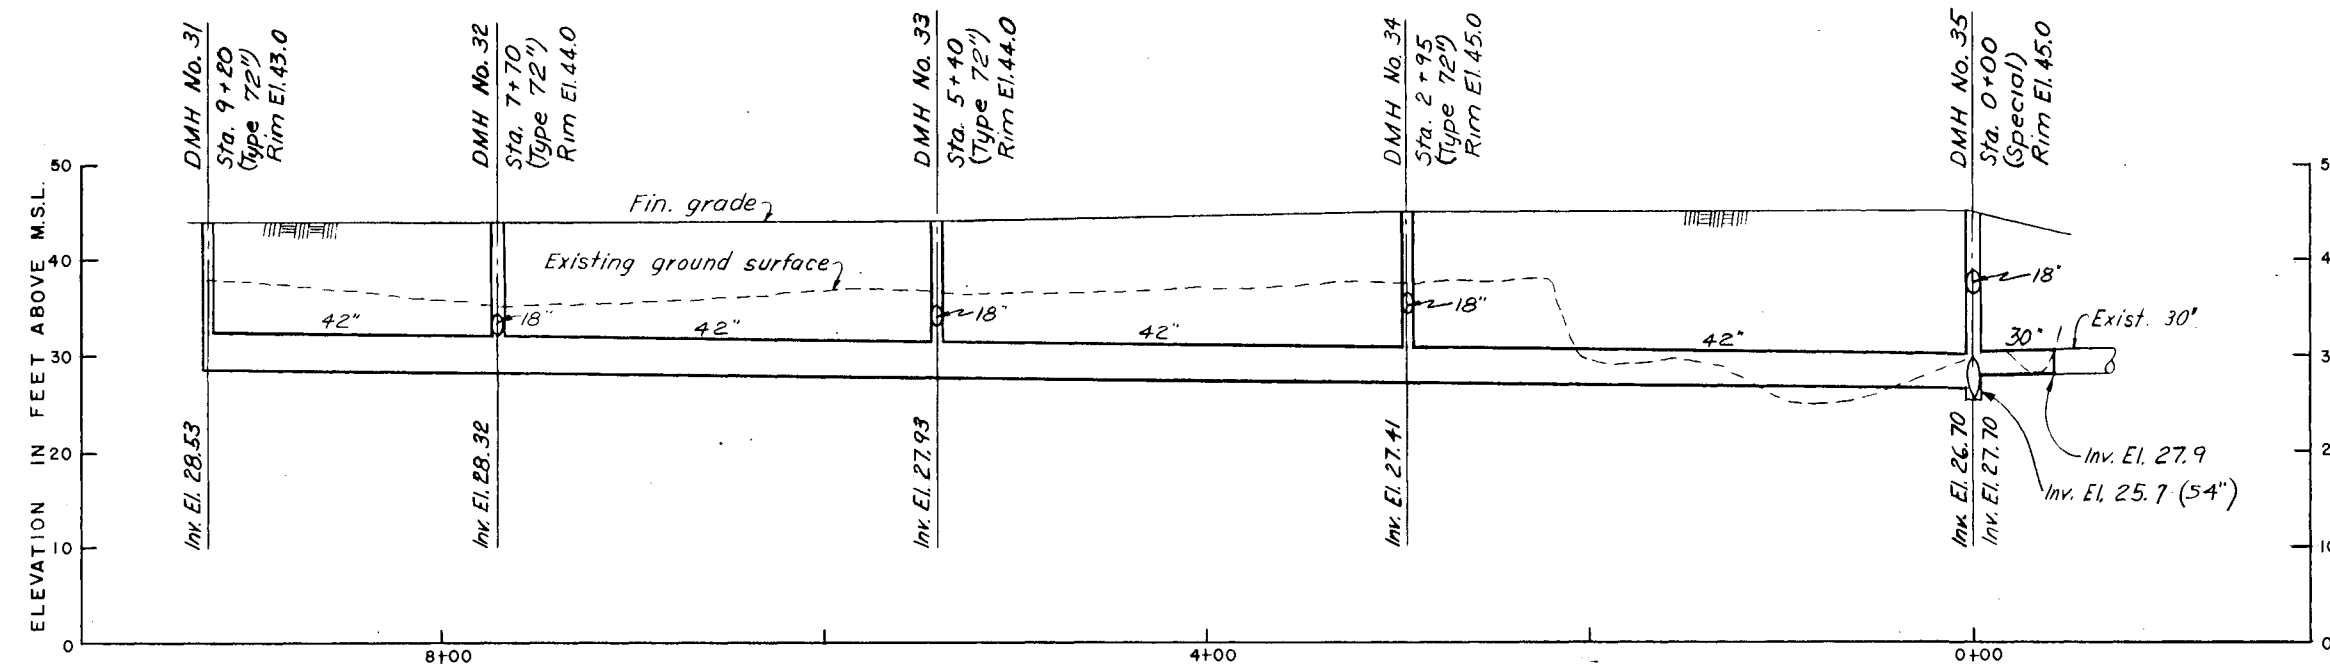
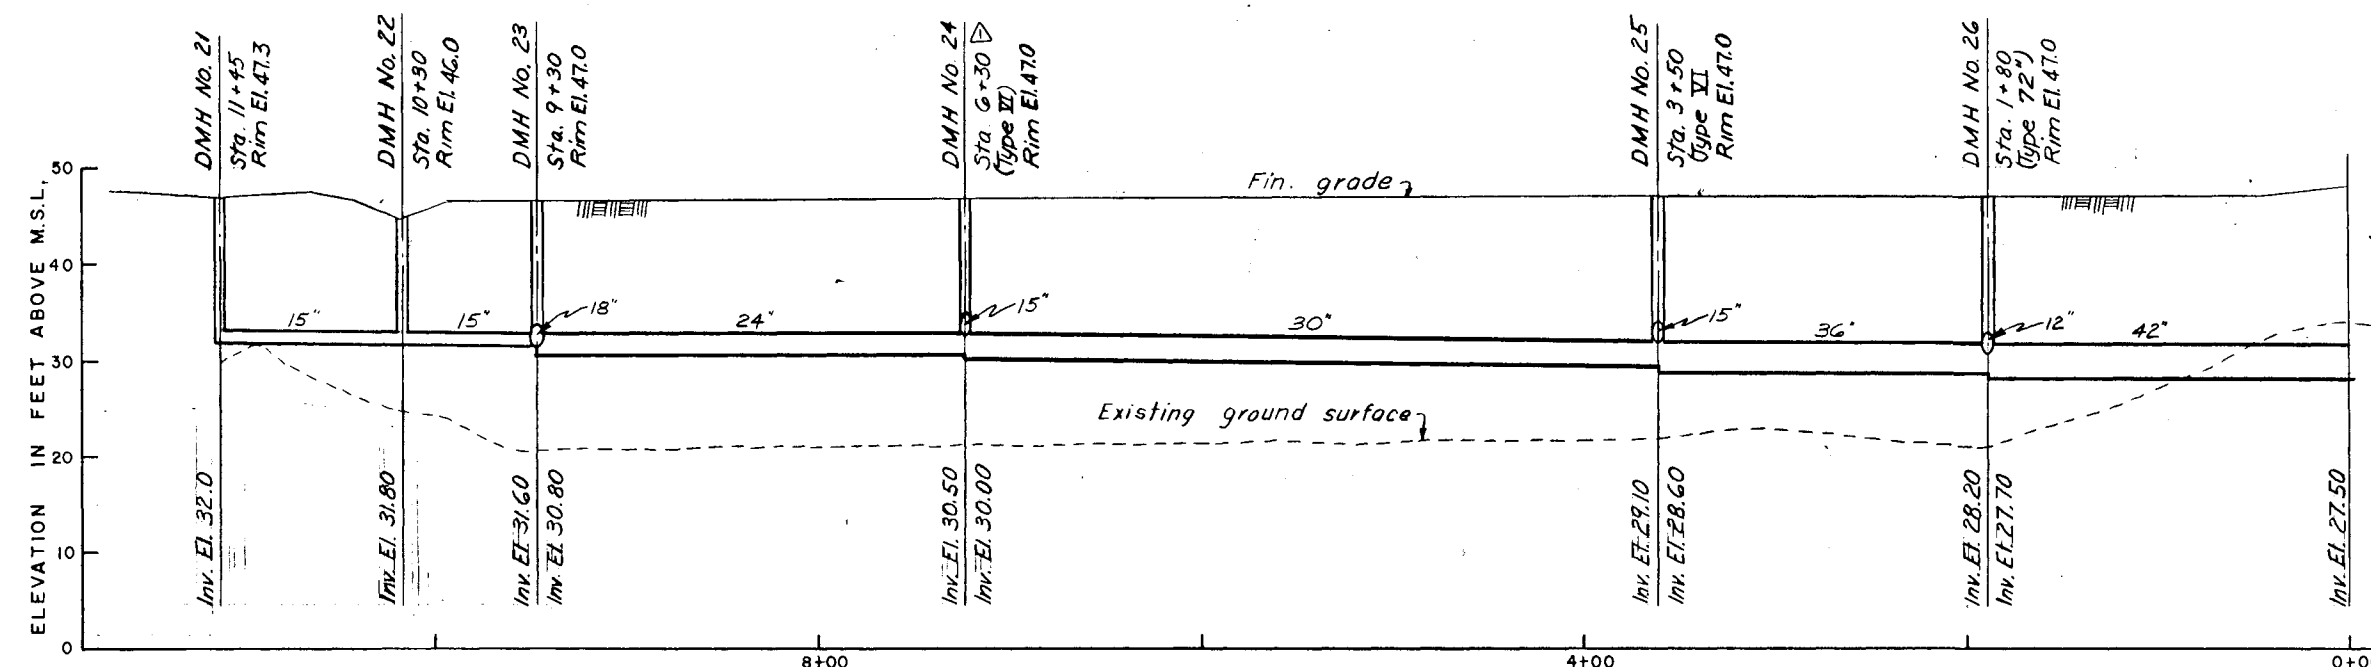
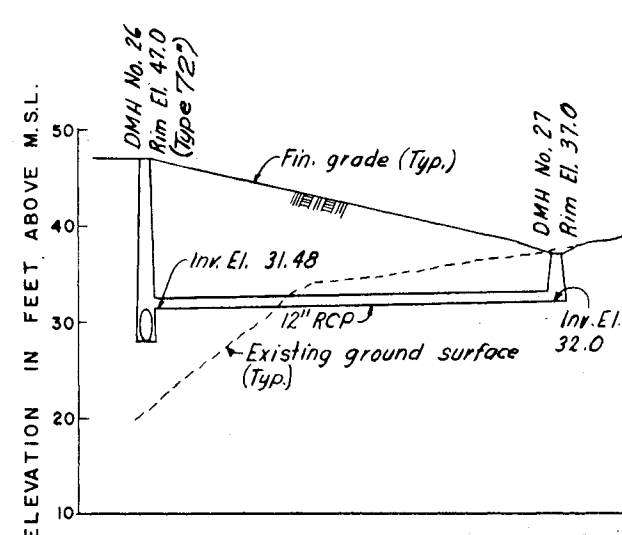




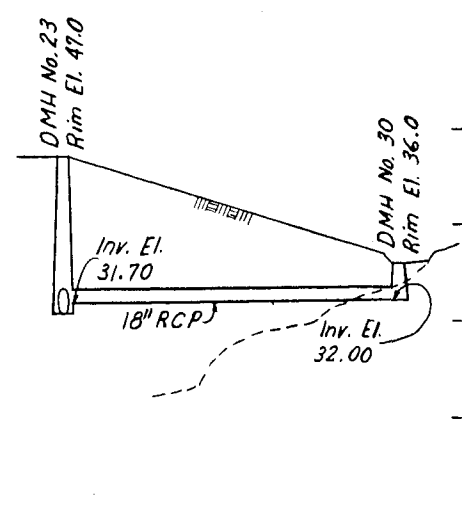
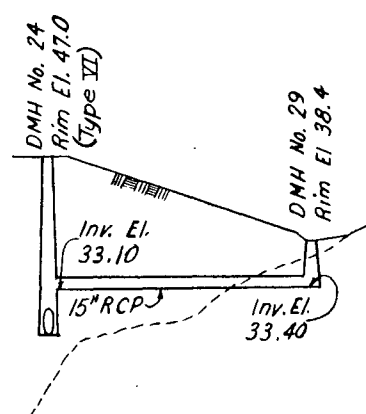
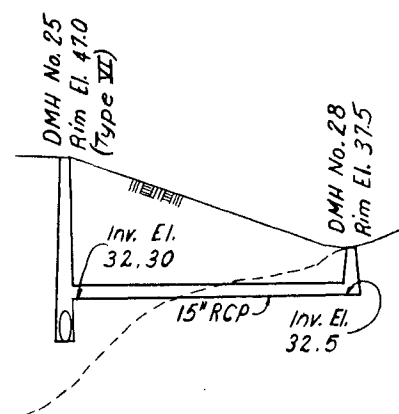
WEST SIDE

SCALE: HOR. 1" = 50'
VERT. 1" = 10'

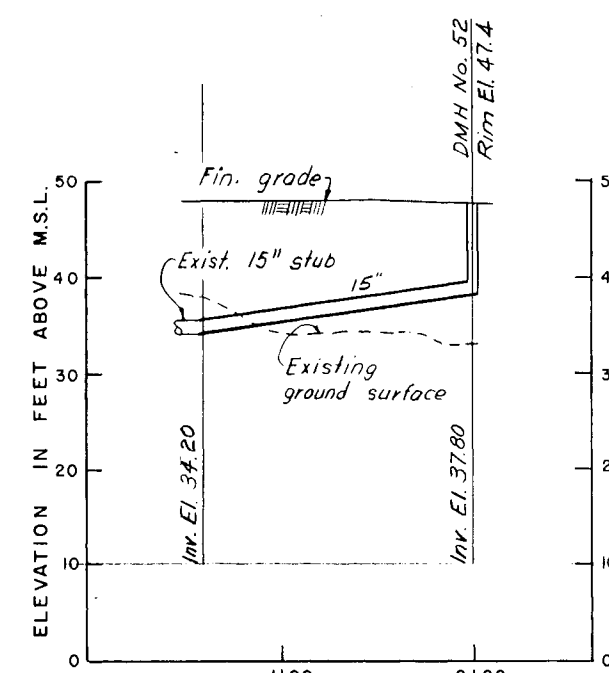
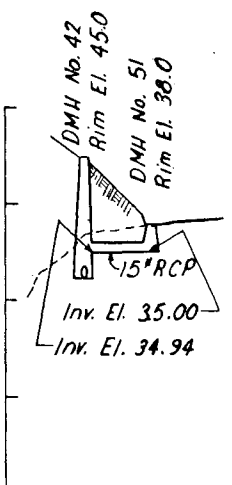
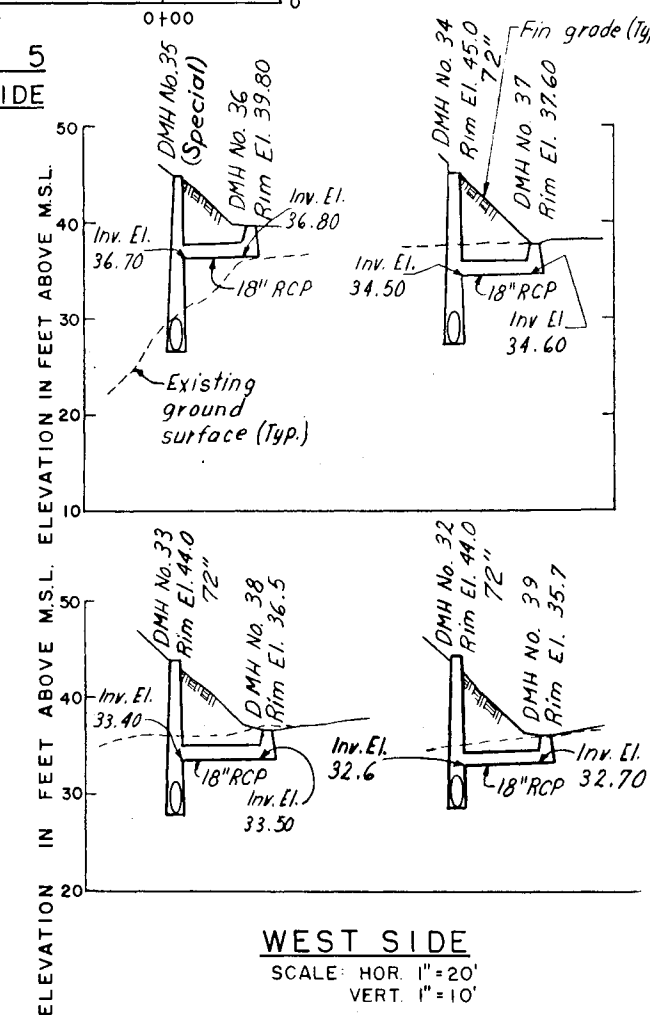
EAST SIDE

SCALE: HOR. 1" = 50'
VERT. 1" = 10'

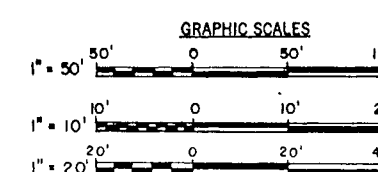
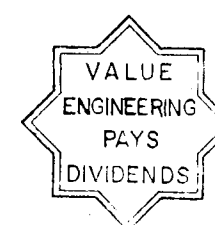
EAST SIDE

SCALE: HOR. 1" = 20'
VERT. 1" = 10'

WEST SIDE

SCALE: HOR. 1" = 20'
VERT. 1" = 10'SECTION 5
SOUTH SIDESCALE: HOR. 1" = 50'
VERT. 1" = 10'

WEST SIDE

SCALE: HOR. 1" = 20'
VERT. 1" = 10'

As Built Drawing

Contract No. DACW 33-76-C-0098

NOTES:

1. For location of low level drains see sheets 34 and 35
2. All manholes shall be Type II unless otherwise noted.
3. Change DMH Nos. 26, 31, 32, 33 & 34 from Type II to 72". Install top slab on 72" base section with opening & 48" risers.

4-4-83		Final field corrections	
REVISION	DATE	DESCRIPTION	BY
1	JUNE 26	Station changed (Am. #1)	W.F.
DEPARTMENT OF THE ARMY NEW ENGLAND DIVISION CORPS OF ENGINEERS WALTHAM, MASS.			
DES. BY W.F.		DR. BY W.F.	
SUBMITTED W.F.		CHECKED W.F.	
APPROVAL W.F.		REVIEWED W.F.	
APPROVED W.F.		APPROVED W.F.	
HARTFORD		CONNECTICUT	
DATE MARCH 1976		DATE MARCH 1976	
SCALE AS SHOWN		SPEC. NO. DACW 33-76-B-0040	
DRAWING NUMBER PAR - I		DRAWING NUMBER PAR - I	
SHEET 36		SHEET 36	