




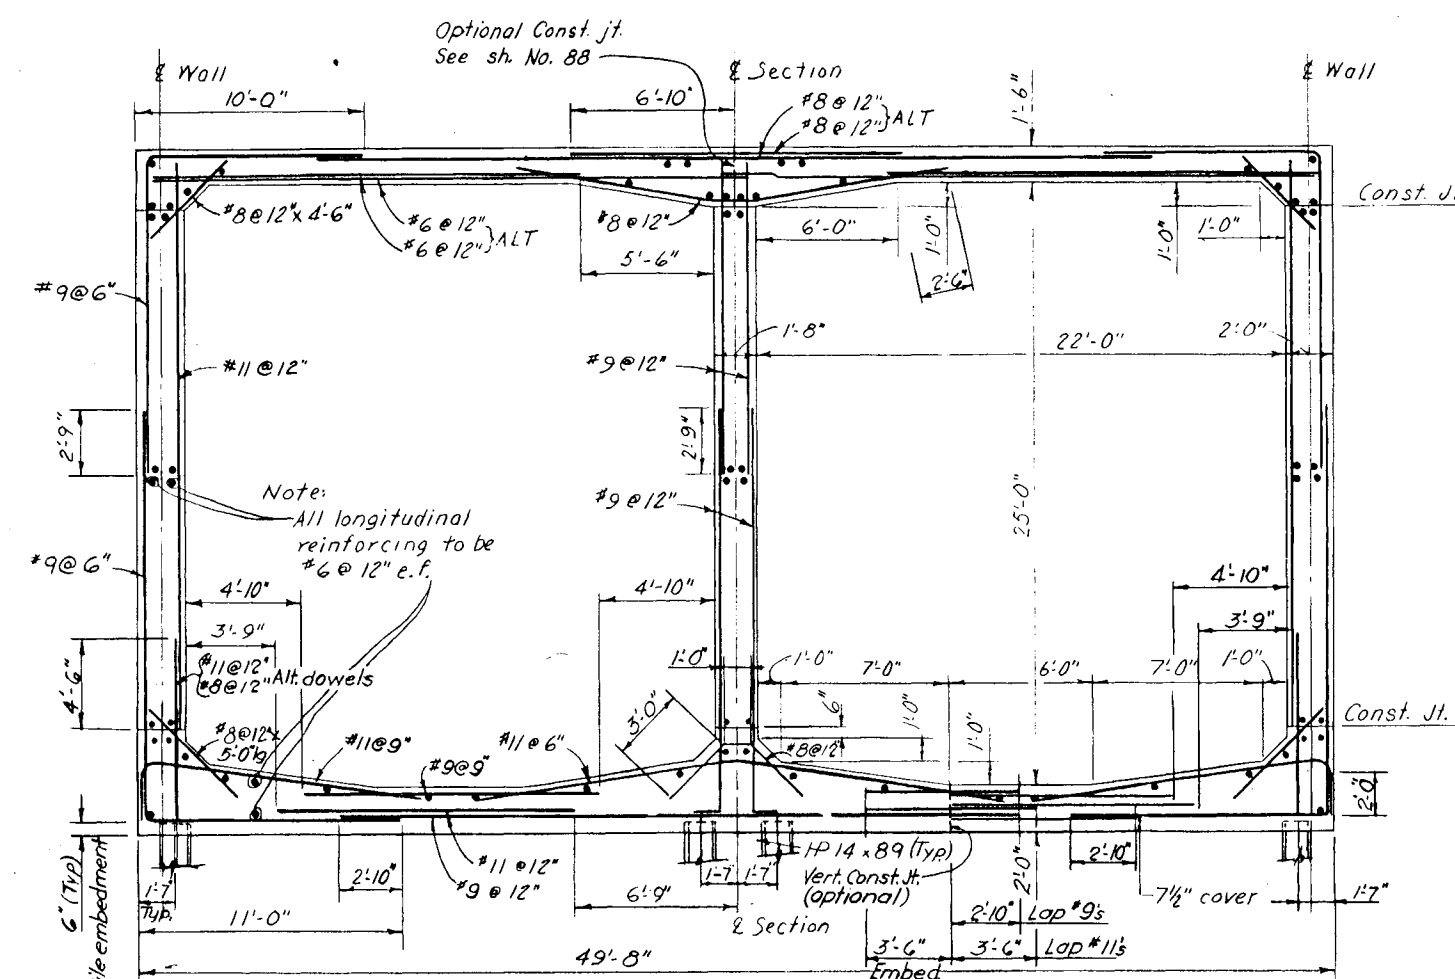


SECTION 7
MON. NO. 1 THRU 35

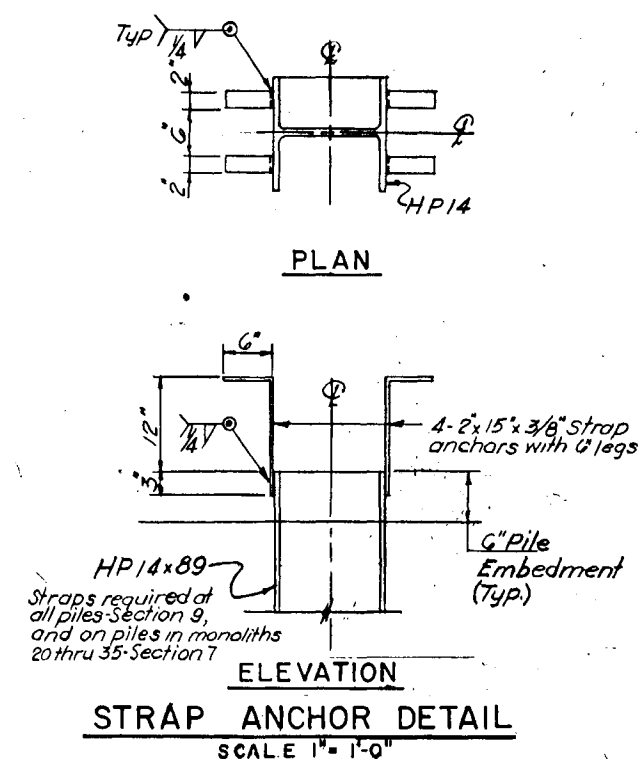

NOTES

1. For general structural notes see Sh. No. 21.
2. For Misc. details see Sh. No. 88
3. For detail of air vent chamber at conduit section 5 see Sh. No. 88
4. For detail of transition to flat invert and increased wall and base thickness adjacent to junction structure, see Sh. No. 45

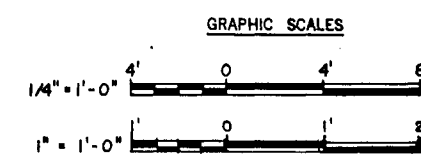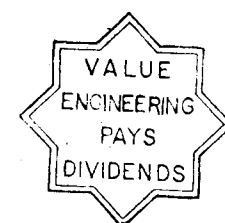

As Built Drawing

Contract No. DABCW-33-78-C-0098

ALTERNATE BASE SLAB REINFORCEMENT DETAIL
(WHERE OPTIONAL JOINT IS OMITTED)

[illegible]