

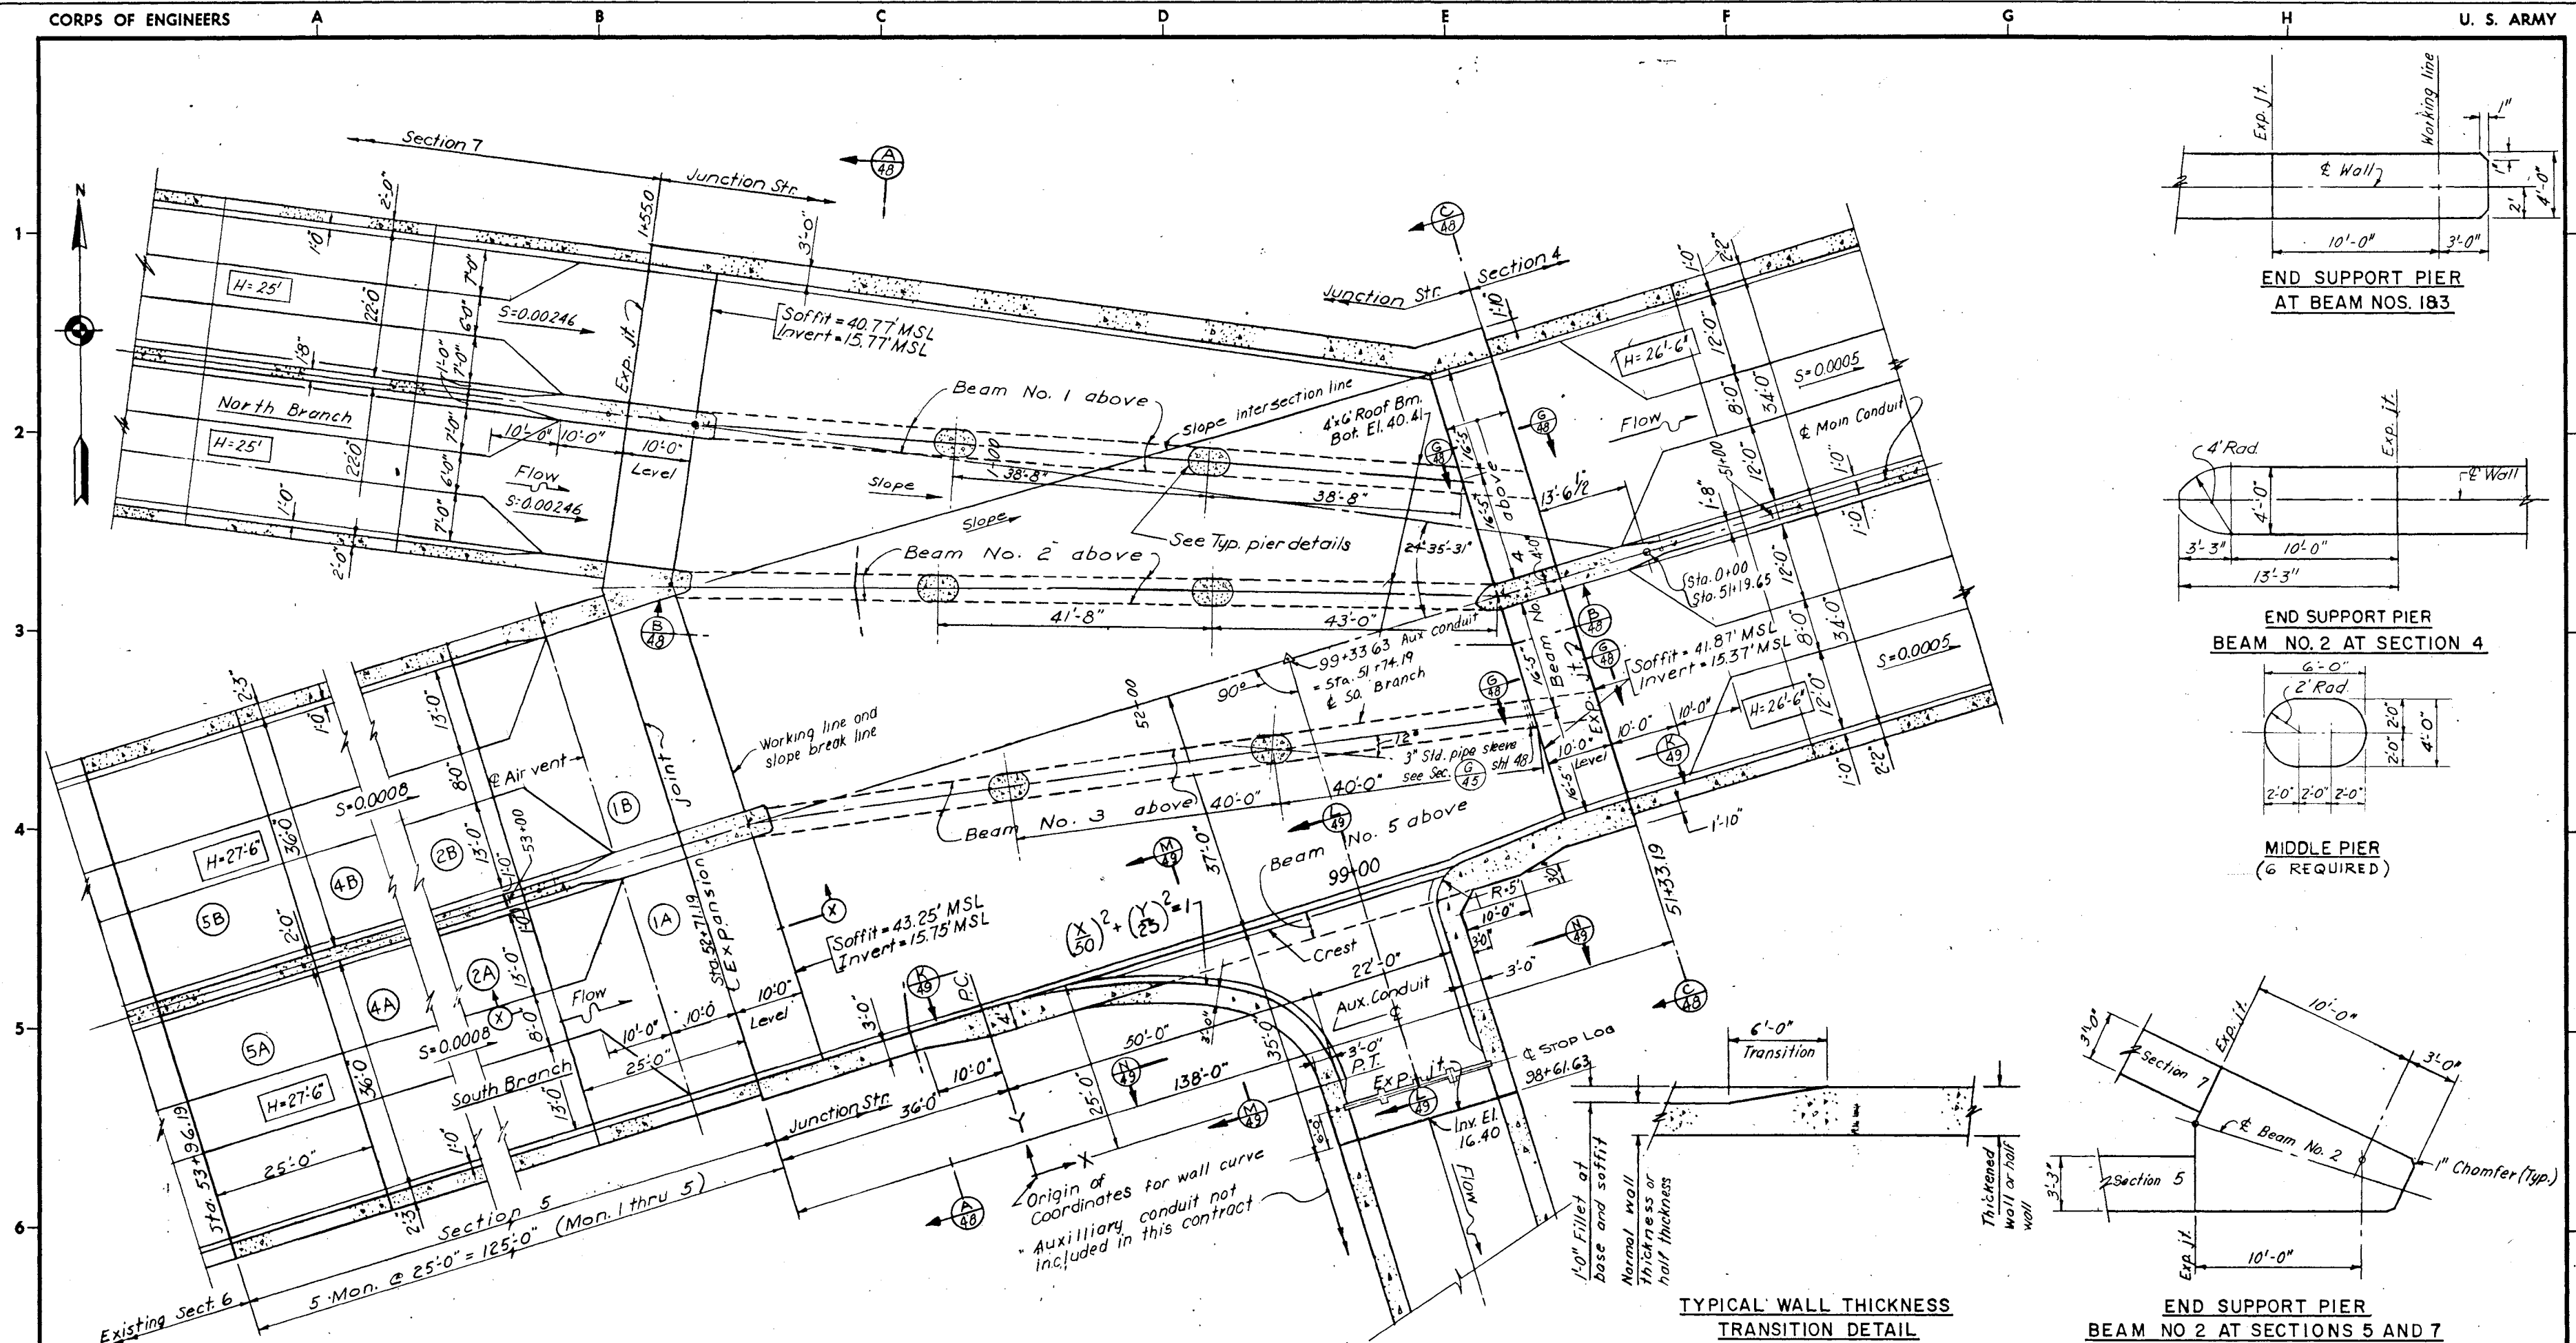


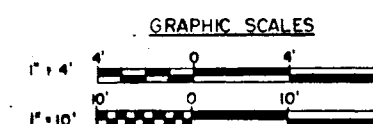

SECTIONAL PLAN
SCALE 1"=10'

COORDINATES FOR WALL CURVE	
X (FEET)	Y (FEET)
0	25.00
5	24.87
10	24.49
15	23.85
20	22.91
25	21.65
30	20.00
35	17.85
40	15.00
45	10.90
50	0

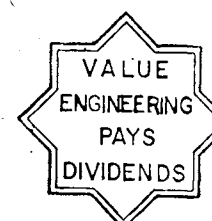

As Built Drawing

Contract No. DACW 33-76-C-0098

DES. BY W.F.	DR. BY W.F.	SC. BY W.F.
SUBMITTED C. M. H. 12-2-76	ONLY, EXH. 1	SECTION
APPROVAL H. J. 12-2-76	REVIEW H. J. 12-2-76	PROJECT H. J. 12-2-76
DEPARTMENT OF THE ARMY NEW ENGLAND DIVISION CORPS OF ENGINEERS WALTHAM, MASS.		
WATER RESOURCES DEVELOPMENT PROJECT PARK RIVER LOCAL PROTECTION JUNCTION STRUCTURE STRUCTURAL LAYOUT PLAN		
HARTFORD	APPROVED	DATE MARCH 1976
CHIEF PROJECT BRANCH	CHIEF ENGINEERING DIVISION	
SCALE AS SHOWN		SPEC. NO. DACW 33-76-B-0040
DRAWING NUMBER		PAR-1
		SHEET 45