

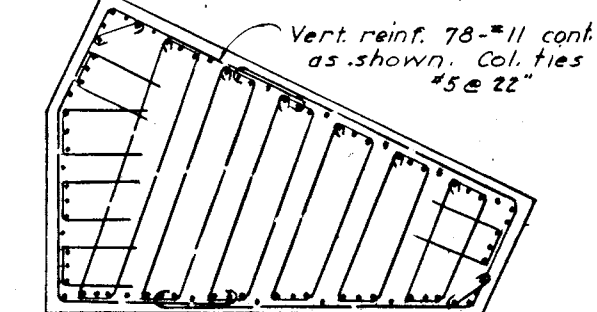
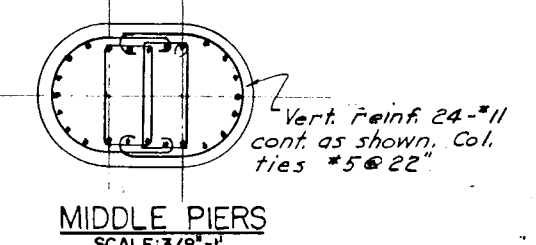
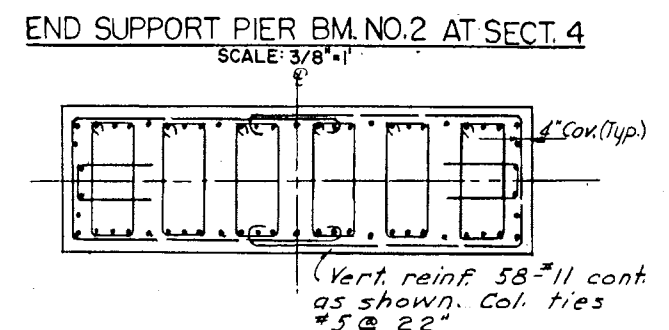
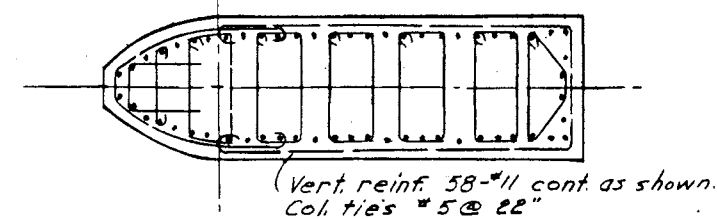
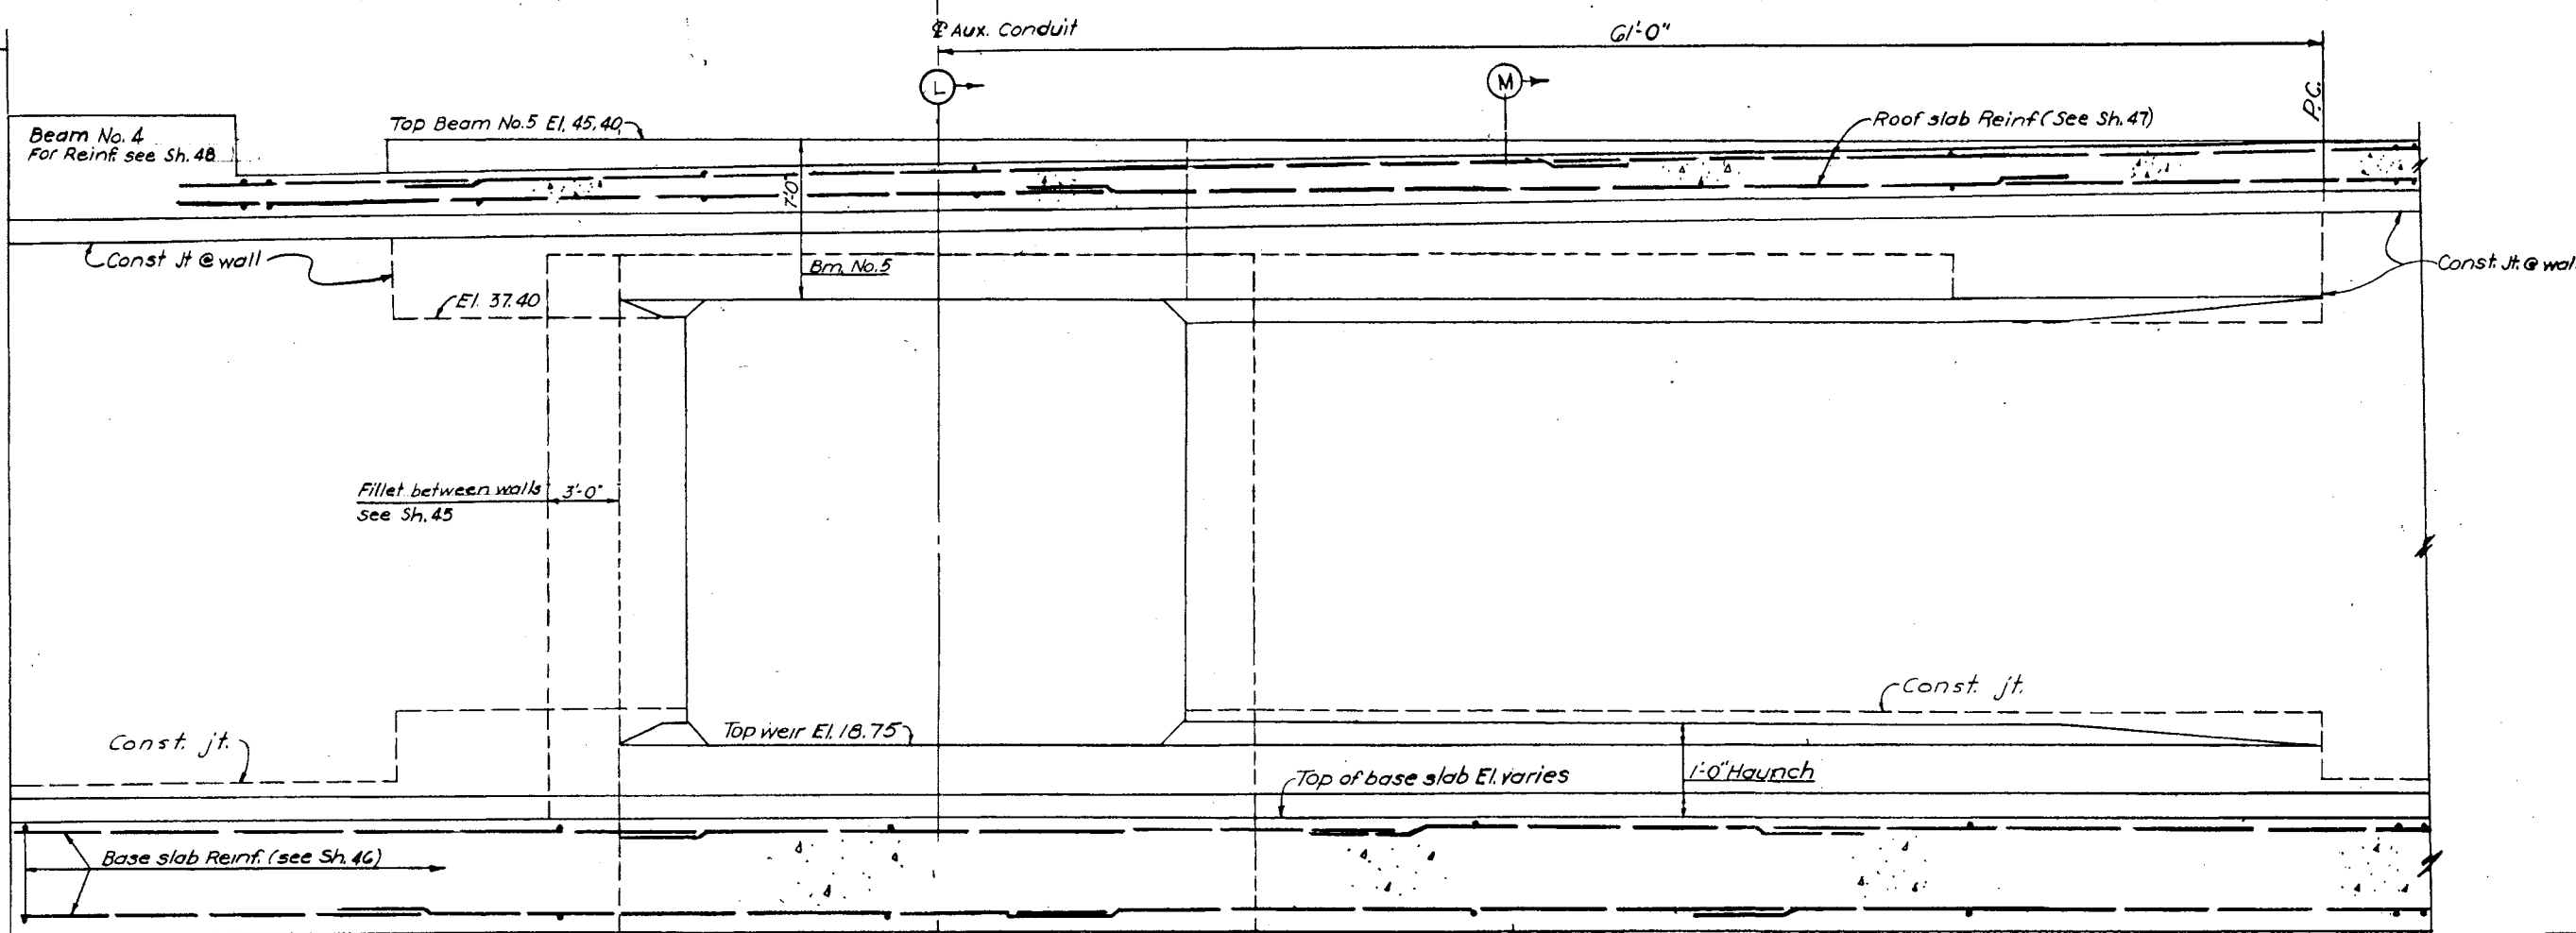
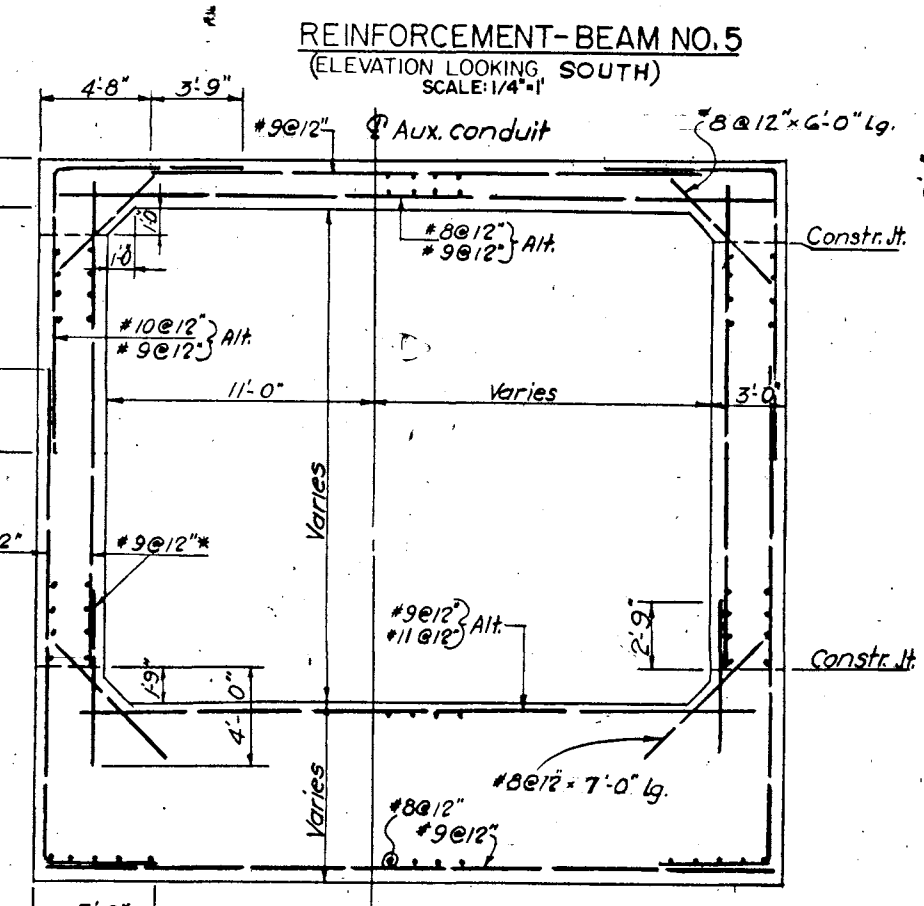
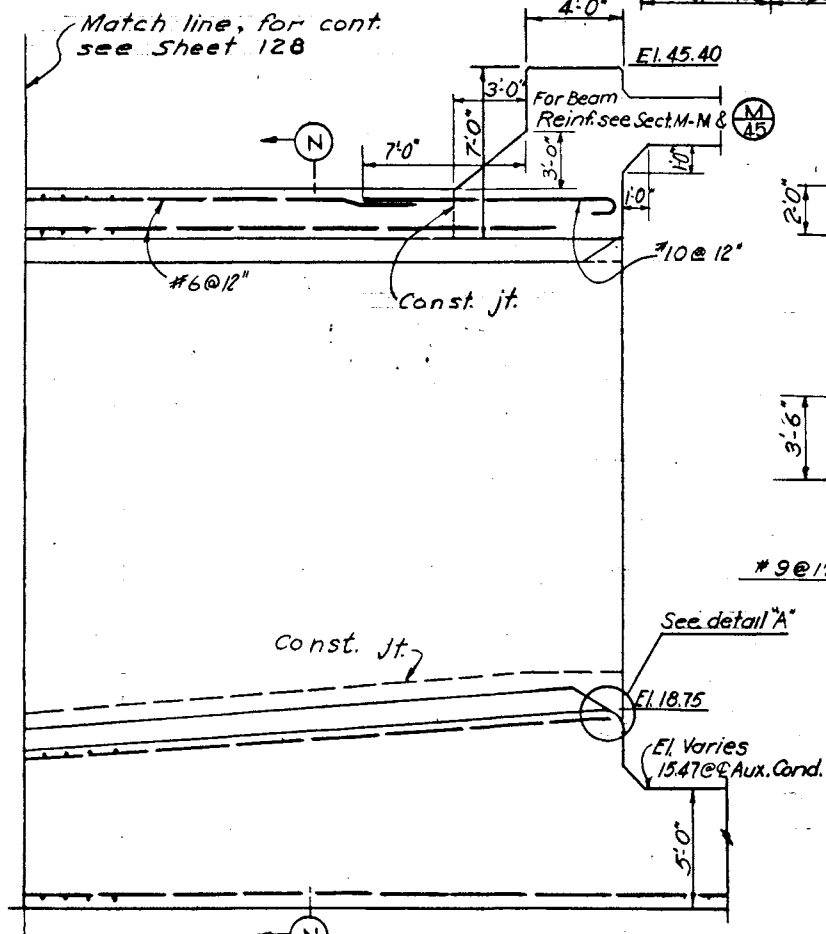


Conduit Sect
No. 4



Note:
Optional approved mechanical splices will
be allowed on ties at above pier details.

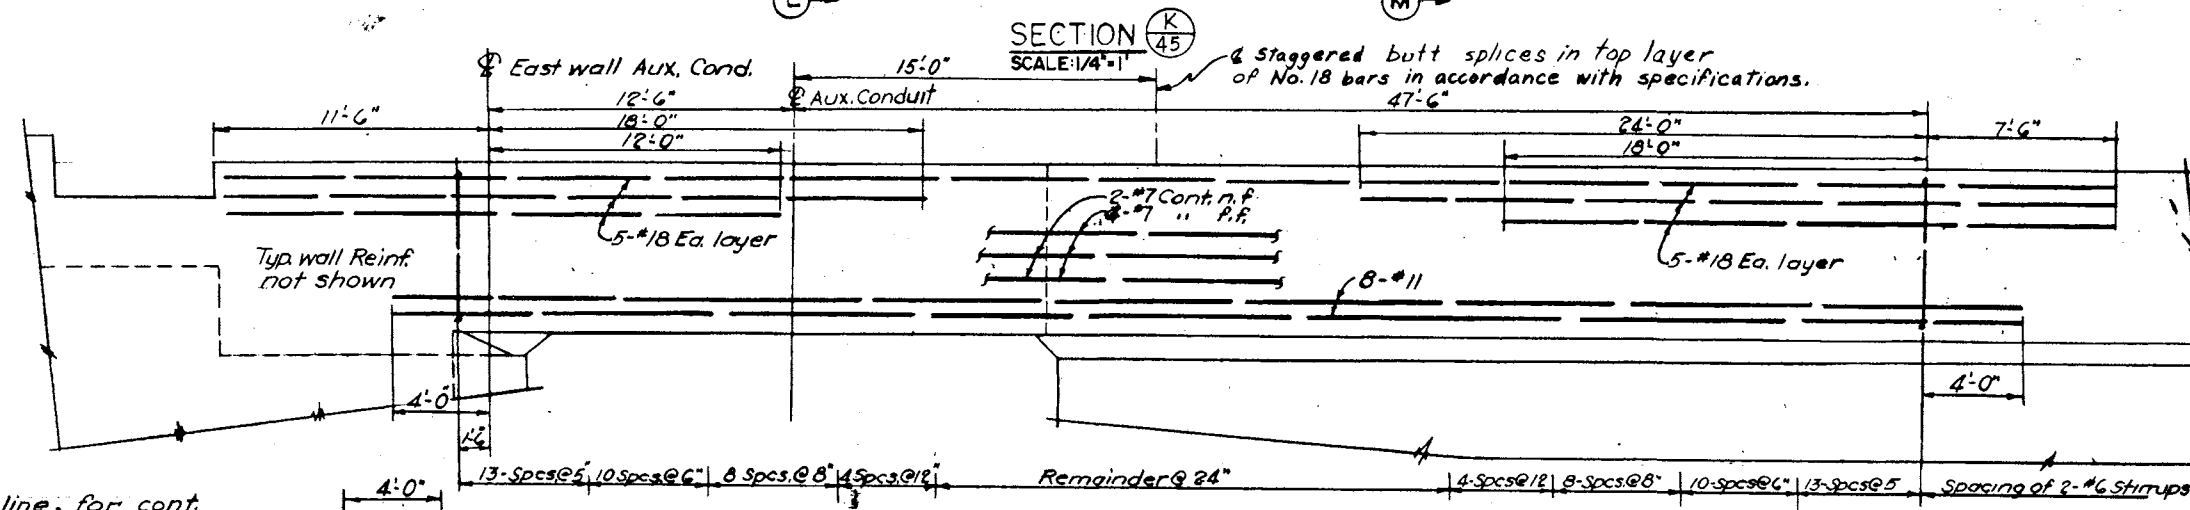

NOTE:
Every fourth bar shall
be extended full length
without dowels.

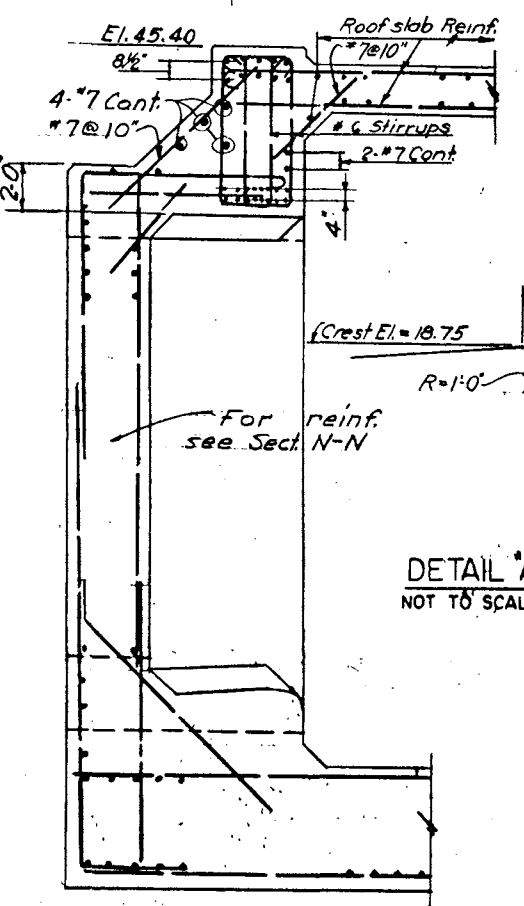

TYP VERTICAL SECTION THRU COLUMNS
SCALE: 3/16"=1'

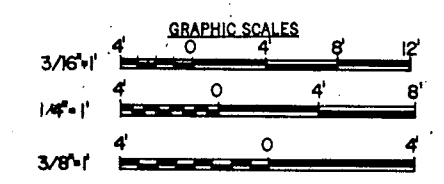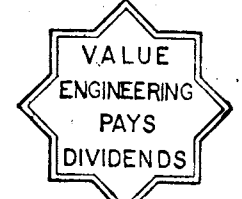

As Built Drawing
Contract No. DACW 33-76-C-0098

REVISION	DATE	DESCRIPTION	BY
4-4-83		Final field corrections	

DEPARTMENT OF THE ARMY
NEW ENGLAND DIVISION
CORPS OF ENGINEERS
WALTHAM, MASS.

WATER RESOURCES DEVELOPMENT PROJECT
PARK RIVER LOCAL PROTECTION
JUNCTION STRUCTURE
STRUCTURAL
SECTIONS AND DETAILS NO. 2

HARTFORD CONNECTICUT
APPROVED: [Signature] DATE: MARCH 1976
CHIEF PROJECT BRANCH

SCALE: AS SHOWN SPEC. NO. DACW 33-76-B-0040
DRAWING NUMBER
PAR-1

SHEET 49