


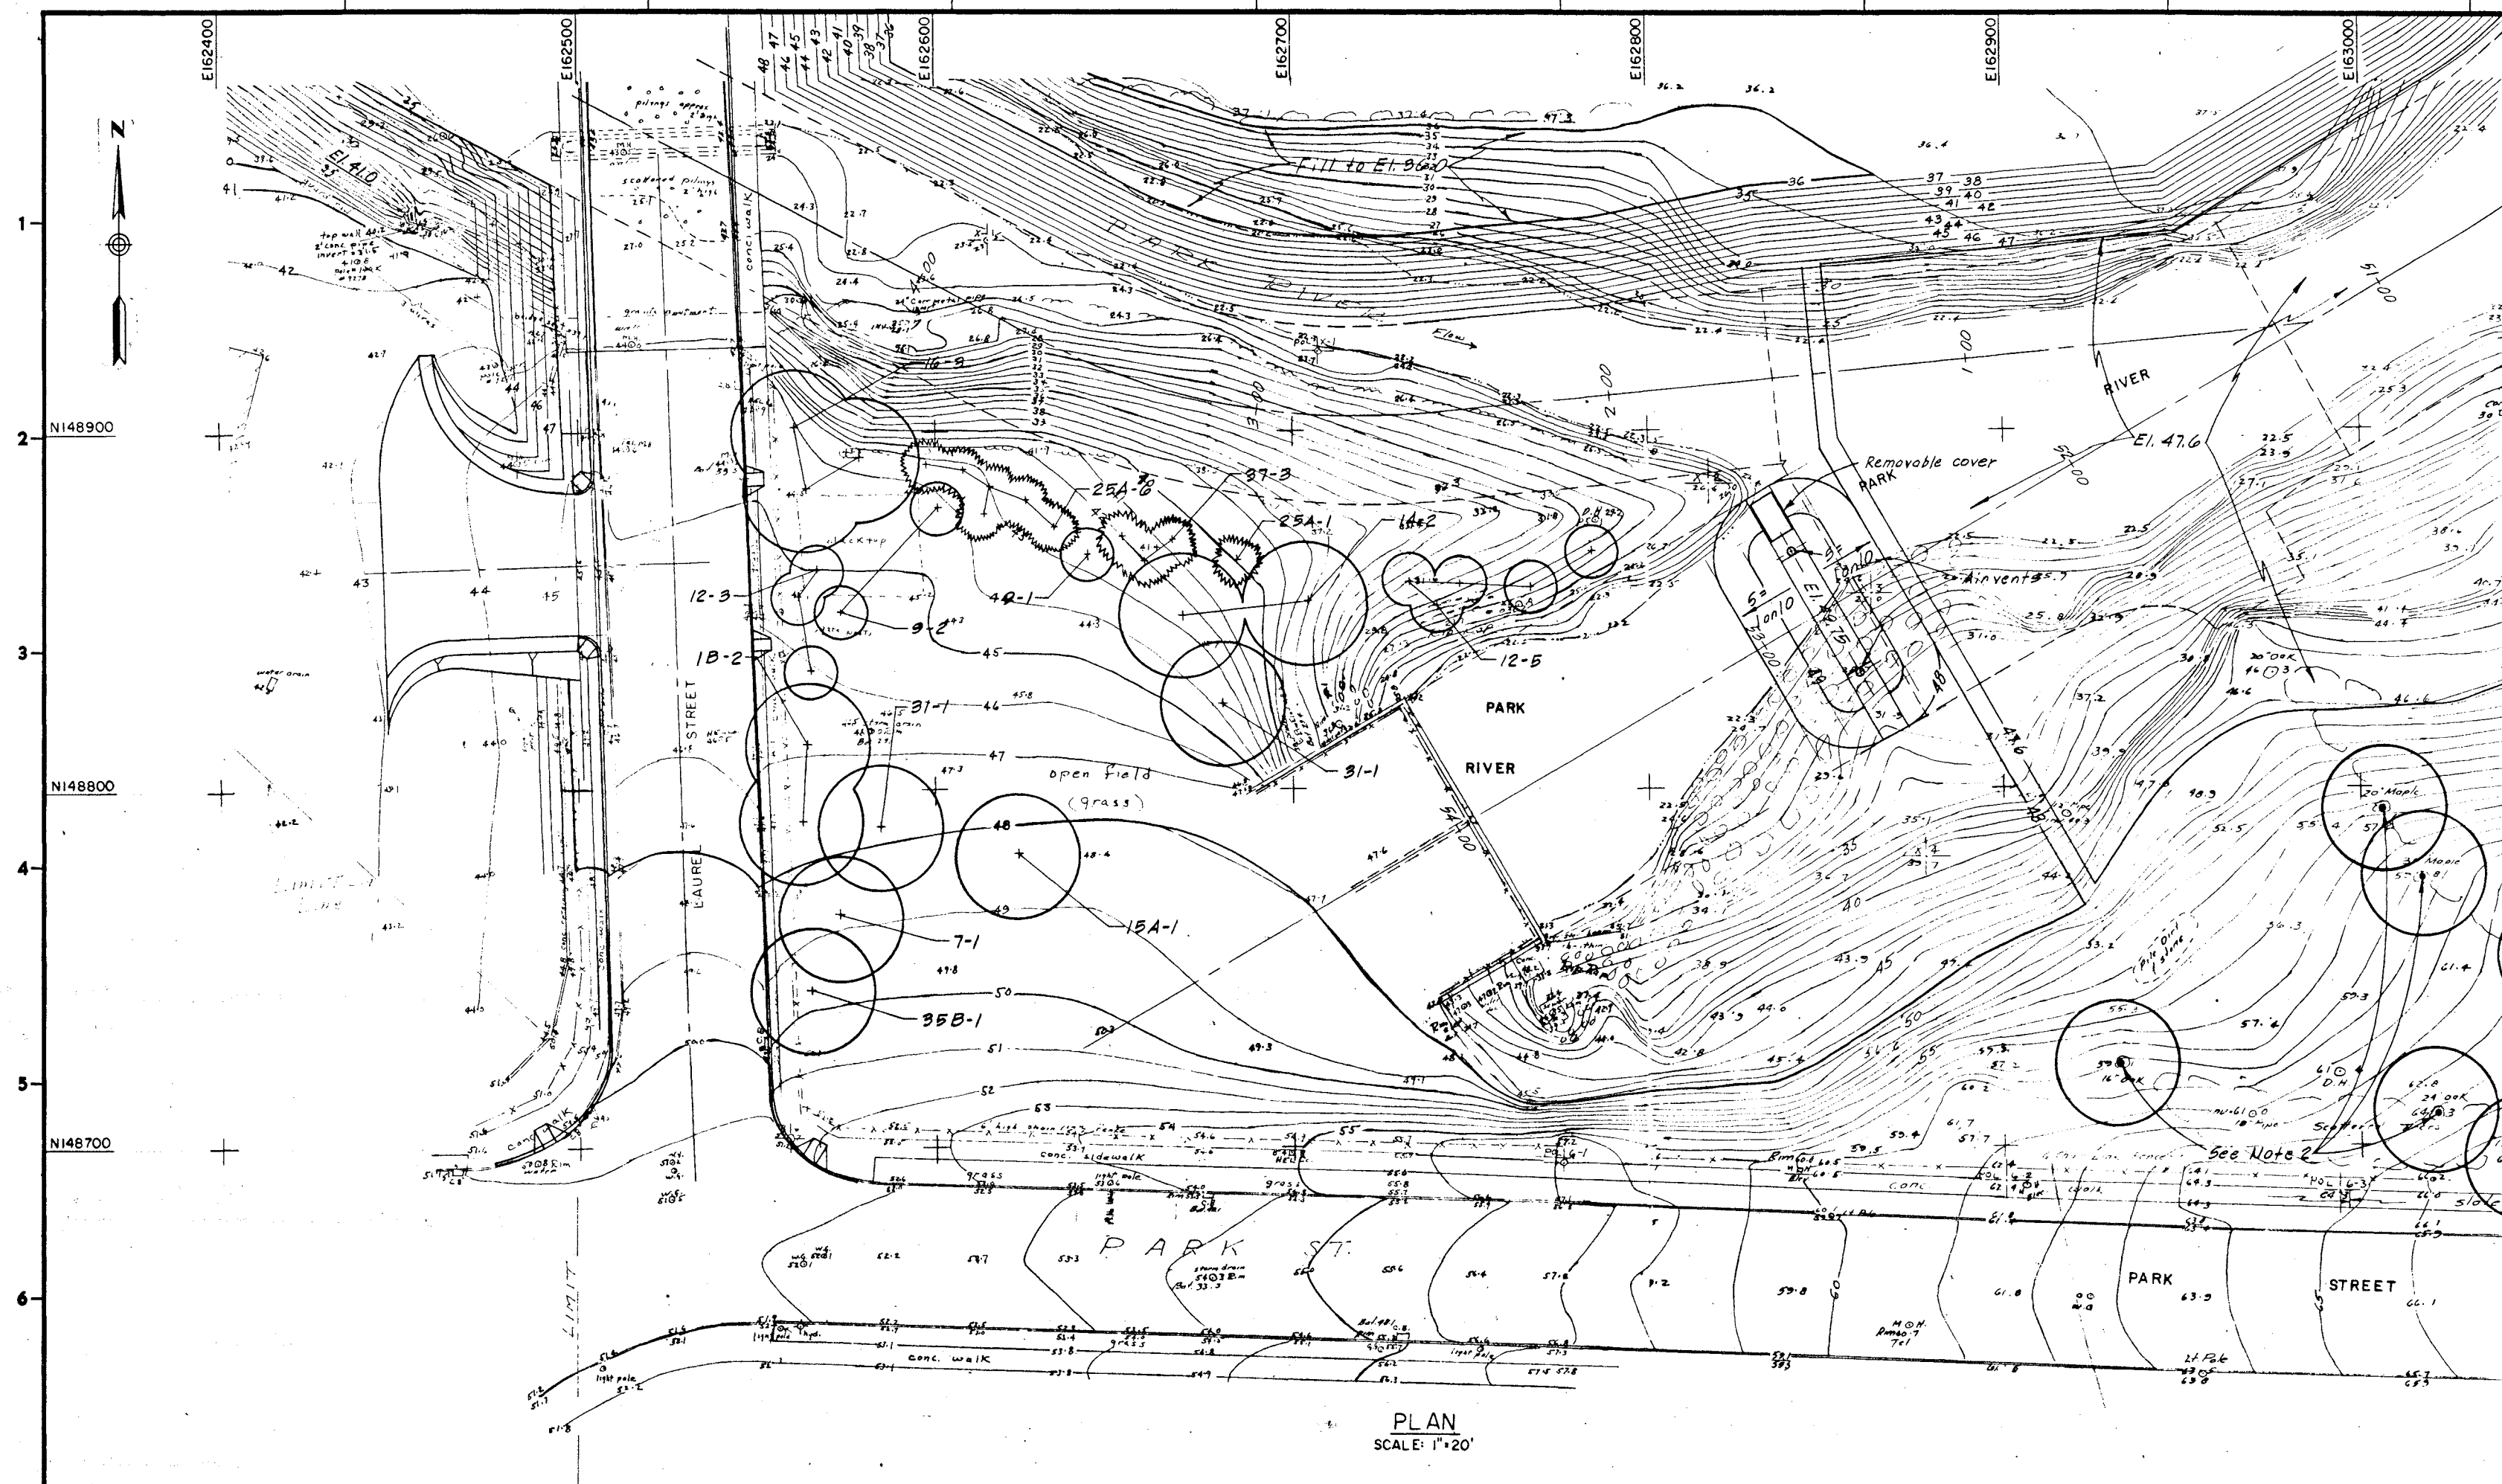

PLAN
SCALE: 1"=20'

NOTE:


1. For description of shrubs and trees see specifications.
2. Trees as noted, not to be removed.



GRAPHIC SCALES
1"=20' 0' 20' 40'

As Built Drawing

Contract No. DACW 33-76-C-0098

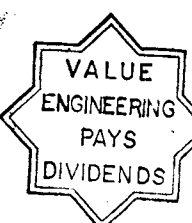

4-4-83		Final Field Corrections	
REVISION	DATE	DESCRIPTION	BY
DEPARTMENT OF THE ARMY NEW ENGLAND DIVISION CORPS OF ENGINEERS WALTHAM, MASS.			
WATER RESOURCES DEVELOPMENT PROJECT PARK RIVER LOCAL PROTECTION JUNCTION STRUCTURE AND SECTION 5 PLANTING PLAN			
DES. BY C.F.		CHK. BY J.A.P. C.F.	
SUBMITTED 8/1/76		APPROVED J.A.P. C.F.	
LANDSCAPE ARCHITECT		CHIEF ENGINEER	
APPROVAL RECOMMENDED		APPROVED	
CHIEF PROJECT BRANCH		CHIEF ENGINEERING DIVISION	
HARTFORD		CONNECTICUT	
DATE		MARCH 1976	
SCALE: 1"=20'		SPEC. NO. DACW 33-76-B-0040	
DRAWING NUMBER		PAR - I	
SHEET 50			