
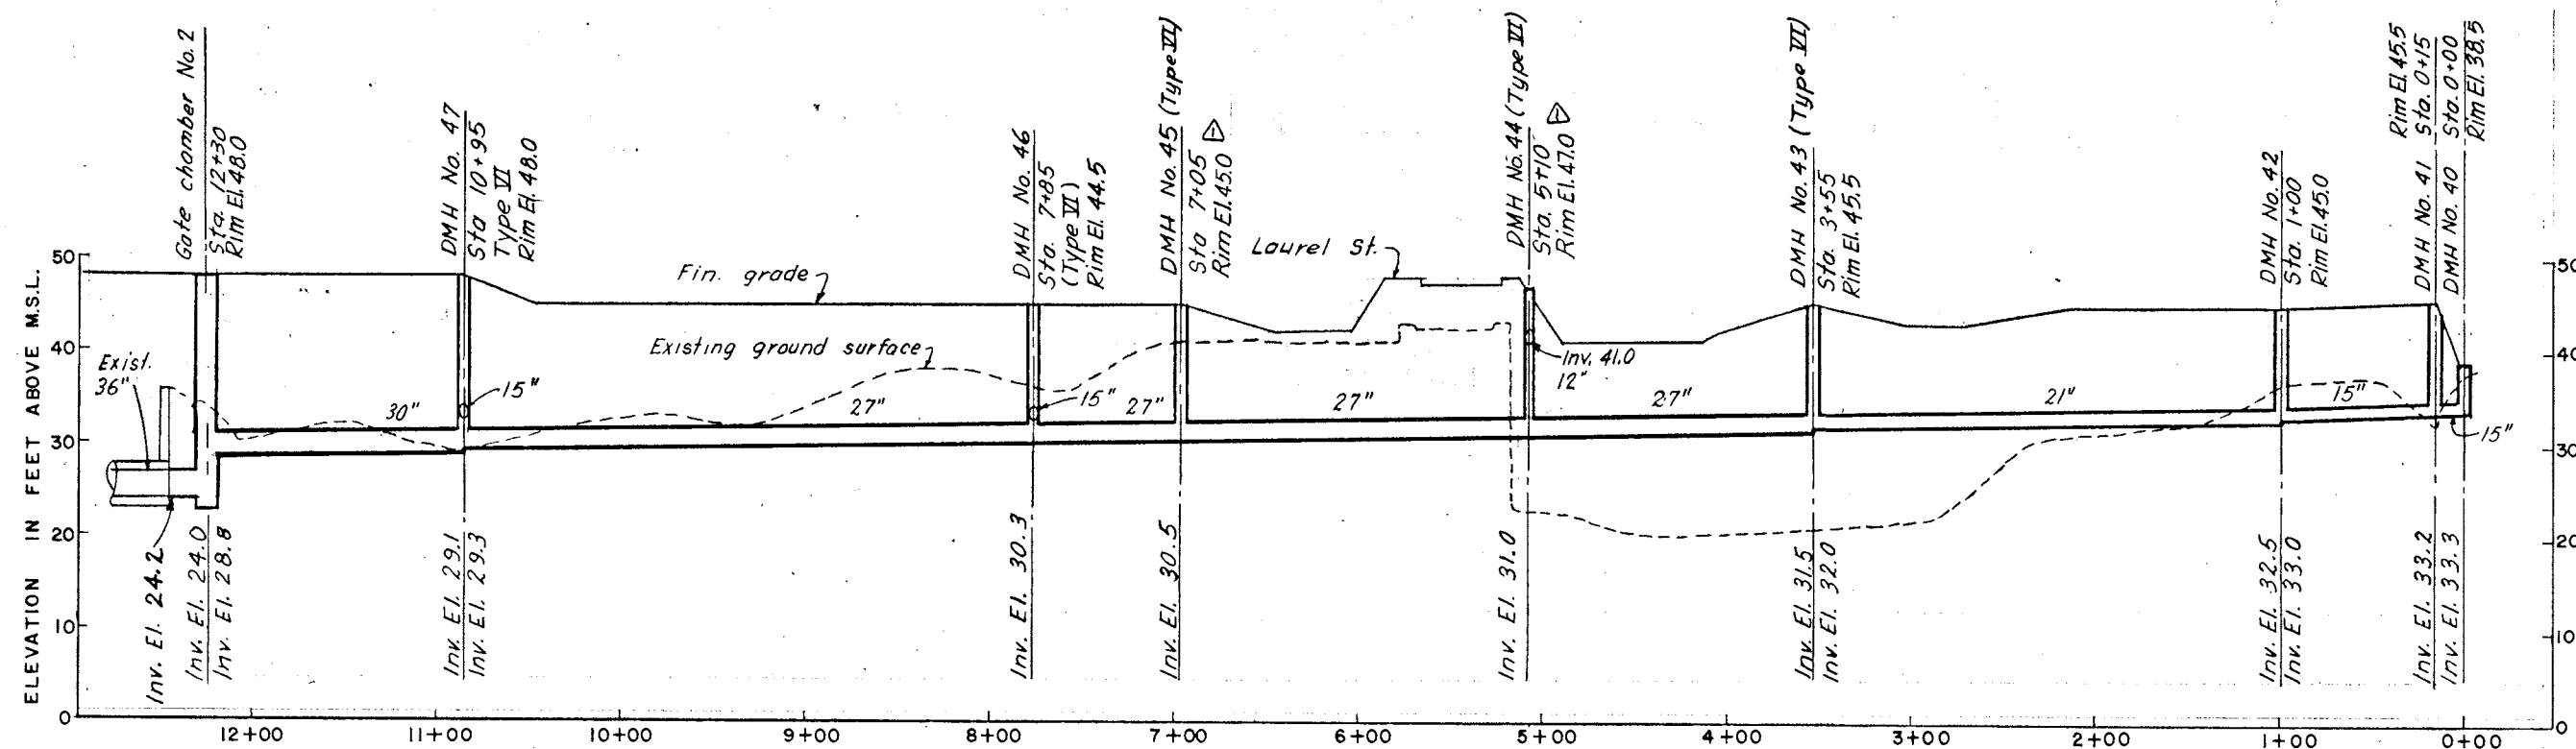
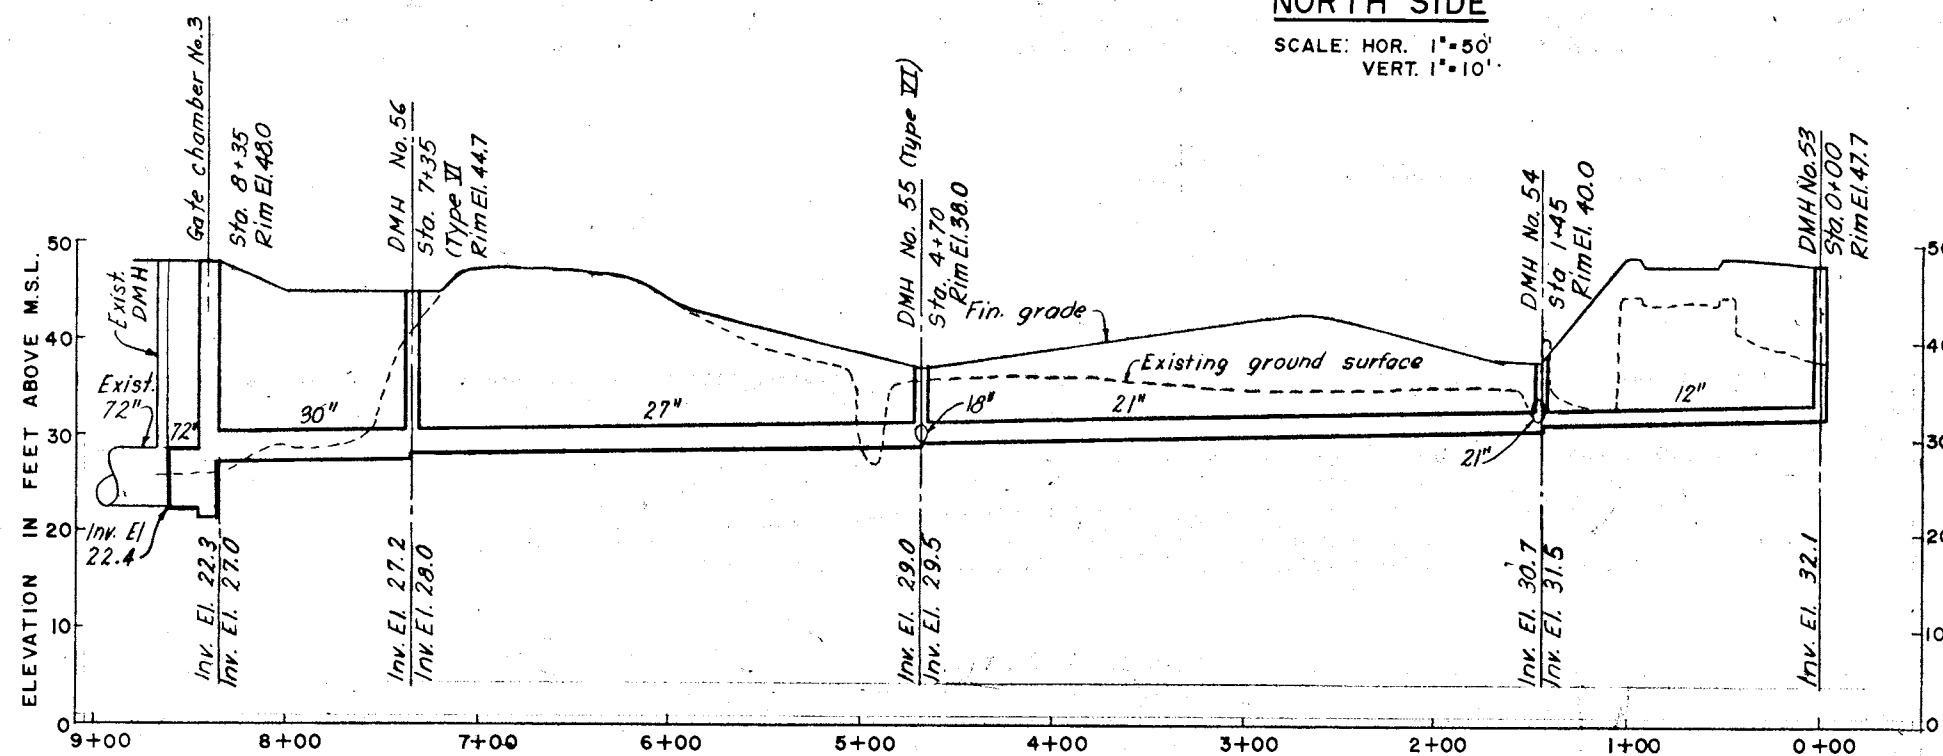
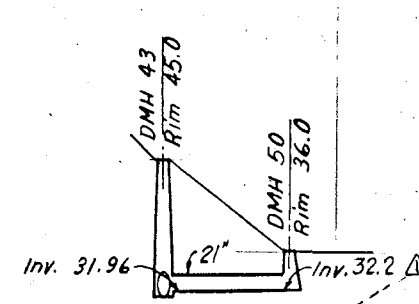
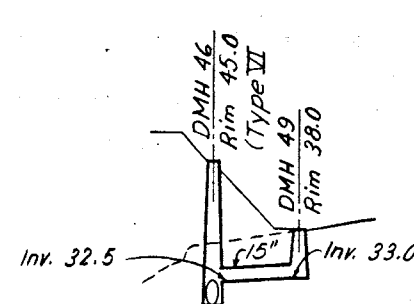


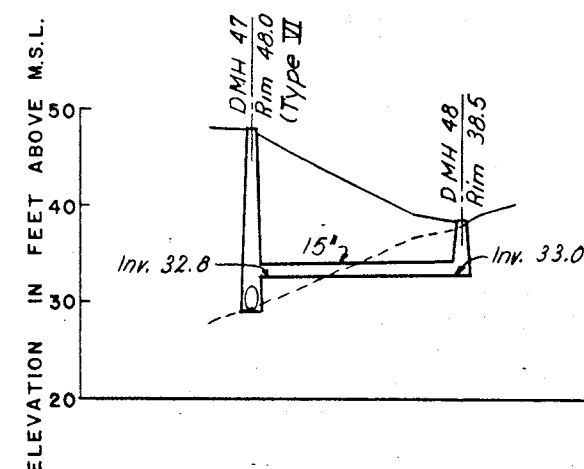

NORTH SIDE

SCALE: HOR. 1"=50'
VERT. 1"=10'

SOUTH SIDE



SCALE: HOR. 1"=50'
VERT. 1"=10'

NORTH SIDE

SCALE: HOR. 1"=20'
VERT. 1"=10'

NOTE:

1. For location of low level drains see sheets 58 and 59.
2. All manholes shall be Type II unless otherwise noted.
3. Change DMH Nos. 43, 44, 45 & 55 from Type II to Type VI.

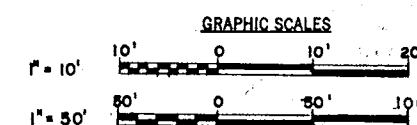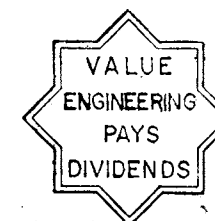

As Built Drawing

Contract No. DACW 33-76-C-0088

DES. BY W. F.	DR. BY W. F.	CK. BY W. F.	DATE 1 June 76	DESCRIPTION Final Field Corrections Rim and Invert E's added (Am. #4)	BY W. F.
DEPARTMENT OF THE ARMY NEW ENGLAND DIVISION CORPS OF ENGINEERS WALTHAM, MASS.					
WATER RESOURCES DEVELOPMENT PROJECT PARK RIVER LOCAL PROTECTION BOX CONDUIT AT SECTION 7 LOW LEVEL DRAINAGE PROFILES					
APPROVAL RECOMMENDED PROJECT ENGINEER APPROVED CHIEF, PROJECT BRANCH			HARTFORD CONNECTICUT DATE MARCH 1976		
SCALE AS SHOWN SPEC. NO. DACW 33-76-8-6040 DRAWING NUMBER PAR - I					