






ROOF PLAN
SCALE 1/4" = 1'-0"

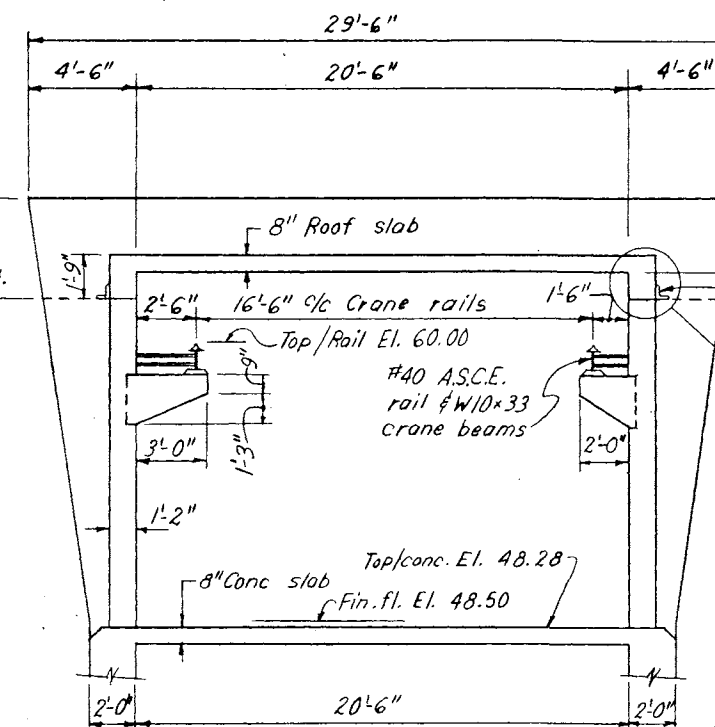


SECTION B - B
SCALE 1/4" = 1' - 0"

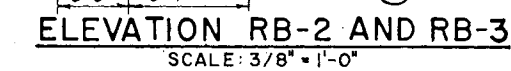

ELEVATION RB-4
SCALE: 3/8" = 1'-0"

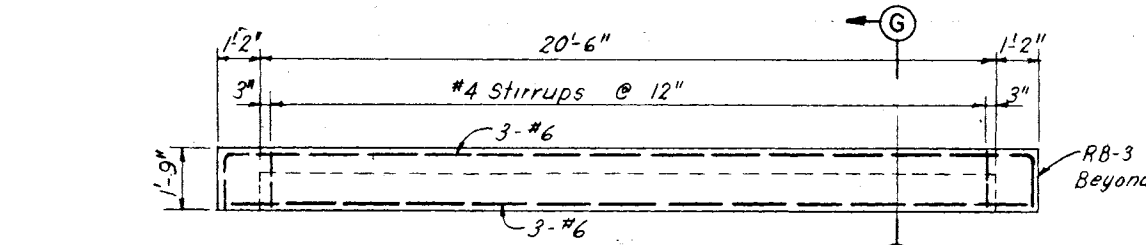


SECTION D-D
SCALE 3/4" = 1'-0"

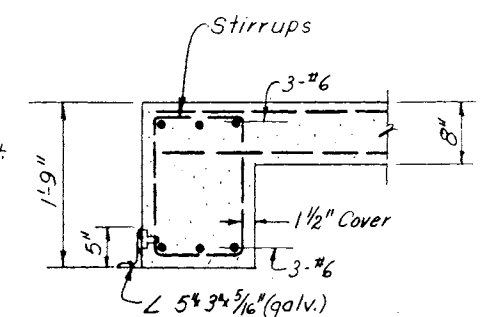


SECTION G-G
SCALE 1" = 1'-0"

Note: For details of shelf angle
& inserts see sh 72.

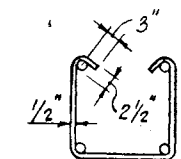



STIRRUPS
SCALE 1" = 1'-0"

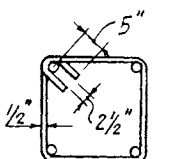


STIRRUPS TIES
SCALE 1" = 1'-0"

As Built Drawing

Contract No. DACW 33-76-C-0098

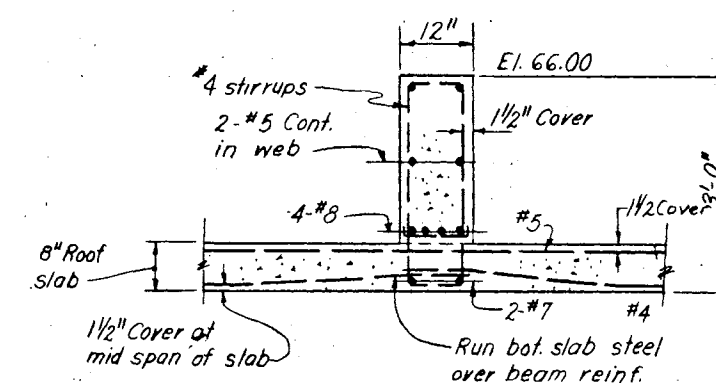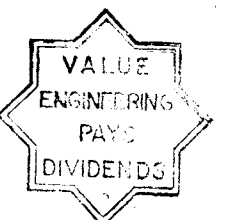

SECTION D-D
SCALE 3/4" = 1'-0"

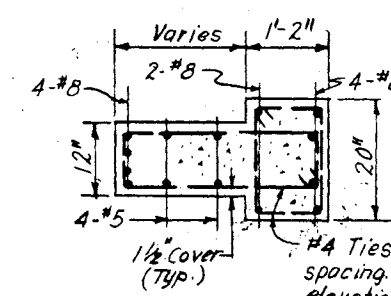

SECTION E-E
SCALE 3/4" = 1' - 0"

