




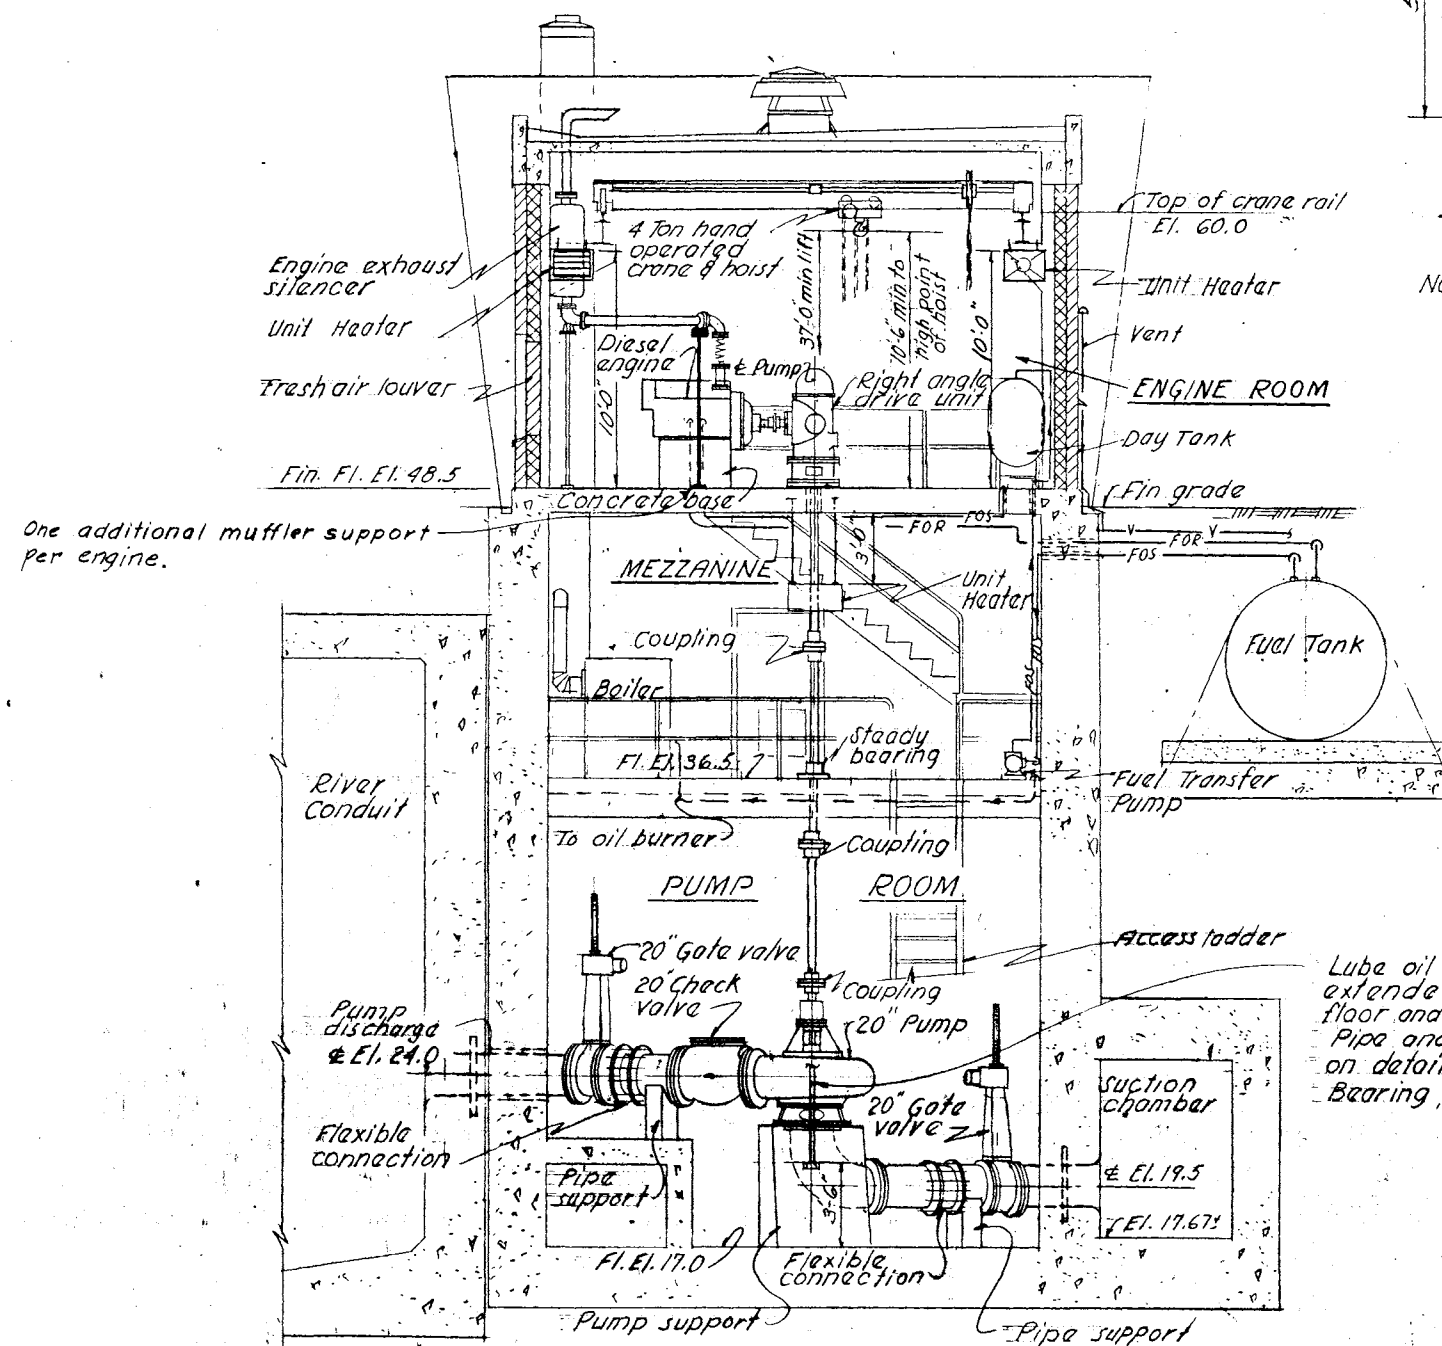

SECTION A-73
SCALE 1/4" = 1'-0"

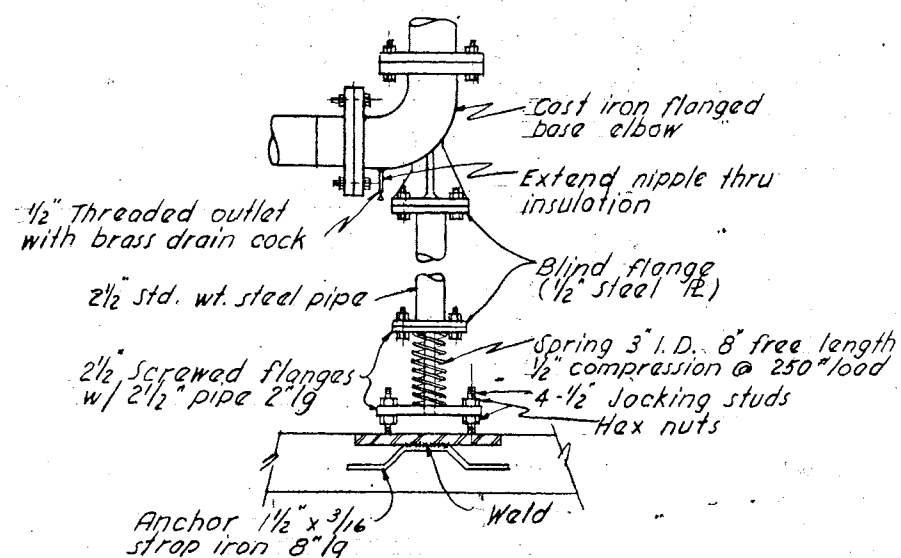


DETAIL-SILENCER SUPPORT
NOT TO SCALE

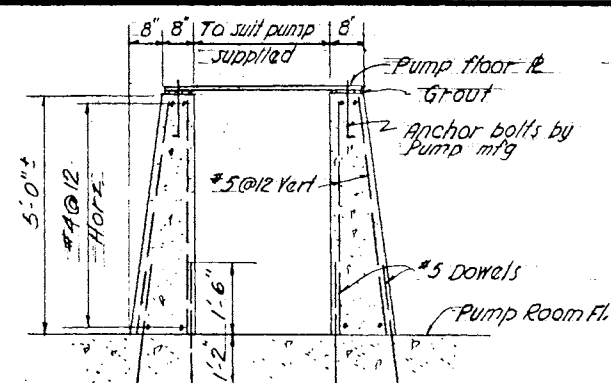


DETAIL - PUMP SUPPORTS
NOT TO SCALE

NOTE: Dimensions shown are min. Concrete supports shall be adjusted to suit pump supplied. For orientation see Pump Room Plan, Sheet 73

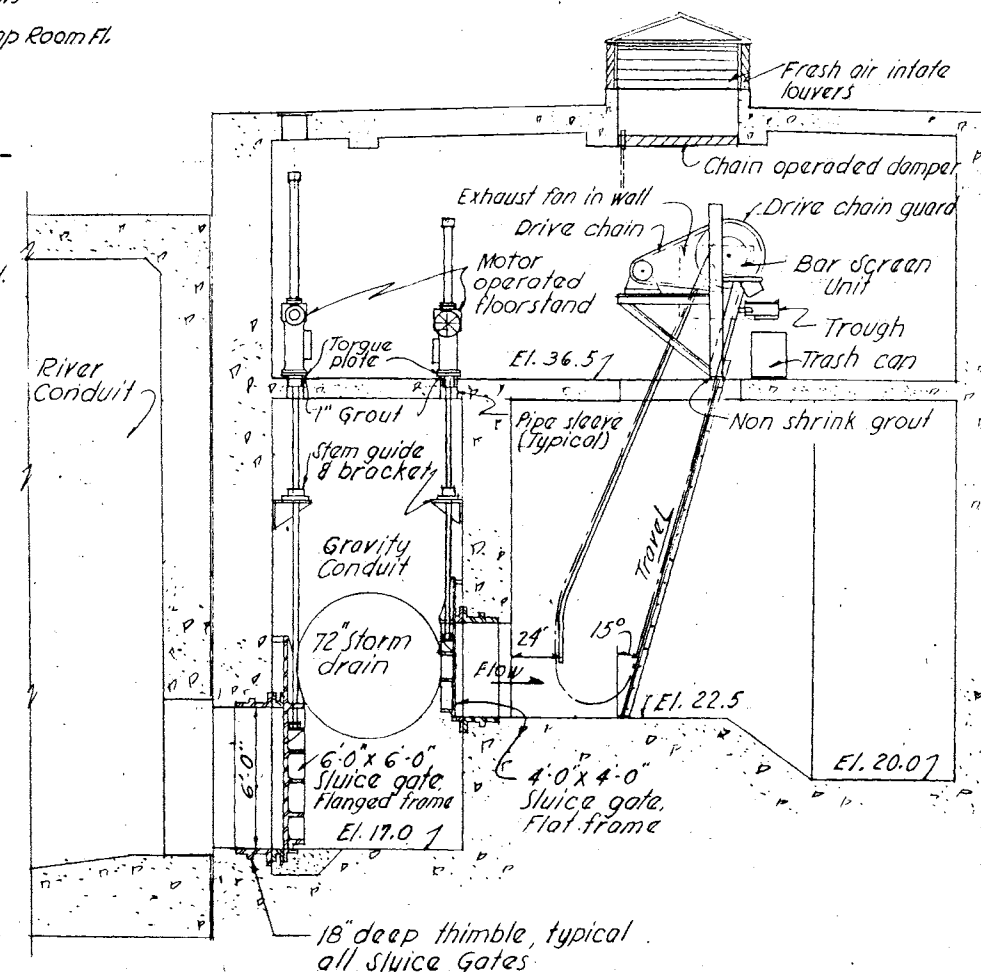

SECTION B-73
SCALE 1/4" = 1'-0"

DETAIL - PRECAST PIPE SUPPORT
NOT TO SCALE


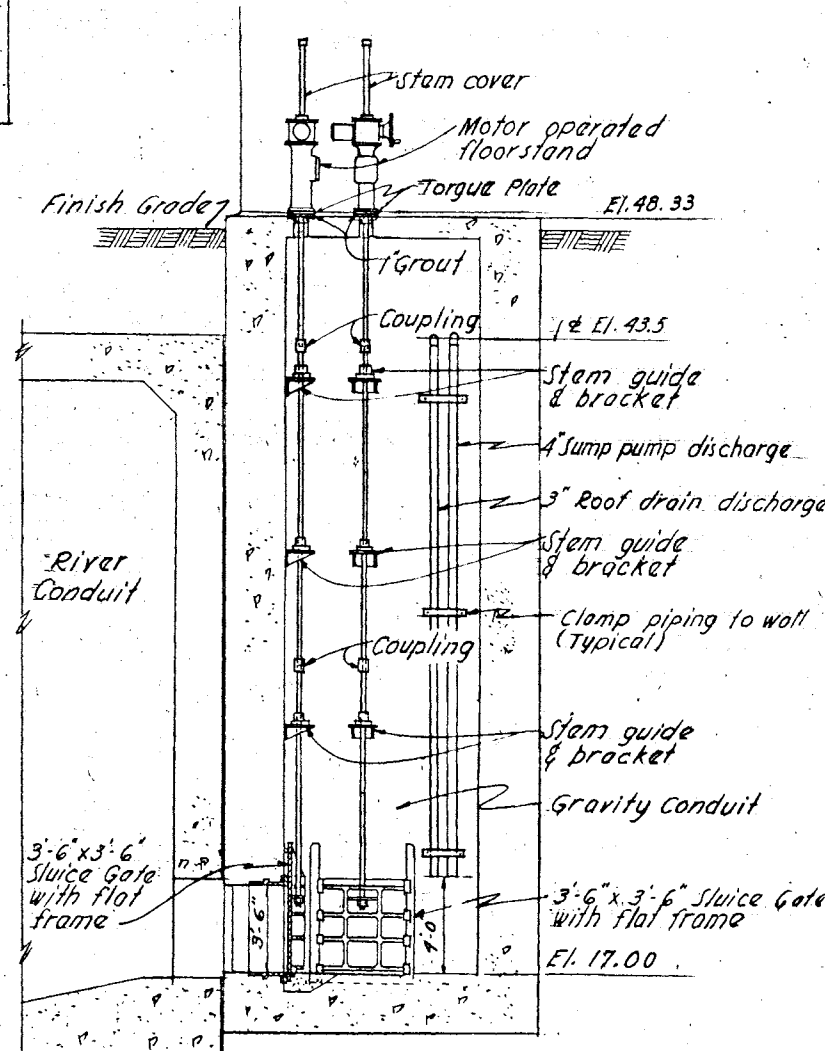


SECTION C-73
SCALE 1/4" = 1'-0"

DETAIL - RIVER & CONDUIT LEVEL GAUGE
SCALE 3/4" = 1'-0"

As Built Drawing

Contract No. DACW 33-76-C-0088

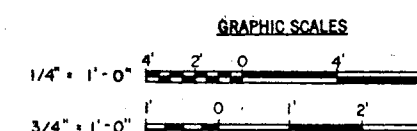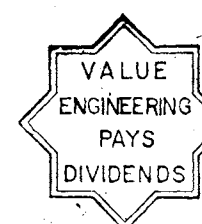

REVISION		DATE	DESCRIPTION	BY
4-4-83			Final field corrections	
DEPARTMENT OF THE ARMY NEW ENGLAND DIVISION CORPS OF ENGINEERS WALTHAM, MASS.				
WATER RESOURCES DEVELOPMENT PROJECT PARK RIVER LOCAL PROTECTION POPE PARK PUMPING STATION MECHANICAL - SECTIONS				
DES. BY J.T.S.		DR. BY J.P.V.	CK. BY J.T.S.	
SUBMITTED BY J.T.S.				
REVIEWED BY J.T.S.				
APPROVED BY J.T.S.				
HARTFORD		CONNECTICUT		
DATE		MARCH 1976		
SCALES SHOWN SPEC. NO. DACW33-76-B-0040 DRAWING NUMBER PAR-1				
SHEET 74				