
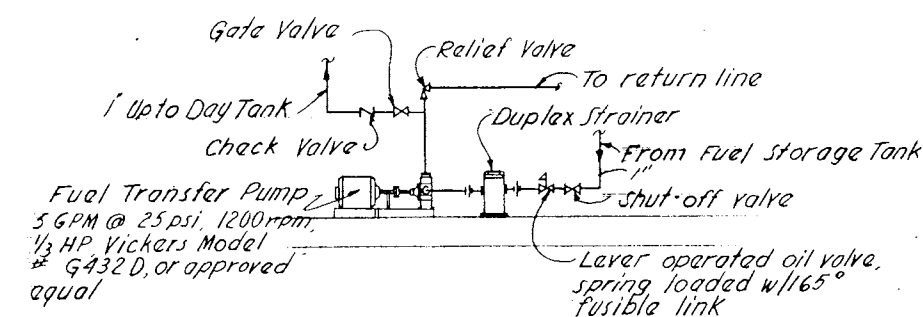
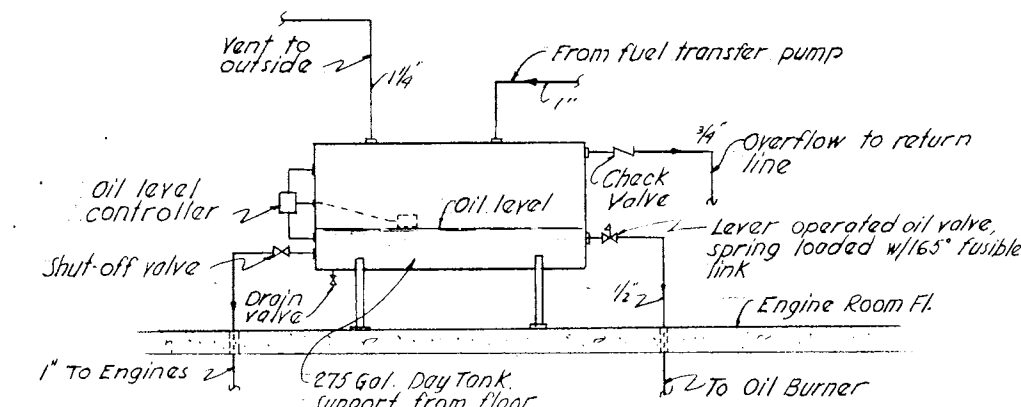
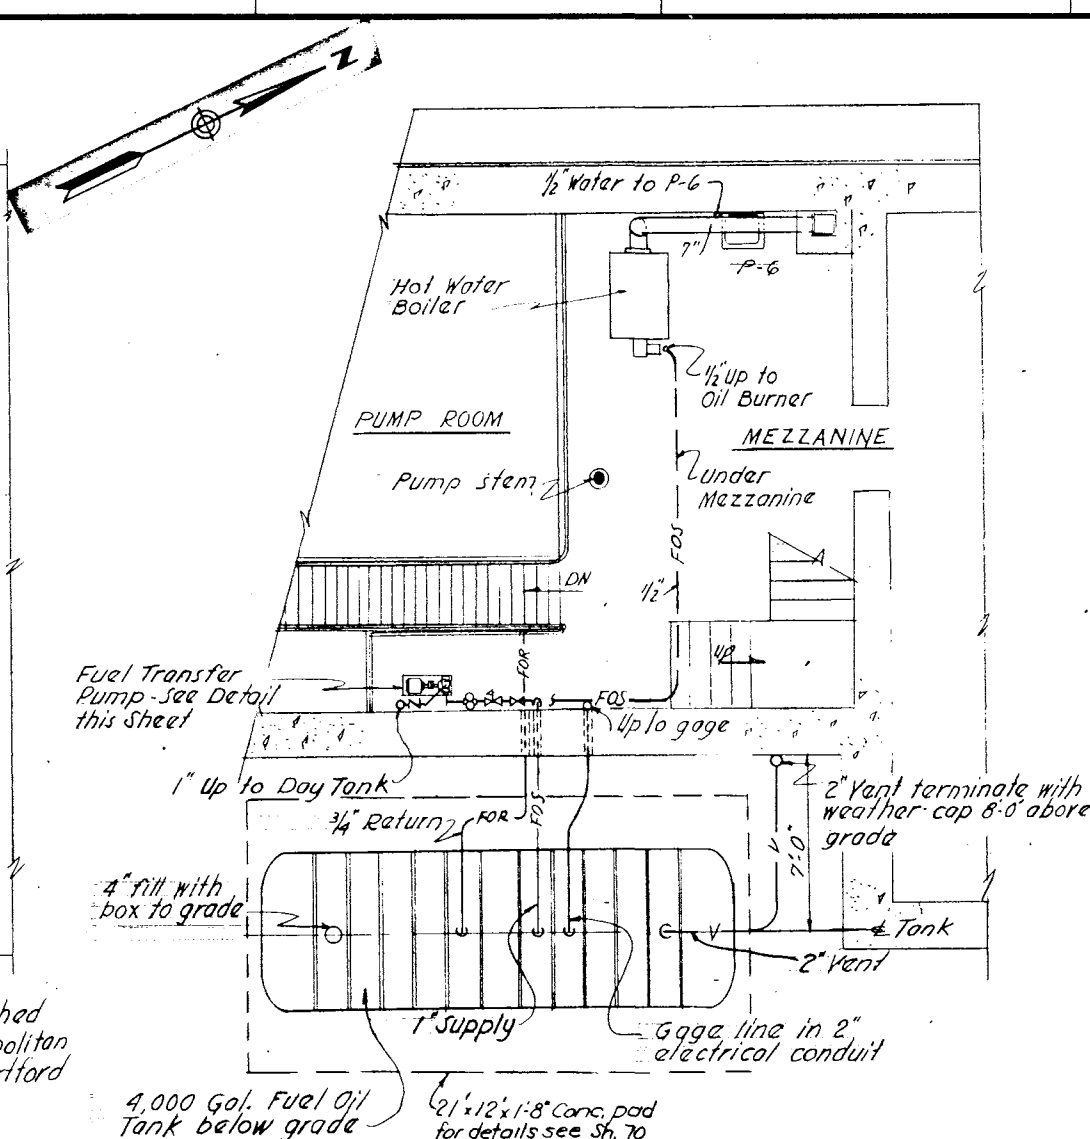


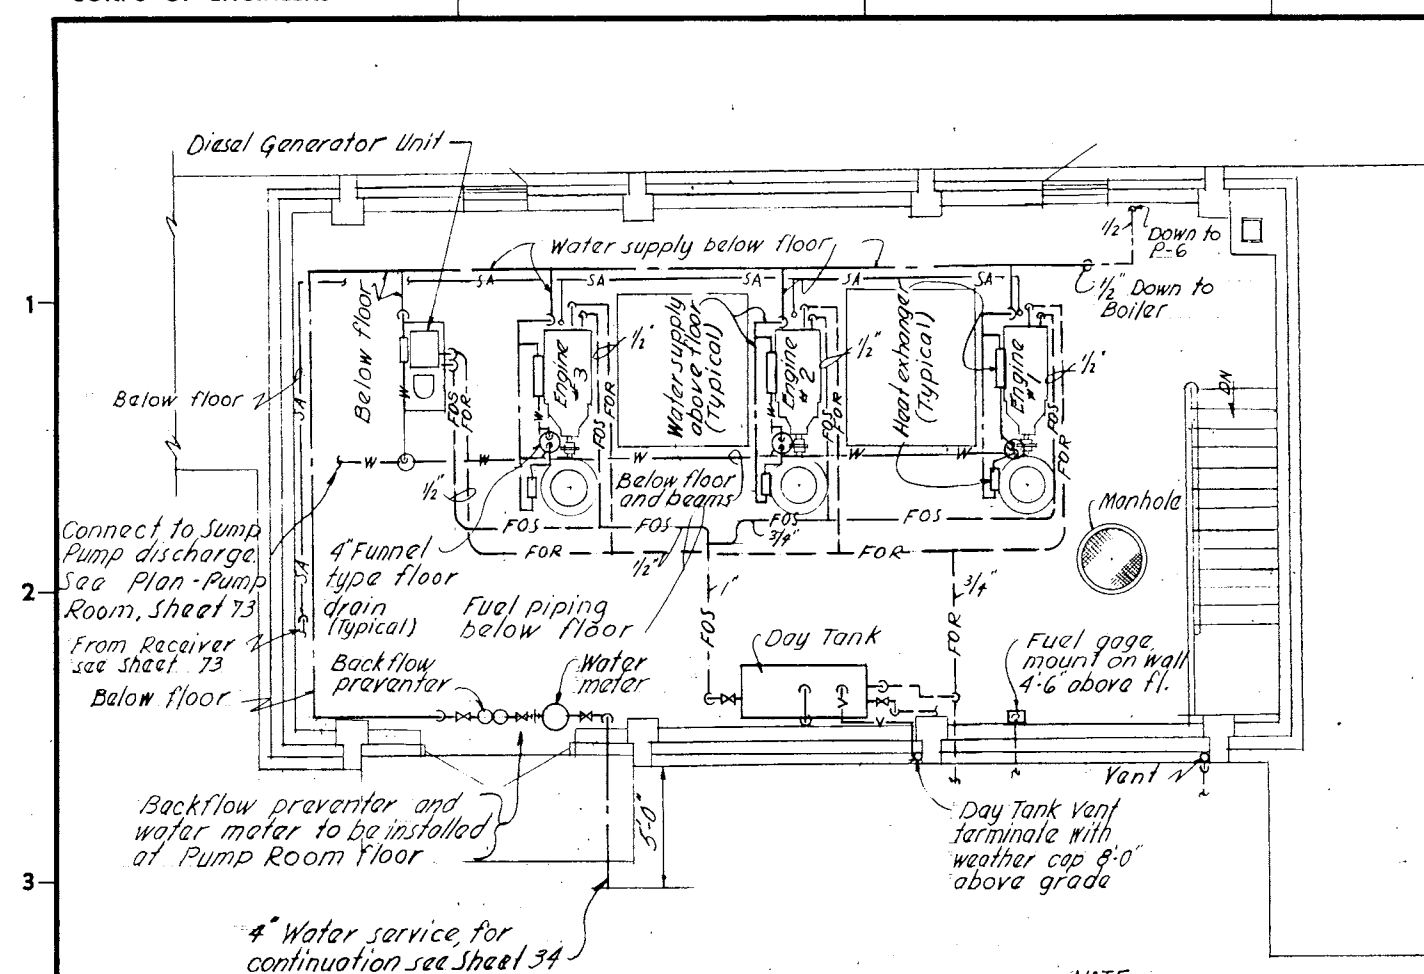




LEGEND

— FOS —	Fuel Oil Supply
— FOR —	Fuel Oil Return
— V —	Vent Piping
— W —	Water Piping
— W —	Waste Water Piping
— G —	Gate Valve
— C —	Check Valve
— L —	Lever Operated Valve
— U —	Union
— S —	Strainer
— SA —	Starting Air Piping


NOTES:
Provide sleeves for all fuel and water piping that pass thru floors or walls. Sleeves shall extend 1" above floor.
For type and size of sleeve see Section 35, Plumbing of specifications.

As Built Drawing

Contract No. DACW 33-76-C-0098

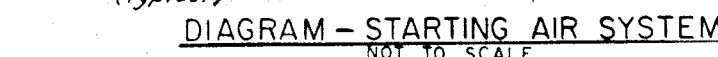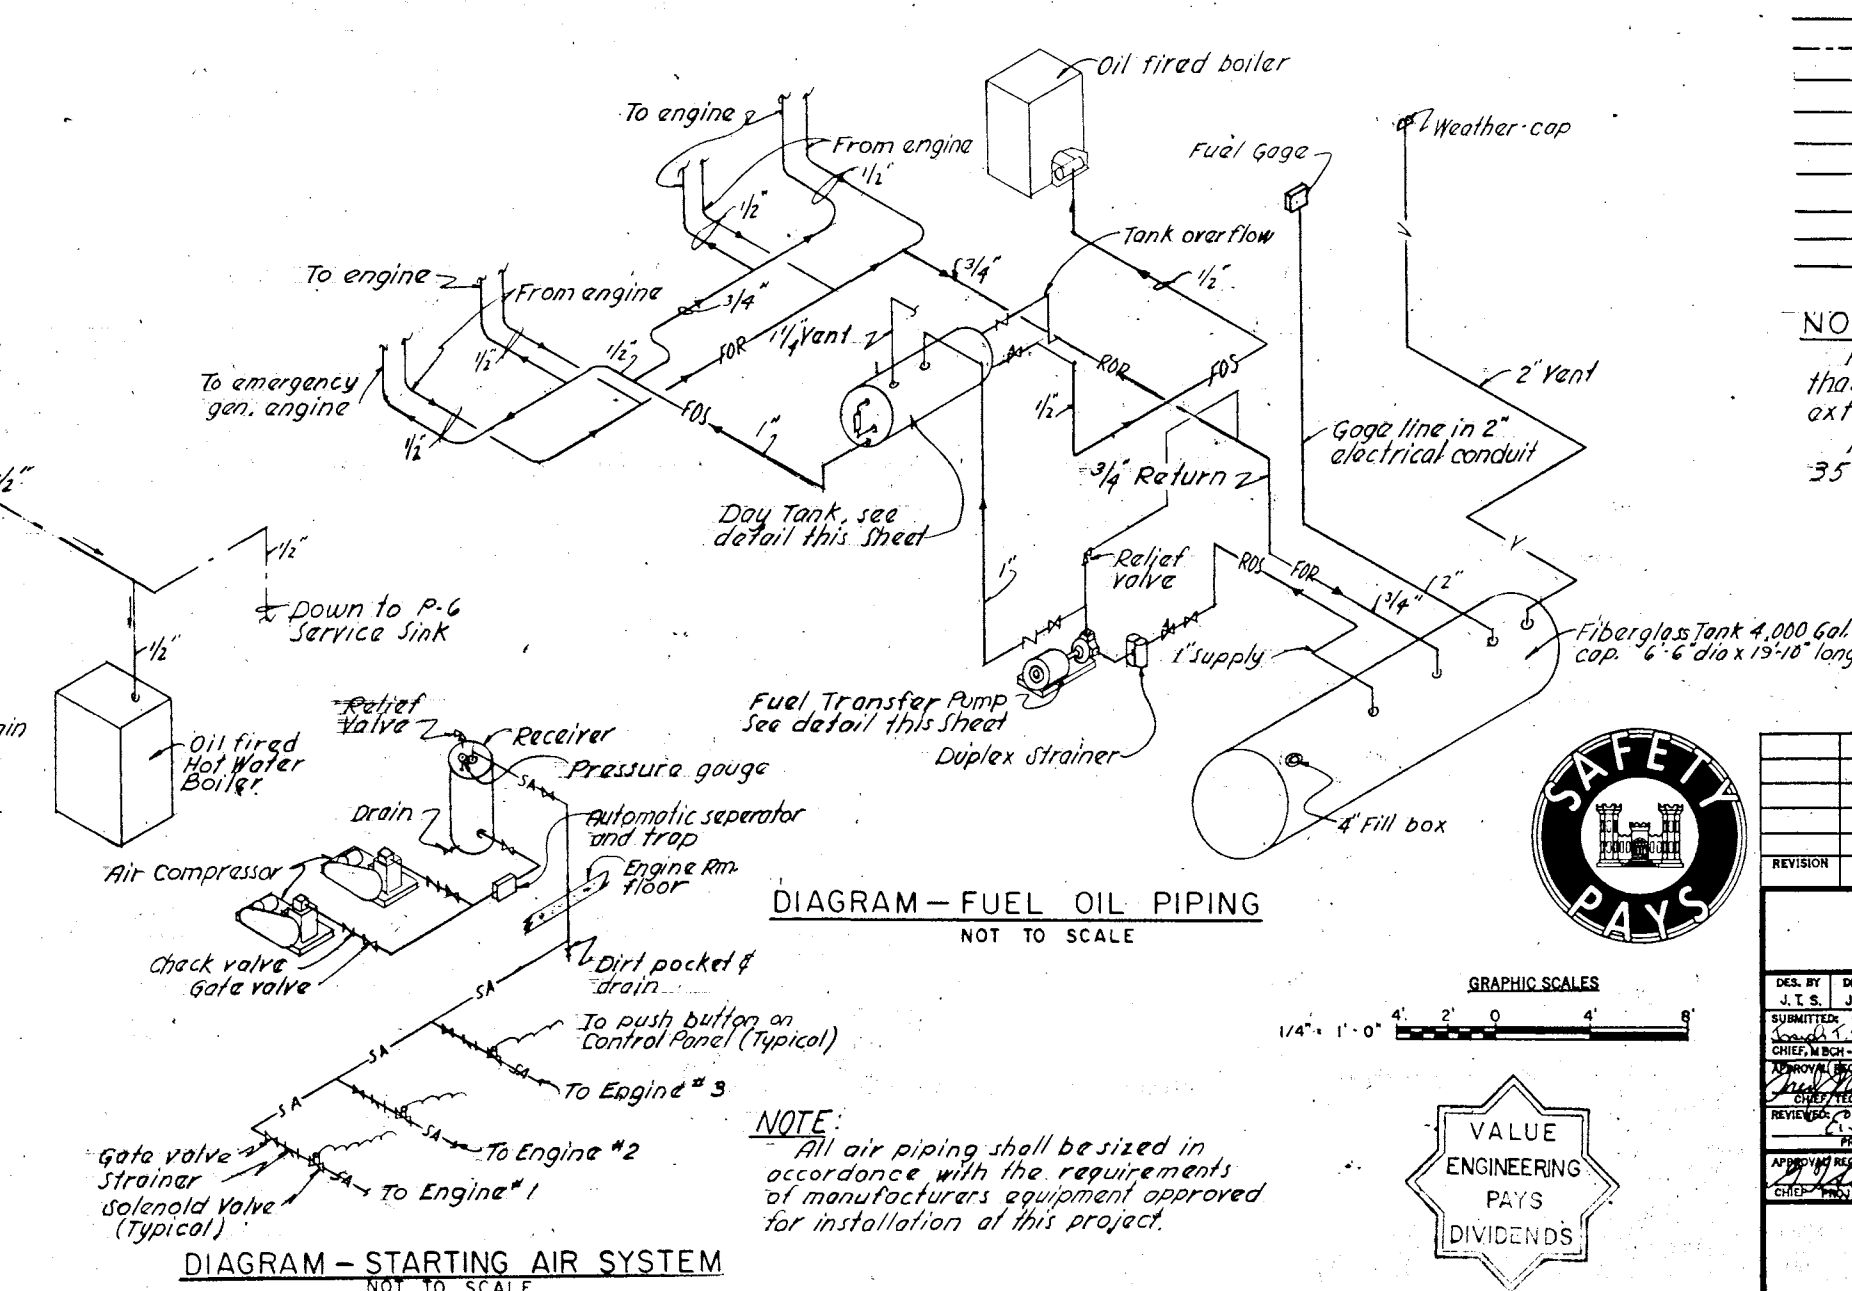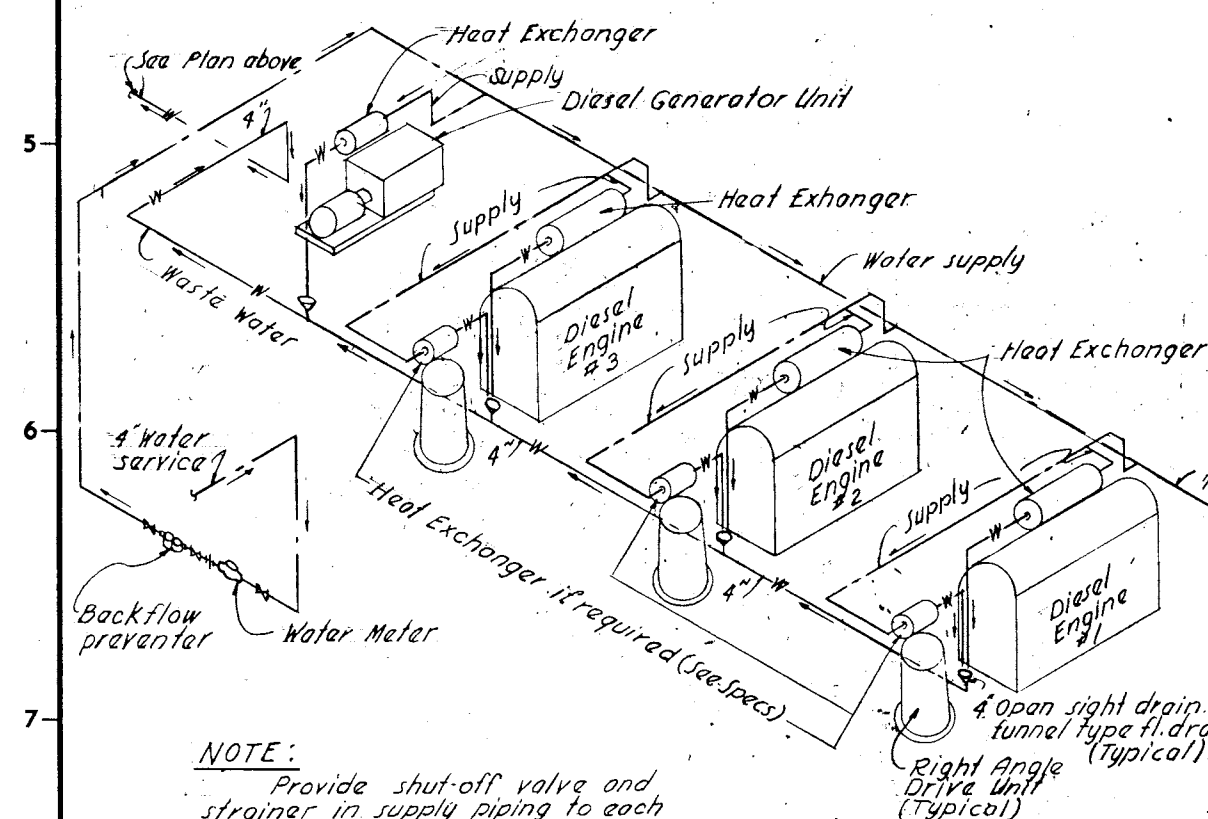

GRAPHIC SCALES
1/4" = 1'-0"

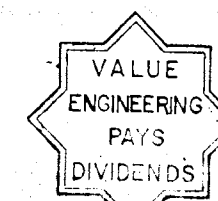

REVISION	DATE	DESCRIPTION	BY

DEPARTMENT OF THE ARMY
NEW ENGLAND DIVISION
CORPS OF ENGINEERS
WALTHAM, MASS.

**WATER RESOURCES DEVELOPMENT PROJECT
PARK RIVER LOCAL PROTECTION
POPE PARK PUMPING STATION
FUEL OIL AND WATER
PIPING-PLANS, DETAILS AND DIAGRAMS**

HARTFORD CONNECTICUT

DATE **MARCH 1976**

SCALE AS SHOWN SPEC. NO. DACW 33-76-B-0040
DRAWING NUMBER
PAR-1

SHEET 76