




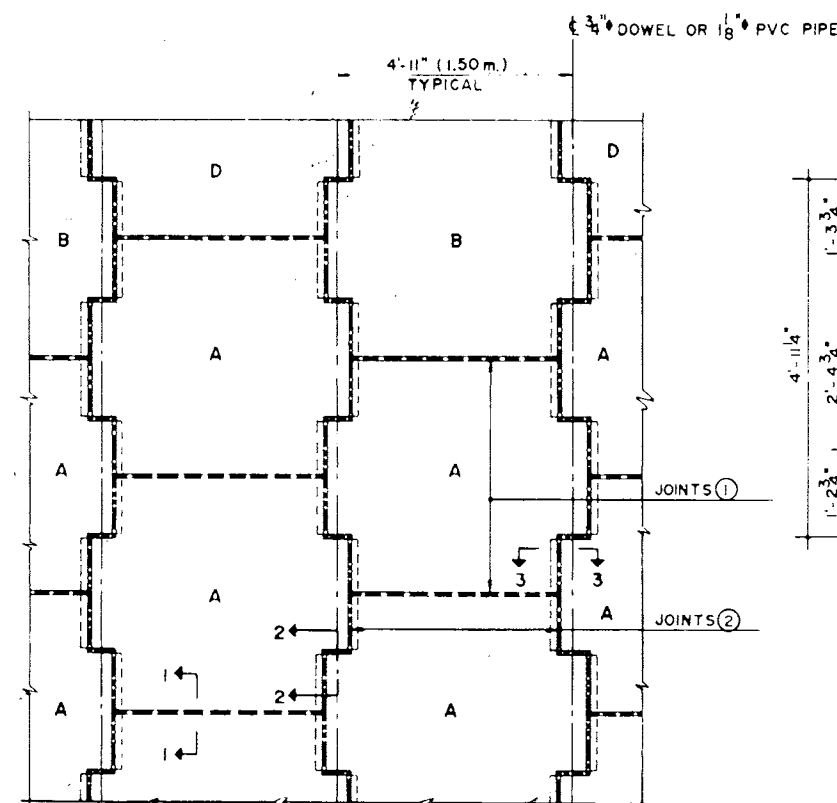


TYPICAL PANEL LAYOUT
SCALE: 1/2" = 1'-0"

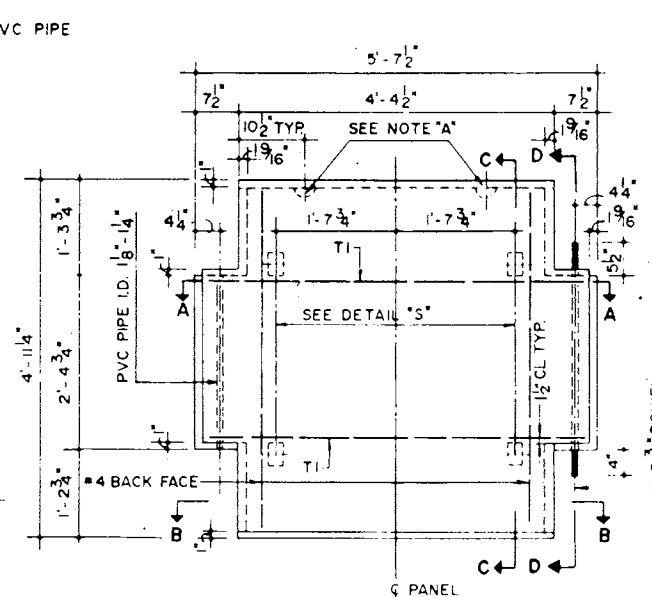


PANEL TYPE A&B
FRONT VIEW

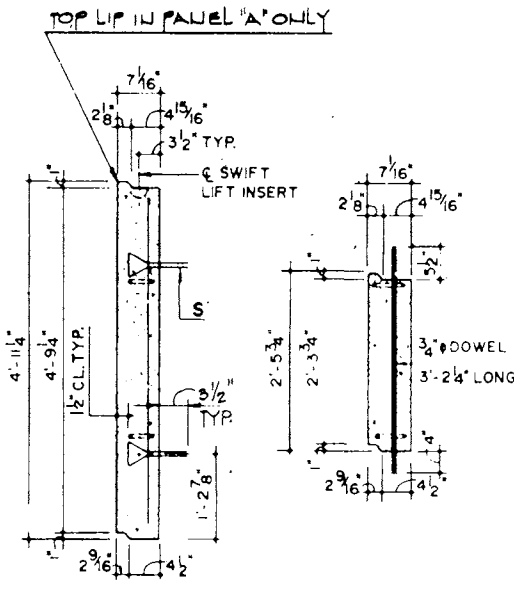


SECTION C-C SECTION D-D

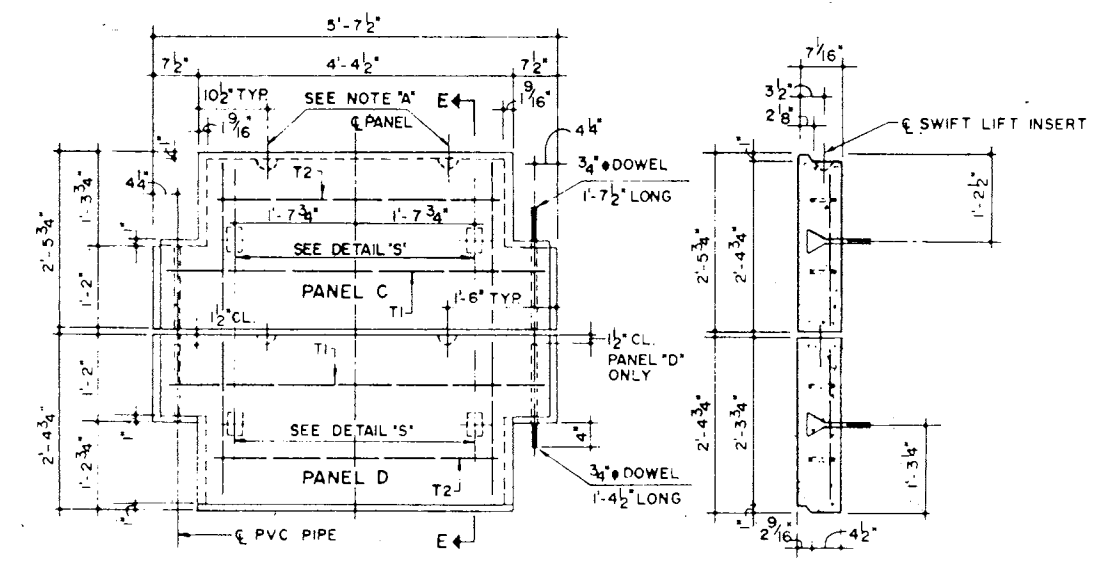

HALF PANELS C&D
FRONT VIEW

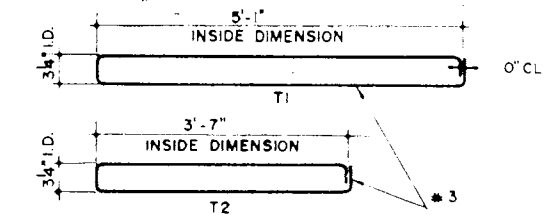


STIRRUP DETAILS
NOT TO SCALE

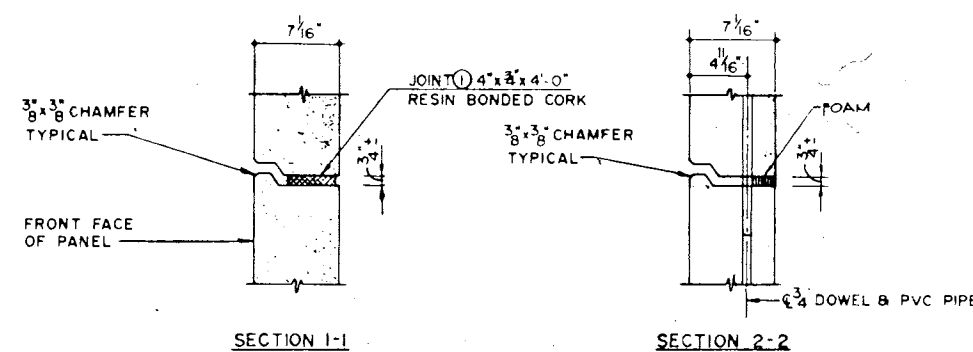


SECTION 1-1

SECTION 2-2

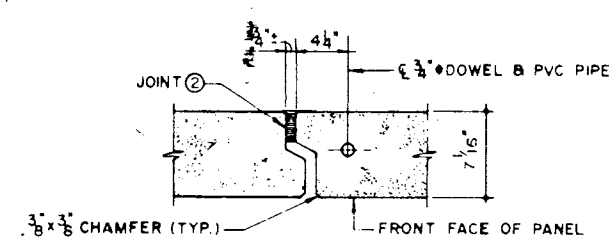


SECTION 3-3


JOINT DETAILS - SCALE: 1 1/2" = 1'-0"

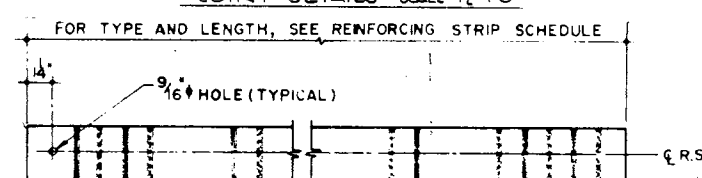

DETAIL OF REINFORCING STRIP
NOT TO SCALE

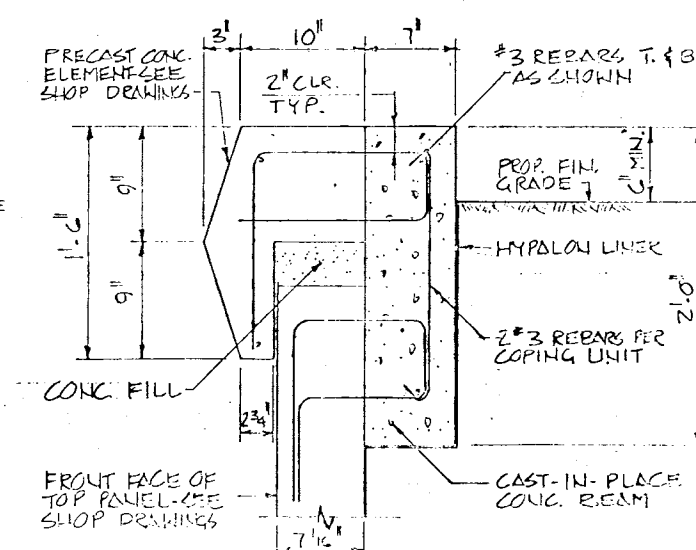

TYPICAL COPING DETAIL
SCALE: $1\frac{1}{2}'' = 1'-0''$

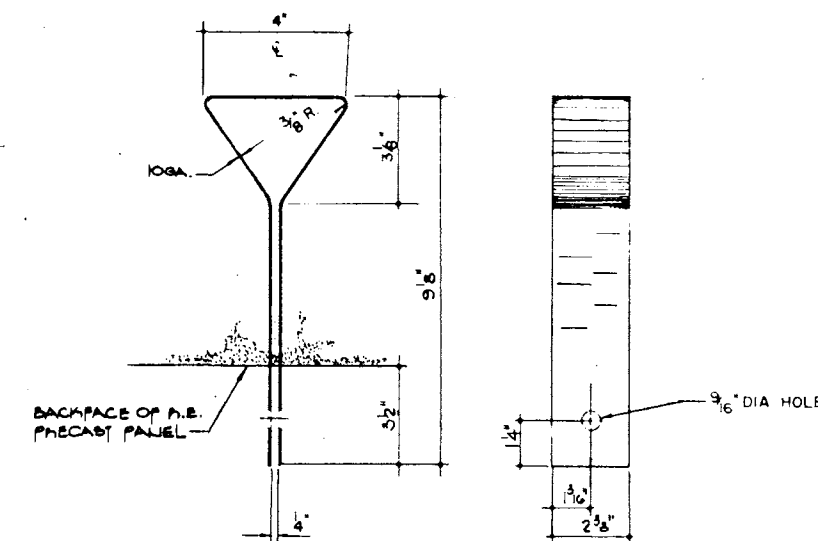

TIE STRIP DETAIL "S"
NOT TO SCALE

PANEL SURFACE AREA	
TYPE	SQ.FT
A	24.2
D	24.2
C	12.1
O	12.1

NOTE "A"



ONE TON SWIFT LIFT INSERTS $3\frac{3}{8}$ " x $3\frac{3}{8}$ " LONG AS
MANUFACTURED BY SUPERIOR CONC. ACCESSORIES.

NOTES:

1. REINFORCING BARS SHALL BE STEEL A615 GRADE 40
2. $\frac{1}{4}$ " CHAMFER SHALL BE PROVIDED ON ALL EXPOSED EDGES (FRONT FACE ONLY)
3. DETAILS NOT SHOWN WILL BE SUBMITTED AS SHOP DRAWINGS

As Built Drawing

Contract No. DACW 33-76-C-0098

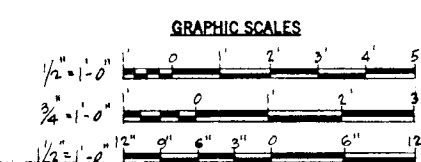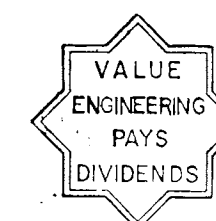

This drawing contains information proprietary to The Reinforced Earth Company, and is being furnished for the use of DEPT. OF ARMY, NEW HAVEN DIV., CORPS OF ENGRS. only in connection with this project, and the information contained herein is not to be transmitted to any other organization unless specifically authorized in writing by The Reinforced Earth Company.

The Reinforced Earth Company is exclusive licensee in the United States under patents issued to Henri Vidal, and the furnishing of this drawing does not constitute an express or implied license under the Vidal patents.

	13 JUN 79	Corner Details and notes deleted.	
REVISION	DATE	DESCRIPTION	BY

DEPARTMENT OF THE ARMY
NEW ENGLAND DIVISION
CORPS OF ENGINEERS
WALTHAM, MASS.

DES. BY <u>LBR</u> SUBMITTED <u>James S. Boat</u> CHIEF CIVIL ENG. SECTION APPROVAL RECOMMENDATION <u>Chief Marvin</u> CHIEF DESIGN BRANCH REVIEWED <u>James S. Boat</u> PROJECT MANAGER APPROVAL REQUESTED: CHIEF PROJECT BRANCH	WATER RESOURCES DEVELOPMENT PROJECT PARK RIVER LOCAL PROTECTION BOX CONDUIT AT SECTION 9 EAST FLOOD WALL DETAILS NO.2 HARTFORD CONNECTICUT APPROVED DATE <u>APRIL 1979</u> CHIEF, ENGINEERING DIVISION
--	---

SCALE AS SHOWN SPEC. NO. DACW33-76-B-0040	
DRAWING NUMBER	
PAR - I	

\$HEET 79B