



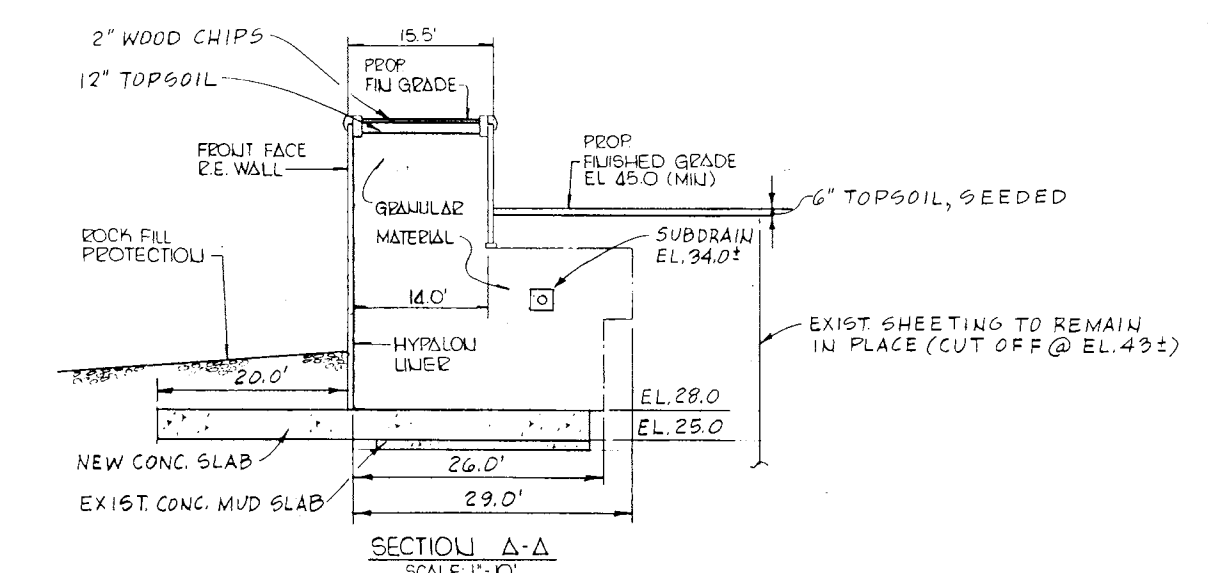

SECTION Δ-Δ
SCALE: 1" = 10'

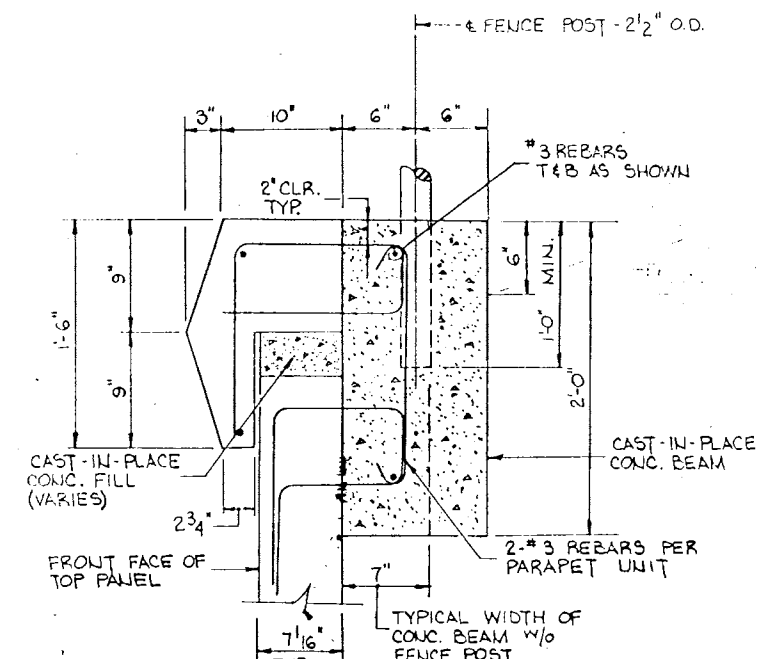


NOTES

1. ALL PANELS ARE TYPE 'A' UNLESS OTHERWISE NOTED
2. 1-8" WIDE STRIPS OF HYDRAULIC LINER SHALL BE PLACED ON INSIDE OF PANELS OVER ALL JOINTS THAT HAVE BEEN PREVIOUSLY COATED WITH PUIOBOND 5001 COMPOUND OR EQUAL. ALL STRIPS SHALL BE FIELD SPLIT AT THE STRIPS TO FIT. (OUTSIDE WALL ONLY)

As Built Drawing

Contract No. DACW 33-76-C-0088

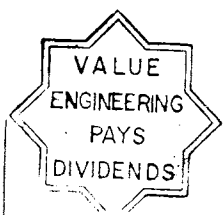


PANEL SCHEDULE																						
		STANDARD PANEL						90° BEUD PANEL			27.3' CUT PANEL				2G' CUT PANEL				2.43' NARROW PANEL			
TYPE	WtS	A	B	C	D	SP3	SP6	AB	BB	CB	AL	SP4L	AR	CR	SP3R	AL	DL	AR	DR	AW	BW	CW
P3	2	—	—	8	6	—	—	—	—	—	—	—	—	1	1	2	1	2	1	1	1	1
	3	—	—	—	—	—	—	—	—	2	4	—	4	—	—	—	—	—	—	—	—	—
	4	16	4	—	—	4	—	2	2	—	—	1	—	—	—	—	—	—	—	—	—	—
	5	4	—	—	—	—	—	—	—	—	—	—	—	—	—	—	—	—	—	—	—	—
	6	20	—	—	—	—	—	—	—	—	—	—	—	—	—	—	—	—	—	—	—	—
	7	—	—	—	—	—	—	—	—	—	—	—	—	—	—	—	—	—	—	—	—	—
	8	—	—	—	—	—	4	—	—	—	—	—	—	—	—	—	—	—	—	—	—	—
	9	8	—	—	—	—	—	—	—	—	—	—	—	—	—	—	—	—	—	—	—	—
	SQ. FT. PER PANEL		24.2	24.2	12.1	12.1	17.9	30.0	24.2	24.2	12.1	13.4	16.6	13.4	6.7	9.9	12.8	6.4	12.8	6.4	12.2	12.2

REIN. STRIP SCHEDULE			
TYPE \ LENGTH	14'	26'	29'
60x5mm	286	46	106

WALL SURFACE AREA= 1975.3 SQ. FT.

GRAPHIC SCALES

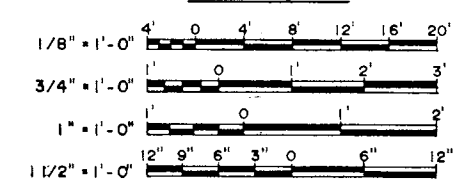

This drawing contains information proprietary to The Reinforced Earth Company, and is being furnished for the use of DEPT OF ARMY, NEW ENGLAND, CORPS OF ENGINEERS only in connection with this project, and the information contained herein is not to be transmitted to any other organization unless specifically authorized in writing by The Reinforced Earth Company.

The Reinforced Earth Company is exclusive licensee in the United States under patents issued to Henri Vidal, and the furnishing of this drawing does not constitute an express or implied license under the Vidal patents.

[illegible]