

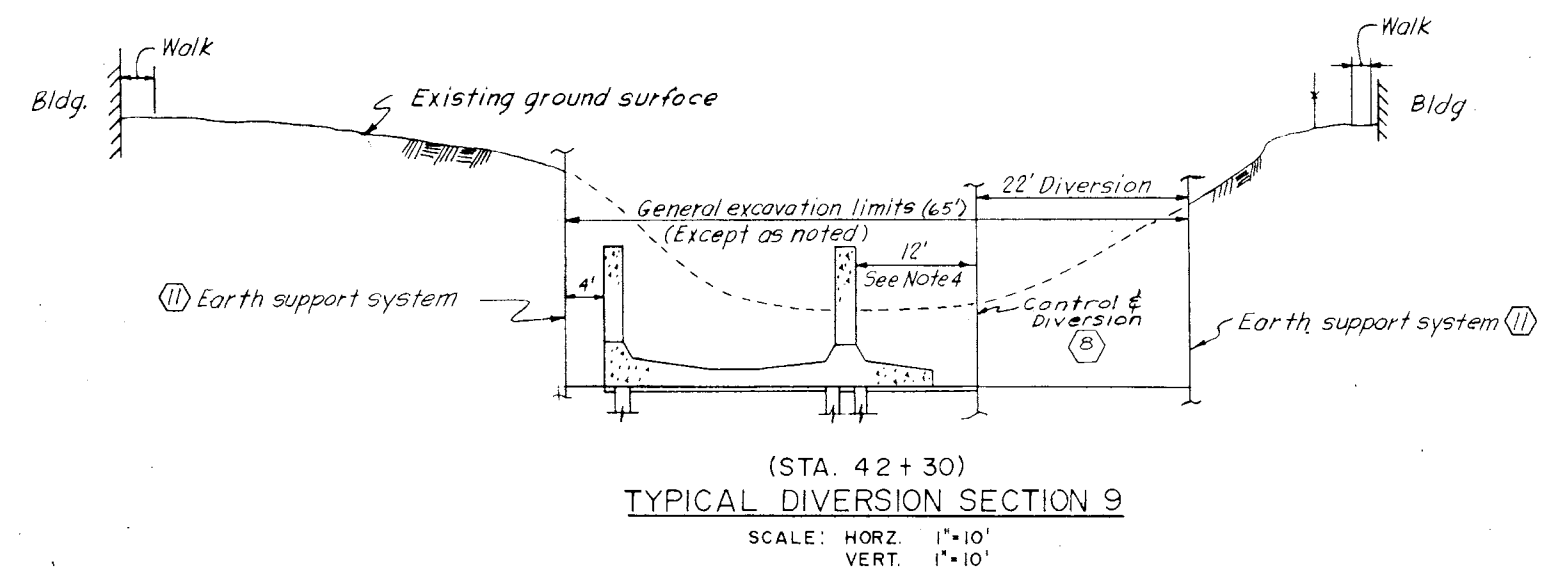


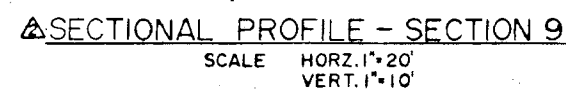

(STA. 42 + 30)
TYPICAL DIVERSION SECTION 9
 SCALE: HORZ. 1" = 10'
 VERT. 1" = 10'

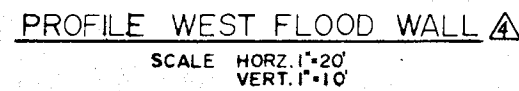

As Built Drawing

Contract No. DACW 33-76-C-0098

[illegible]