

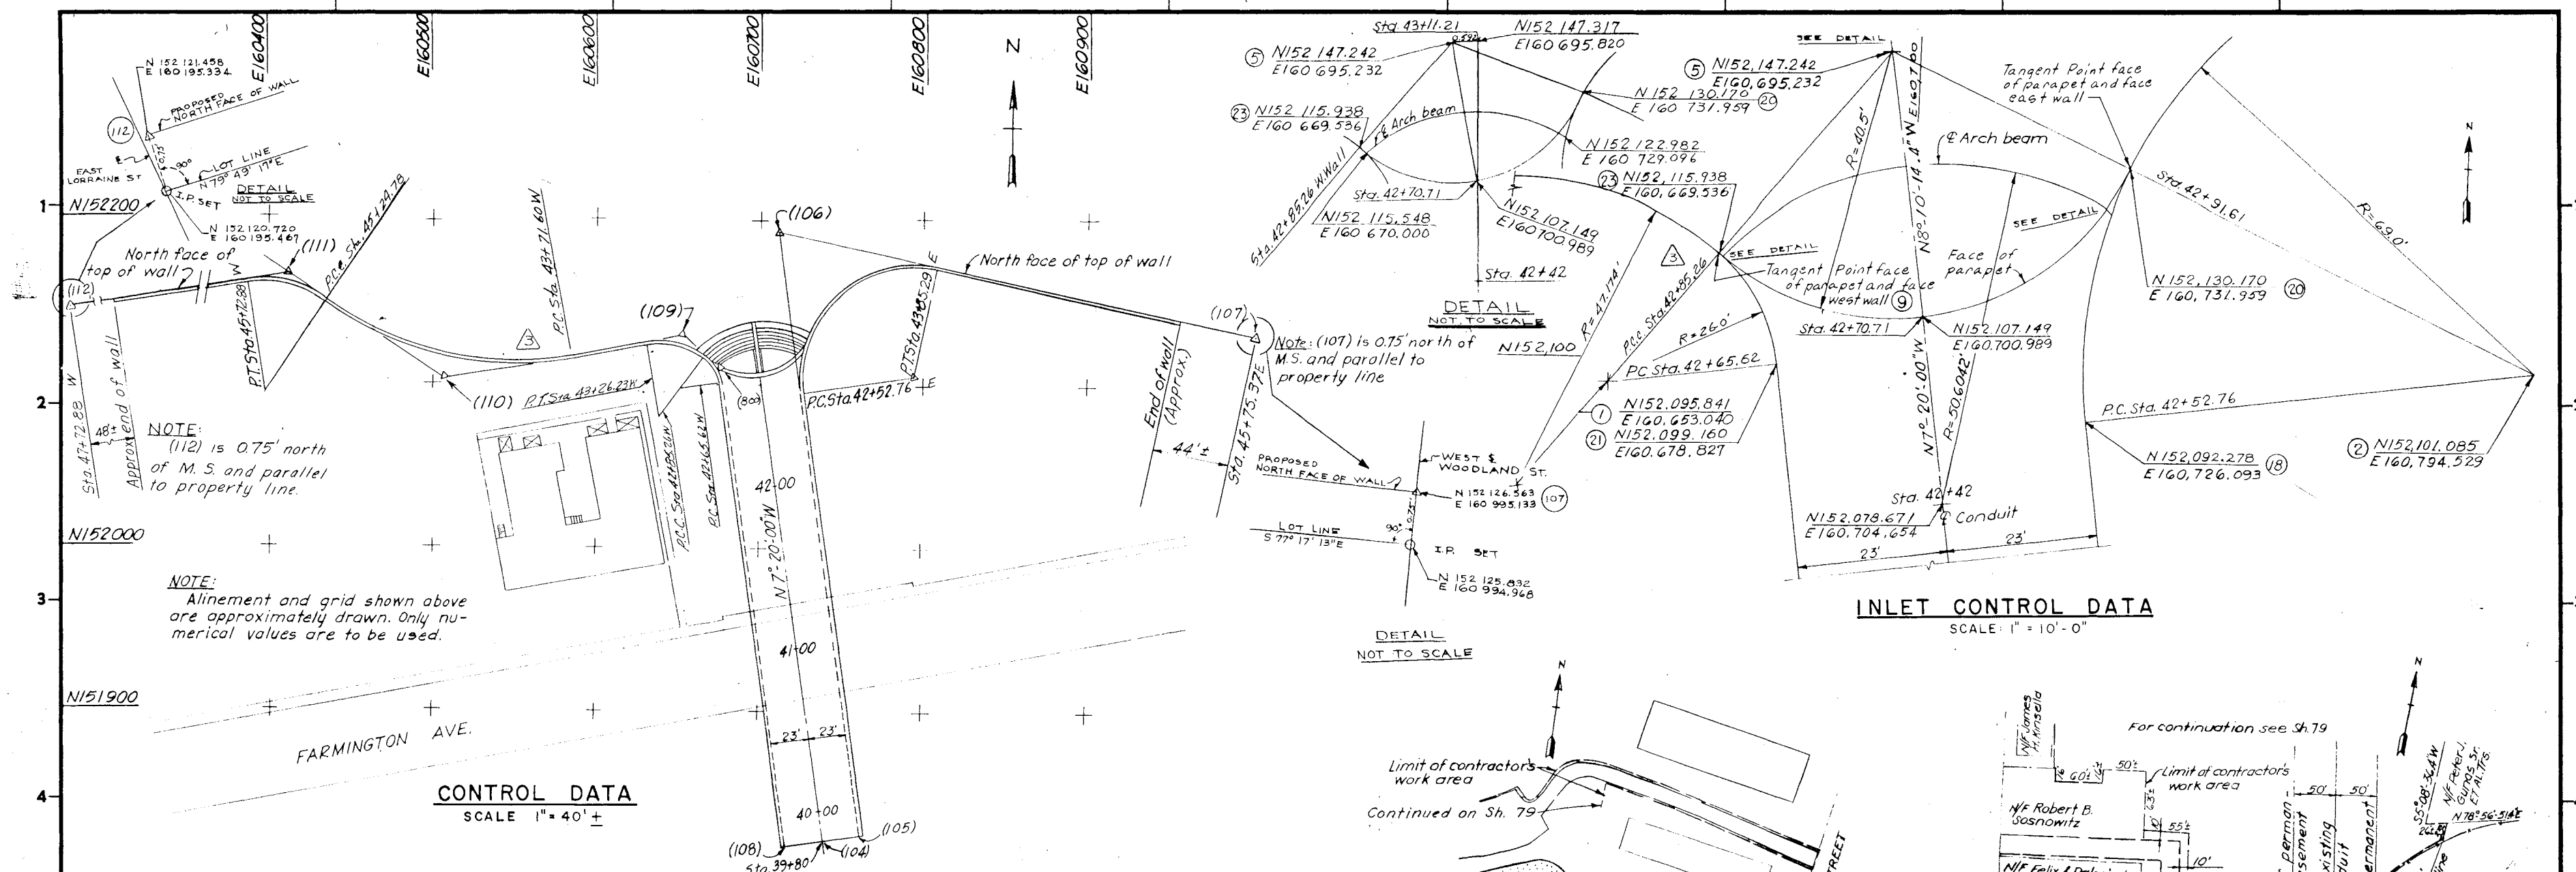
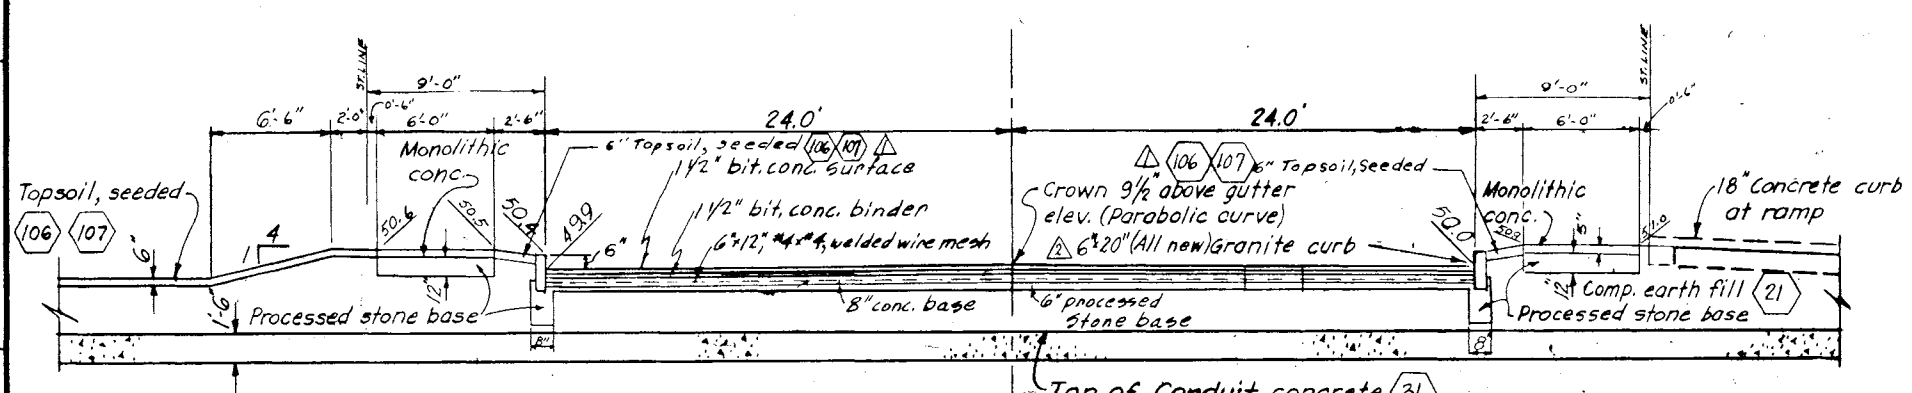



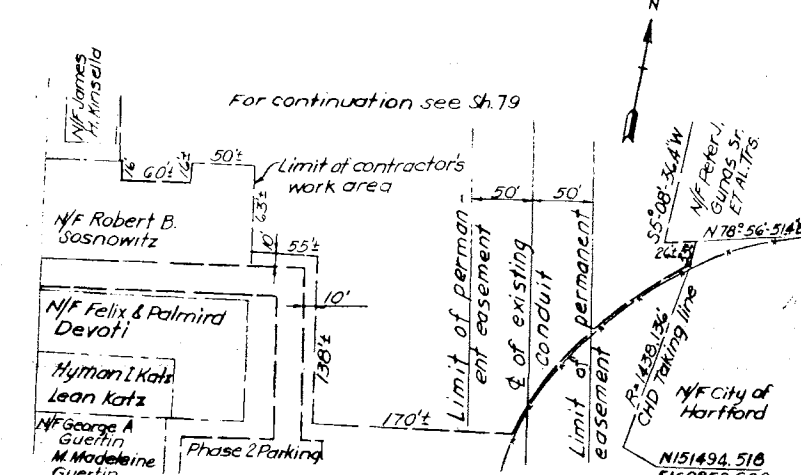


PT. NO.	COORDINATES		DIST.	BEARING	CURVE DATA							P.C. Sta.	P.T. Sta.
	NORTH	EAST			T	R	L.C.	Δ					
108	151815.878	160715.284	295.934	N7°20'00"W	10.317	26.0	14.643	43-17-12.1				42+85.62	42+85.26W
800*	152109.392	160677.511	32.195	N50°37'11"W	21.878	47.17	40.970	49-45-41.4				42+85.26	43+26.23W
109	152129.819	160652.626	147.816	S79°37'06"W	80.569	200.00	153.183	43-53-01.5				43+71.60W	45+24.78W
110	152103.182	160507.229	105.852	N56°29'51.7"E	26.051	65.00	49.554	43-40-71.3				45+24.78W	45+72.88W
111	152161.609	160418.963	227.205	S79°49'16"W									
112	152121.458	160195.334											
104	151818.570	160738.066											
105*	151821.750	160760.908	371.386	N7°20'00"W	98.627	69.0	132.526	110-02-47				42+52.76E	43+85.29E
106	152130.898	160713.504	288.707	S77°17'13"E									
107	152126.563	160995.133											
*	Indicates a P.I. point												

DETAIL
NOT TO SCALE

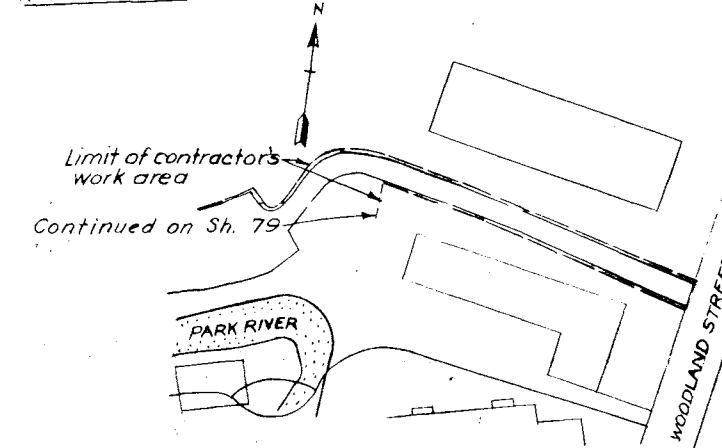

- NOTES:**
- For Driveway Ramps see Typical Section - Broad St. Driveway Ramp on Sh. 15
 - For electric, telephone, water and gas relocations under Farmington Ave. see Sheets 95 and 123.

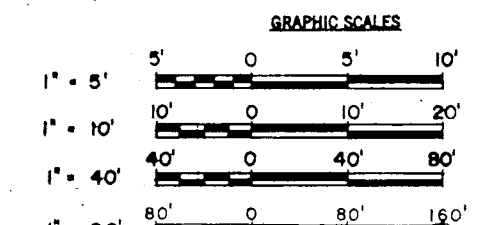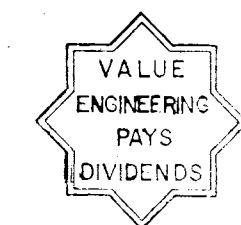

As Built Drawing
Contract No. DACW 33-76-C-0088

REVISION	DATE	DESCRIPTION	BY
1	13 Oct 77	West wall alignment changed	W. H. H. Jr.
2	14 June 76	Revised size of granite curb (Am #3)	W. H. H. Jr.
3	14 June 76	Added Bid item No. (Am #2)	W. H. H. Jr.

DEPARTMENT OF THE ARMY
NEW ENGLAND DIVISION
CORPS OF ENGINEERS
WATERBURY, MASS.

WATER RESOURCES DEVELOPMENT PROJECT
PARK RIVER LOCAL PROTECTION
BOX CONDUIT AT SECTION 9
CONTROL DATA & MISCELLANEOUS DETAILS

HARTFORD CONNECTICUT
DATE MARCH 1976

SCALE AS SHOWN SPEC. NO. DACW 33-76-B-0040
DRAWING NUMBER
PAR-1
SHEET 88