

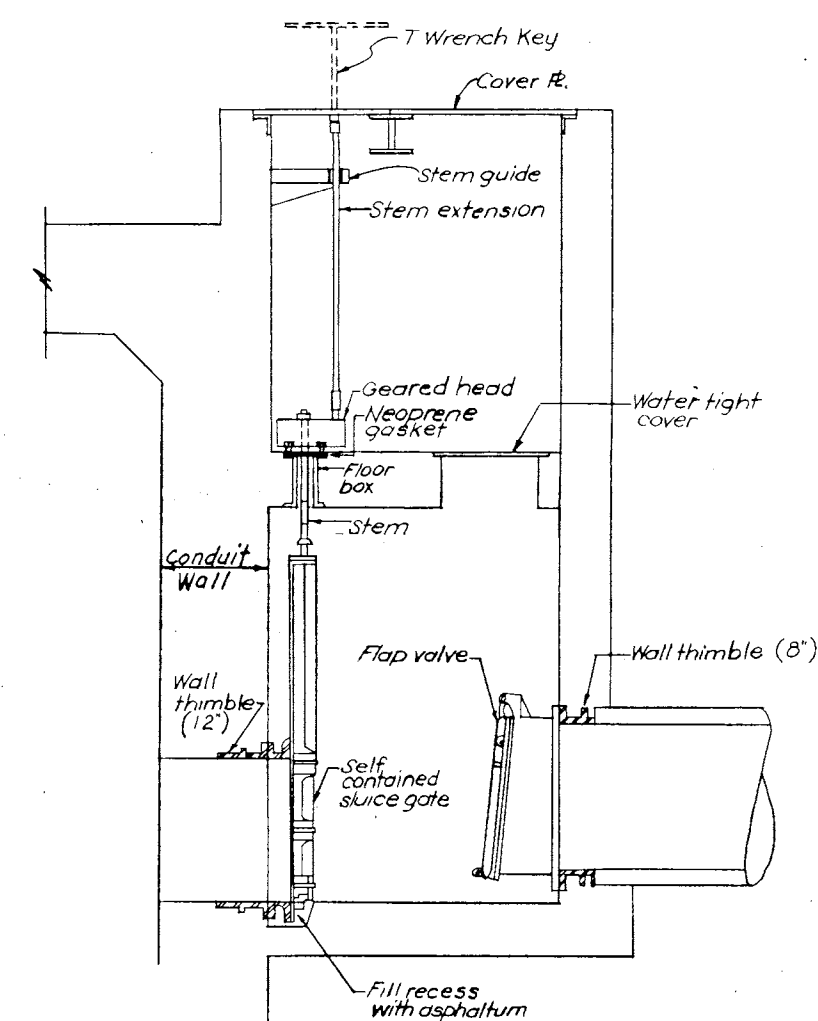
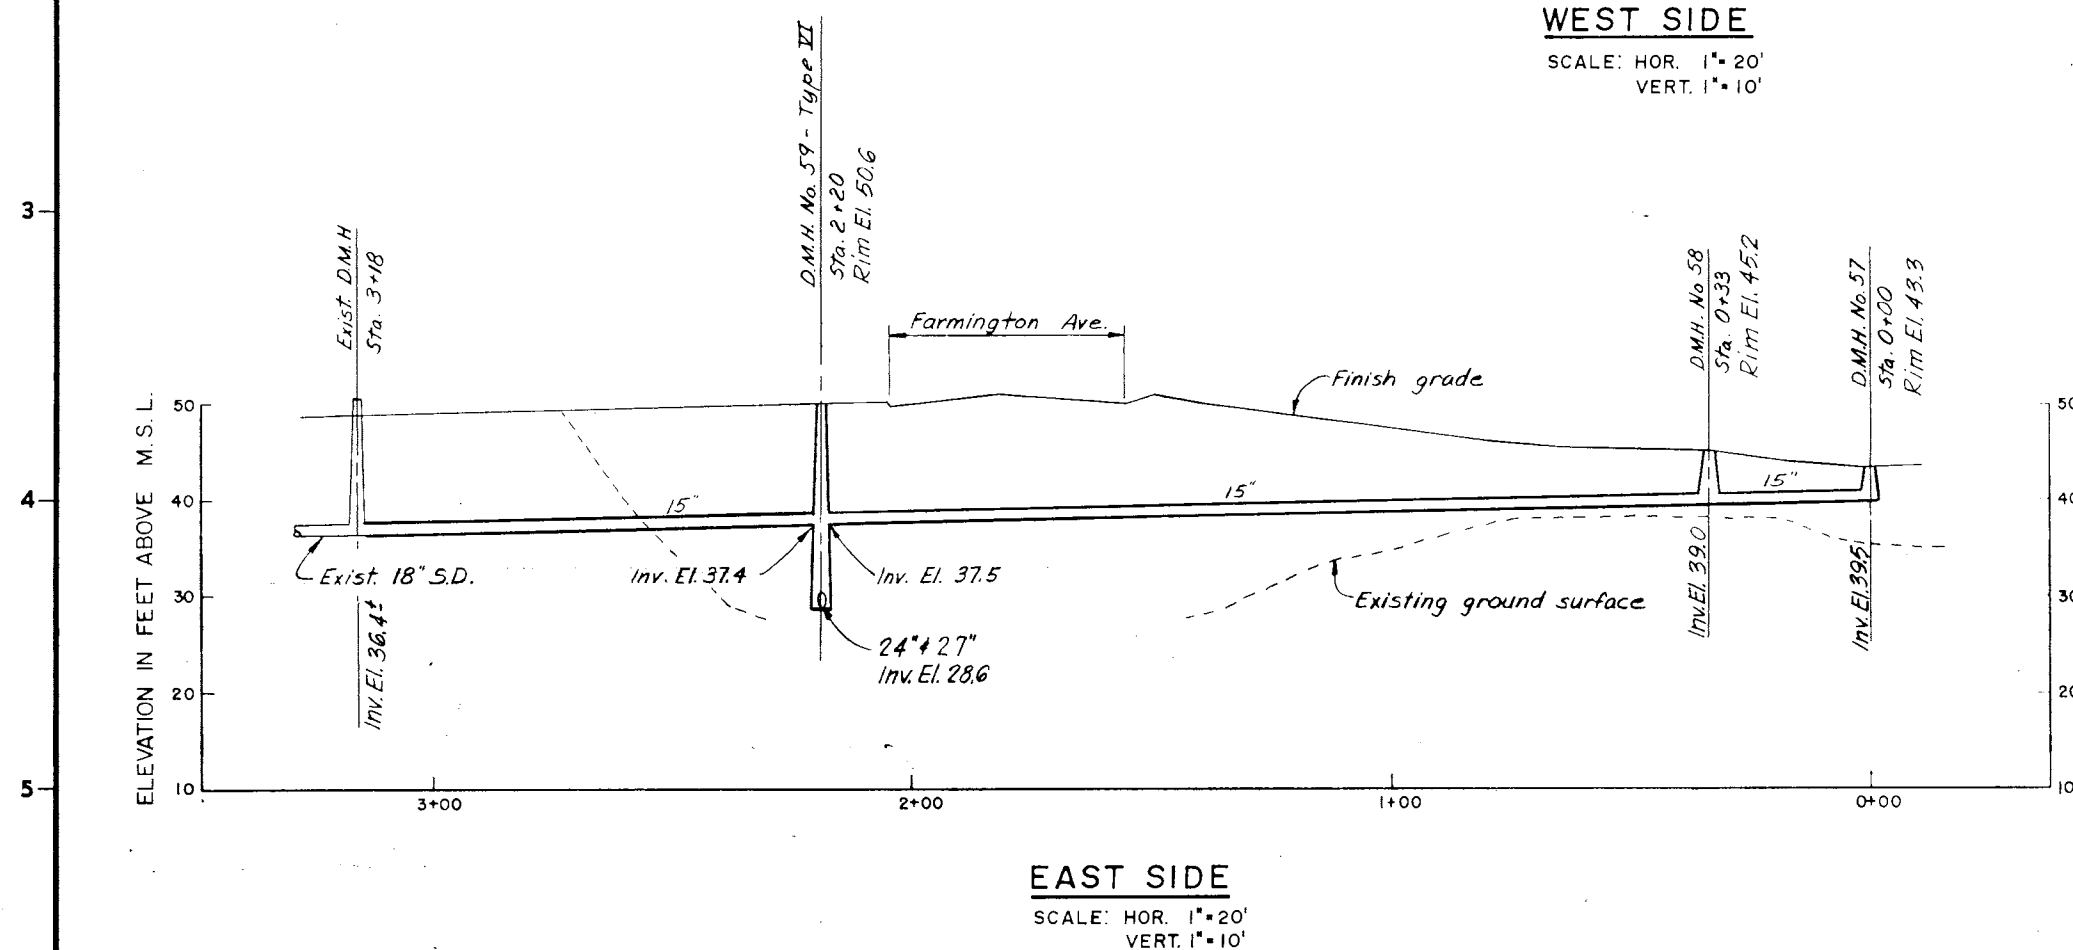
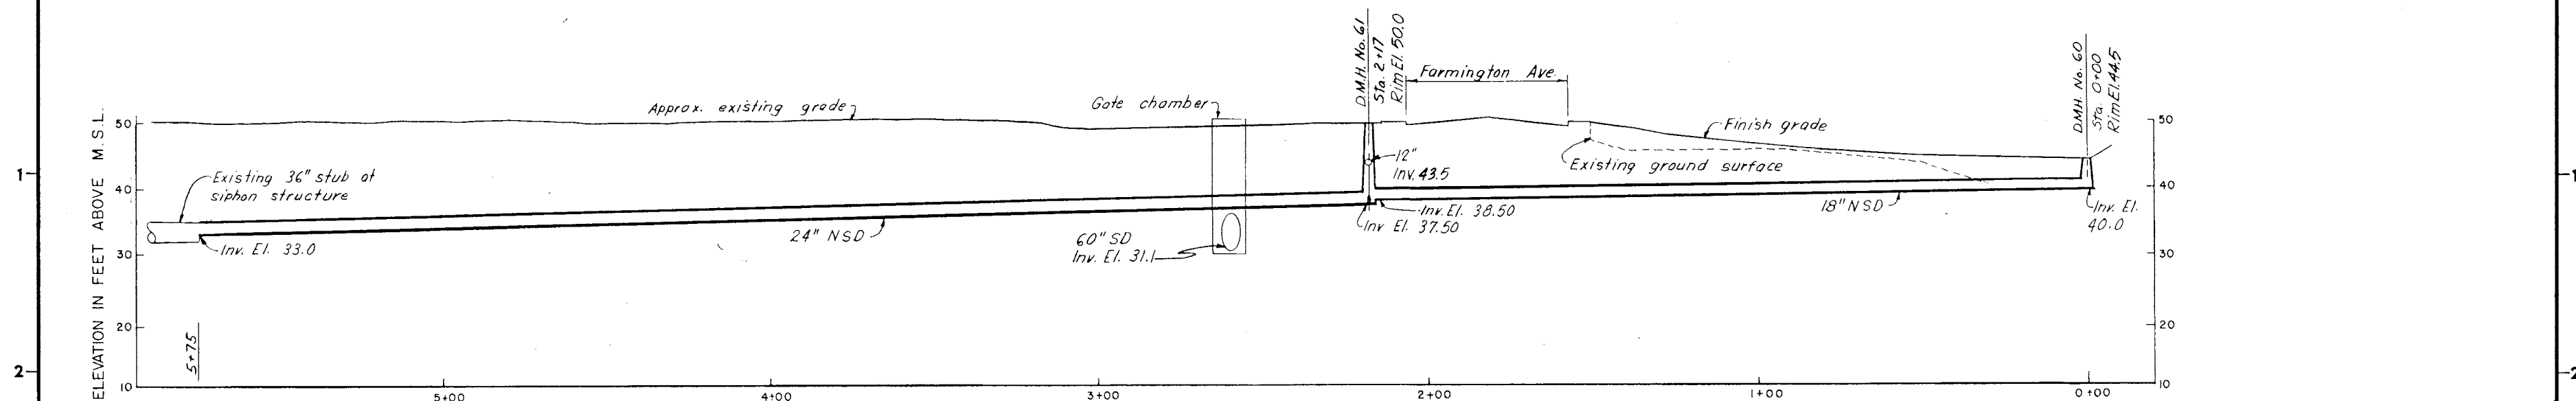


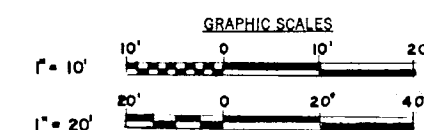

NOTES:

1. For location of low level drains see Sheet 79.
2. All manholes shall be Type II unless otherwise noted.
3. Drain MH No. 59 changed from Type II to II.

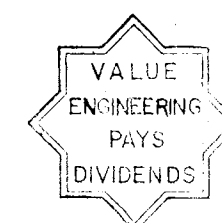

As Built Drawing

Contract No. DACW 33-76C-0098

REVISION	DATE	DESCRIPTION	BY
4-4-83		Final field corrections	

DES. BY W. F.		DR. BY W. F.	CK. BY W. F.
SUBMITTED R. H. Smith		CHIEF, UTILITIES SECTION	
APPROVAL, RECOMMENDED J. H. Jones		CHIEF, TECH. ENG. BRANCH	
REVIEWED J. H. Jones		PROJECT ENGINEER	
APPROVAL, RECOMMENDED J. H. Jones		CHIEF, PROJECT BRANCH	

DEPARTMENT OF THE ARMY NEW ENGLAND DIVISION CORPS OF ENGINEERS WALTHAM, MASS.	
WATER RESOURCES DEVELOPMENT PROJECT PARK RIVER LOCAL PROTECTION BOX CONDUIT AT SECTION 9 LOW LEVEL DRAINAGE PROFILES	
HARTFORD	CONNECTICUT
APPROVED J. H. Jones	DATE MARCH 1976
SCALE AS SHOWN SPEC. NO. DACW 33-76-B-0040	
DRAWING NUMBER PAR - 1	