




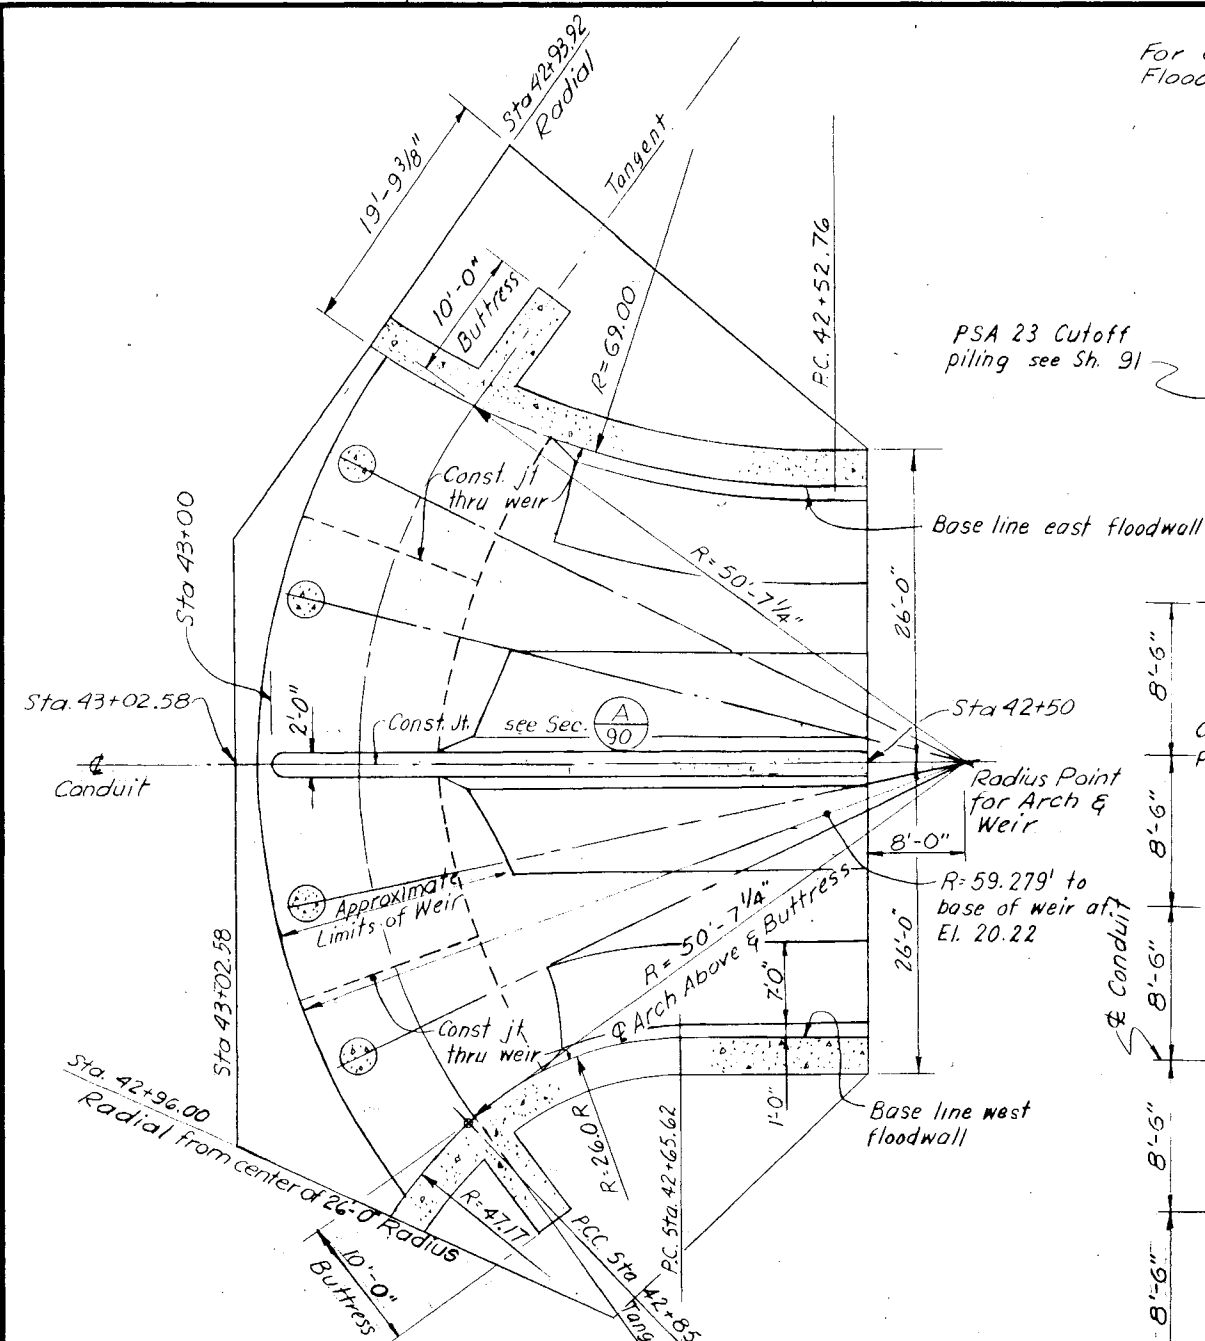


△ BASE ALIGNMENT PLAN △
SCALE 1/8" = 1'-0"

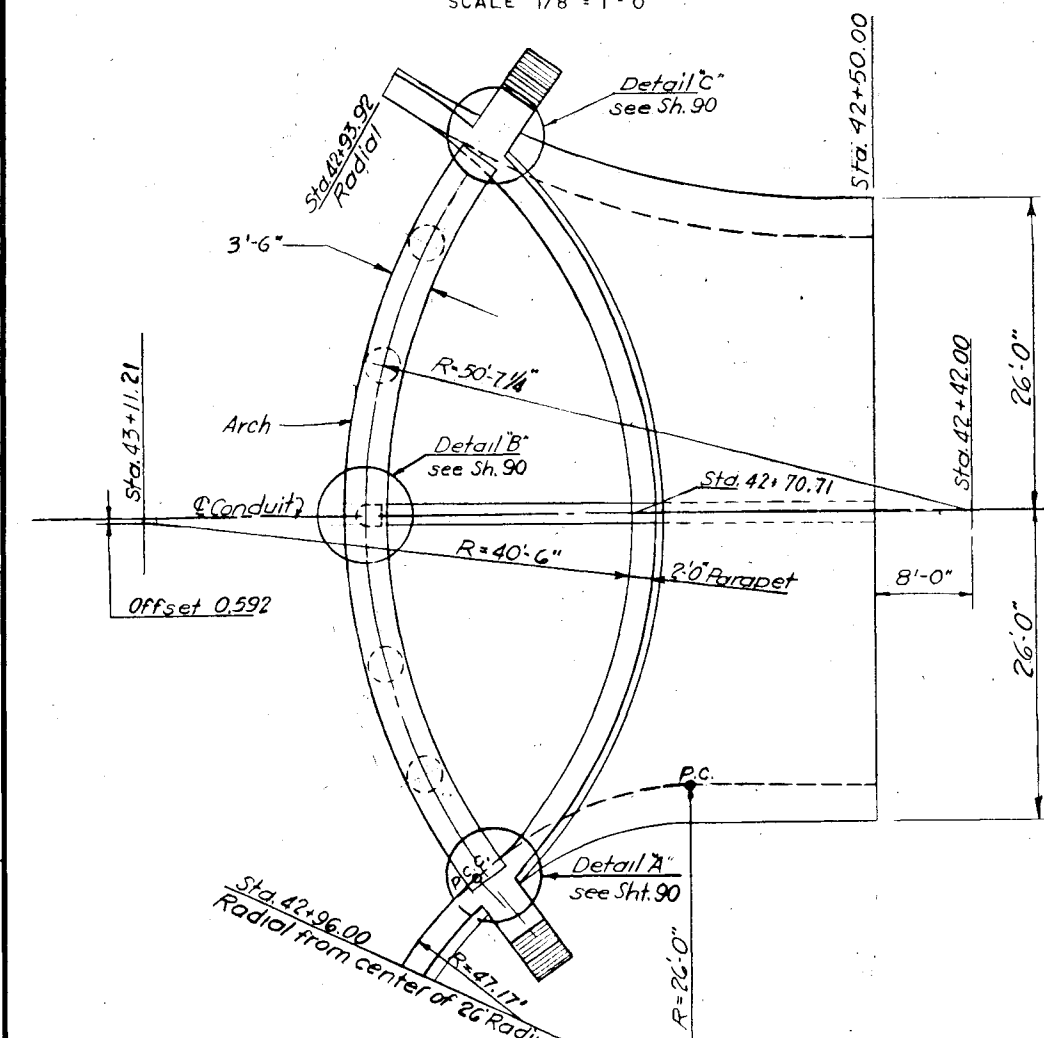

△ ROOF ALIGNMENT PLAN △
SCALE 1/8" = 1'-0"

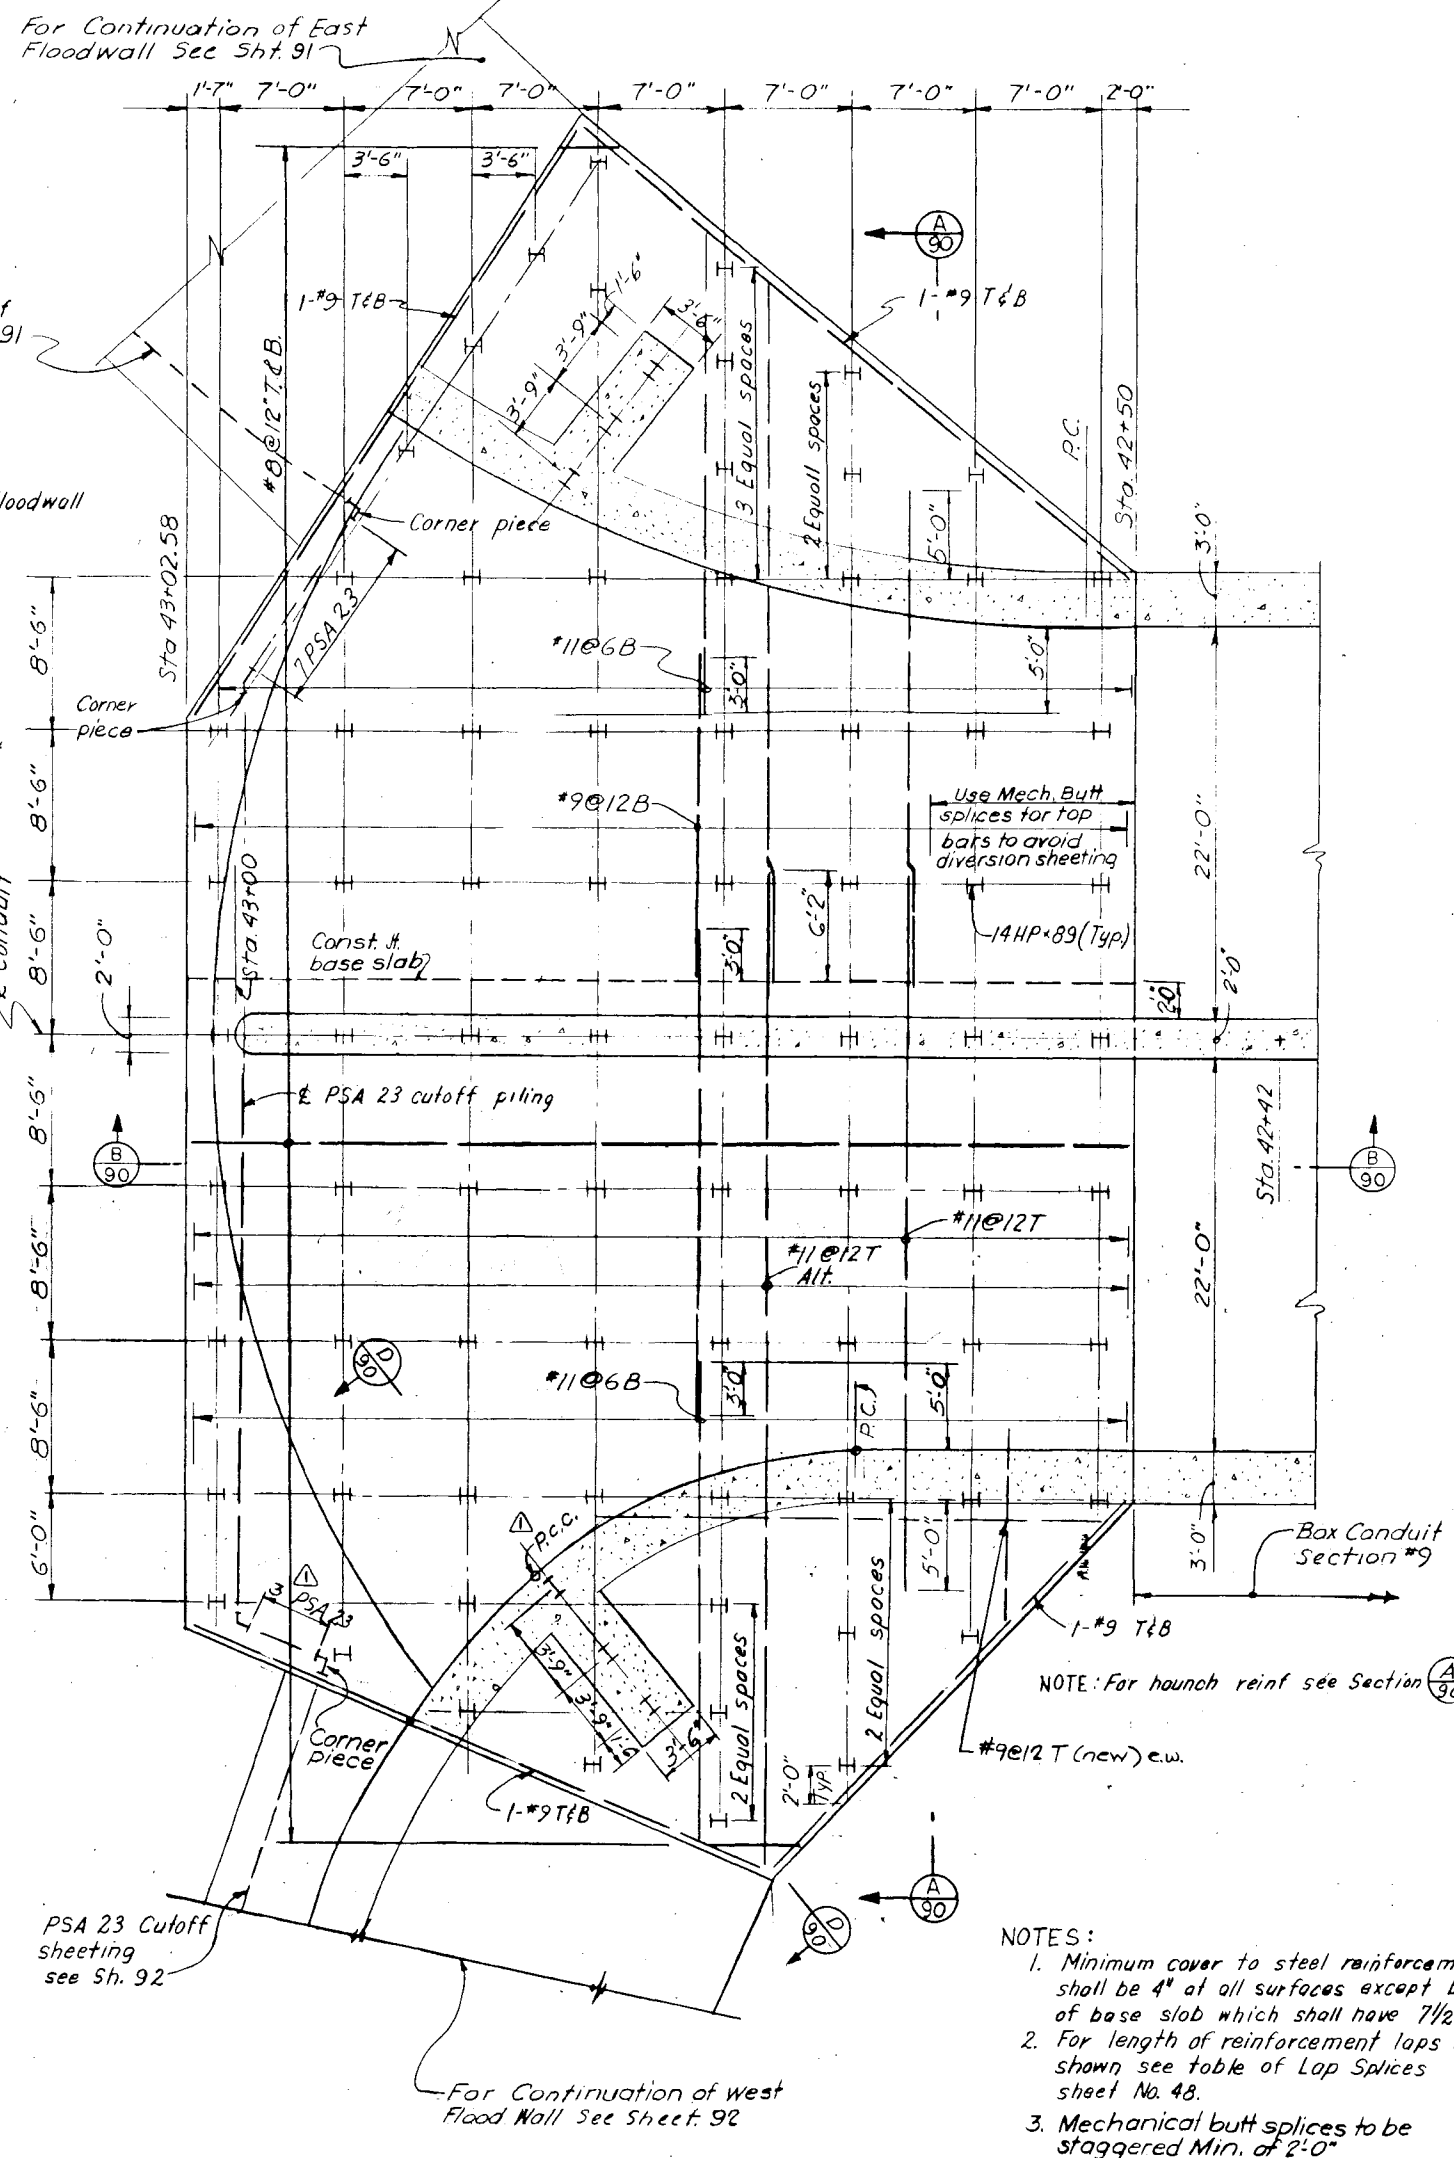

△ PILE AND FOUNDATION PLAN △
SCALE 3/16" = 1'-0"

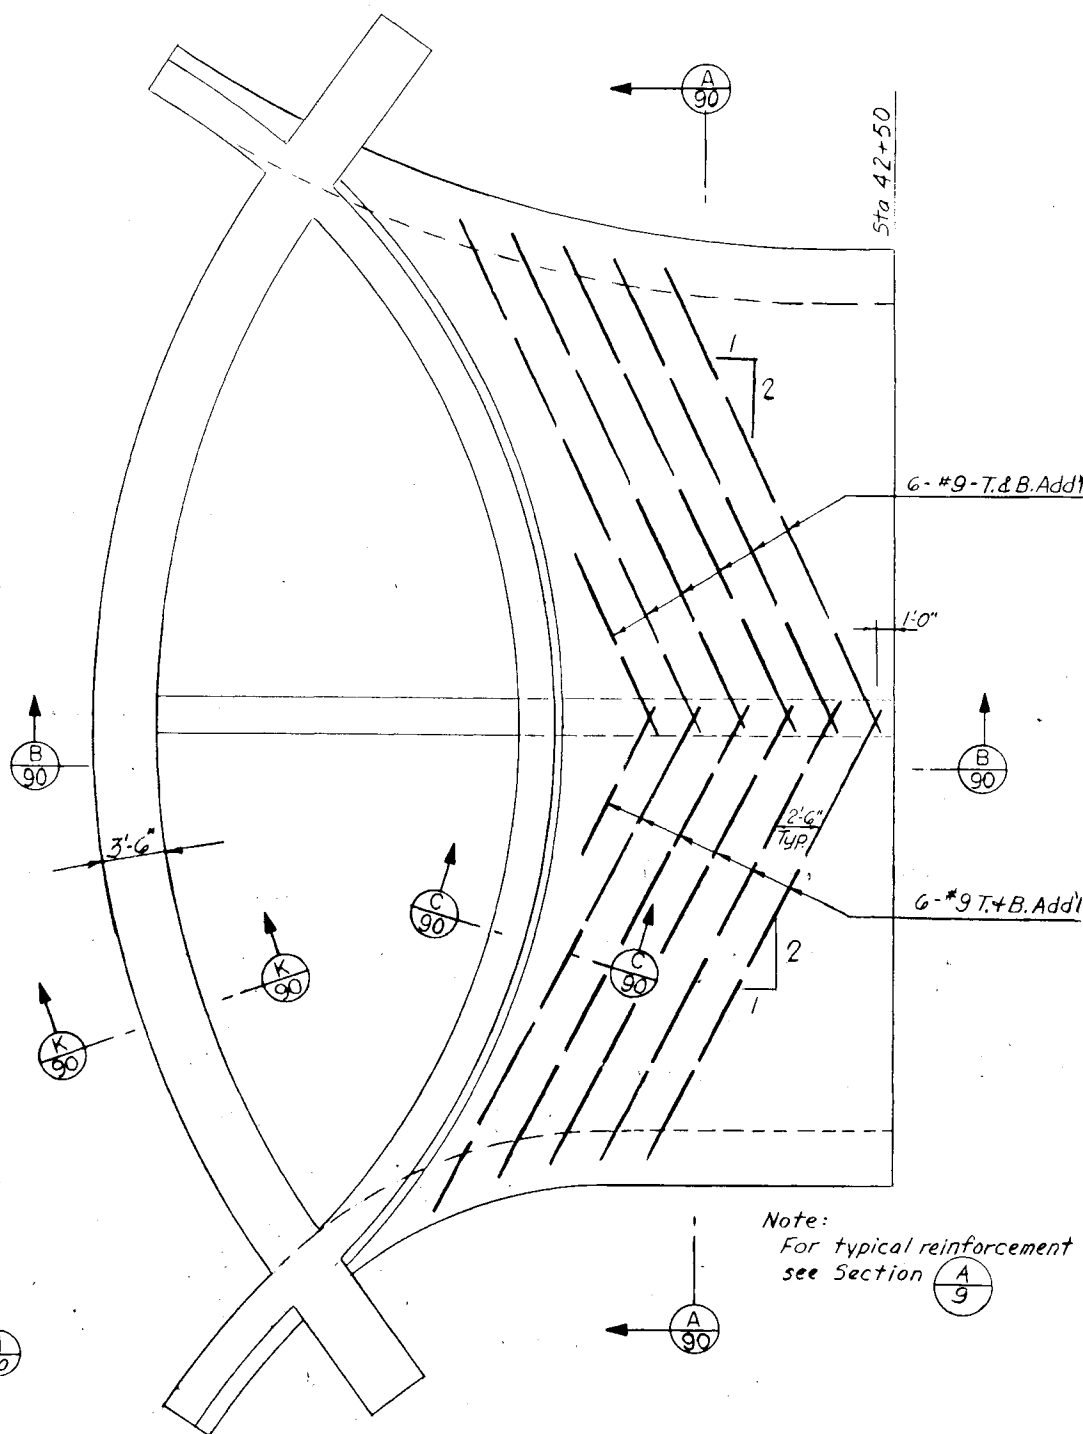


△ ROOF REINFORCING PLAN △
SCALE 3/16" = 1'-0"

As Built Drawing

Contract No. DACW 33-76-C-0098

- NOTES:
1. Minimum cover to steel reinforcement shall be 4" at all surfaces except bottom of base slab which shall have 7 1/2" cover.
 2. For length of reinforcement laps not shown see table of Lap Splices sheet No. 48.
 3. Mechanical butt splices to be staggered Min. of 2'-0"

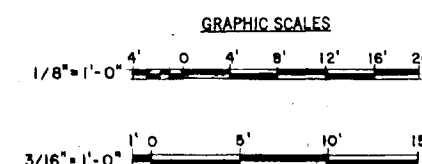

DES. BY R.H.		DR. BY W.F.		CK. BY W.F.	
SUBMITTED 12 Jan 79		13 Oct 77		20 Feb 79	
CHIEF, STRUC. SECTION		CHIEF, TECH. ENG. BRANCH		CHIEF, PROJECT BRANCH	
APPROVAL/RECOMMENDATION [Signature]		APPROVED [Signature]		DATE MARCH 1976	
DEPARTMENT OF THE ARMY NEW ENGLAND DIVISION CORPS OF ENGINEERS WALTHAM, MASS.		WATER RESOURCES DEVELOPMENT PROJECT PARK RIVER LOCAL PROTECTION INLET STRUCTURE PILE PLAN AND REINFORCEMENT DETAILS		HARTFORD CONNECTICUT	
SCALE AS SHOWN SPEC. NO. DACW 33-76-B-0040		DRAWING NUMBER PAR-1		SHEET 89	