


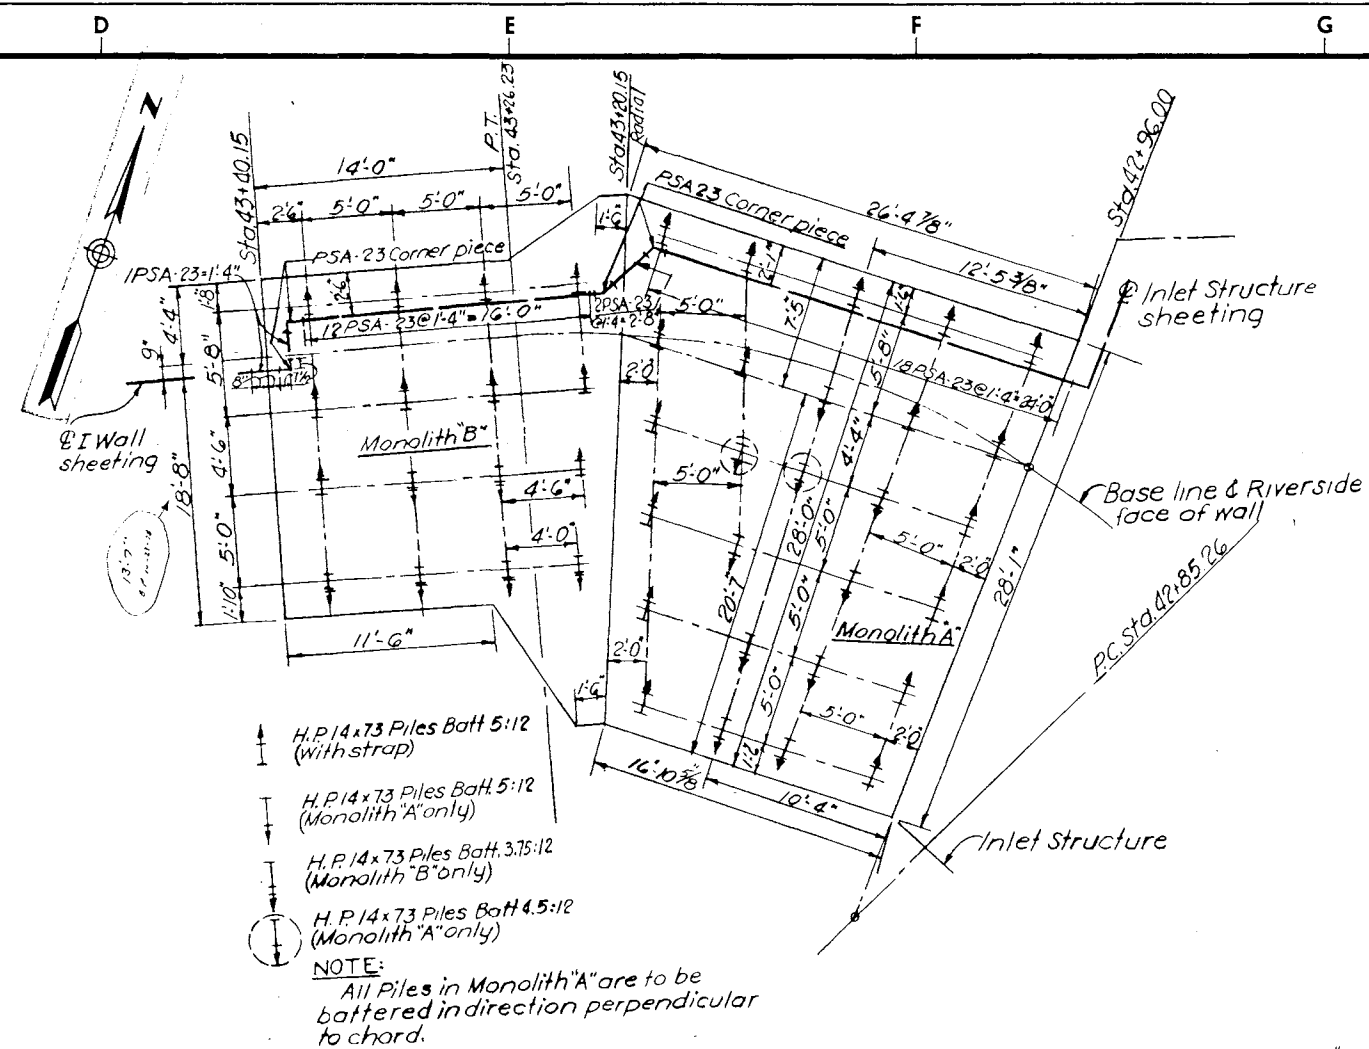

2-2"x3/8" straps welded to each pile

Top of conc slab

Typ.

1/4"

SECTION F-F


TYPICAL PILE STRAP ANCHORAGE

NOT TO SCALE



NOTES:

1. For section C-C, see sheet 91, typical Inlet T-wall transition.
2. For general notes see sheet 91.

* Top bars are horizontal bars so placed that more than 12" of concrete is cast in the member below the bar.

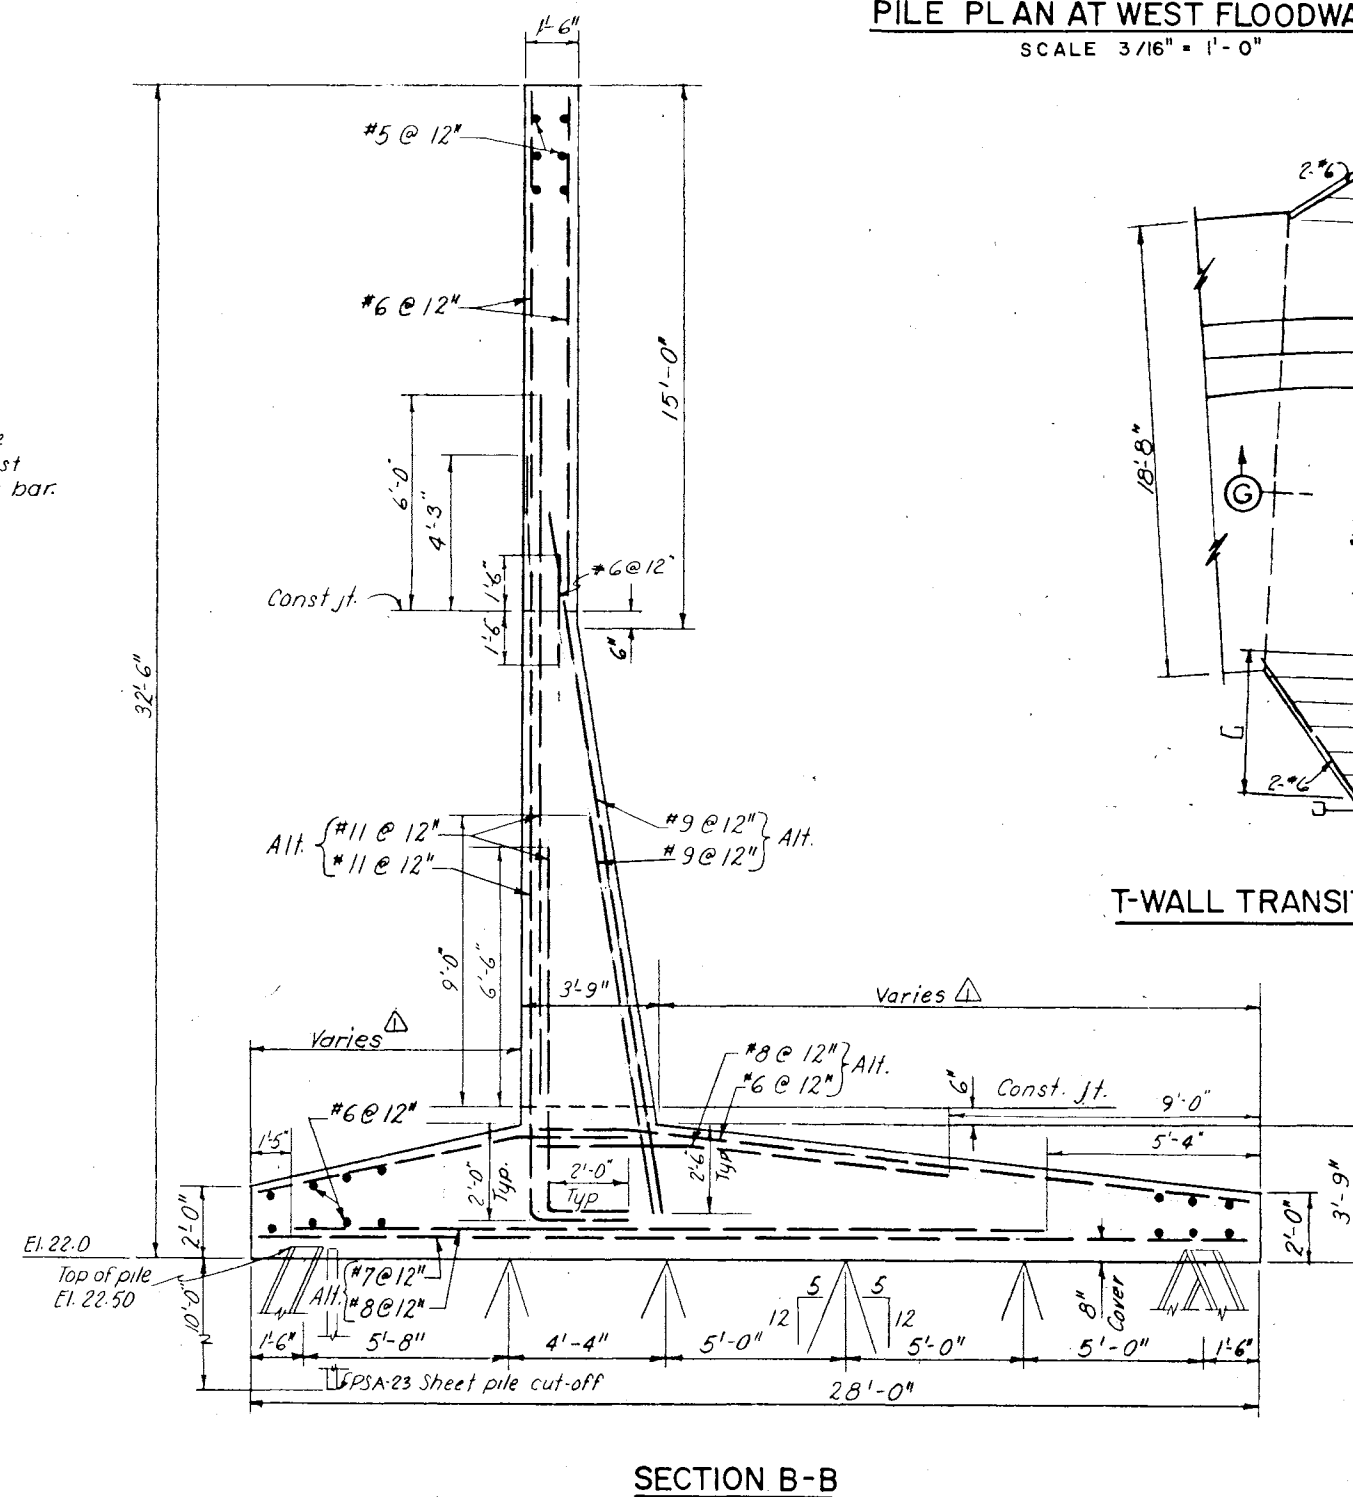

T-WALL TRANSITION AT STA. 43+20.15

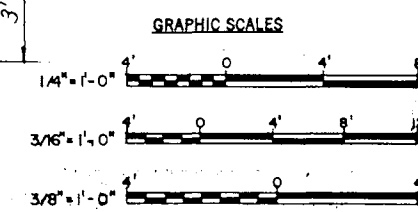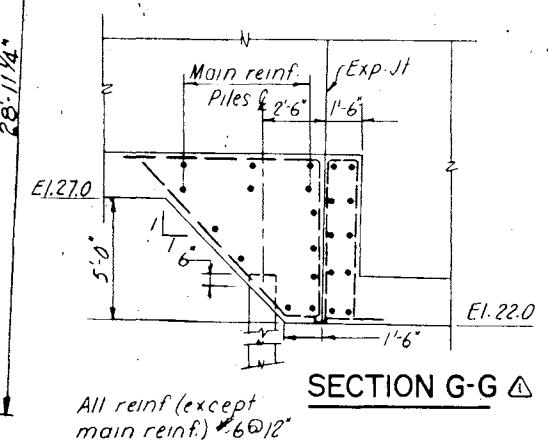

As Built Drawing
Contract No. DCTC 3376-C-0098

[illegible]