


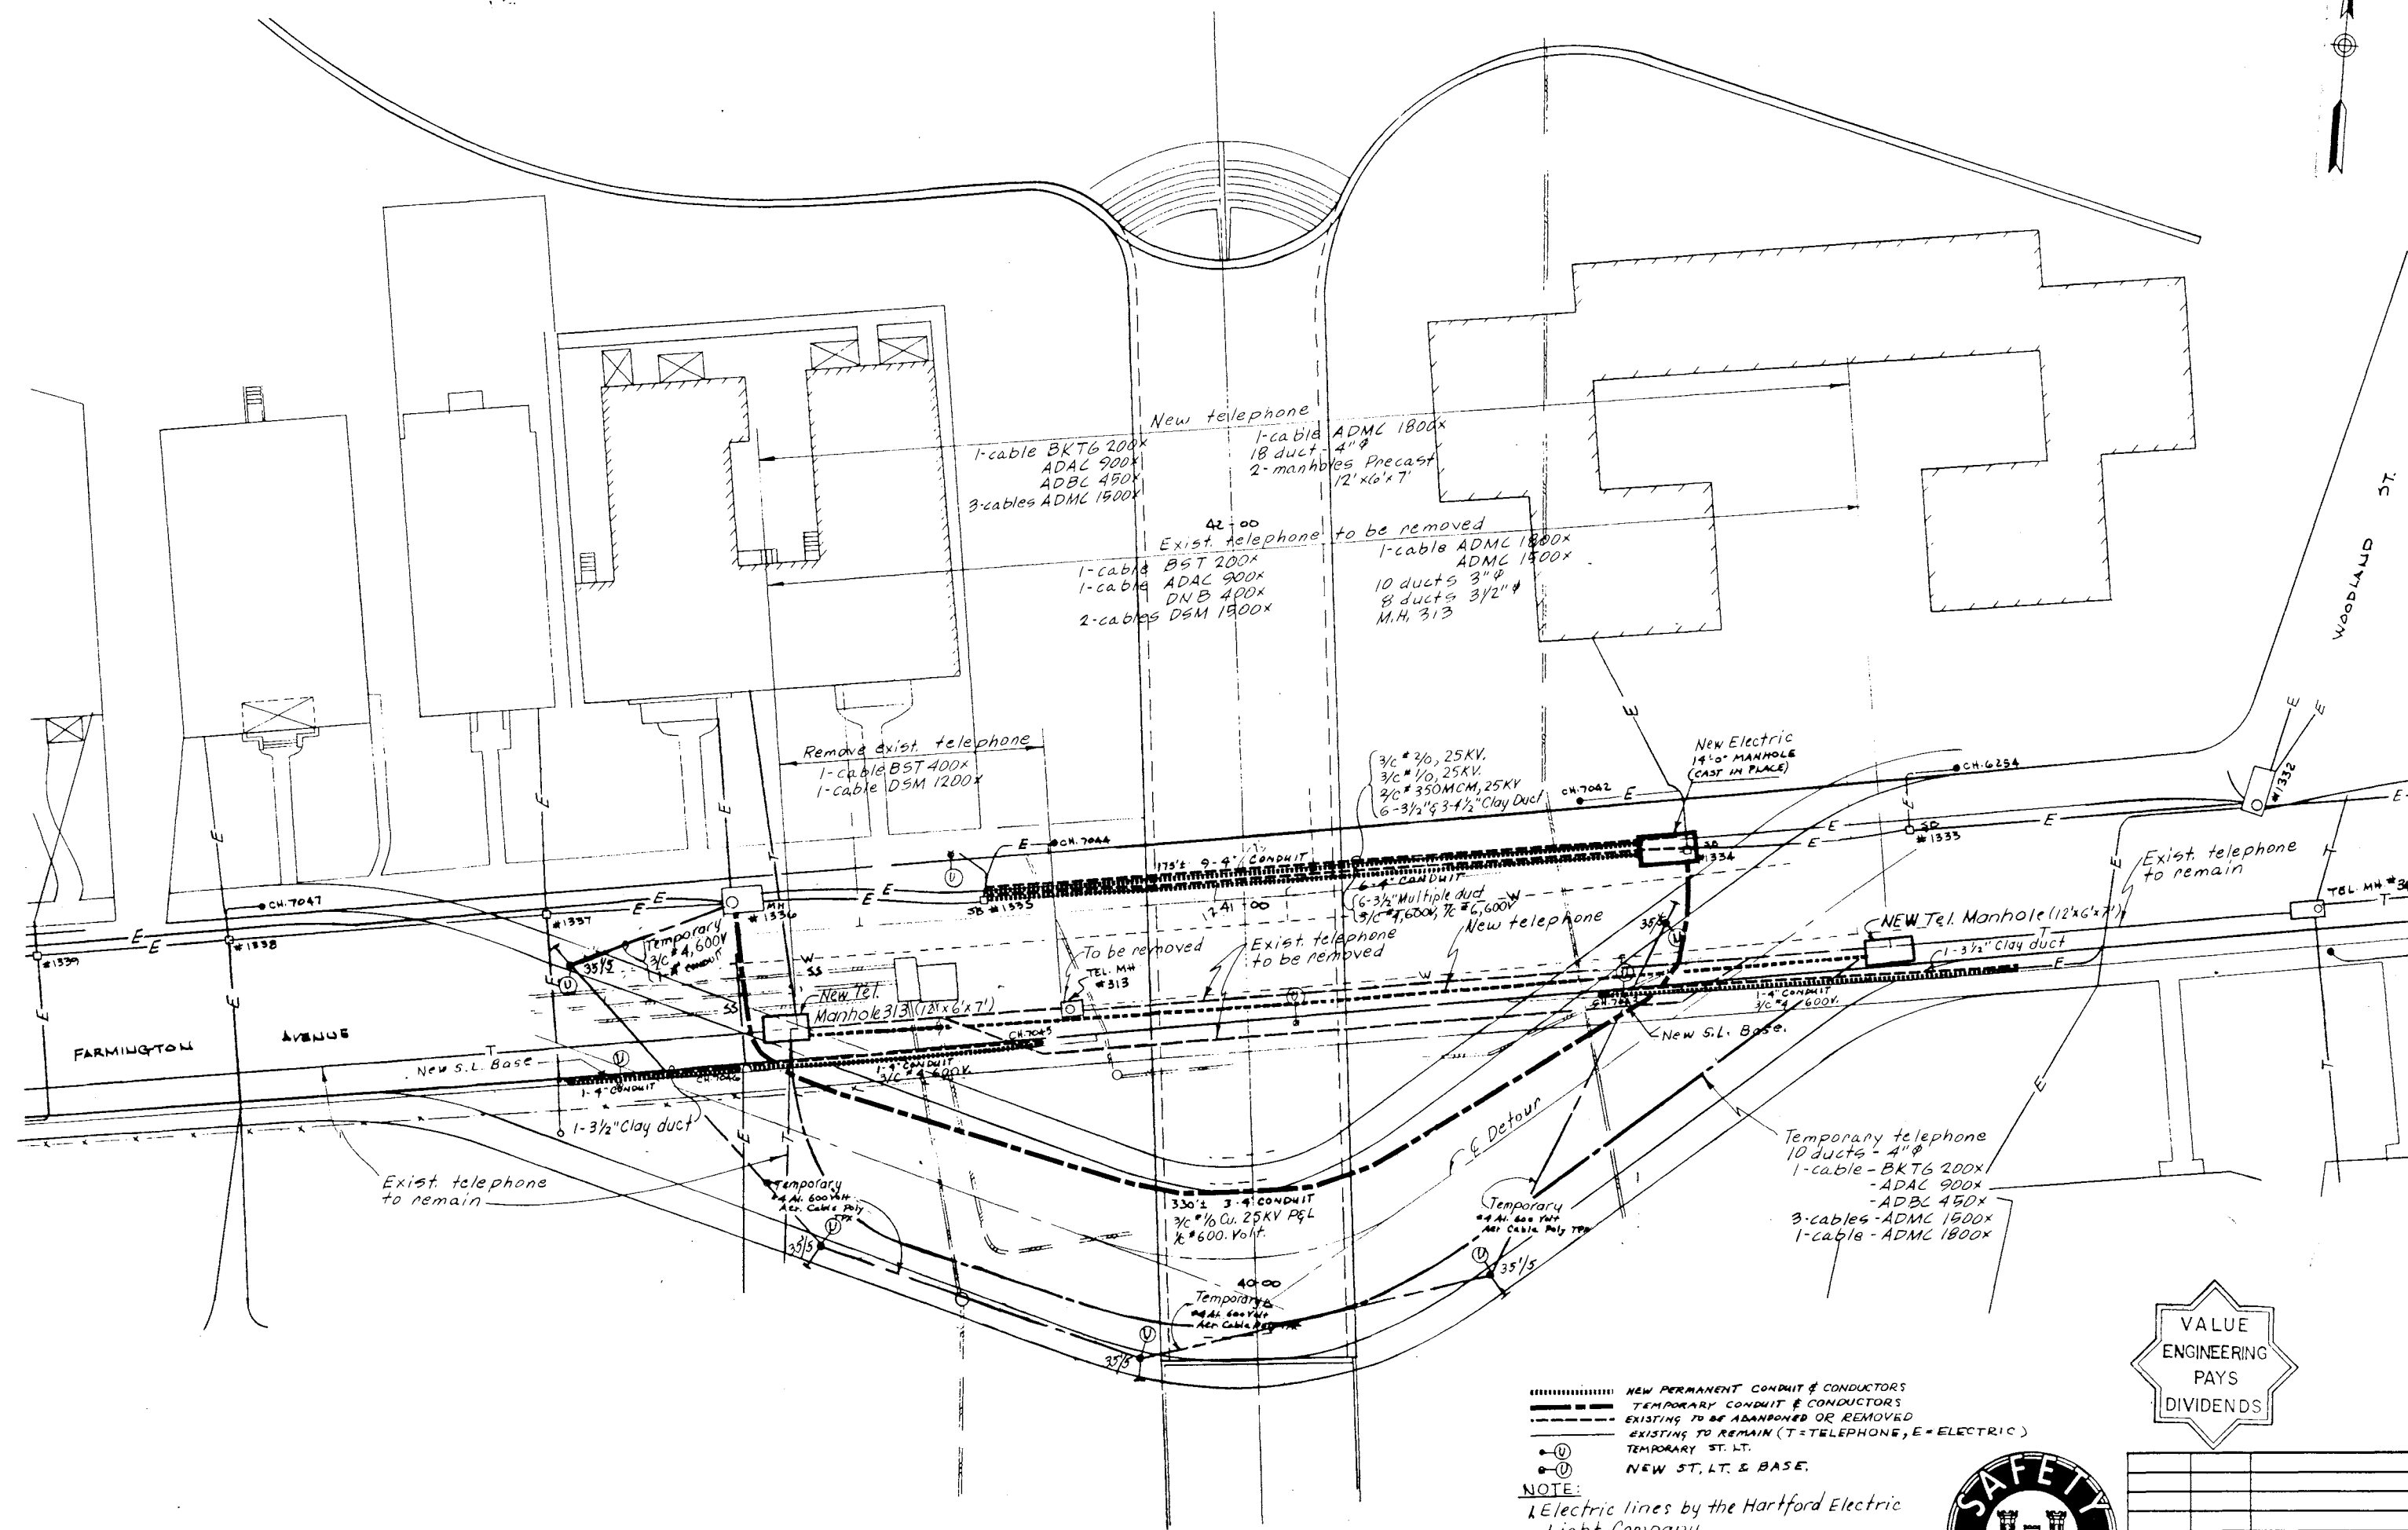

FARMINGTON AVENUE

SCALE: 1" = 20'

NEW PERMANENT CONDUIT & CONDUCTORS
TEMPORARY CONDUIT & CONDUCTORS
EXISTING TO BE ABANDONED OR REMOVED
EXISTING TO REMAIN (T=TELEPHONE, E=ELECTRIC)
TEMPORARY ST. LT.
NEW ST. LT. & BASE.


NOTE:
1. Electric lines by the Hartford Electric Light Company.
2. Telephone lines by the Southern New England Telephone Company.
3. New streetlight pole bases by contractor for details see Dwg. No. PAR-1, sheet 109.

GRAPHIC SCALES

20' 0 20' 40'
1" = 20'

As Built Drawing

Contract No. DACW 33-76-C-0098

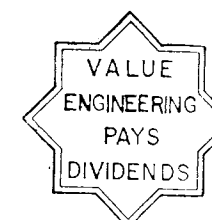

REVISION	DATE	DESCRIPTION	BY

DEPARTMENT OF THE ARMY
NEW ENGLAND DIVISION
CORPS OF ENGINEERS
WALTHAM, MASS.

DES. BY L.F. DR. BY L.L. CK. BY T.T.
SUBMITTED: [Signature]
CHIEF MECH. ELEC. SECTION
APPROVAL RECOMMENDED: [Signature]
CHIEF TECH. ENG. BRANCH
REVIEWED: [Signature]
PROJECT ENGINEER
APPROVED: [Signature]
CHIEF PROJECT BRANCH

WATER RESOURCES DEVELOPMENT PROJECT
PARK RIVER LOCAL PROTECTION
BOX CONDUIT AT SECTION 9
ELECTRICAL AND TELEPHONE DISTRIBUTION

HARTFORD CONNECTICUT
DATE MARCH 1976
SCALE: 1" = 20' SPEC. NO. DACW 33-76-B-0040
DRAWING NUMBER
PAR - 1
SHEET 95