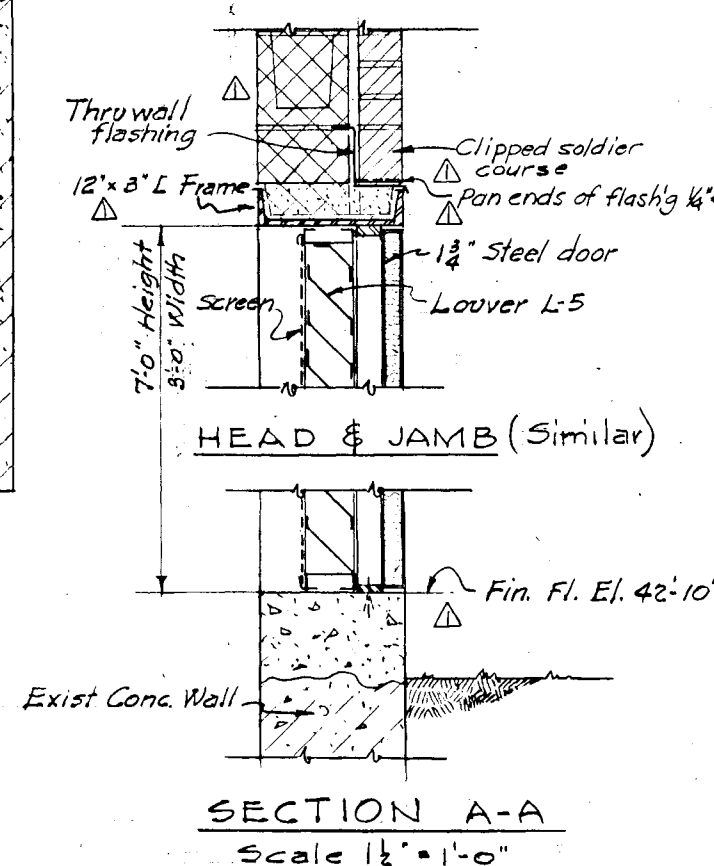
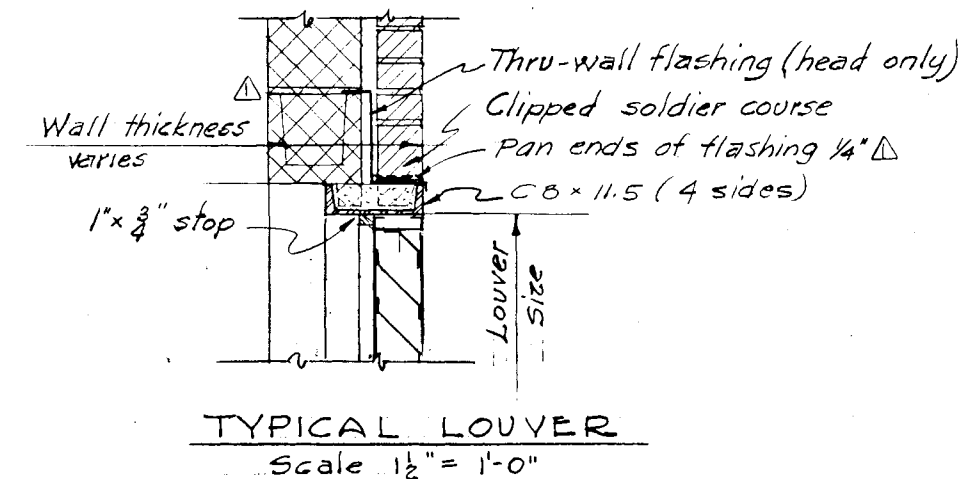
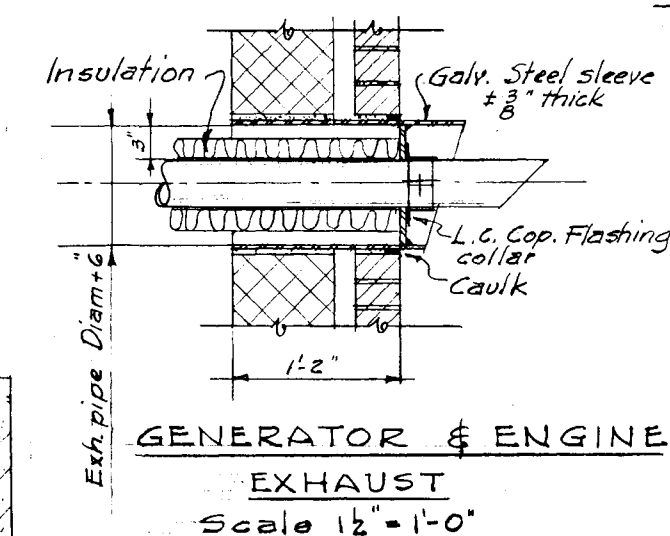
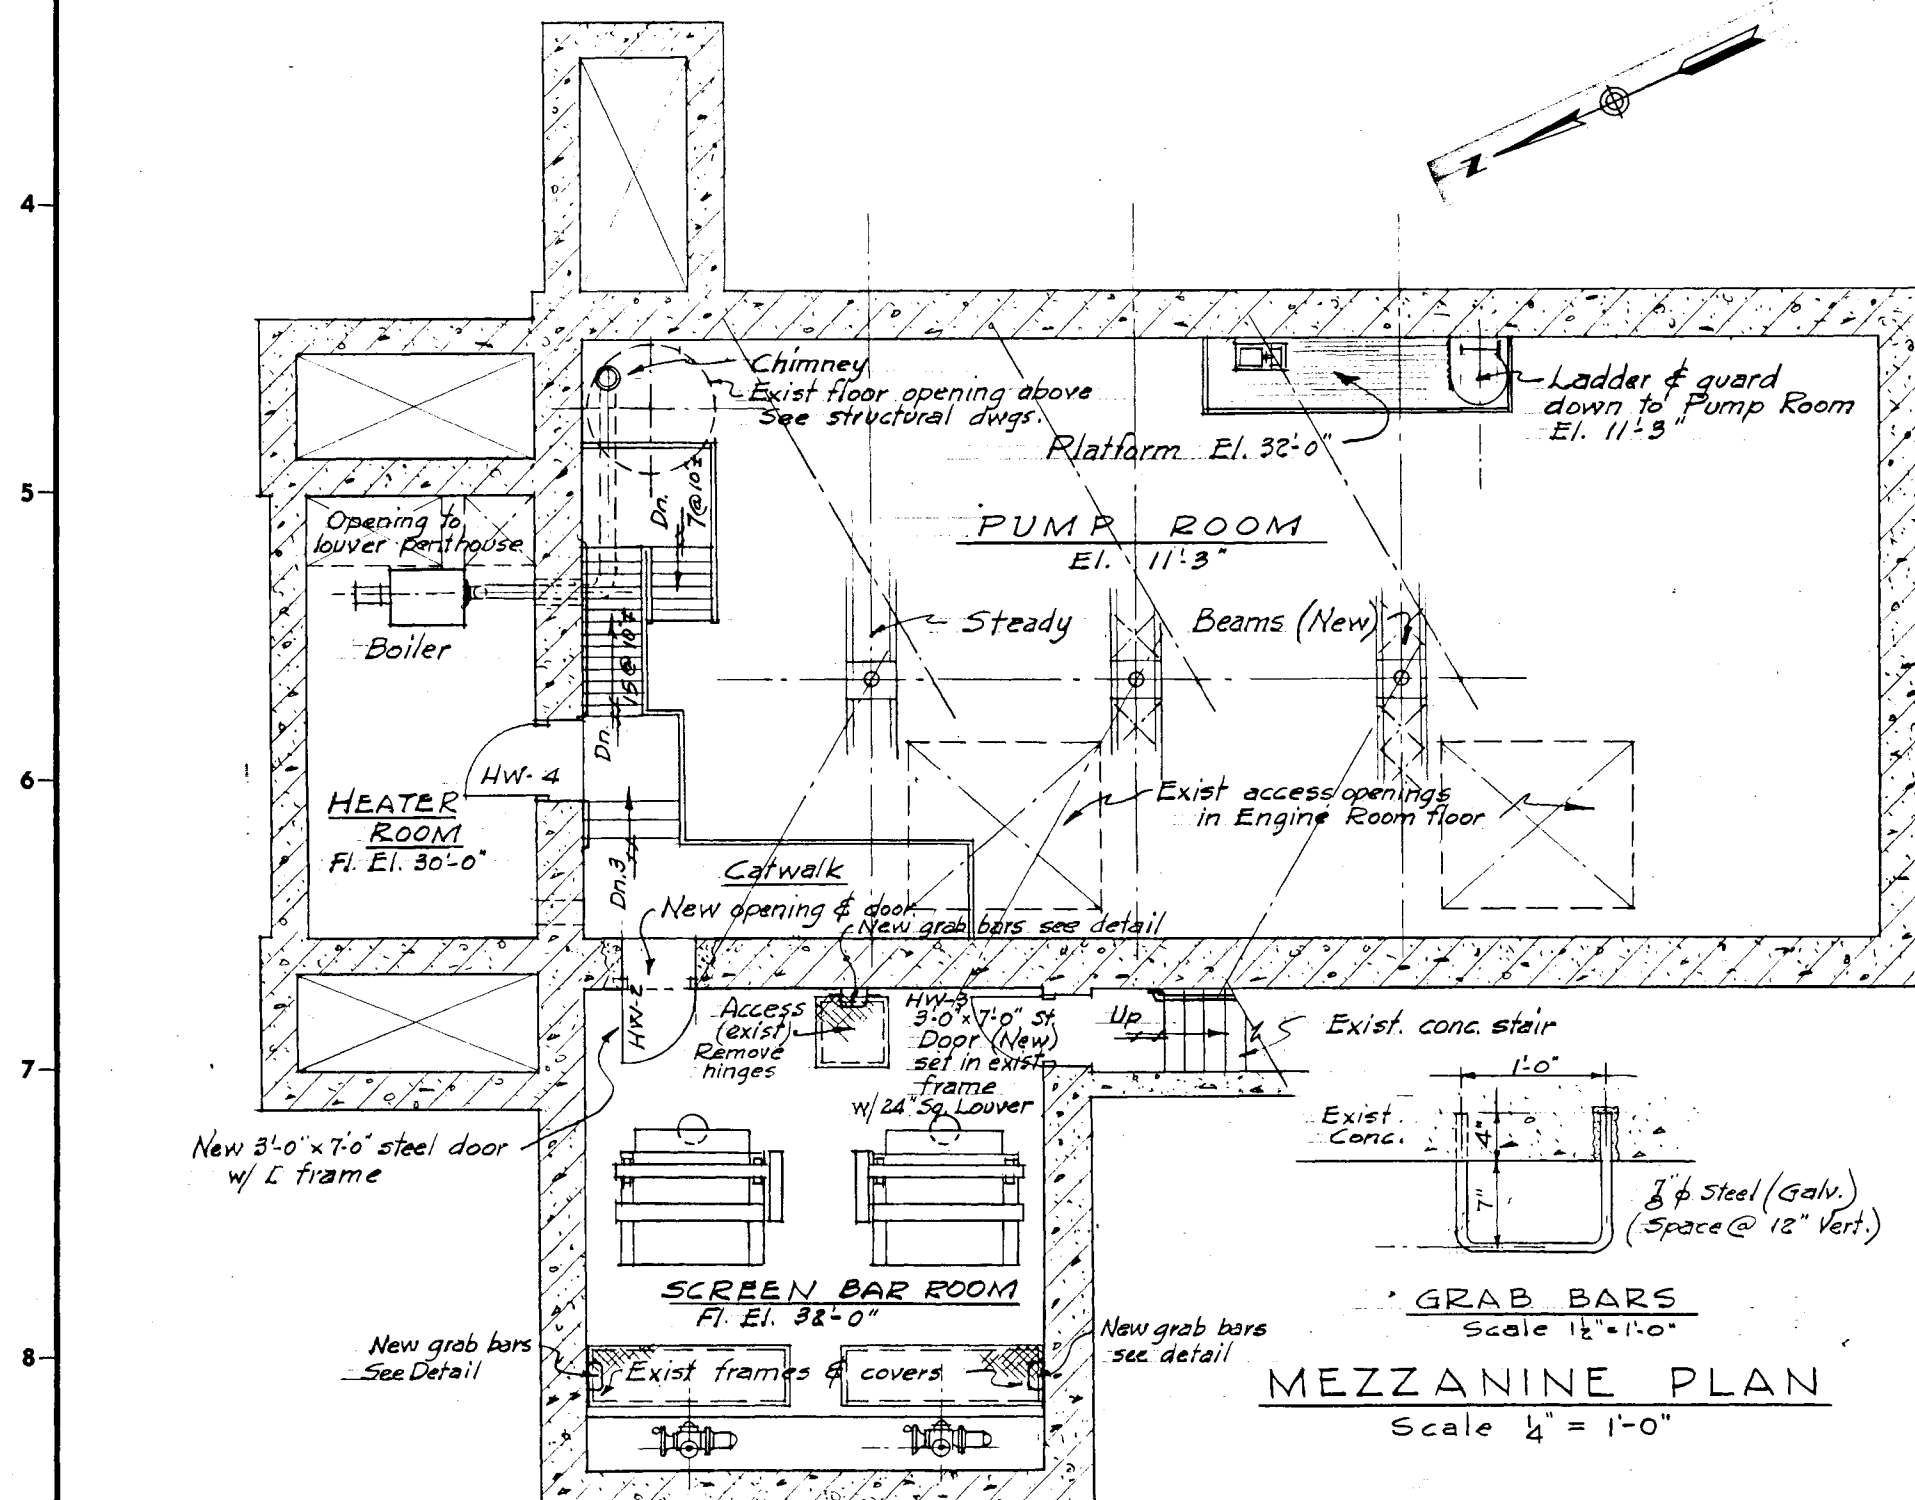
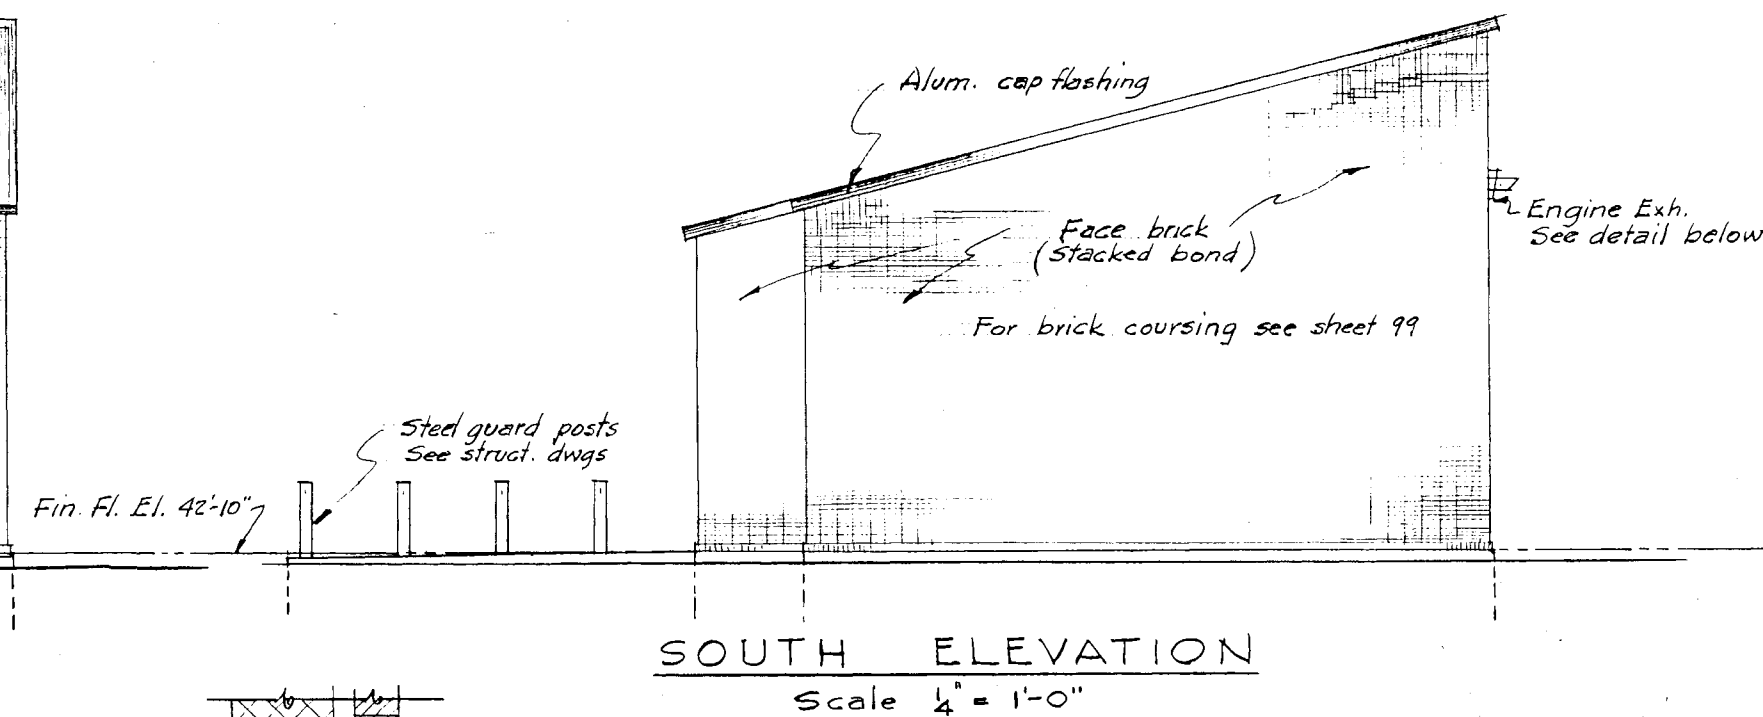
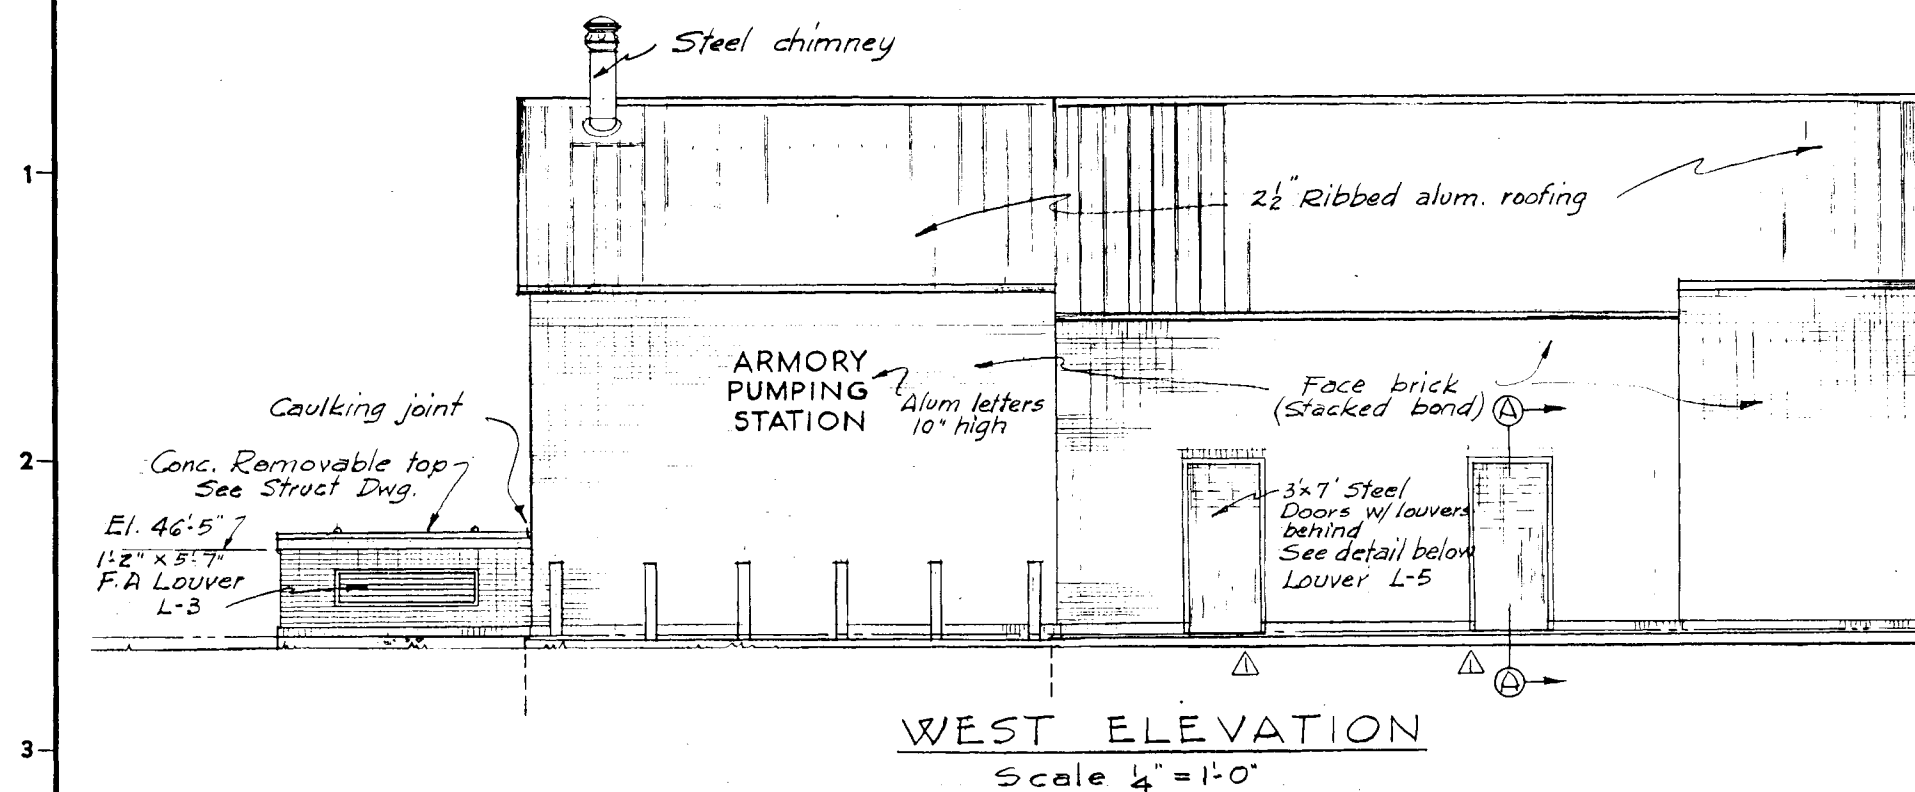


- NOTES
- For details of catwalks, ships ladders, railings, access covers, ladders, see Sh. 102
 - All brick dimensions are from bottom of joint to bottom of joint unless otherwise noted
 - Brick dimensions for exterior brick are based on standard 2 1/4 x 3 1/2 x 7 1/2" with 3/8" joints
 - Brick shall be similar to Belden Brick Co. 900-906A
 - Floors in bar-screen room & heater room shall be patched and smoothed as required, and painted red to match engine room floor.

REVISION	DATE	DESCRIPTION	BY
4-4-83		Final field corrections	
5-12-78		Revised flashing & louver subframe sill elev.	WAL

DEPARTMENT OF THE ARMY NEW ENGLAND DIVISION CORPS OF ENGINEERS WALTHAM, MASS.			
WATER RESOURCES DEVELOPMENT PROJECT PARK RIVER LOCAL PROTECTION ARMORY PUMPING STATION ARCHITECTURAL PLAN AND ELEVATIONS			
DES. BY C.E.	DR. BY C.E.	CK. BY C.E.	PROJECT ENGINEER HARTFORD
SUBMITTED ALL DATA CHECKED APPROVED REVIEWED	DATE 1/10/78	SECTION ARCHITECTURAL	APPROVED DATE MARCH 1978
SCALE AS SHOWN		SPEC. NO. DACW 33-76-8 0040	
DRAWING NUMBER PAR - I		SHEET 97	

As Built Drawing

Contract No. DACW 33-76-C-0098