


## EAST ELEVATION

Scale 1/4" = 1'-0"  
58'-0"


## NORTH ELEVATION

Scale 1/4" = 1'-0"

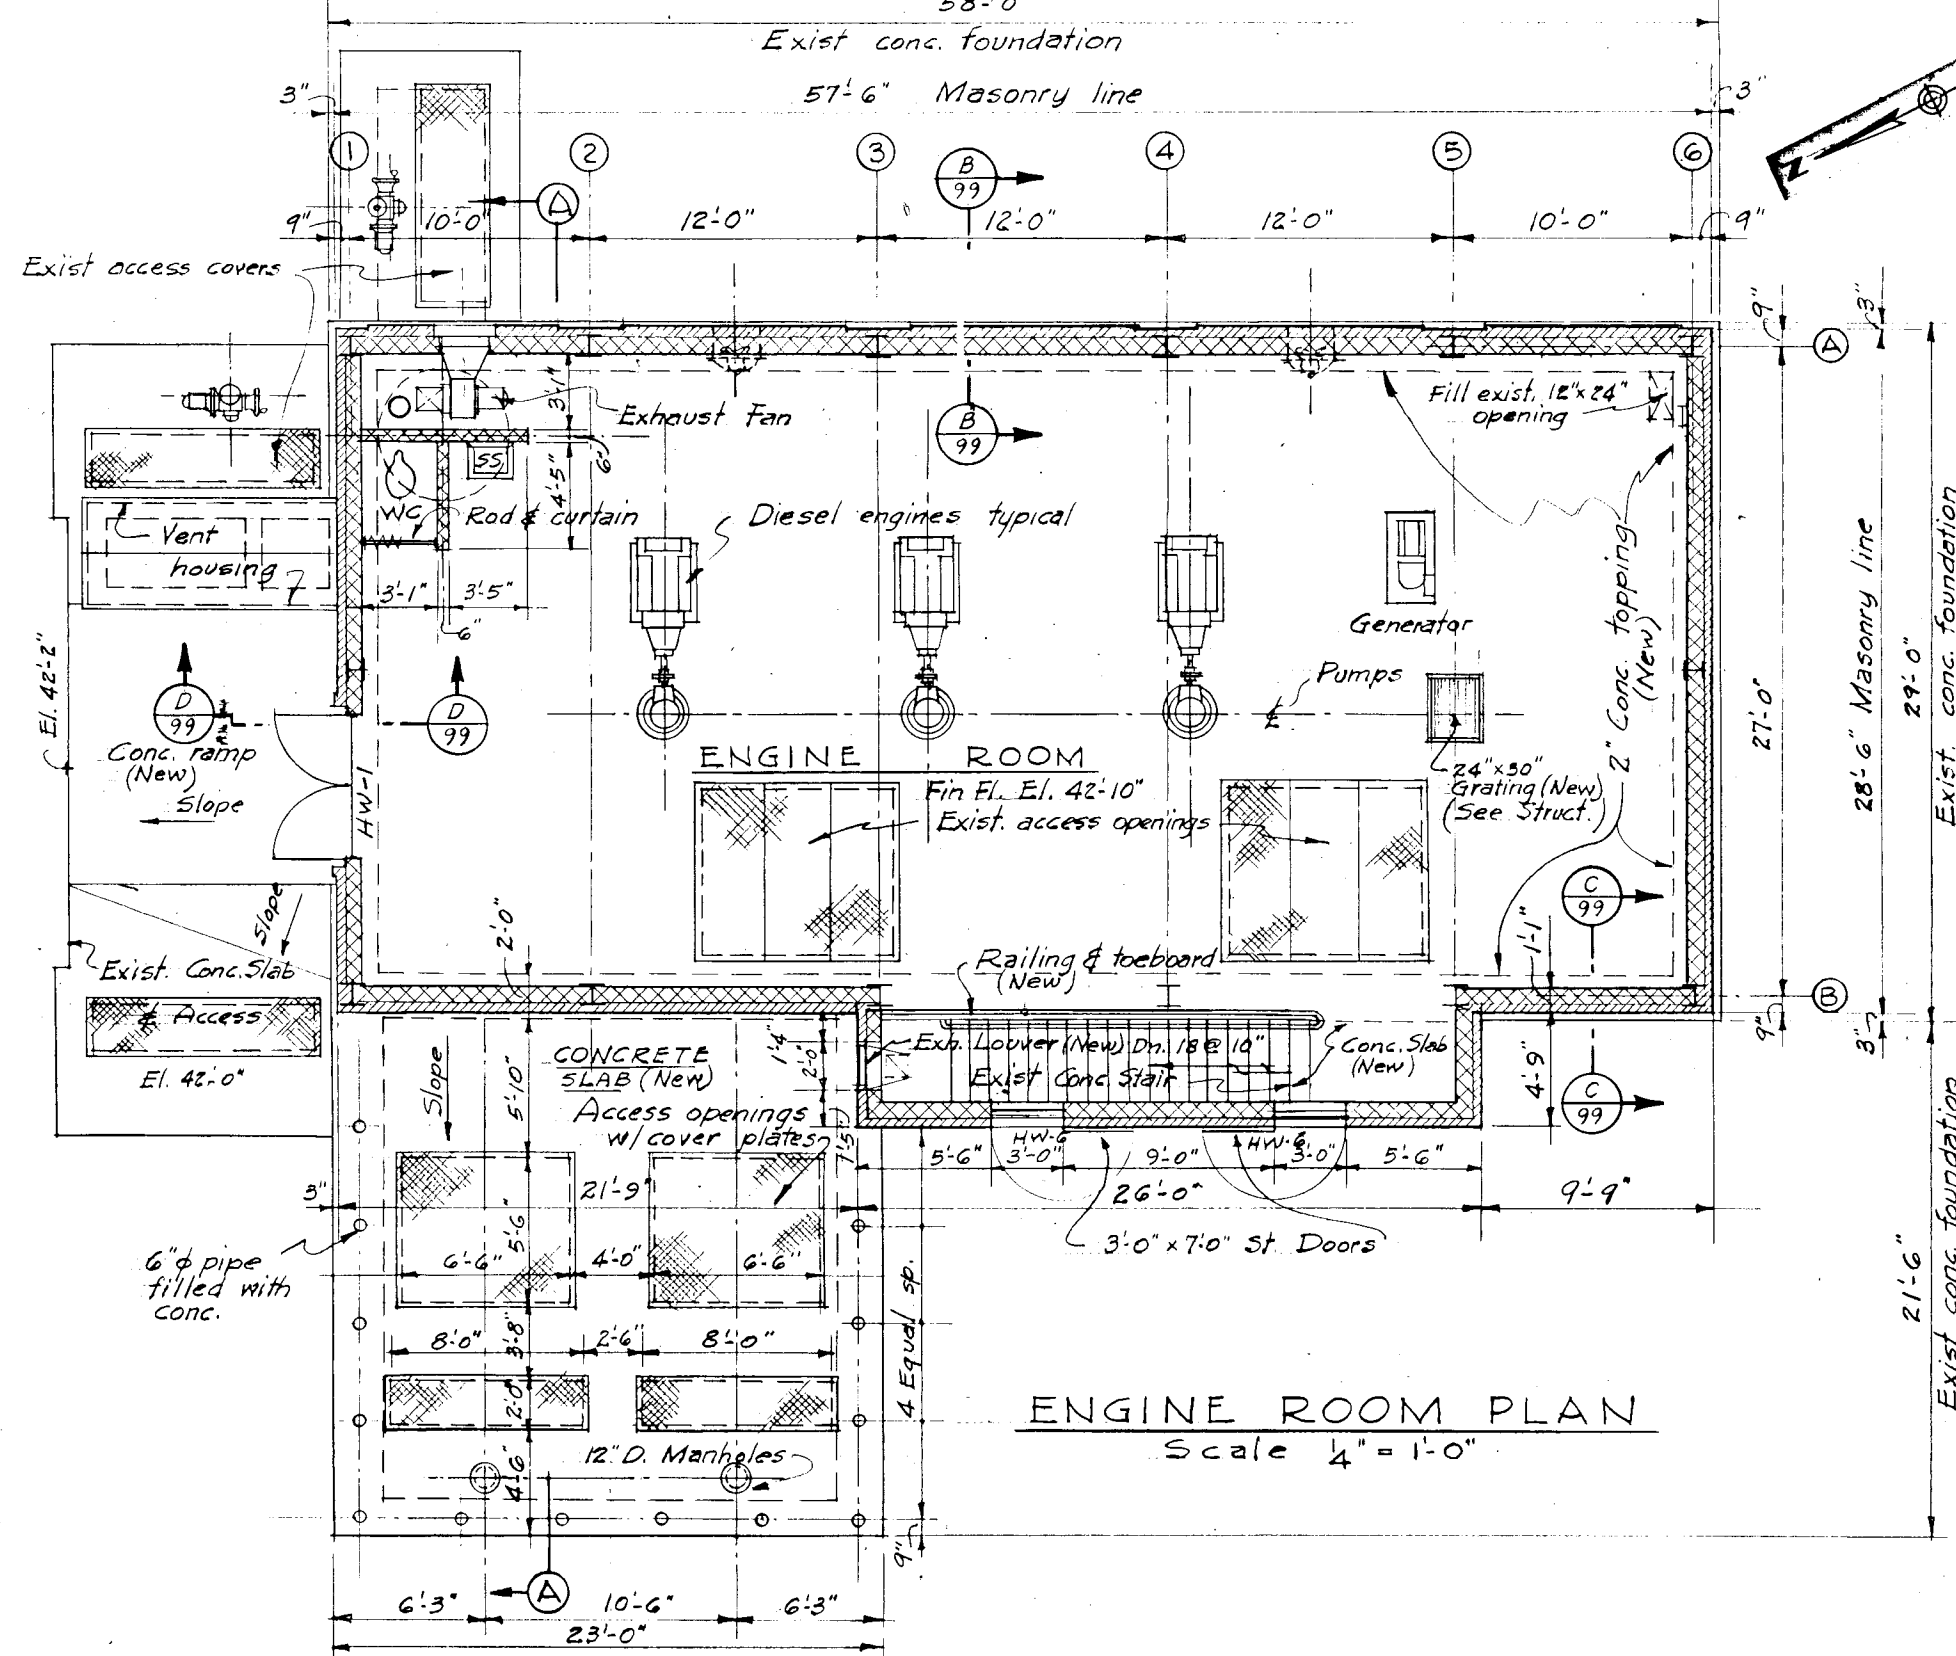


## ENGINE ROOM PLAN

Scale 1/4" = 1'-0"

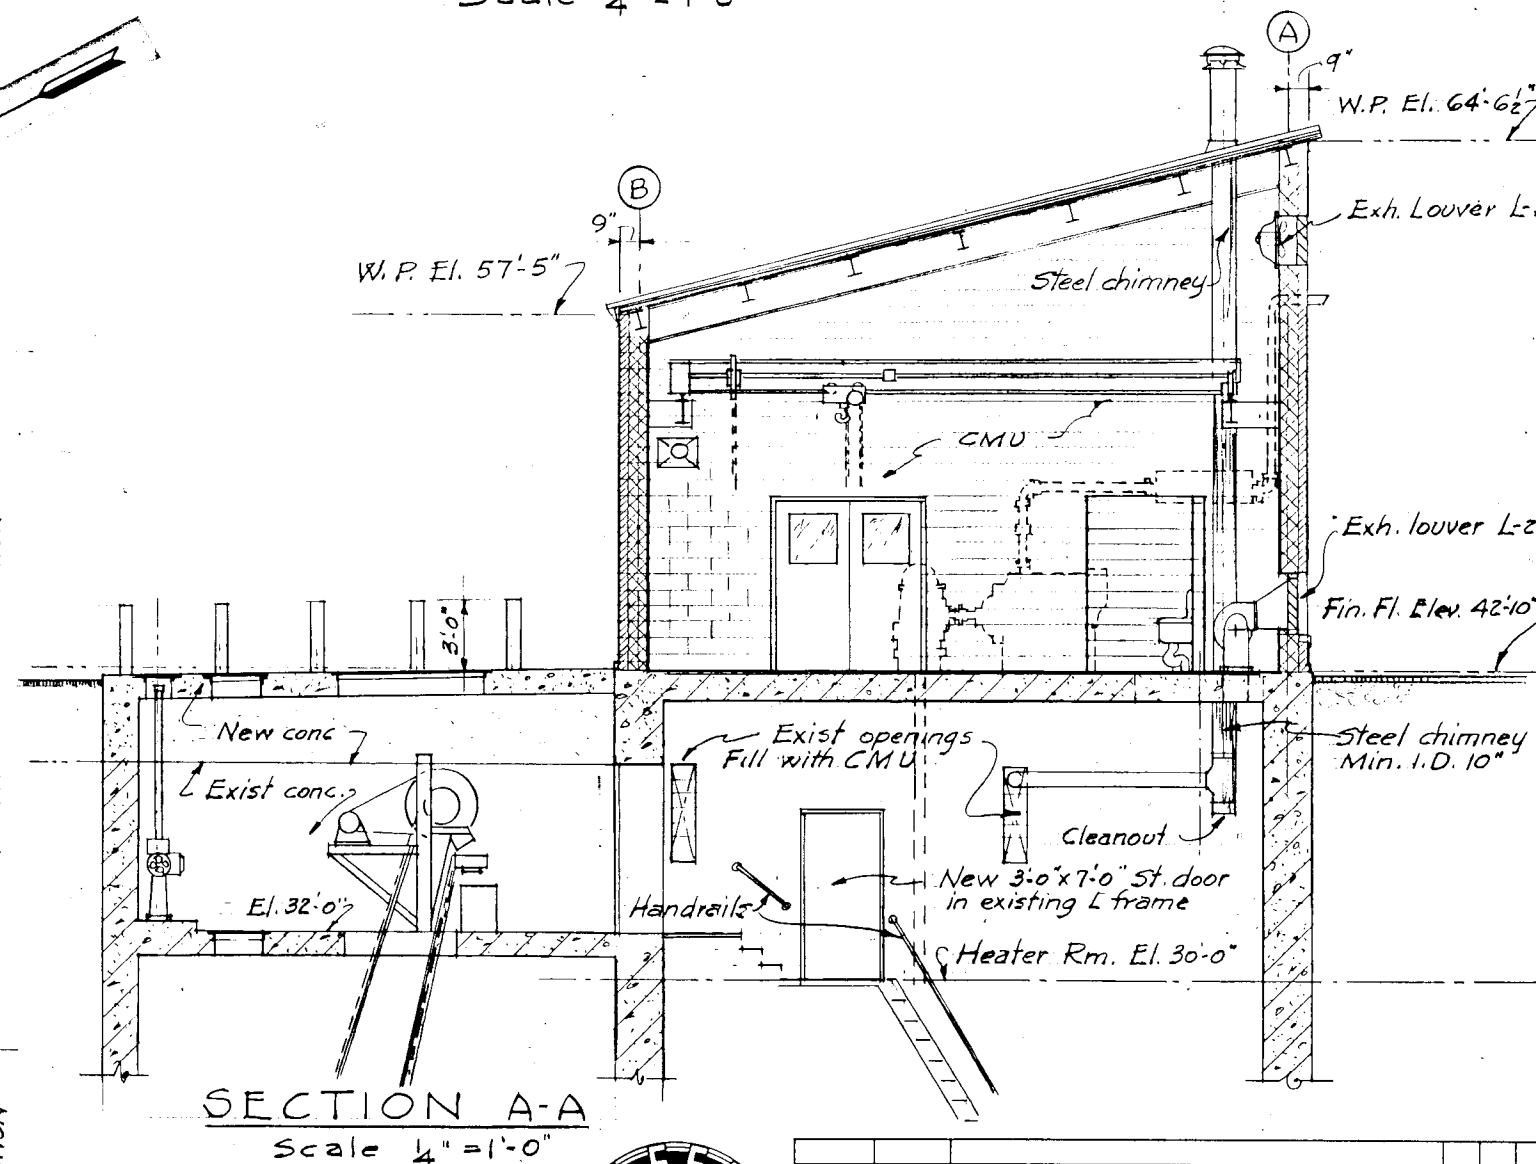

## SECTION A-A

Scale 1/4" = 1'-0"

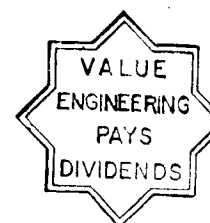GRAPHIC SCALES  
1/4" = 1'-0"

## NOTES

1. "Colorcron" separate floor, 2" thick, color tile red, applied to existing slab in Engine Room

As Built Drawing

Contract No. DACW 33-76-C-0098

| REVISION | DATE | DESCRIPTION             | BY |
|----------|------|-------------------------|----|
| 4-4-83   |      | Final field corrections |    |

| DEPARTMENT OF THE ARMY<br>NEW ENGLAND DIVISION<br>CORPS OF ENGINEERS<br>WALTHAM, MASS.                                                   |               |                    |                 |
|------------------------------------------------------------------------------------------------------------------------------------------|---------------|--------------------|-----------------|
| DES. BY<br>C E                                                                                                                           | DR. BY<br>C E | CK. BY<br>C E      | SECTION<br>ARCH |
| WATER RESOURCES DEVELOPMENT PROJECT<br>PARK RIVER LOCAL PROTECTION<br>ARMORY PUMPING STATION<br>ARCHITECTURAL<br>ELEVATIONS AND SECTIONS |               |                    |                 |
| HARTFORD                                                                                                                                 |               | CONNECTICUT        |                 |
| APPROVED                                                                                                                                 |               | DATE<br>MARCH 1976 |                 |
| SCALE AS SHOWN   SPEC. NO. DACW33-76-B-0040<br>DRAWING NUMBER<br>PAR - I                                                                 |               |                    |                 |