




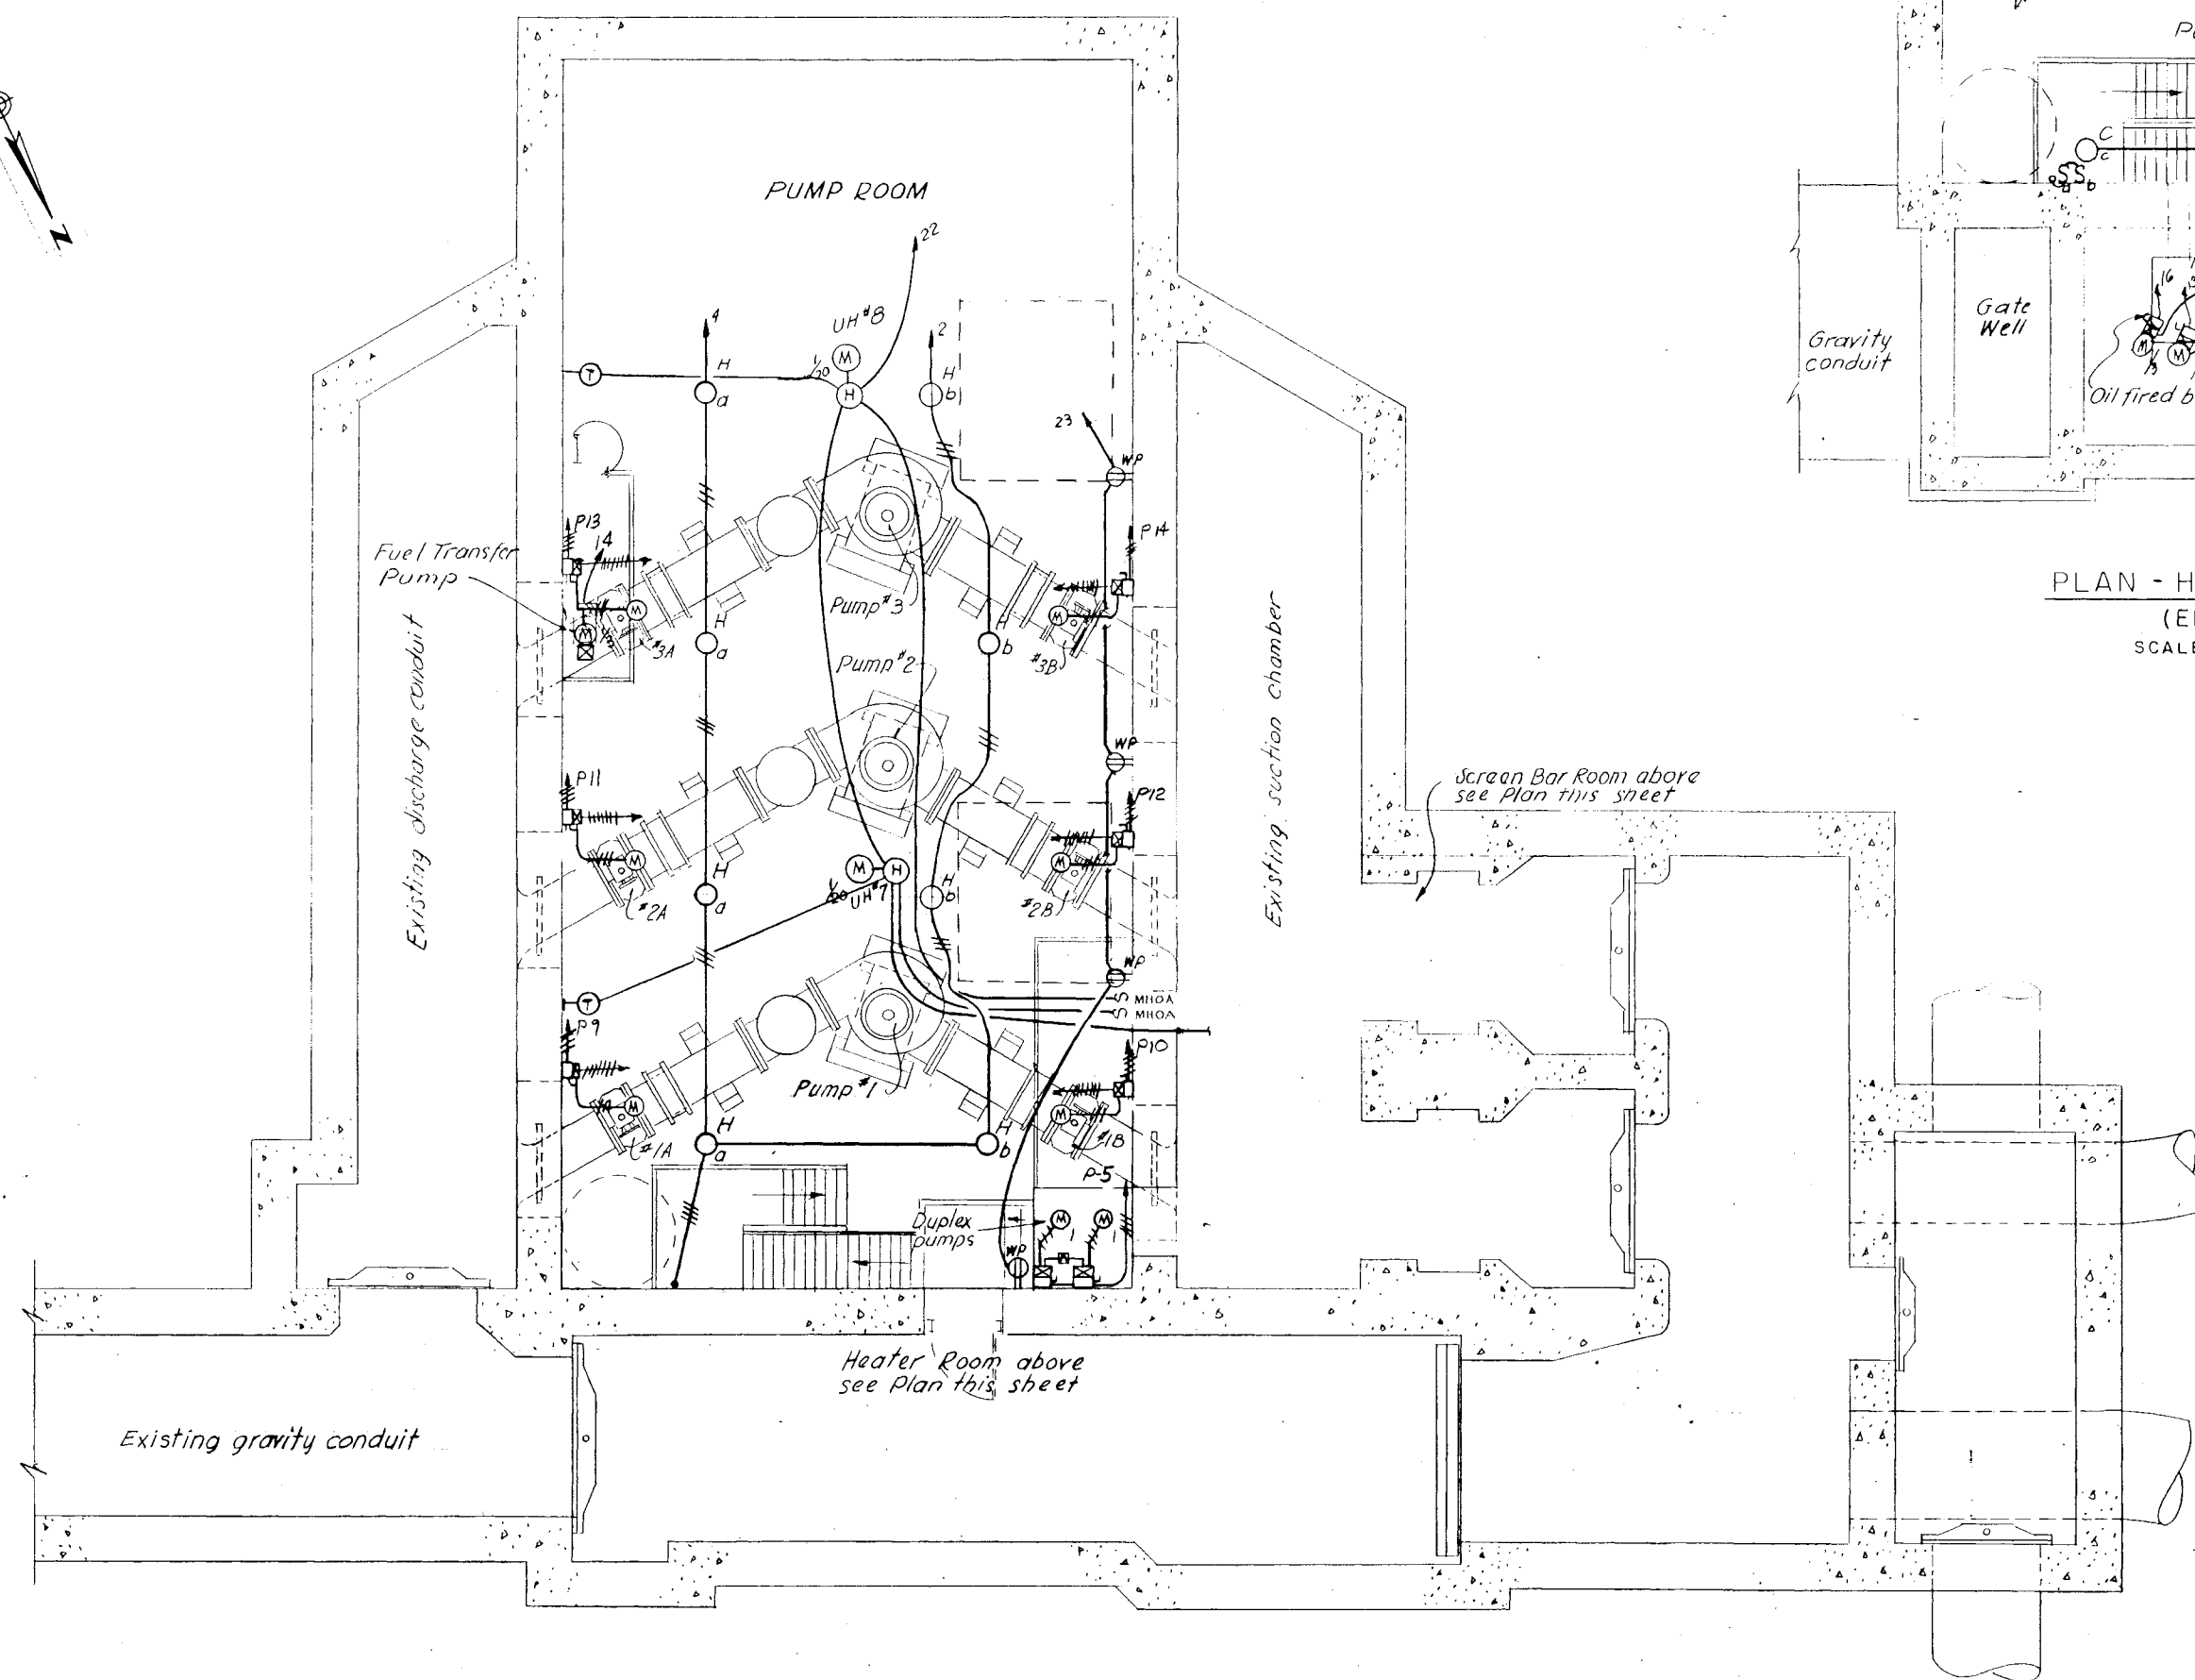


PLAN - PUMP ROOM
(EL. 11.25)
SCALE: 1/4" = 1'-0"

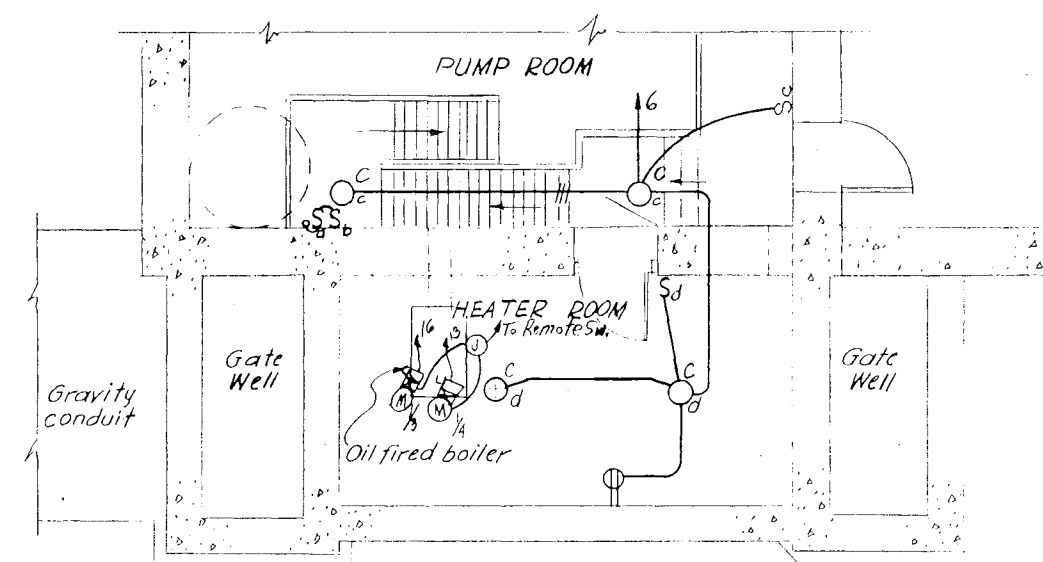

PLAN - HEATER ROOM
(EL. 30.0)
SCALE 1/4" = 1' - 0"

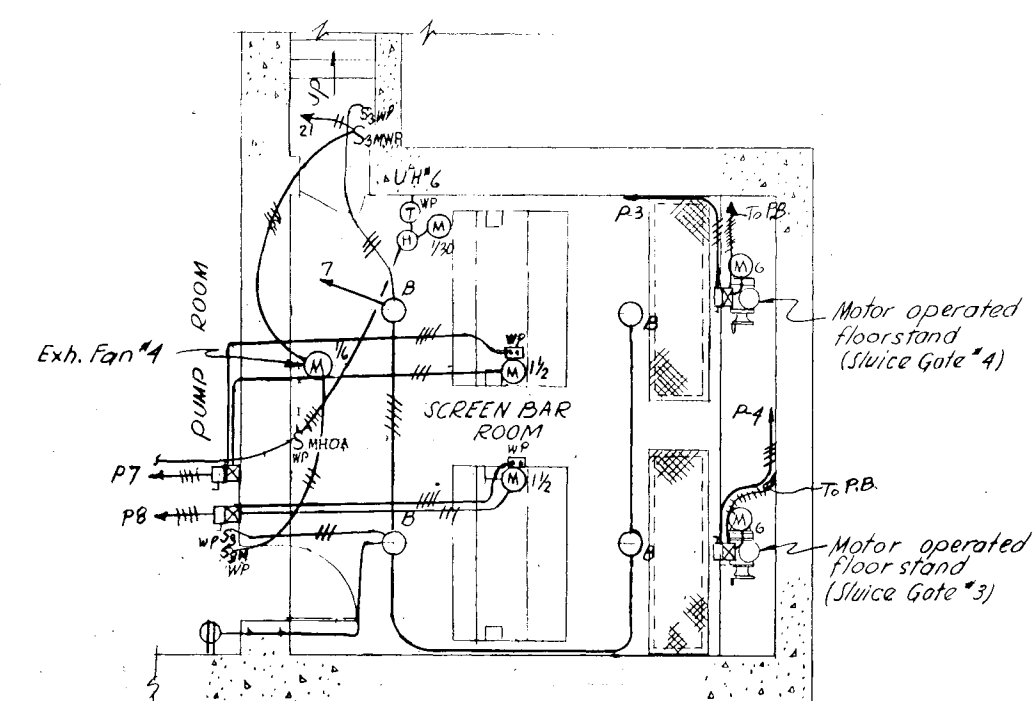

PLAN - SCREEN BAR ROOM
(EL 32.0)
SCALE 1/4" = 1'-0"

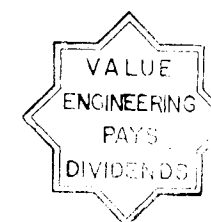

GRAPHIC SCALES

$$l_1'' = l_1' - O''$$

As Built Drawings

Contract No. DACW 33-76C-0098

[illegible]