

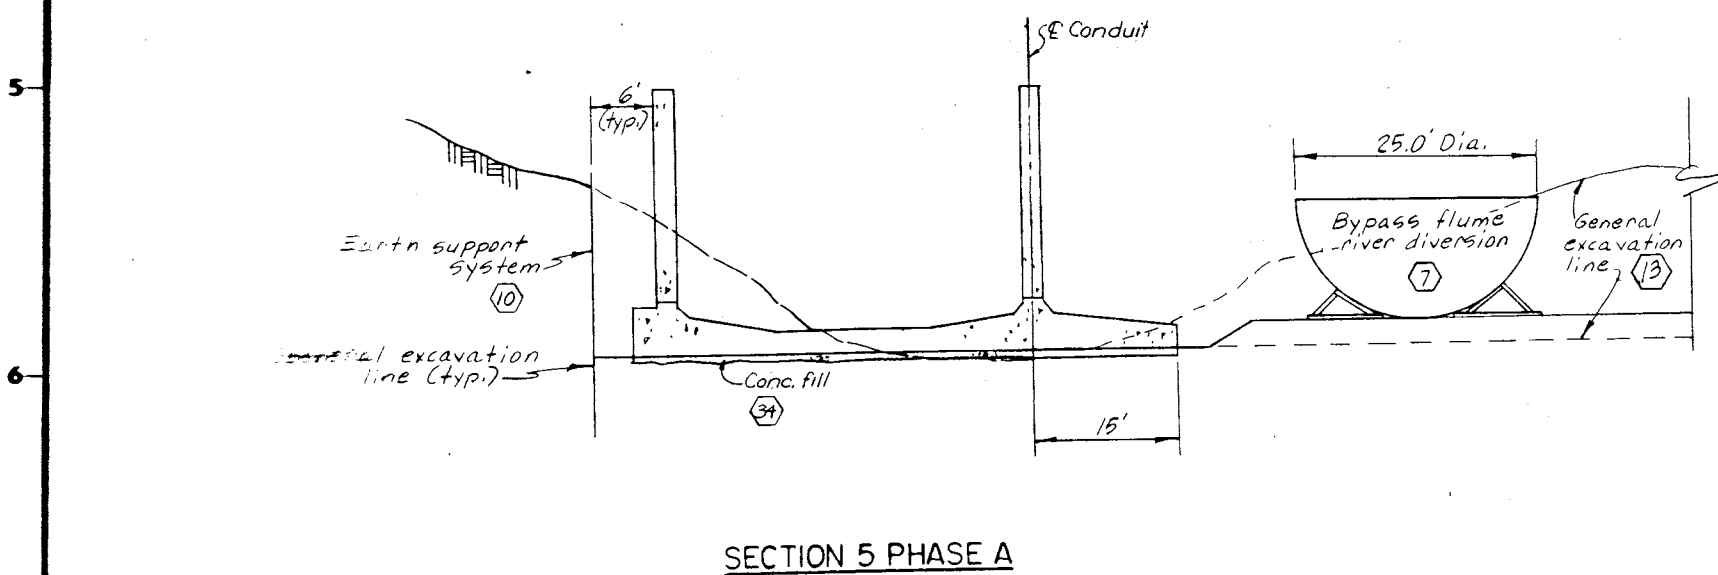
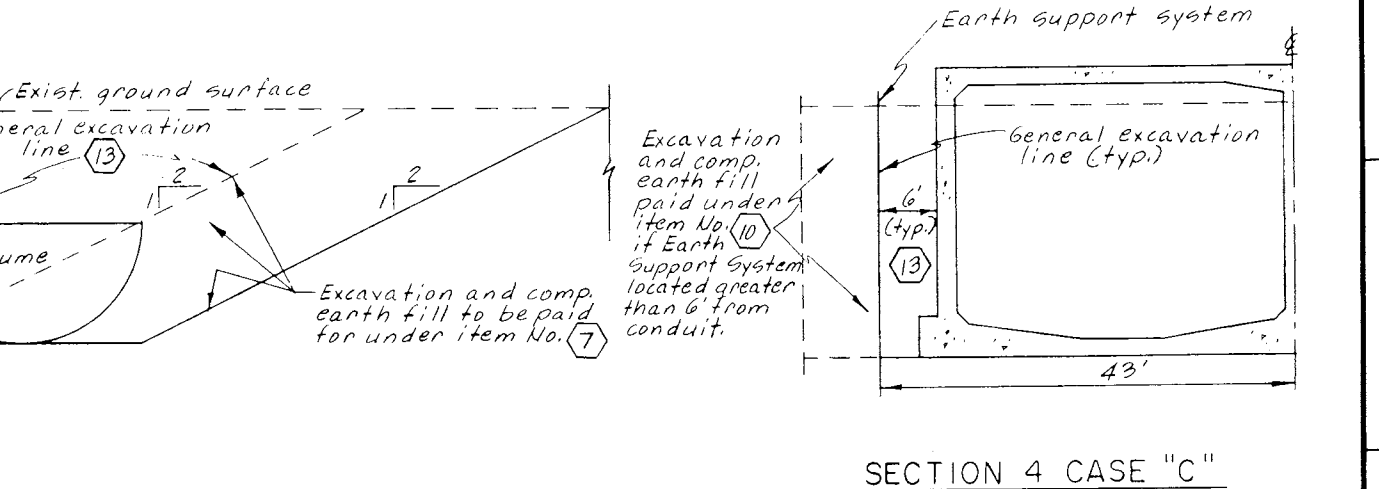
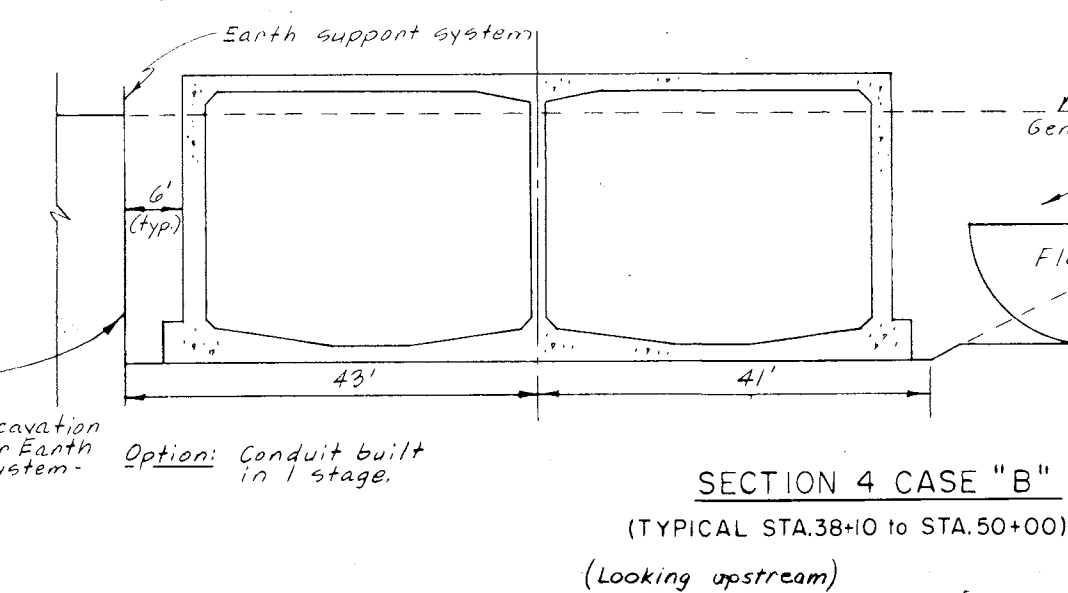
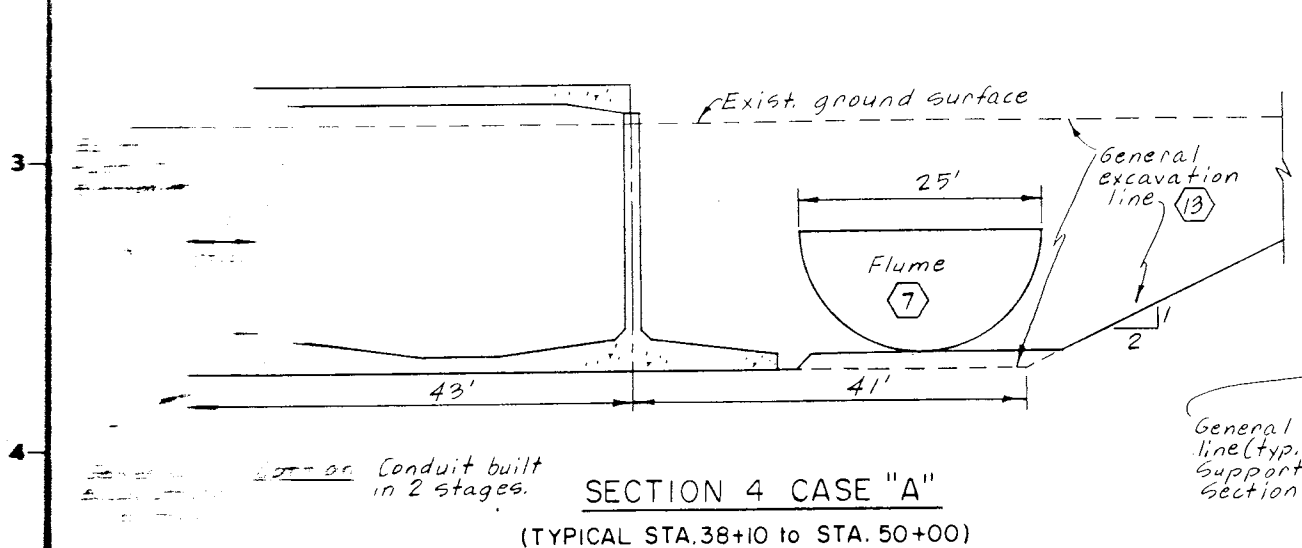
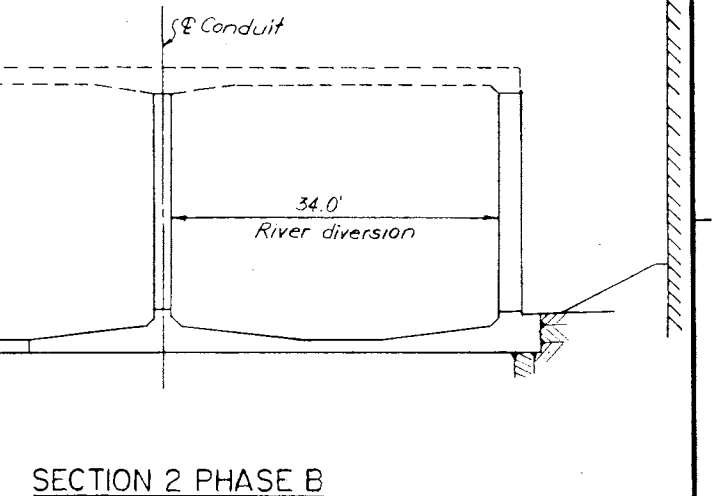
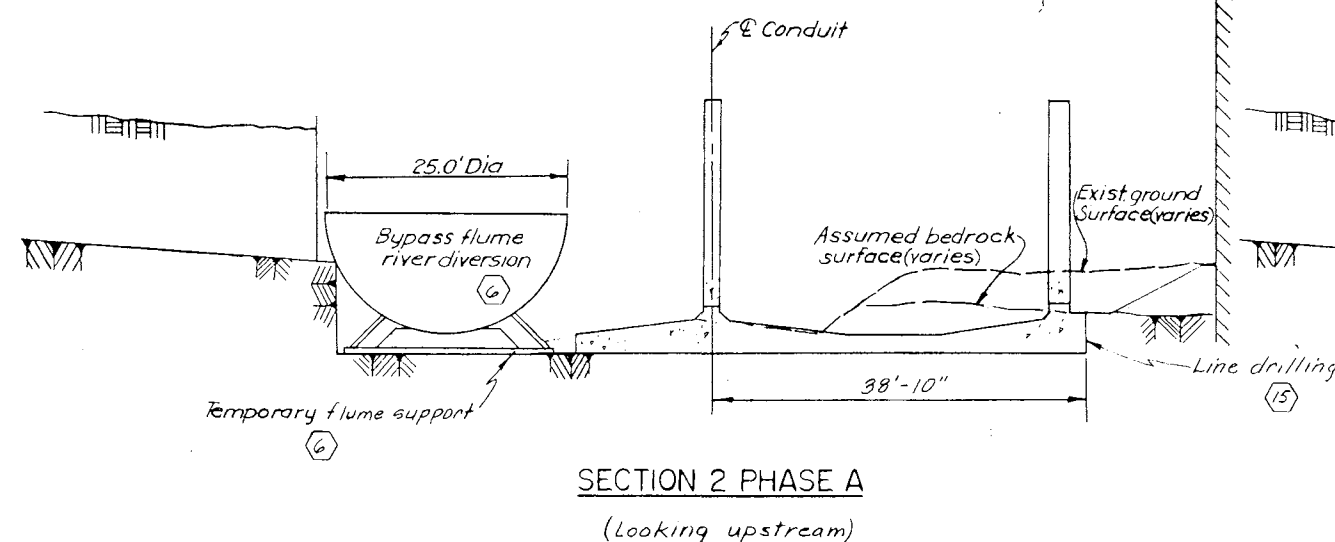






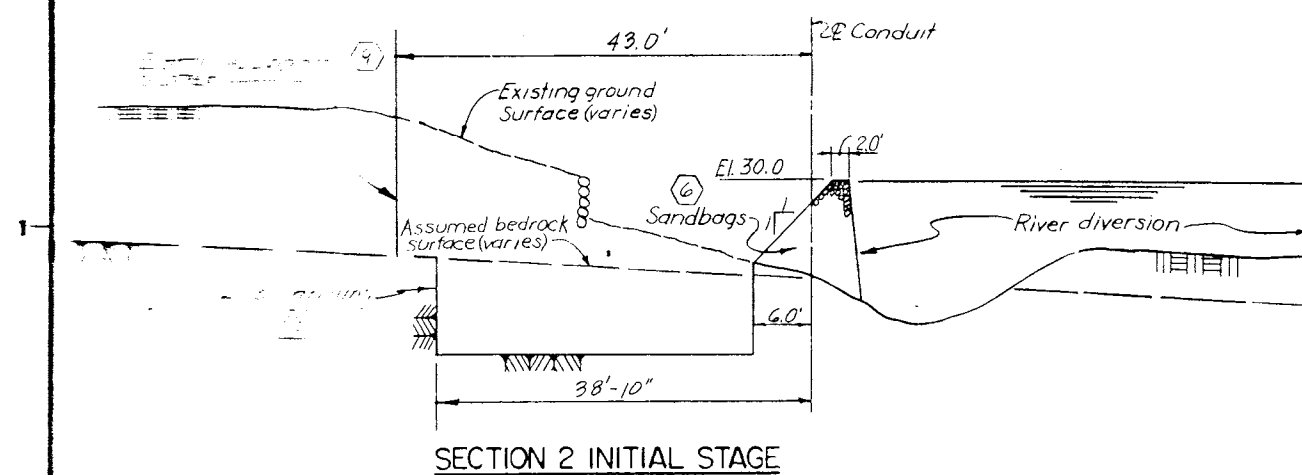


(Looking upstream)

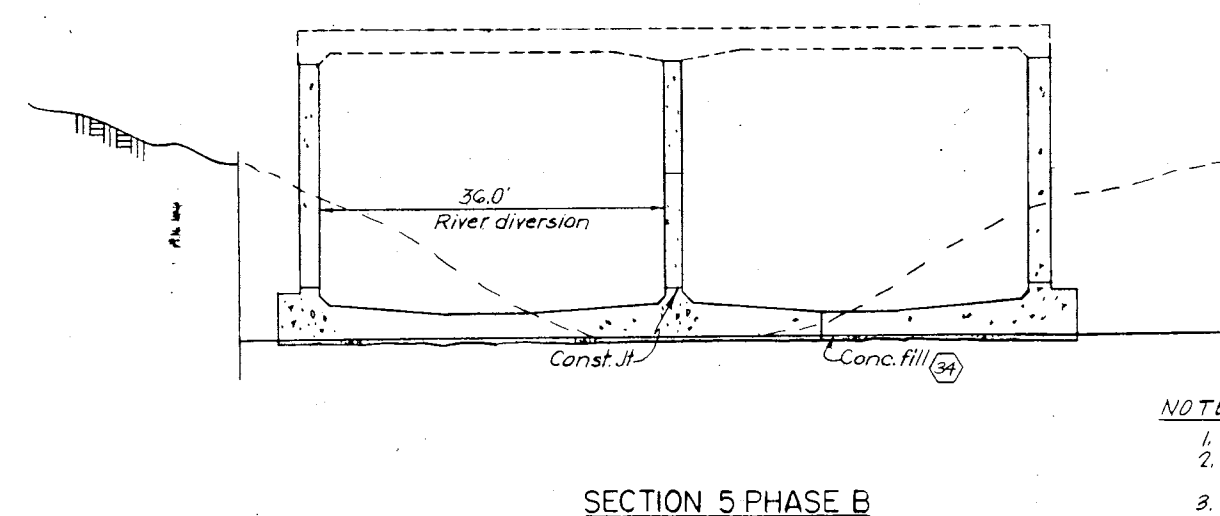

NOTES:

1. For General Notes see Sht. 2.
2. For Division of Work plans see Shts. 13, 14, 32, 33, 34 and 55.
3. Contractor has option of building conduits in one or two stages. Cases A, B and C indicate manner and extent of payment dependent upon option selected. For Section 2 and 5 manner and extent of payments indicated on sheets showing cross-sections.

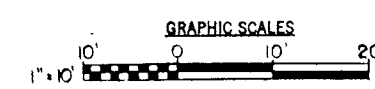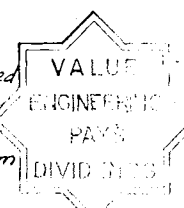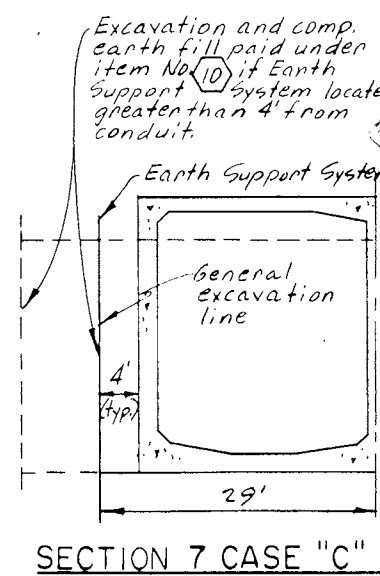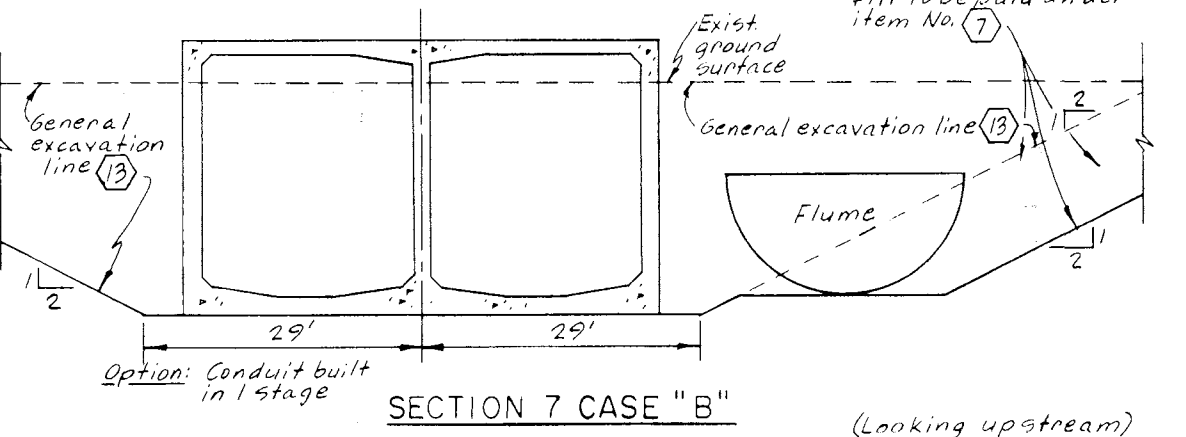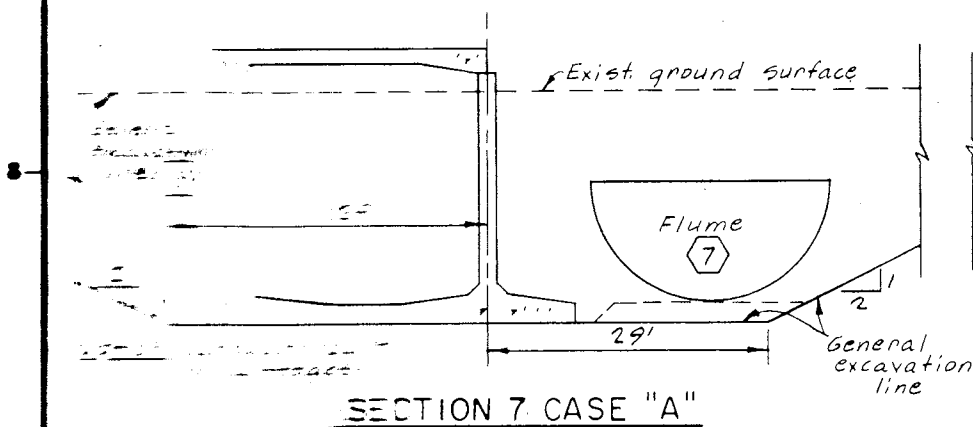As Built Drawing
33.76 C 0098

REVISION	DATE	DESCRIPTION	BY

DES. BY: R.C. DR. BY: J.B.M. CK. BY: R.T.C.			
SUBMITTED: [Signature]			
CHIEF, LAYOUT SECTION			
APPROVAL/RECOMMENDATION: [Signature]			
CHIEF, PROJECT BRANCH			
REVIEWED: [Signature]			
PROJECT ENGINEER			
APPROVED: [Signature]			
CHIEF, ENGINEERING DIVISION			

DEPARTMENT OF THE ARMY NEW ENGLAND DIVISION CORPS OF ENGINEERS WALTHAM, MASS.		WATER RESOURCES DEVELOPMENT PROJECT PARK RIVER LOCAL PROTECTION DIVERSION OF WATER TYPICAL SECTIONS	
HARTFORD		CONNECTICUT	
APPROVED: [Signature]		DATE: MARCH 1976	
SCALE: 1"=10'		SPEC. NO. DACW33-76-B-0040	
DRAWING NUMBER PAR-1		SHEET 112	