

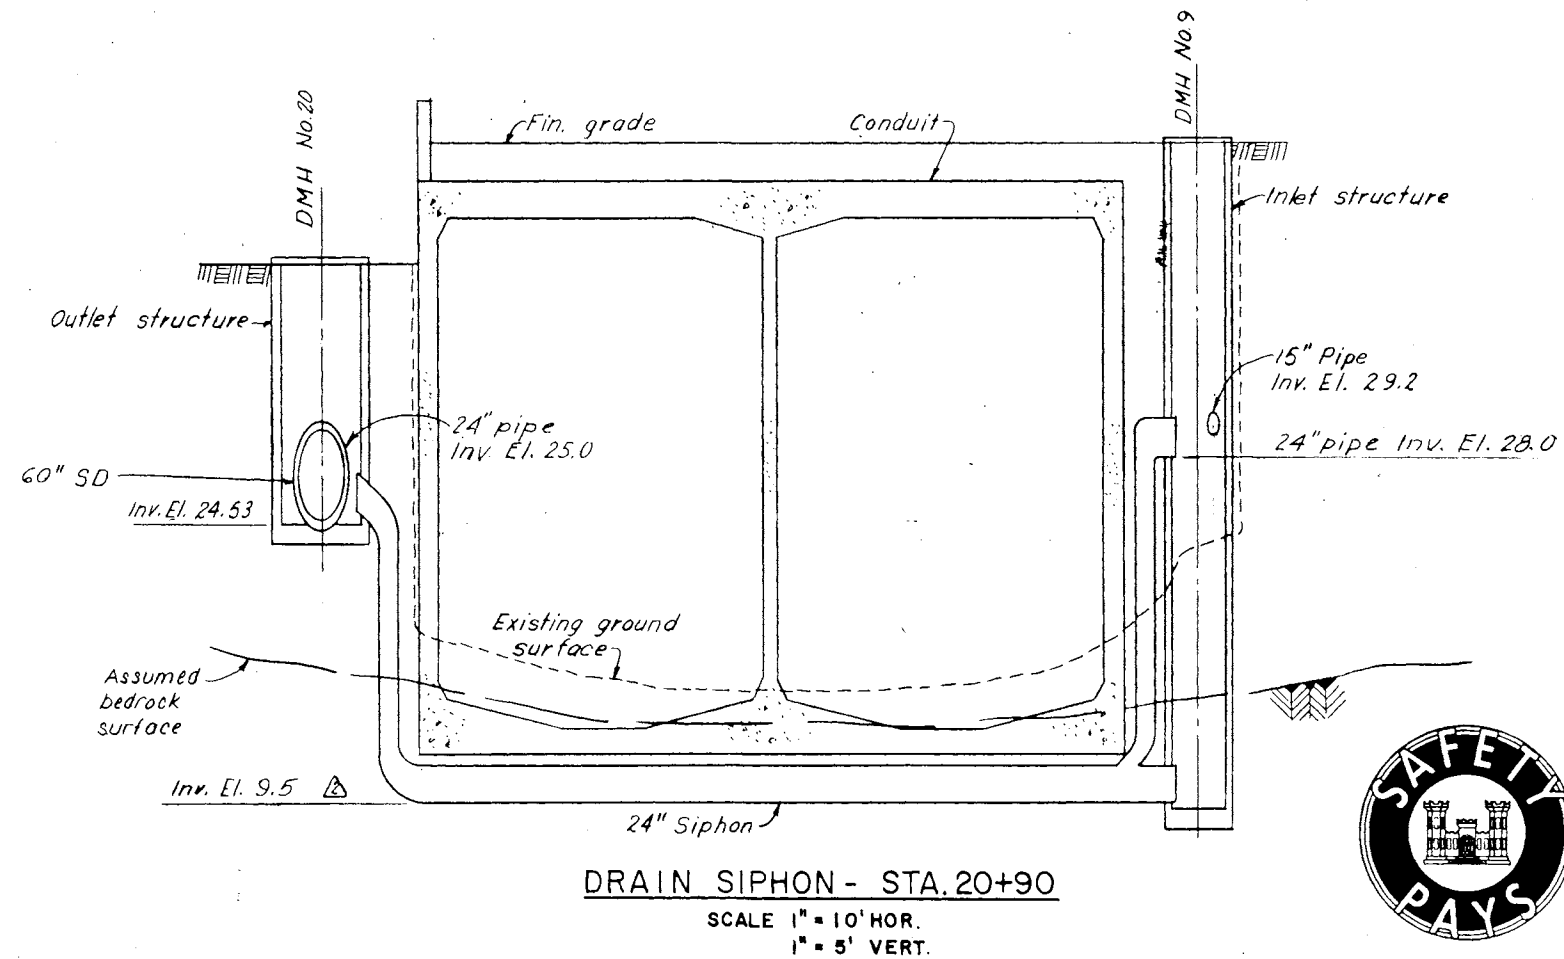
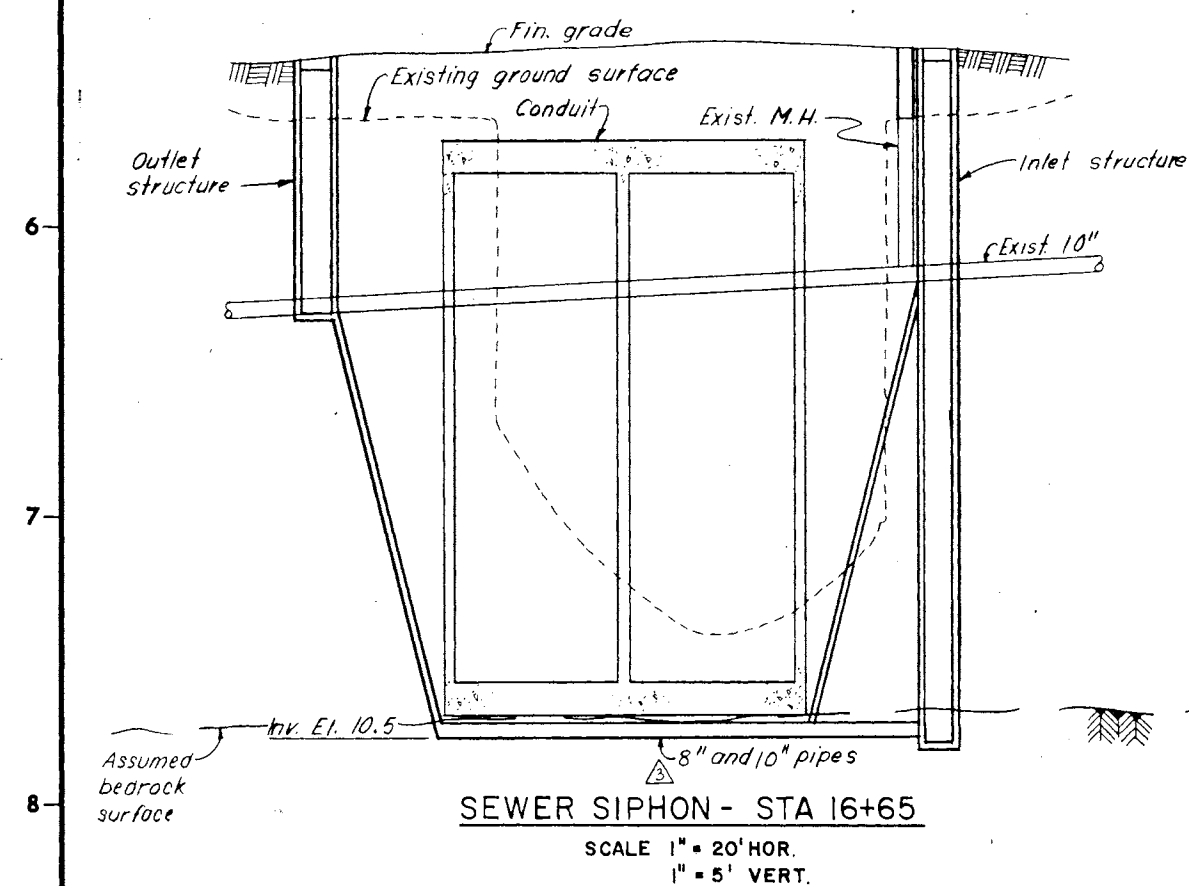
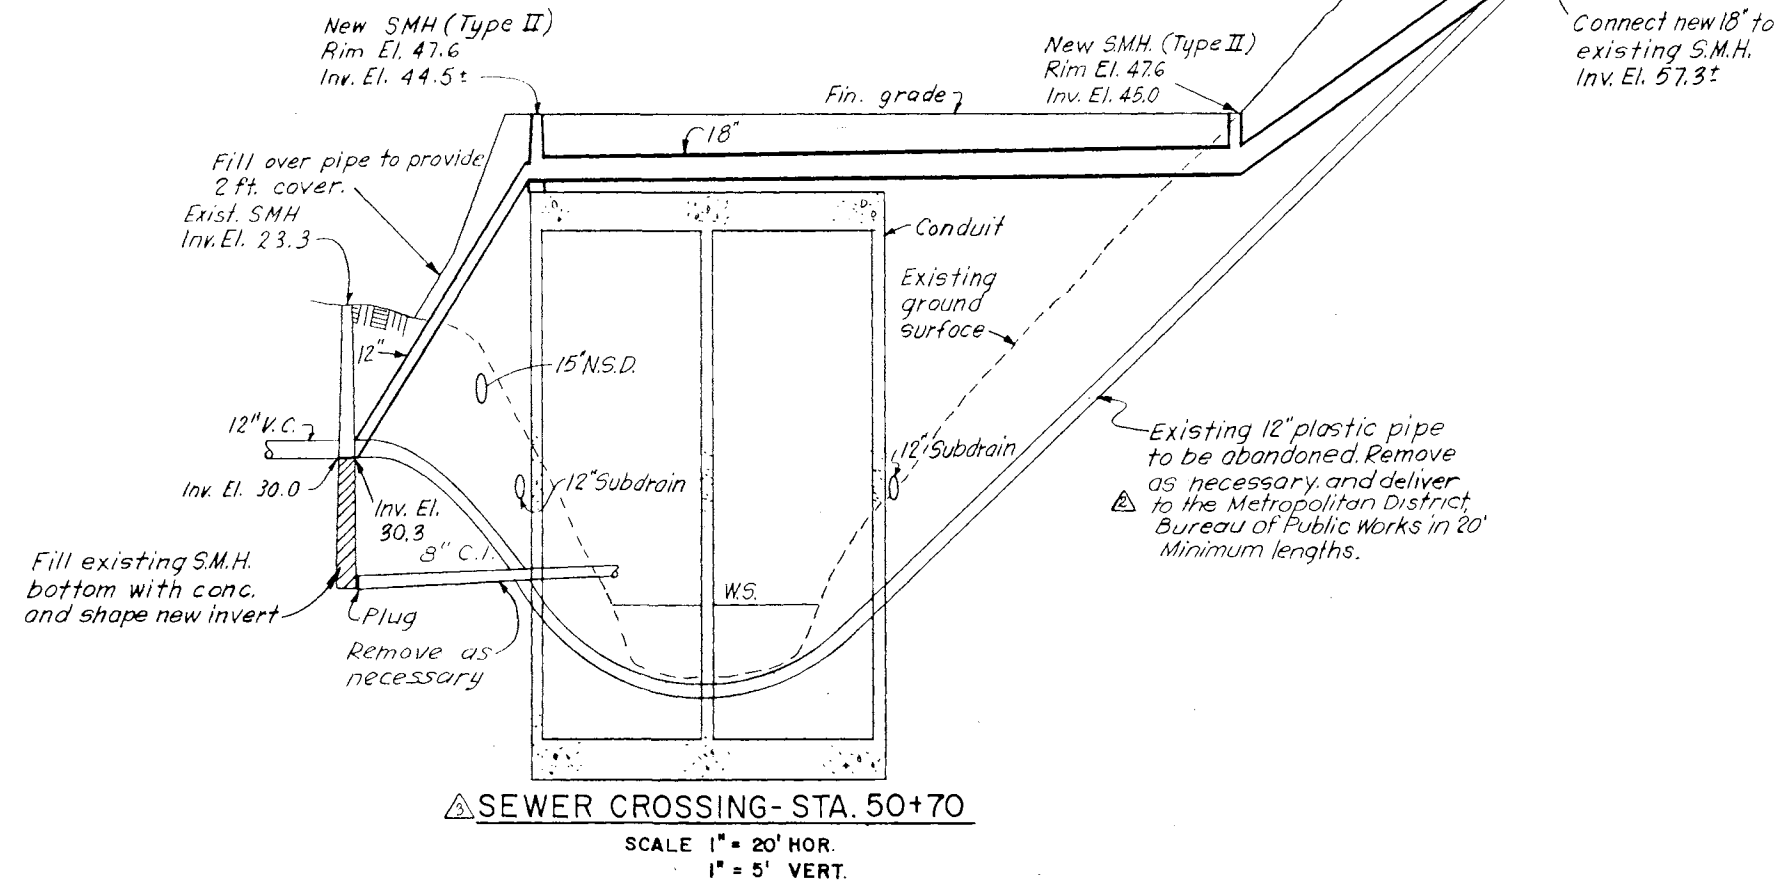


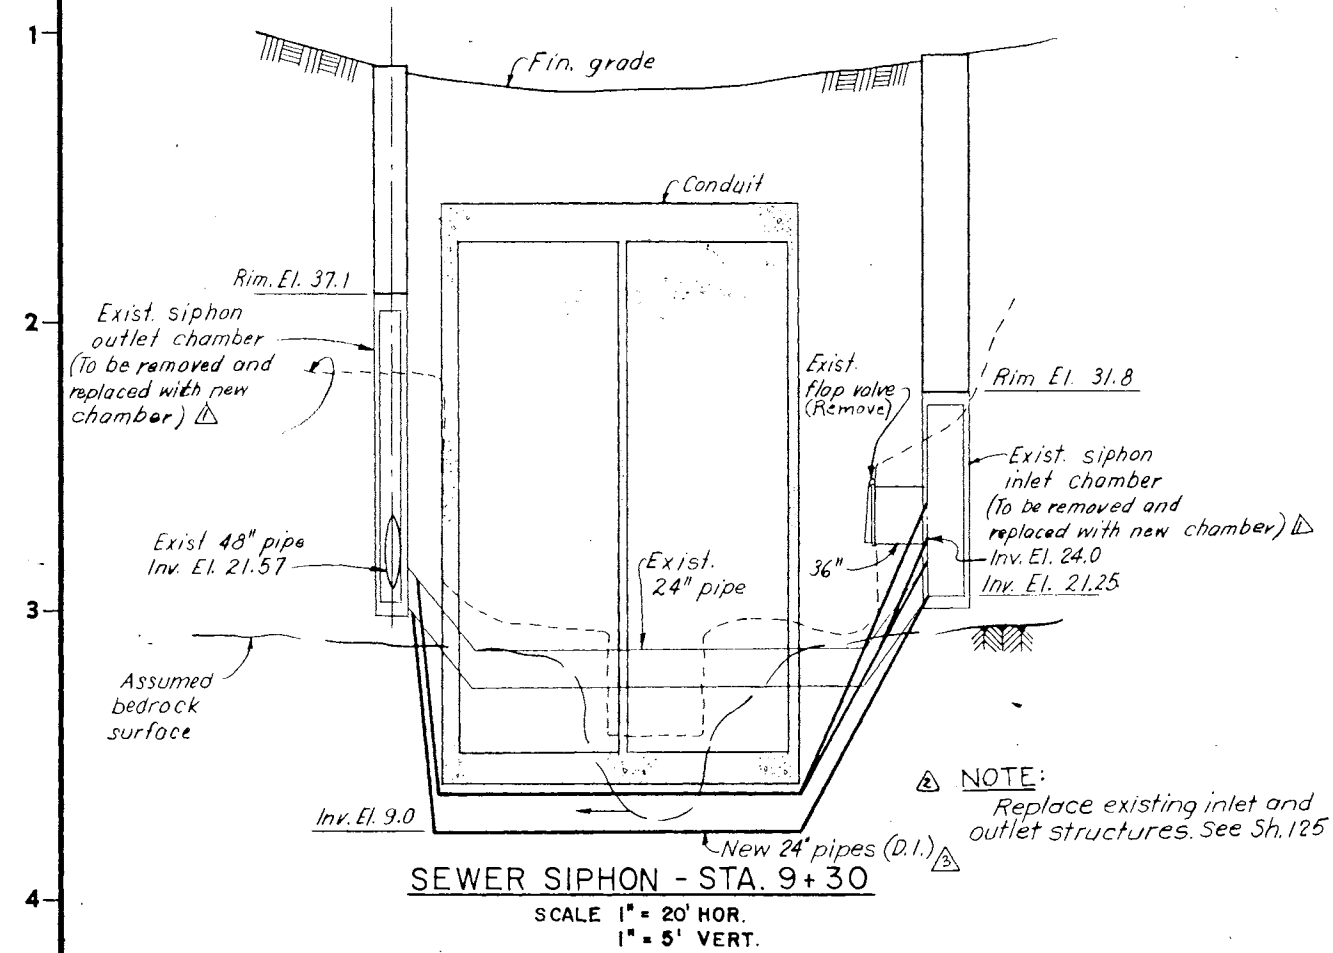

As Built Drawing

Contract No. DACW 33-76 C 0098

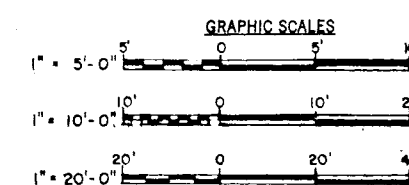

DES. BY W.F.	DR. BY W.F.	CHK. BY J.L.
SUBMITTED 1/1/76	1/1/76	1/1/76
CHIEF, UTILITIES SECTION	CHIEF, UTILITIES SECTION	CHIEF, UTILITIES SECTION
APPROVAL RECOMMENDED 1/1/76	1/1/76	1/1/76
REVIEWED 1/1/76	1/1/76	1/1/76
APPROVED 1/1/76	1/1/76	1/1/76
CHIEF, PROJECT BRANCH	CHIEF, PROJECT BRANCH	CHIEF, PROJECT BRANCH

DEPARTMENT OF THE ARMY
NEW ENGLAND DIVISION
CORPS OF ENGINEERS
WALTHAM, MASS.

WATER RESOURCES DEVELOPMENT PROJECT
PARK RIVER LOCAL PROTECTION

SEWER PROFILES

HARTFORD CONNECTICUT
DATE MARCH 1976

SCALE AS SHOWN SPEC. NO. DACW 33-76 B-0040
DRAWING NUMBER
PAR - 1
SHEET 115