



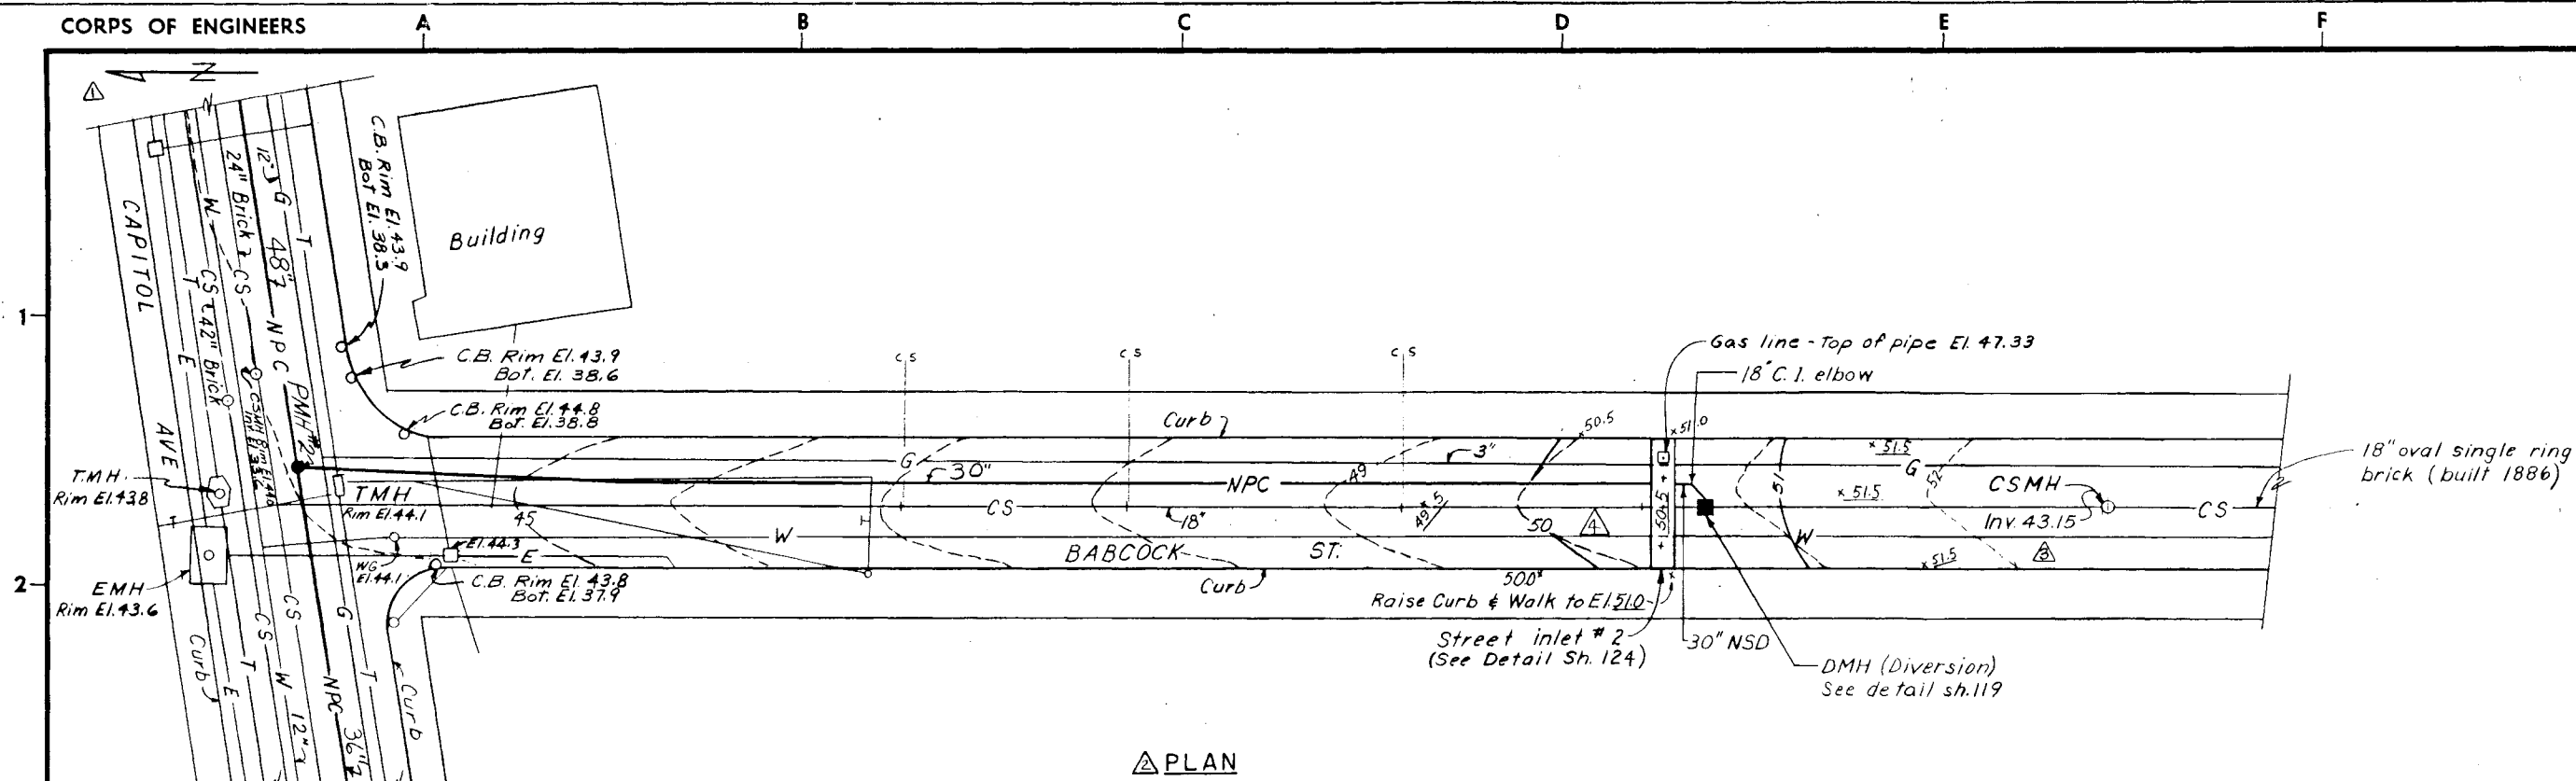


△ PLAN

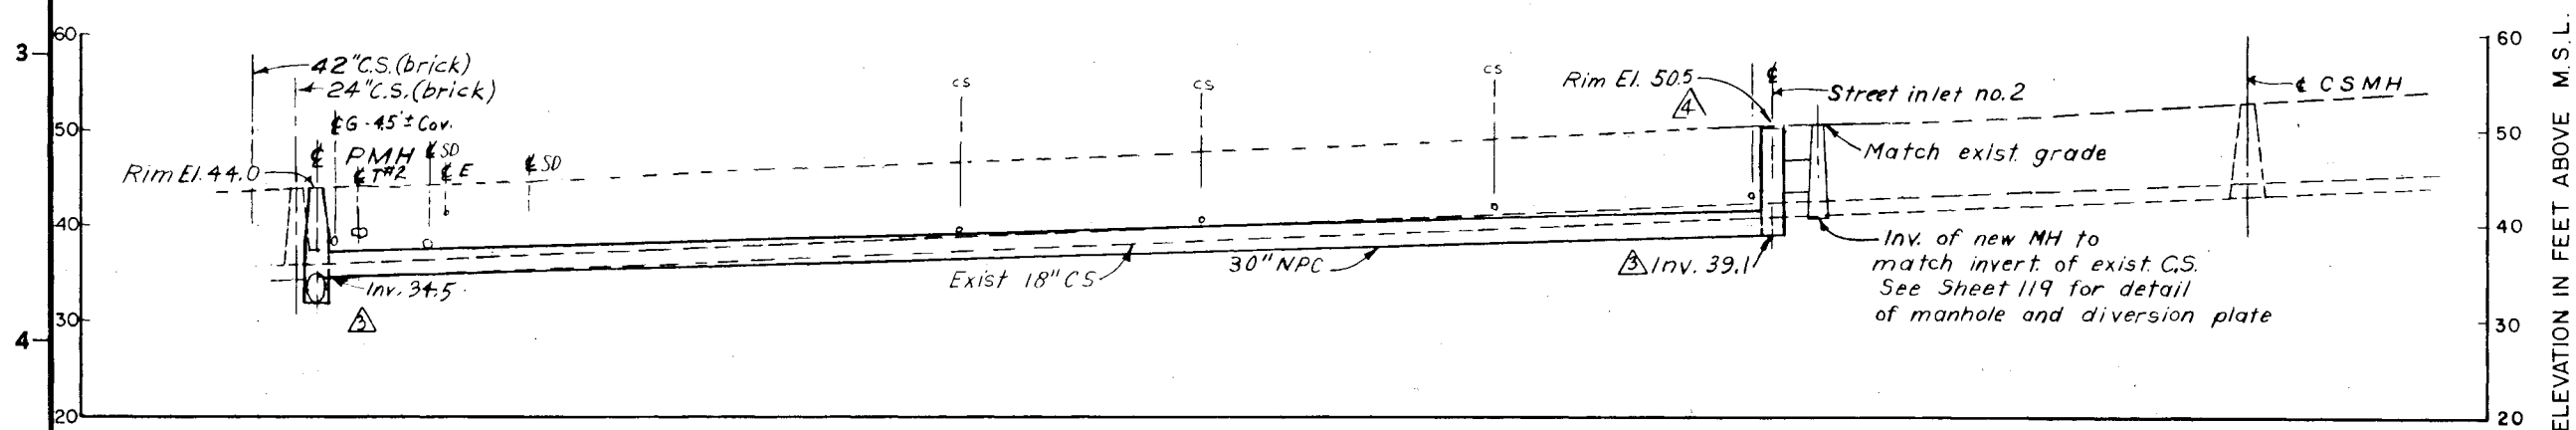


△ PROFILE

BABCOCK ST. PRESSURE CONDUIT

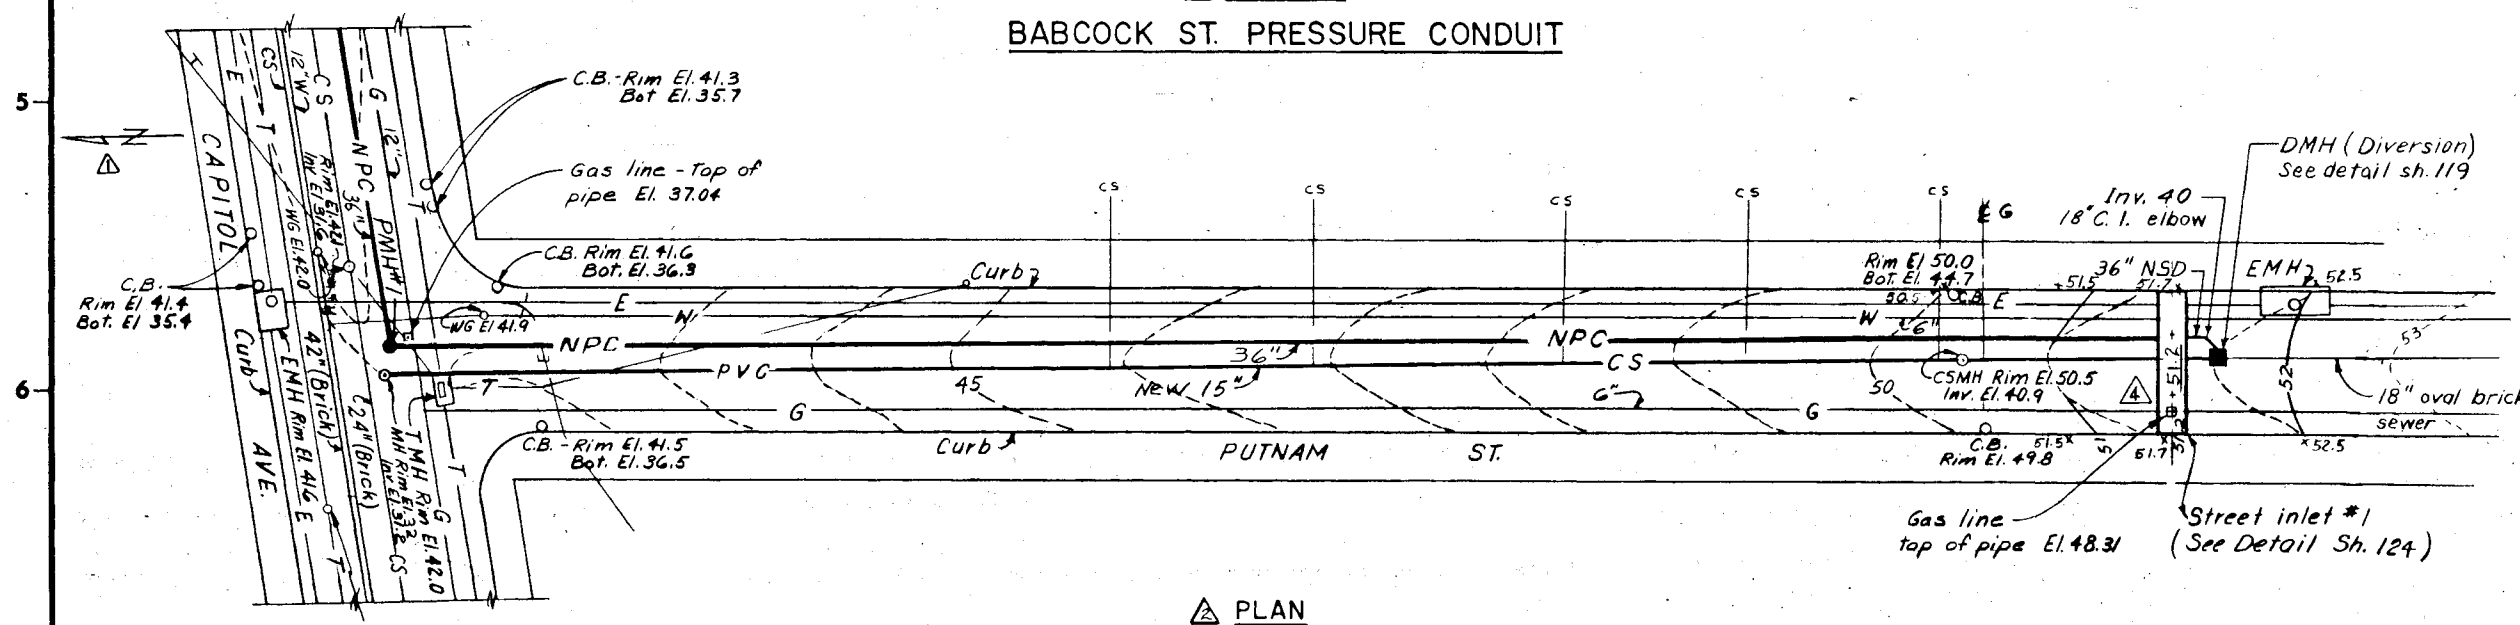

△ PLAN


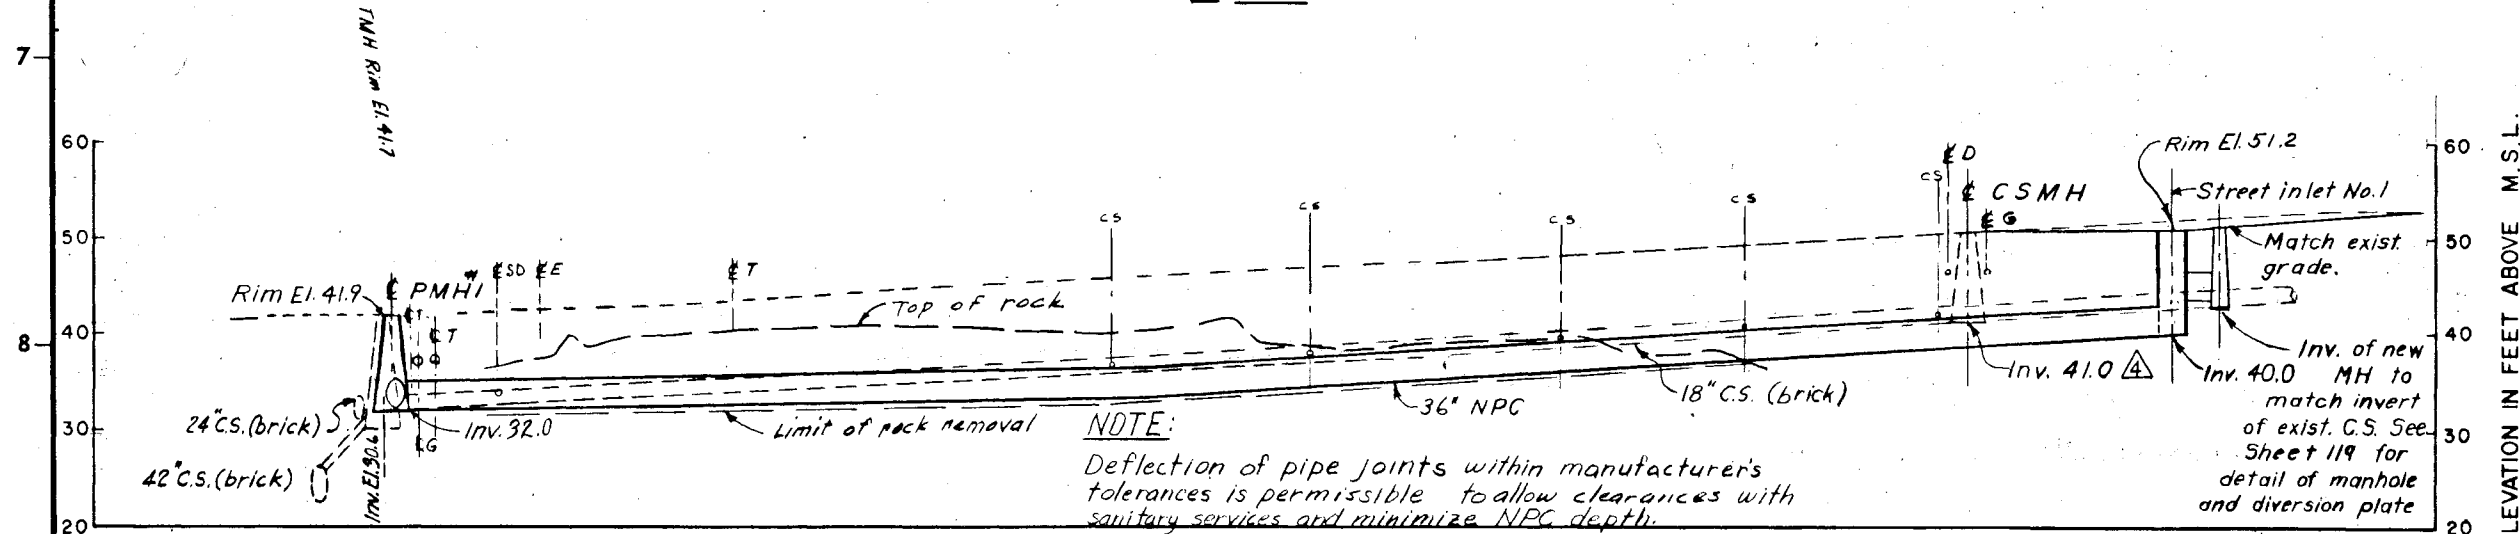


△ PROFILE

PUTNAM ST. PRESSURE CONDUIT

NOTES:

1. Combined sewers are shown on profile for information only.
2. Rim elevations on PMH's are approximate and should be adjusted to match existing grades.
3. For additional information on electrical and telephone lines see sheet 129.
4. When lateral drains to existing catch basins are in conflict with new pressure conduit, the drain shall be re-installed at elevations and slopes established by the Contracting Officer.
5. The area in the vicinity of new street inlets shall be reggraded.
All disturbed areas shall be restored with the same materials, base course and pavement thickness as the existing.
6. For detail of pressure manhole, see sheet 127.

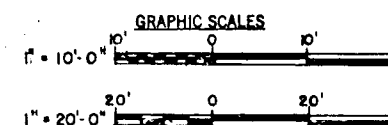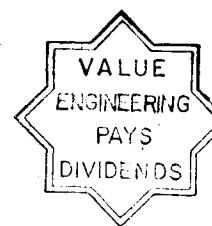

As Built Drawing
Contract No. DACW 33-76 C-0098

DES. BY W. F.	DR. BY W. F.	CK. BY W. F.	DATE MARCH 1976
SUBMITTED BY W. F.			
APPROVED BY W. F.			
REVIEWED BY W. F.			
PROJECT ENGINEER W. F.			
APPROVED W. F.			
DATE MARCH 1976			
SCALE AS SHOWN SPEC. NO. DACW 33-76-B-0040			
DRAWING NUMBER PAR-1			
SHEET 116			