
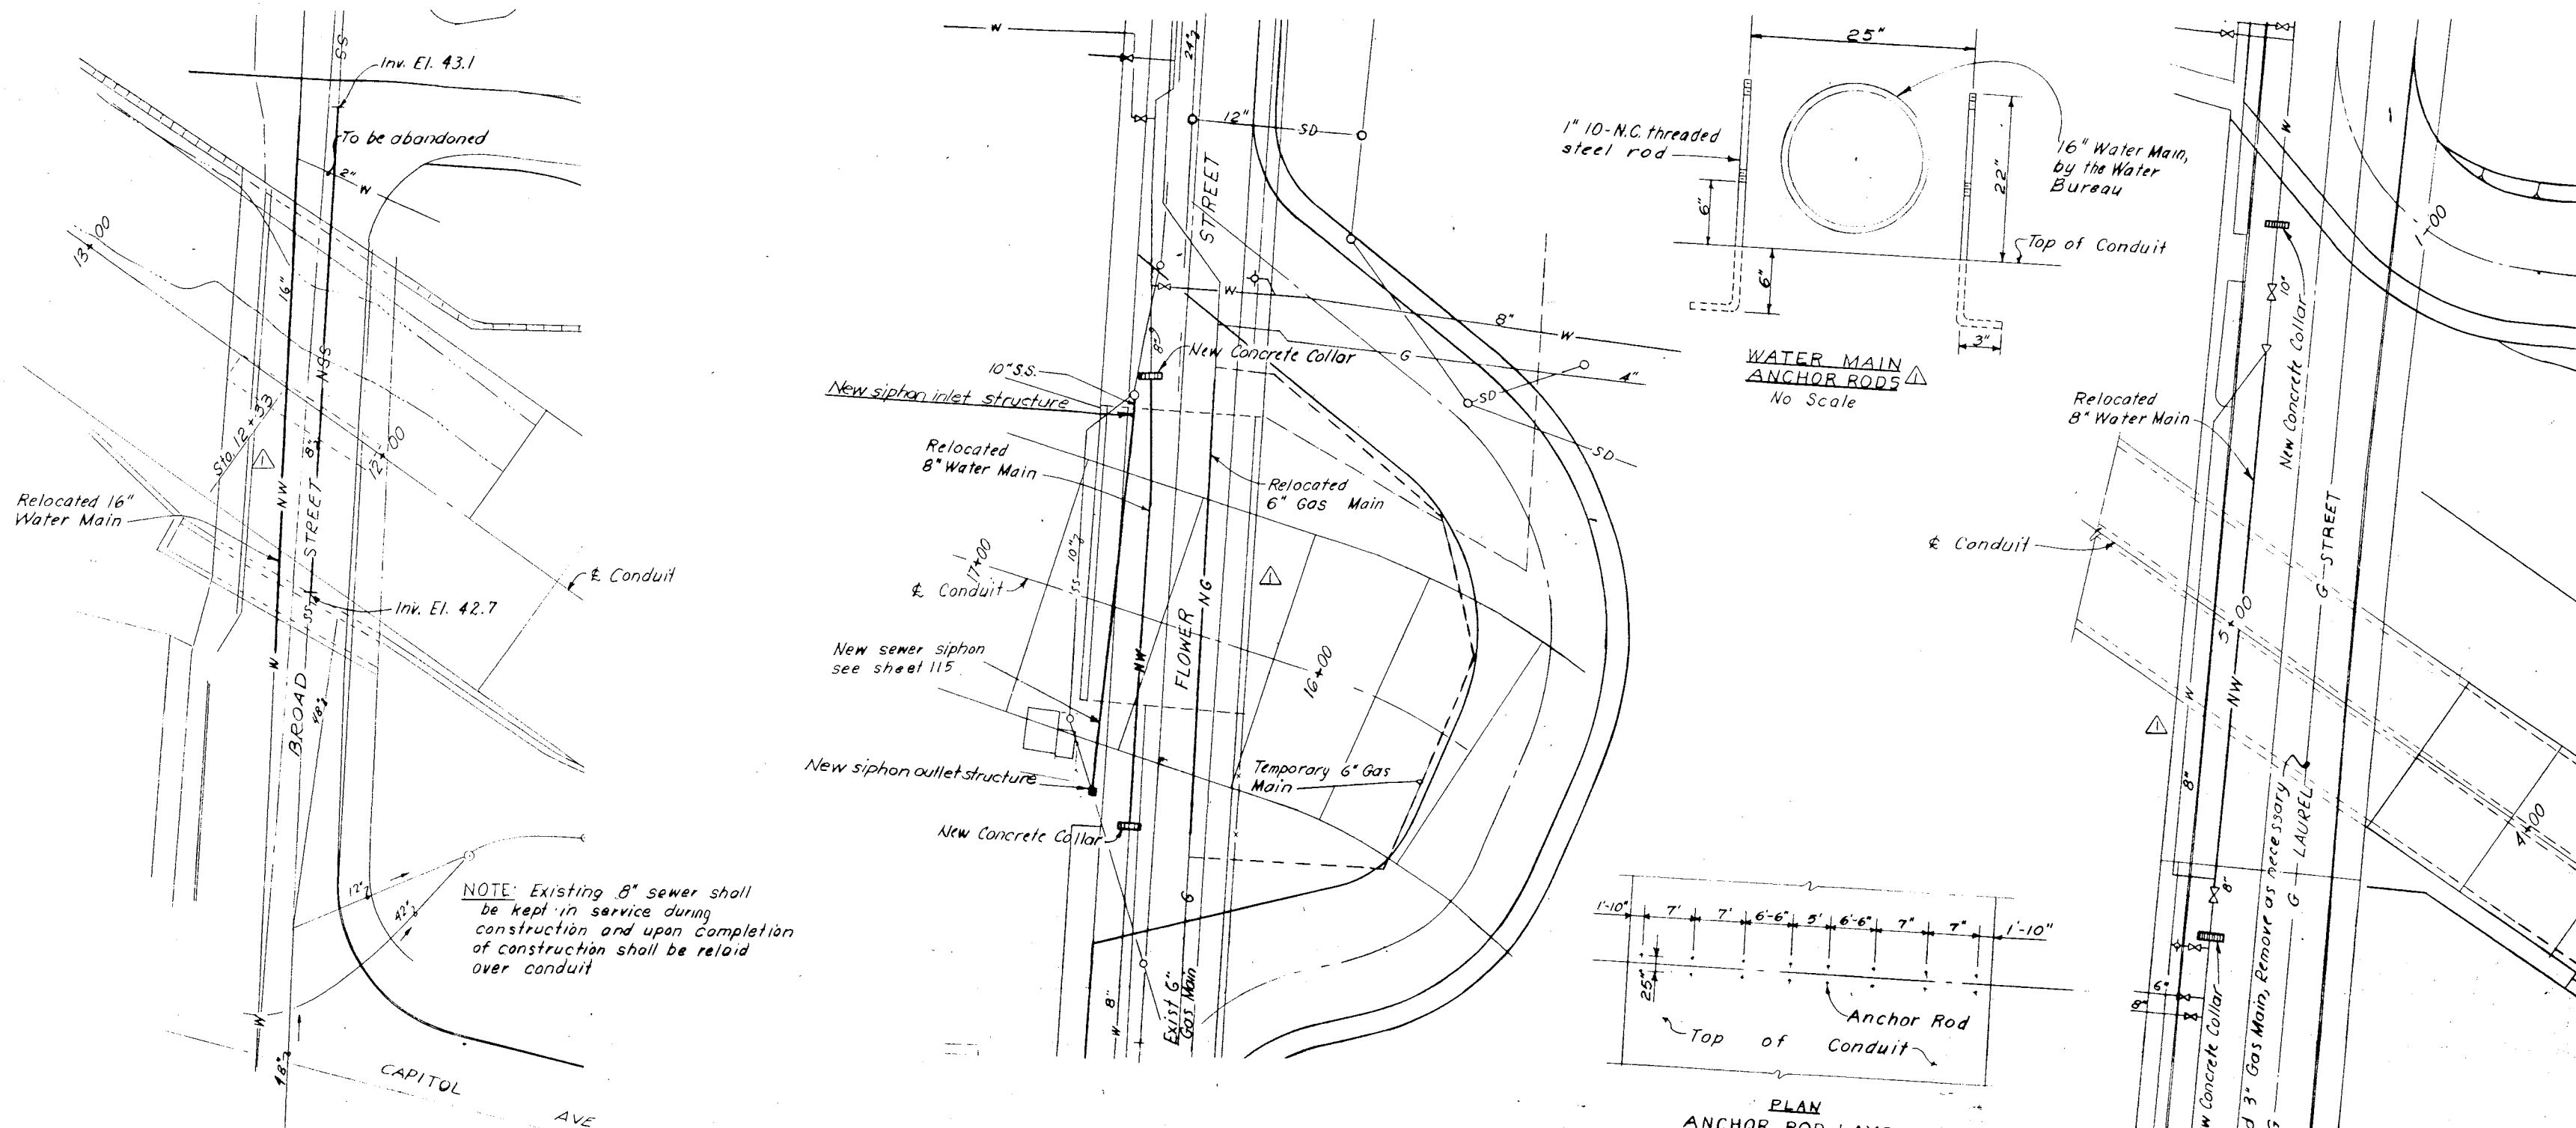
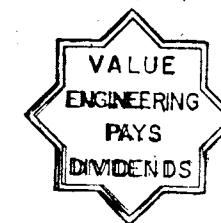


**General Notes:**

1. All new gas line work will be performed by the Connecticut Natural Gas Corporation.
2. All new water line work will be performed by The Metropolitan District Water Bureau.
3. All new sewer and drainage work shall be performed by the contractor.

NOTE:
ANCHOR ROD LAYOUT (NO SCALE)
 Anchor Rods required at Section 9, Stas. 40+33, 40+69, 41+21; also at Section 2, Sta. 12+33. Coordinate spacing at Section 2 with Metr. Dist. Water Bureau.

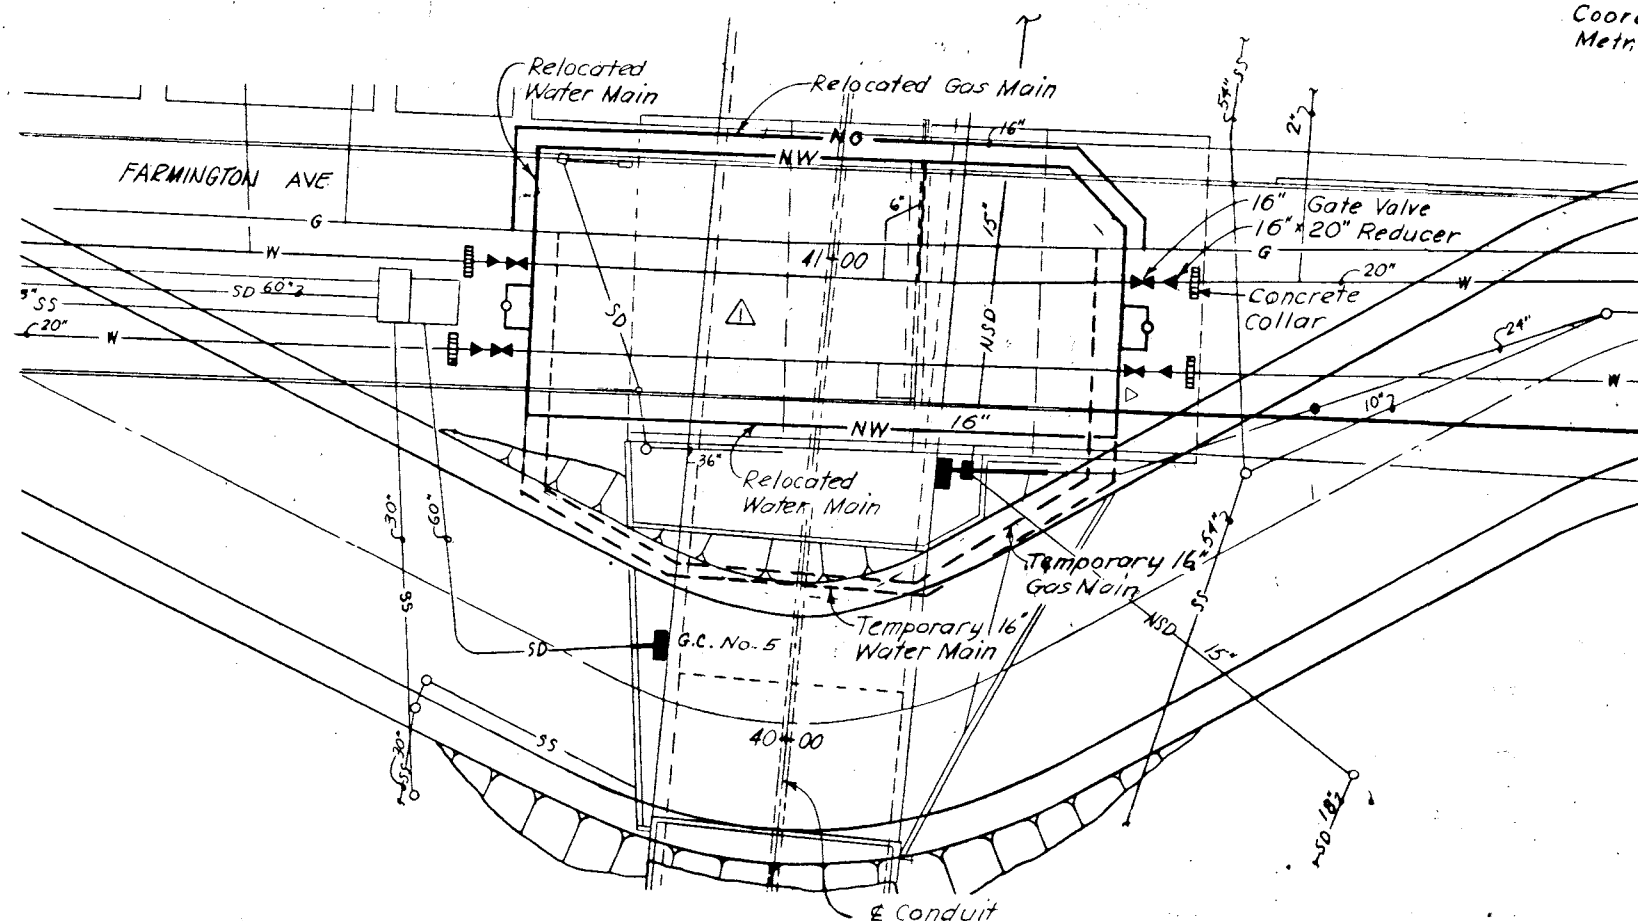

1" = 20' 0"

As Built Drawing

Contract No. DACW 33-76-C-0098

REVISION		DATE		DESCRIPTION		BY	
4-10-76		Plans revised; Details added. (Am #2)				J. H. F. 22	
DEPARTMENT OF THE ARMY NEW ENGLAND DIVISION CORPS OF ENGINEERS WALTHAM, MASS.							
DES. BY L.F.				CK. BY J.D. 26			
SUBMITTED 3/14/76				SECTION UTILITIES			
APPROVAL [Signature]				CHIEF OF THE BRANCH			
REVIEWED [Signature]				PROJECT ENGINEER			
APPROVAL [Signature]				CHIEF OF THE BRANCH			
HARTFORD				CONNECTICUT			
APPROVED [Signature]				DATE MARCH 1976			
SCALE AS SHOWN				SPEC. NO. DACW 33-76-B-0040			
DRAWING NUMBER PAR-1				SHEET 120			