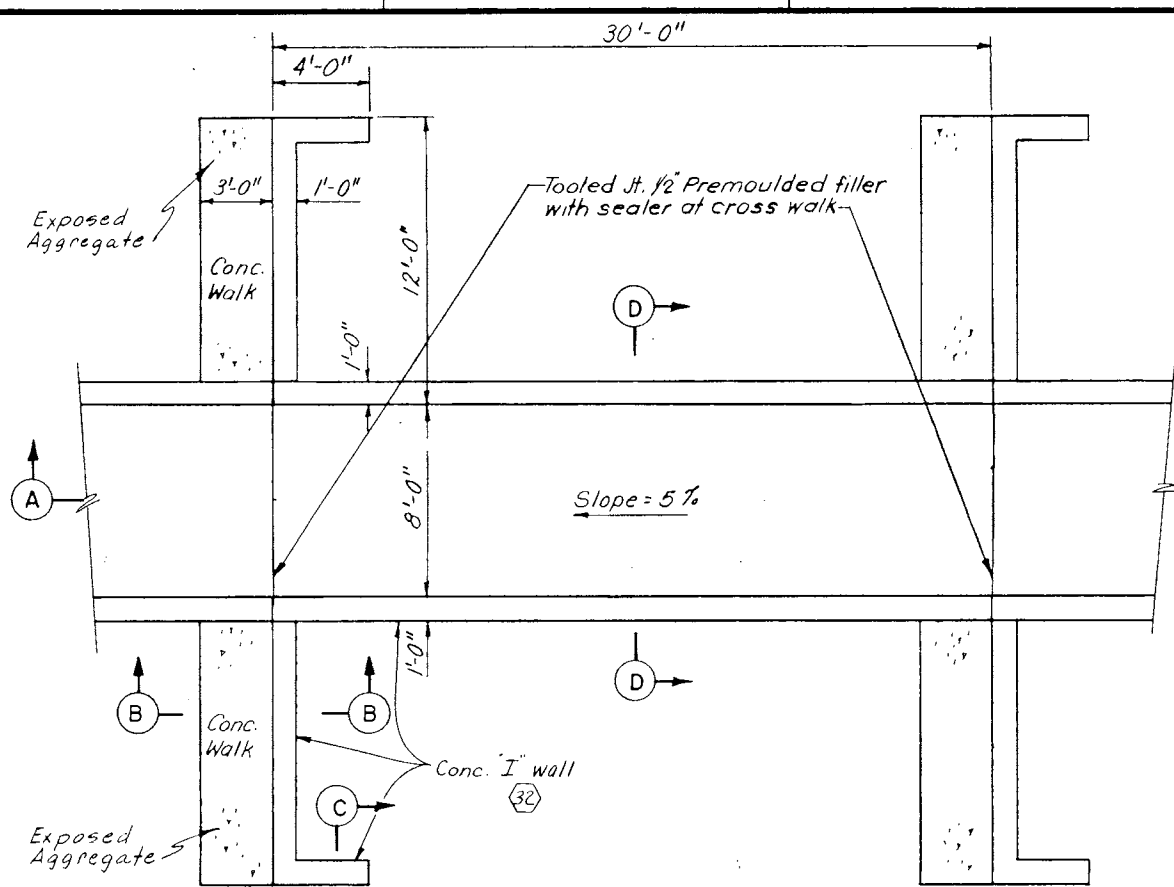
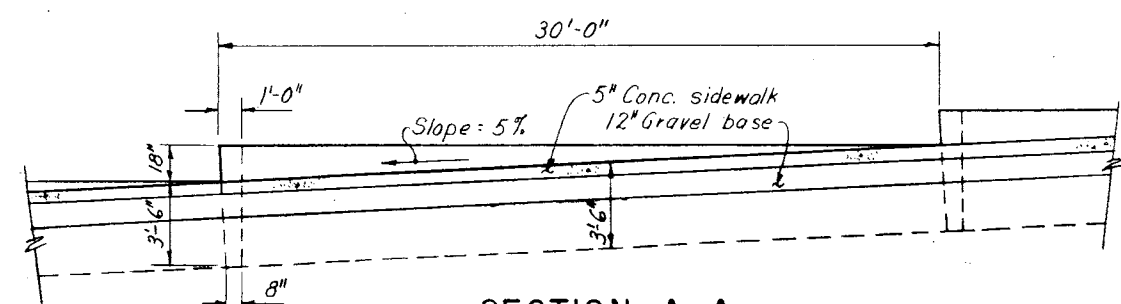


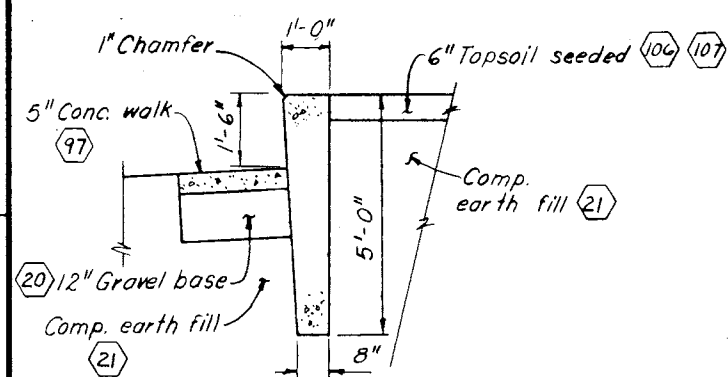
**8-FOOT SIDEWALK**

PLAN

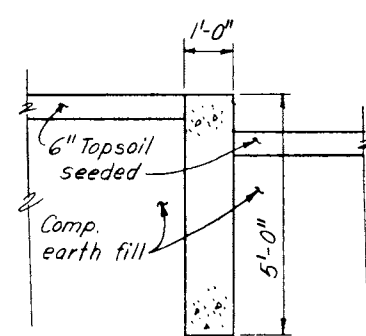
SCALE 1/4" = 1'-0"

**SECTION A-A**

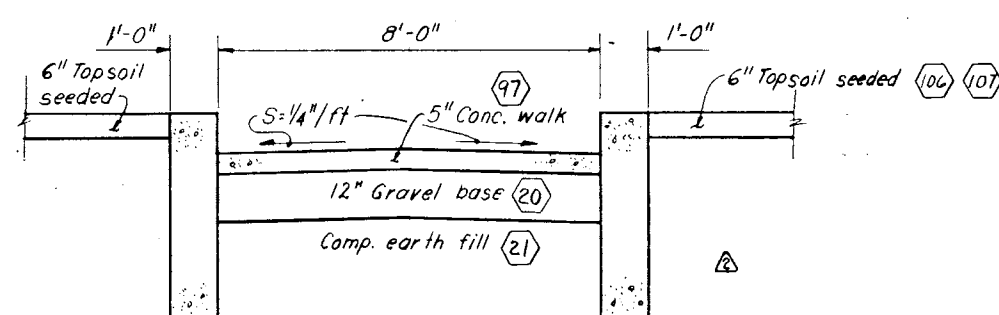
SCALE 1/4" = 1'-0"

**SECTION B-B**

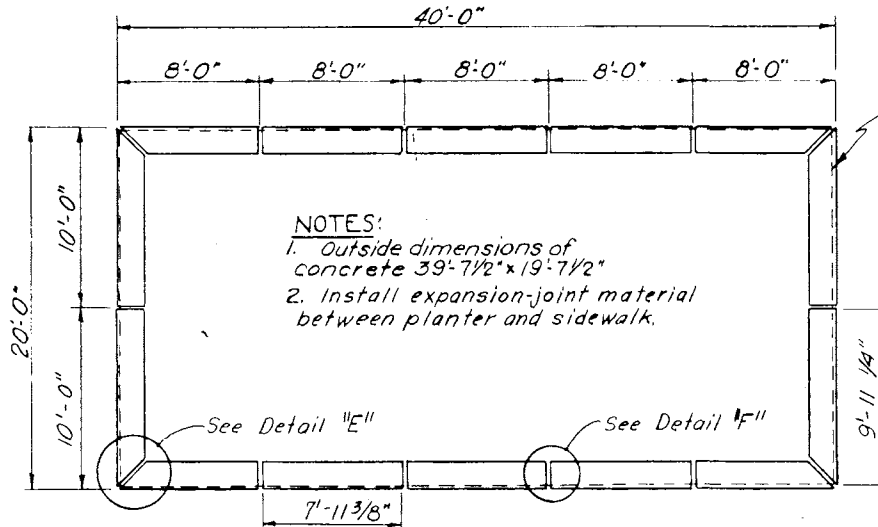
SCALE 1/2" = 1'-0"

**SECTION C-C**

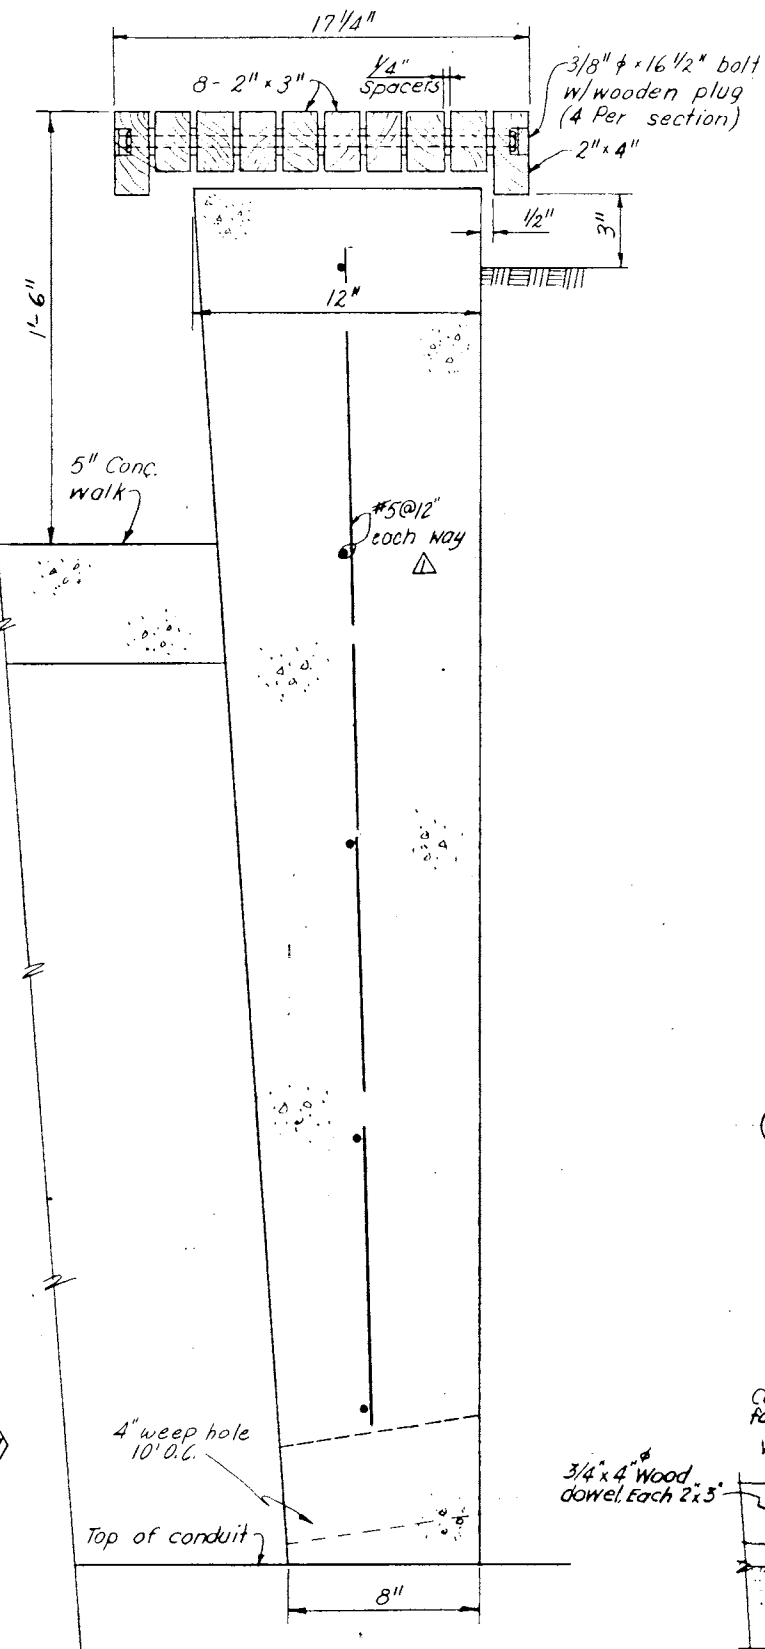
SCALE 1/2" = 1'-0"

**SECTION D-D**

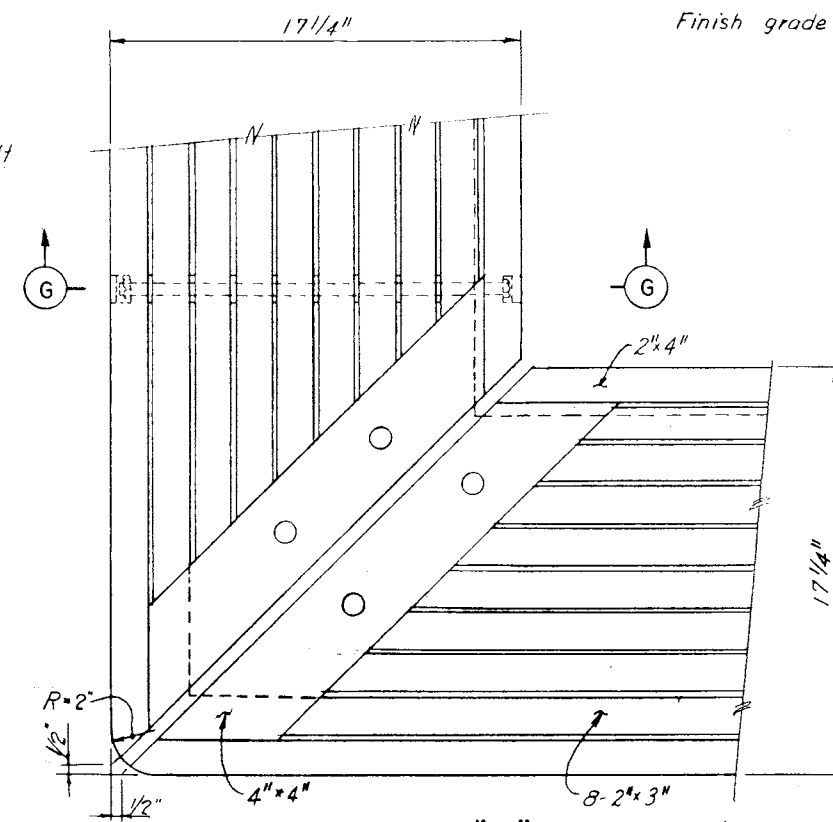
SCALE 1/2" = 1'-0"

**PLANTER**

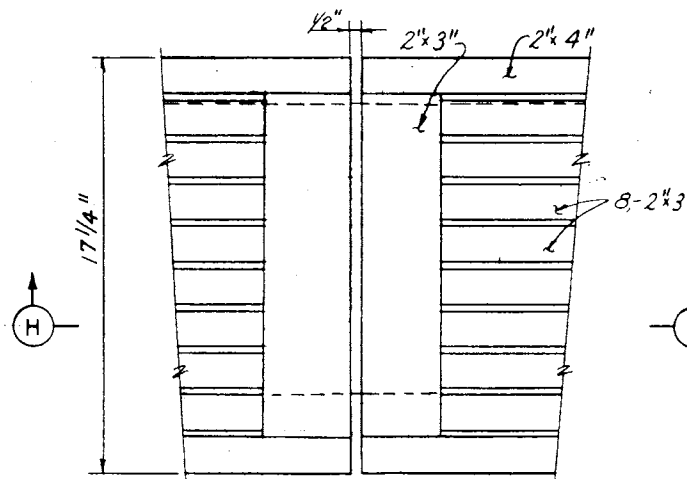
SCALE 3/16" = 1'-0"

**SECTION G-G**

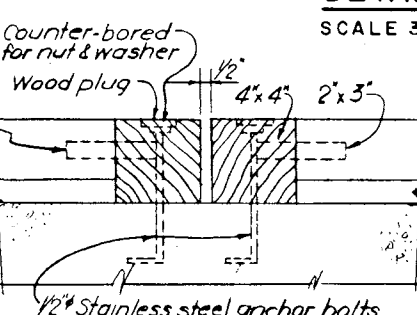
SCALE 3" = 1'-0"

**DETAIL "E"**

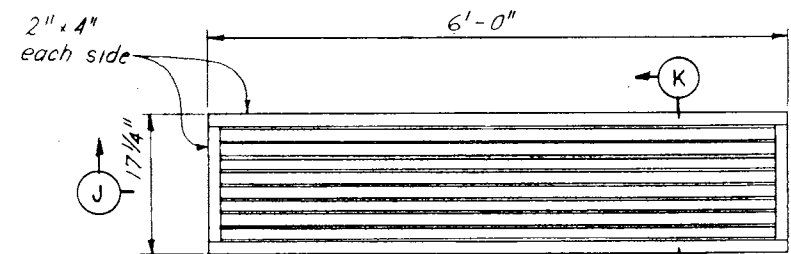
SCALE 3" = 1'-0"

**DETAIL "F"**

SCALE 3" = 1'-0"

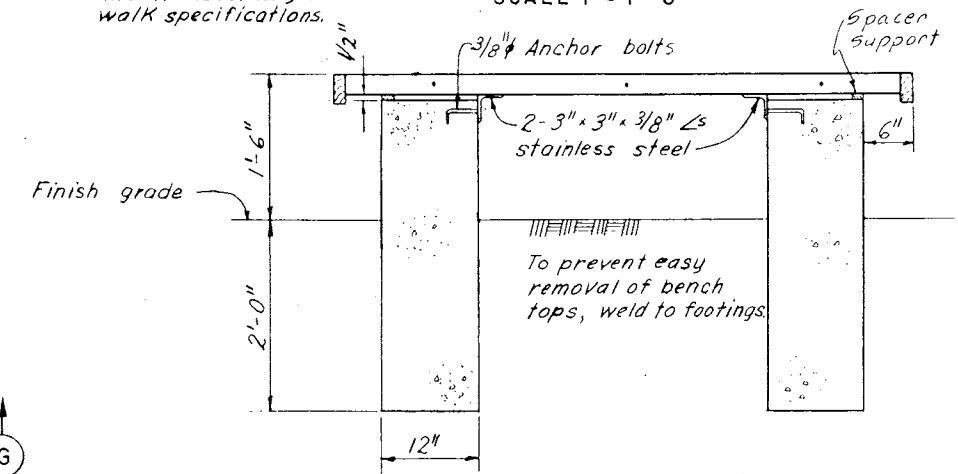
**SECTION H-H**

SCALE 3" = 1'-0"

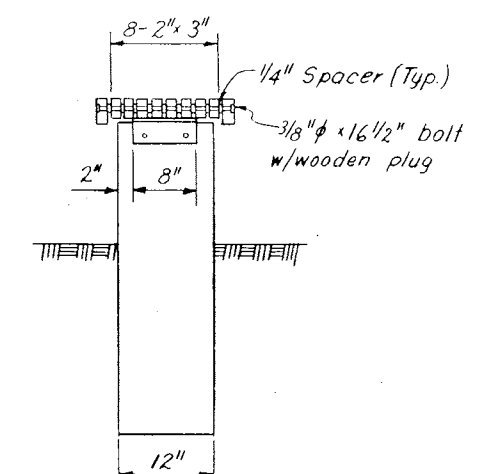
**BENCH PLAN**

SCALE 1" = 1'-0"

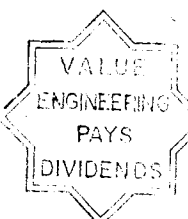
NOTE: Install 17 1/4" foot-pads between benches and existing walks, with expansion-joint material each side. Install according to concrete walk specifications.

**SECTION J-J**

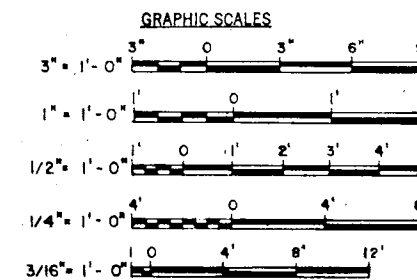
SCALE 1" = 1'-0"

**SECTION K-K**

SCALE 1" = 1'-0"



As Built drawing
Contract No. DACW 33-76 C 0098



4-4-83 Final field corrections			
REVISION	DATE	DESCRIPTION	BY
1	June 76	Note deleted (Am #4)	
2	June 76	Revised note (Am #2)	
DEPARTMENT OF THE ARMY NEW ENGLAND DIVISION CORPS OF ENGINEERS WALTHAM, MASS.			
WATER RESOURCES DEVELOPMENT PROJECT PARK RIVER LOCAL PROTECTION			
PLANTING MISCELLANEOUS DETAILS NO.1			
HARTFORD		CONNECTICUT	
APPROVED		DATE MARCH 1976	
SPECIAL ENGINEERING DIVISION		SCALE AS SHOWN	
DRAWING NUMBER		SPEC. NO. DACW33-76-B-0040	
PAR-1		SHEET 121	