




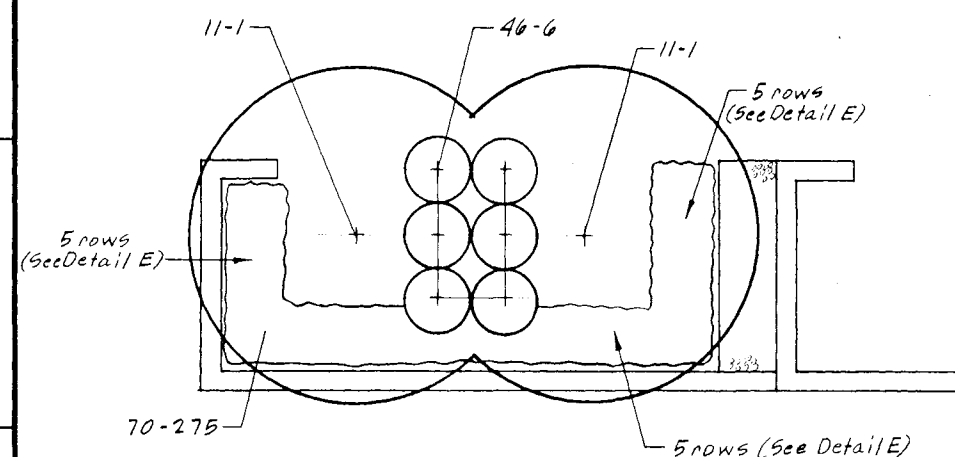


DETAIL A
SCALE: 1" = 5'

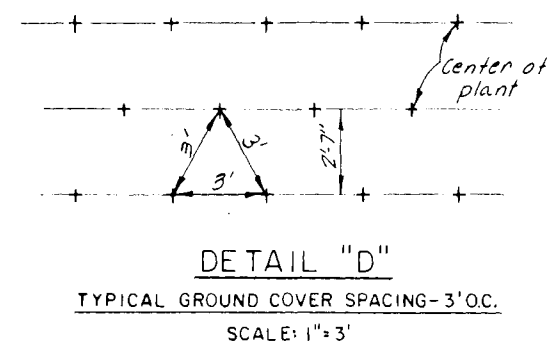


DETAIL "D"
TYPICAL GROUND COVER SPACING-3' O.C.
SCALE: 1" = 3'

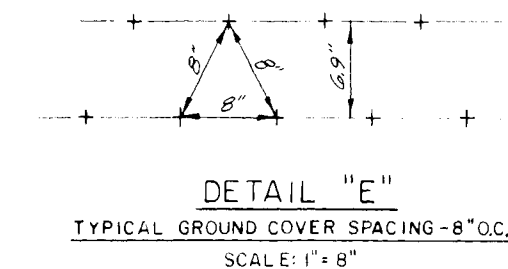

DETAIL "E"
TYPICAL GROUND COVER SPACING-8" O.C.
SCALE: 1" = 8'

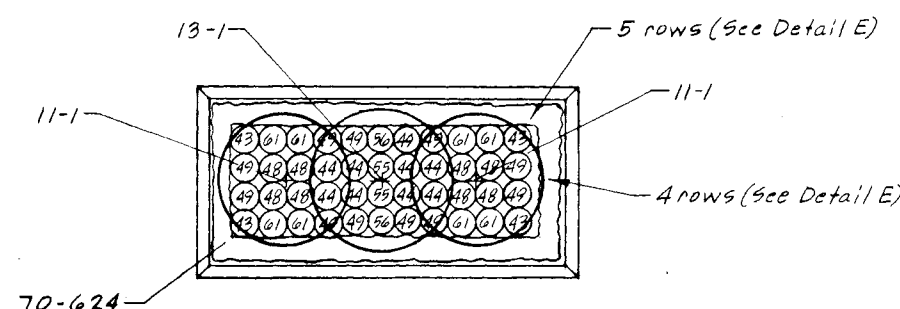


DETAIL B
SCALE: 1" = 10'

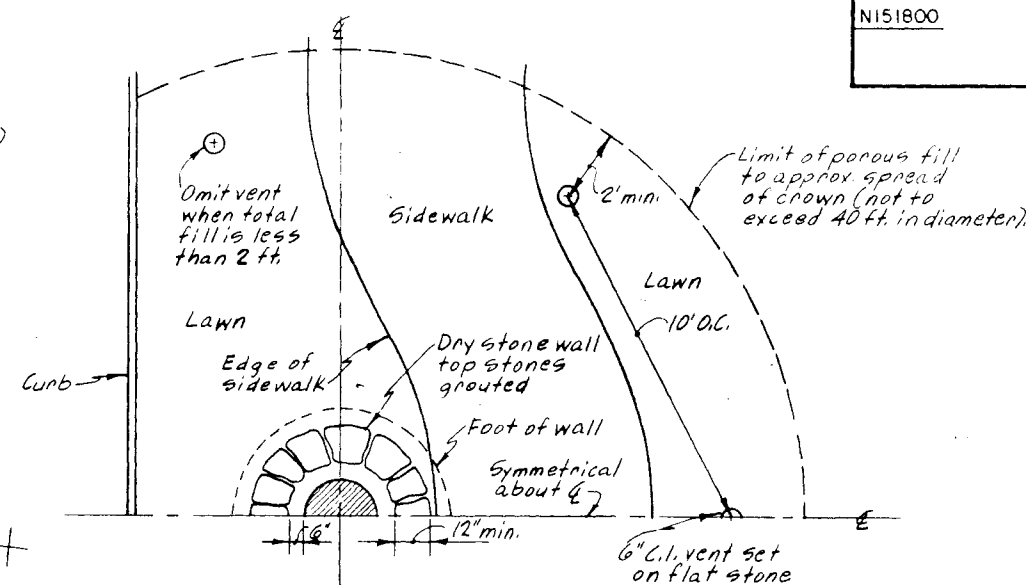

PLAN



NOTE: Porous fill to extend from tree well to limit of branches where new grade is 6" or more above existing grade.

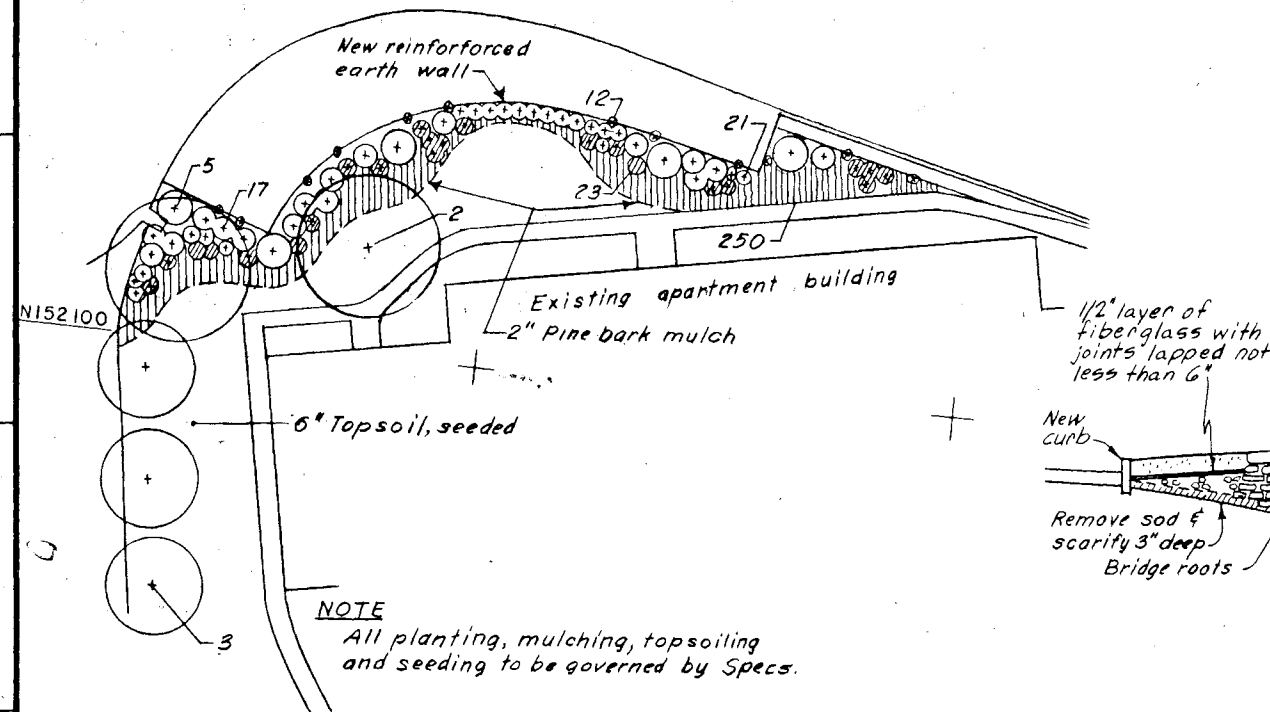

SECTION

TREE WELL (122)
SCALE: 3/8" = 1'-0"


For location of tree well see Sheet 23.

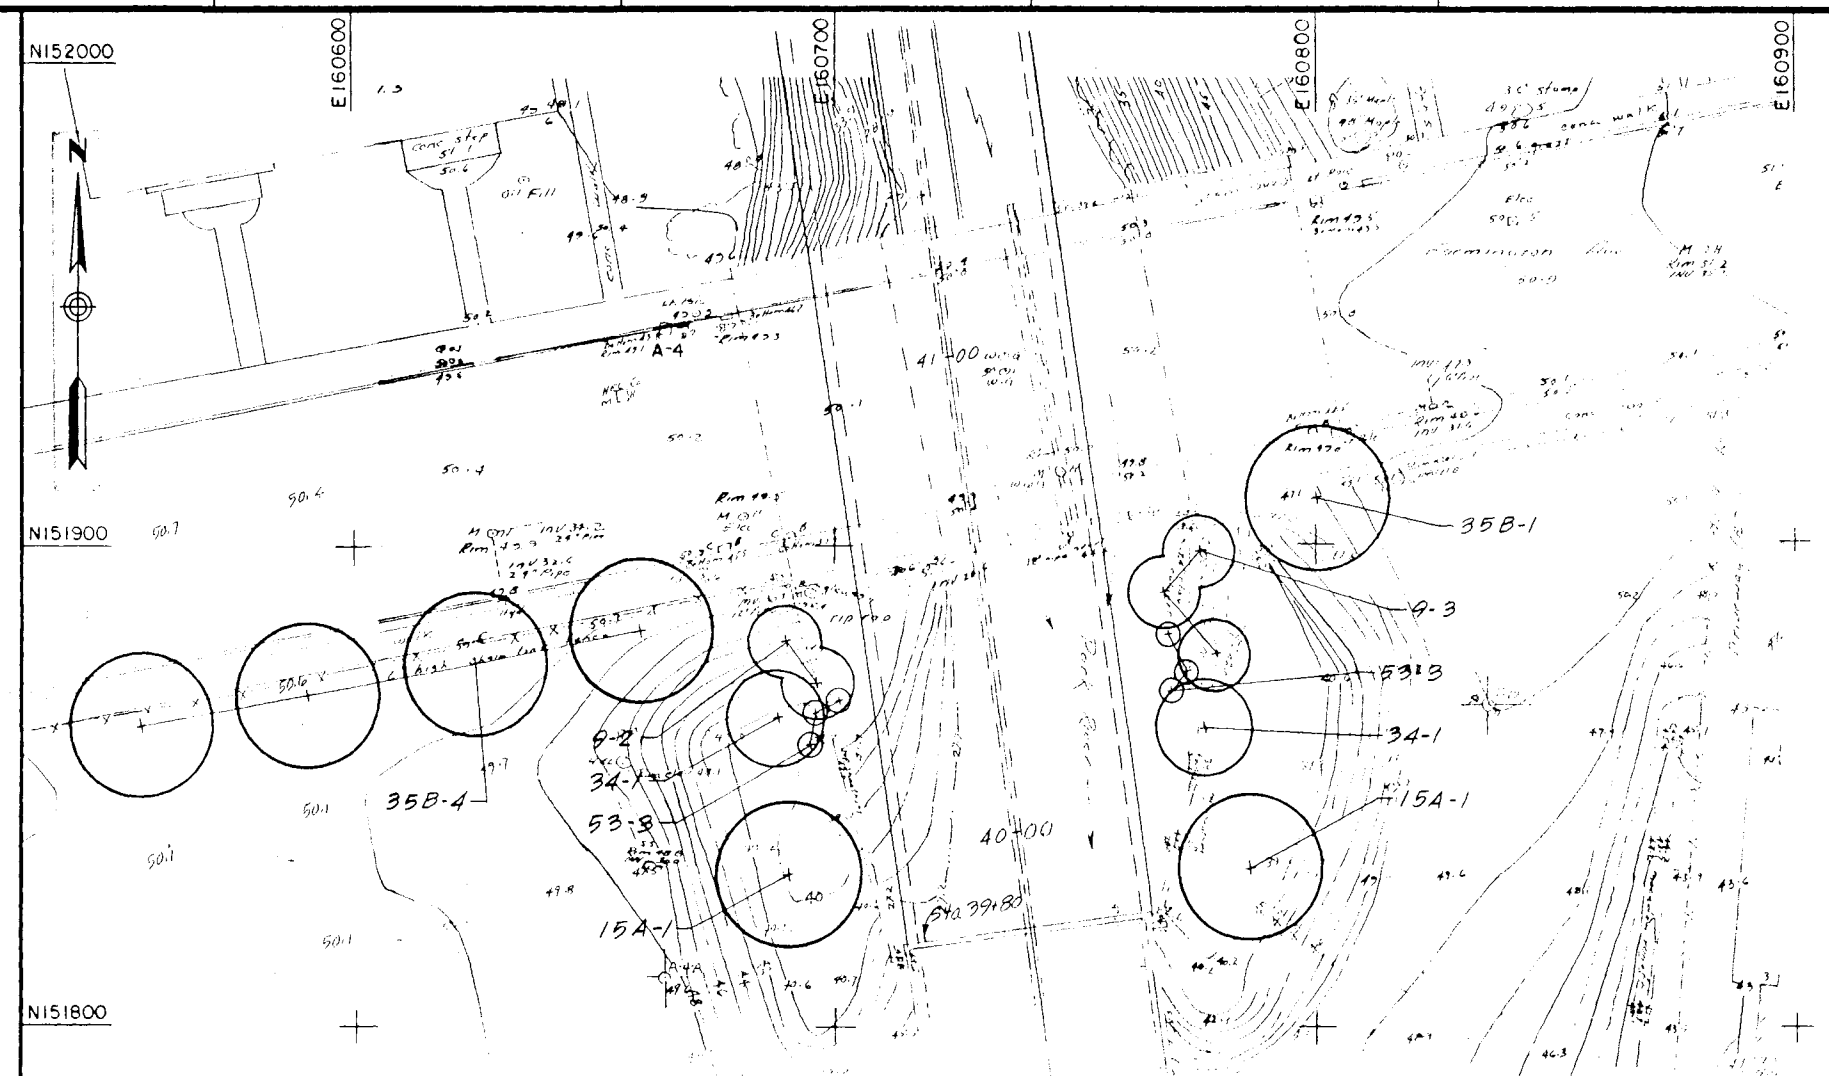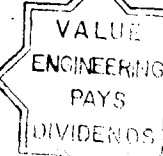

PLANTING SECTION 9 (122) For additional planting see Sheet 79A
SCALE: 1" = 20'


As Built Drawing

Contract No. DACW 33-78-C-0098

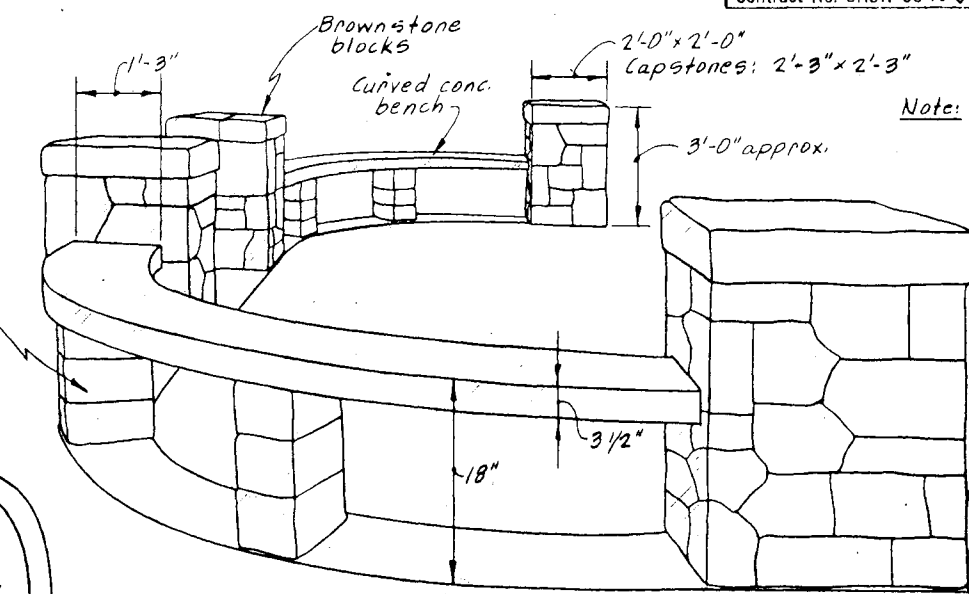

BENCH DETAIL PERSPECTIVE (125)
NO SCALE

For location of bench see Sheet 35.

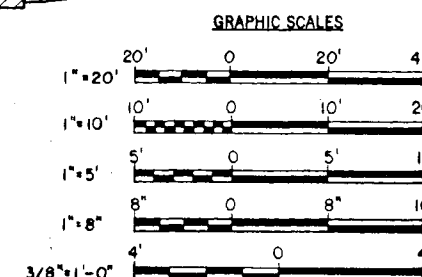

REVISION	DATE	DESCRIPTION	BY

DEPARTMENT OF THE ARMY
NEW ENGLAND DIVISION
CORPS OF ENGINEERS
WALTHAM, MASS.

DES. BY: D.A.N. L.R.L. D.A.N.
SUBMITTED: *David Milande*
LANDSCAPE ARCHITECT
APPROVAL: *John E. ...*
REVIEWED: *John E. ...*
PROJECT ENGINEER
APPROVED: *John E. ...*
CHIEF, PROJECT BRANCH

WATER RESOURCES DEVELOPMENT PROJECT
PARK RIVER LOCAL PROTECTION
PLANTING
MISCELLANEOUS DETAILS NO. 2
HARTFORD CONNECTICUT
DATE: MARCH 1978
SCALE: AS SHOWN SPEC. NO. DACW 33-78-B-0040
DRAWING NUMBER
PAR-1
SHEET 122