



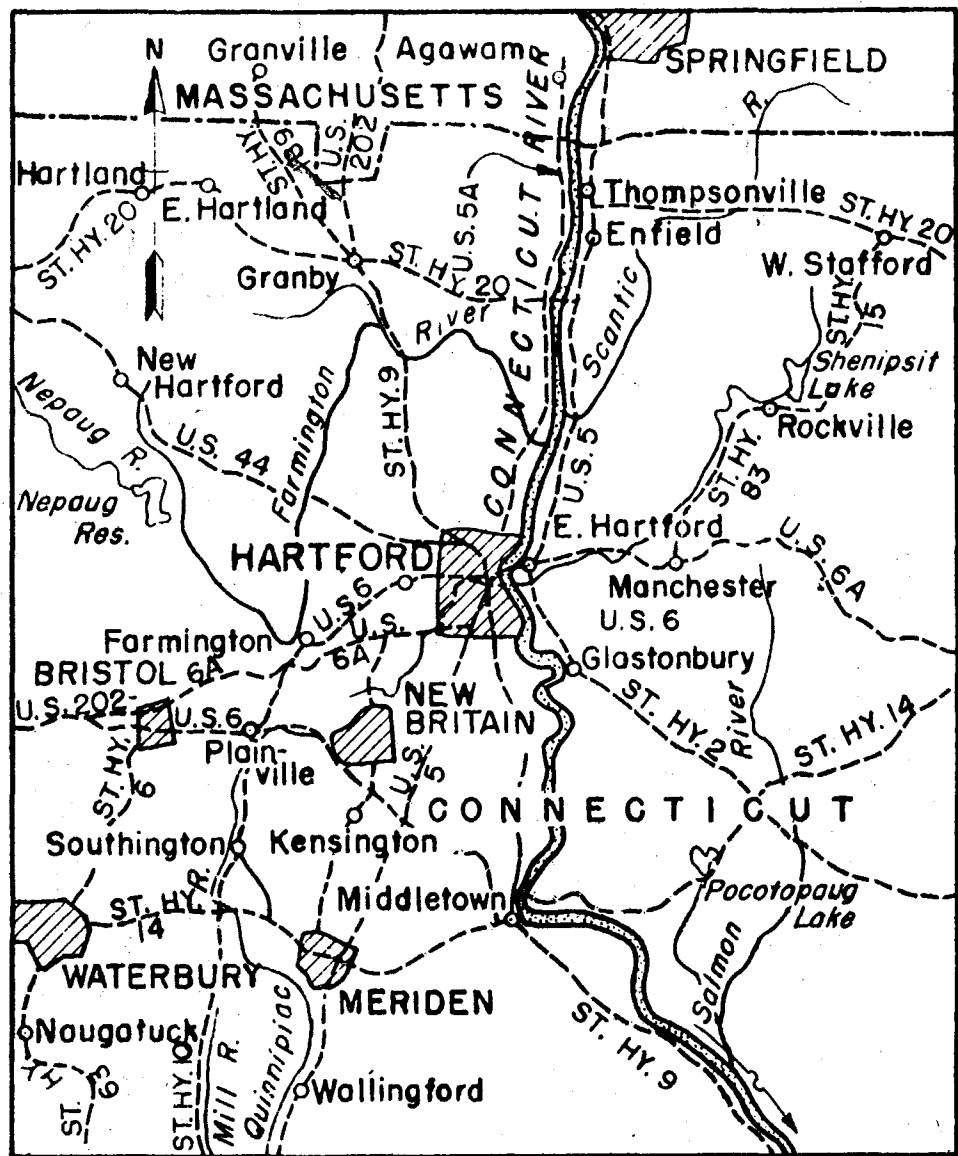

LOCATION MAP
SCALE 1 IN. = 8 Miles

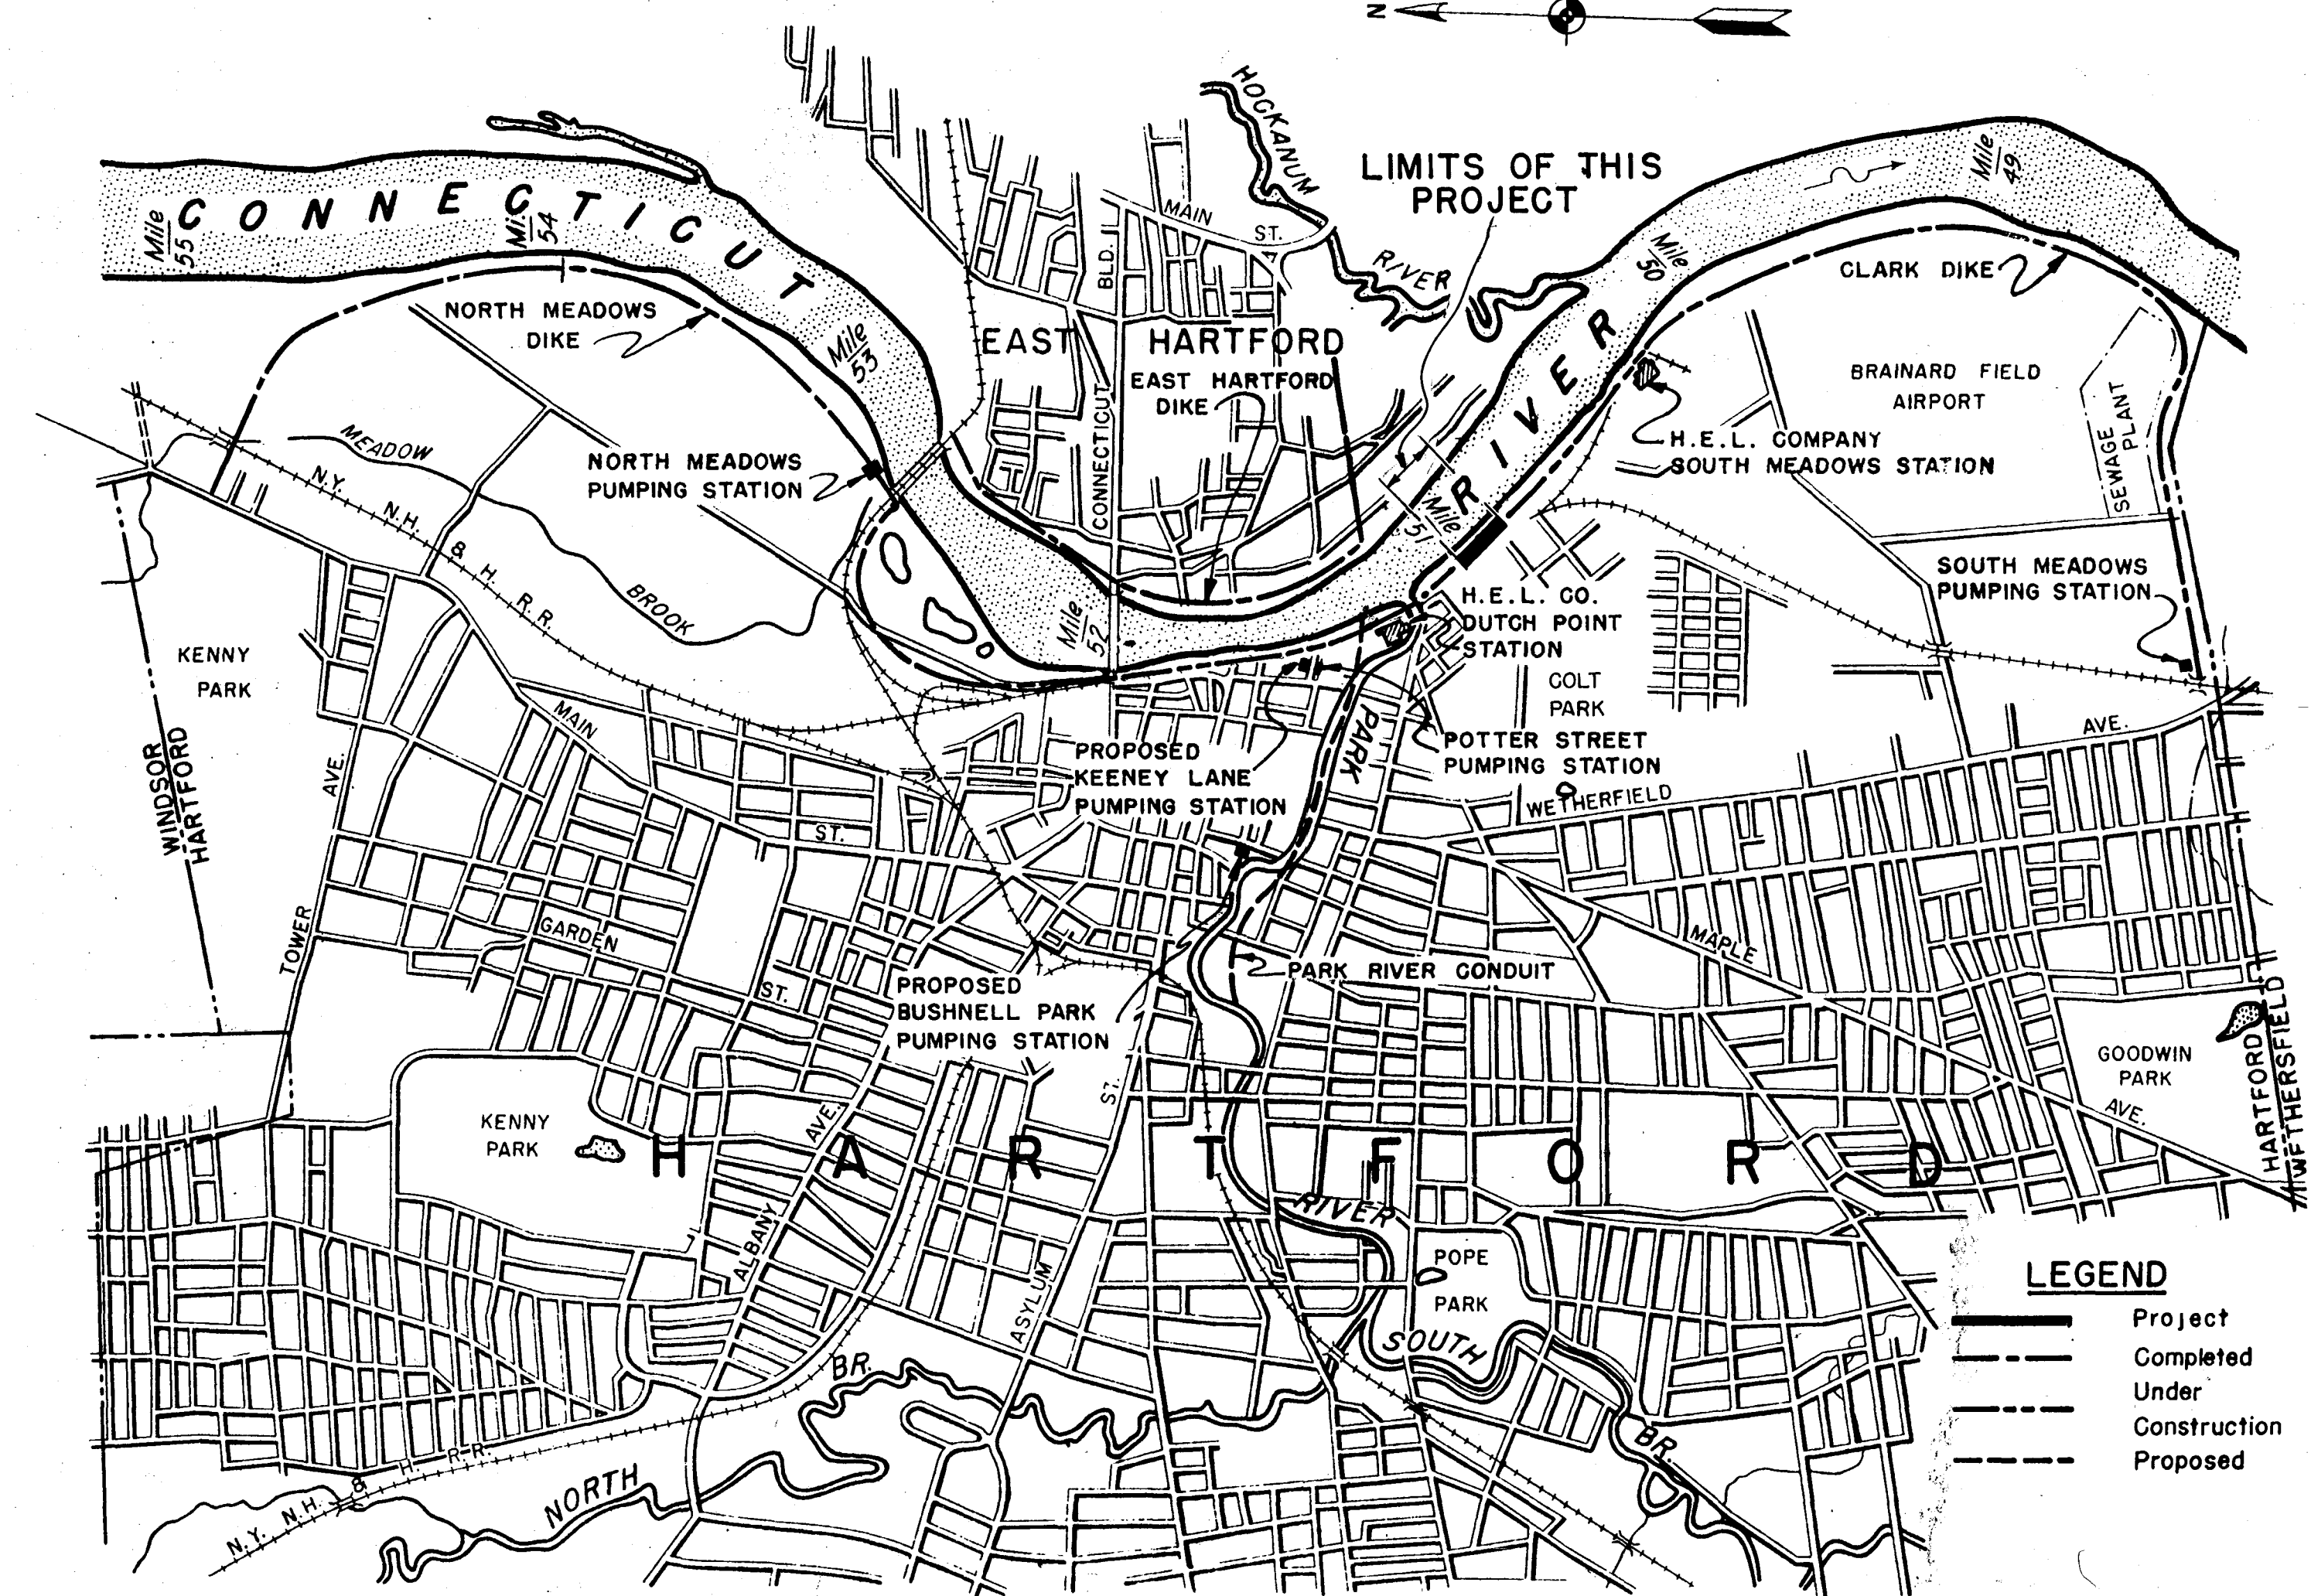

VICINITY MAP

LEGEND

—	Project
- - -	Completed
- - -	Under
- - -	Construction
- - -	Proposed

INDEX TO DRAWINGS

SHEET NO.	DESCRIPTION	FILE NO.
1	PROJECT LOCATION AND INDEX	CT-4-3124
2	GENERAL PLAN	CT-4-3125
3	SECTIONS AND DETAILS	CT-4-3126
4	GEOLOGIC SECTION	CT-2-1336

KEY	DATE	REVISION	REV BY	CK BY	AP BY
	12/31/45	As-Built			

CONNECTICUT RIVER FLOOD CONTROL
HARTFORD DIKE
RECONSTRUCTION AT SLIDE STA. 44+45.68 TO STA. 65+00
FOUNDATION DRAIN WELLS STA. 52+30± TO STA. 60+10±
(HIRED LABOR)
PROJECT LOCATION AND INDEX
CONNECTICUT RIVER
IN 4 SHEETS SCALE 1 IN. = 2000 FT. SHEET NO. 1
U.S. ENGINEER OFFICE, PROVIDENCE, R.I. JAN. 1942
SUBMITTED: 12/31/45
APPROVAL: 12/31/45
RECOMMENDED: 12/31/45
APPROVED: 12/31/45
DESIGN SECTION: 12/31/45
DRAWN: M.L.
TRACED: M.L.
CHECKED: J.W.C.
FILE NO. CT-4-3124