


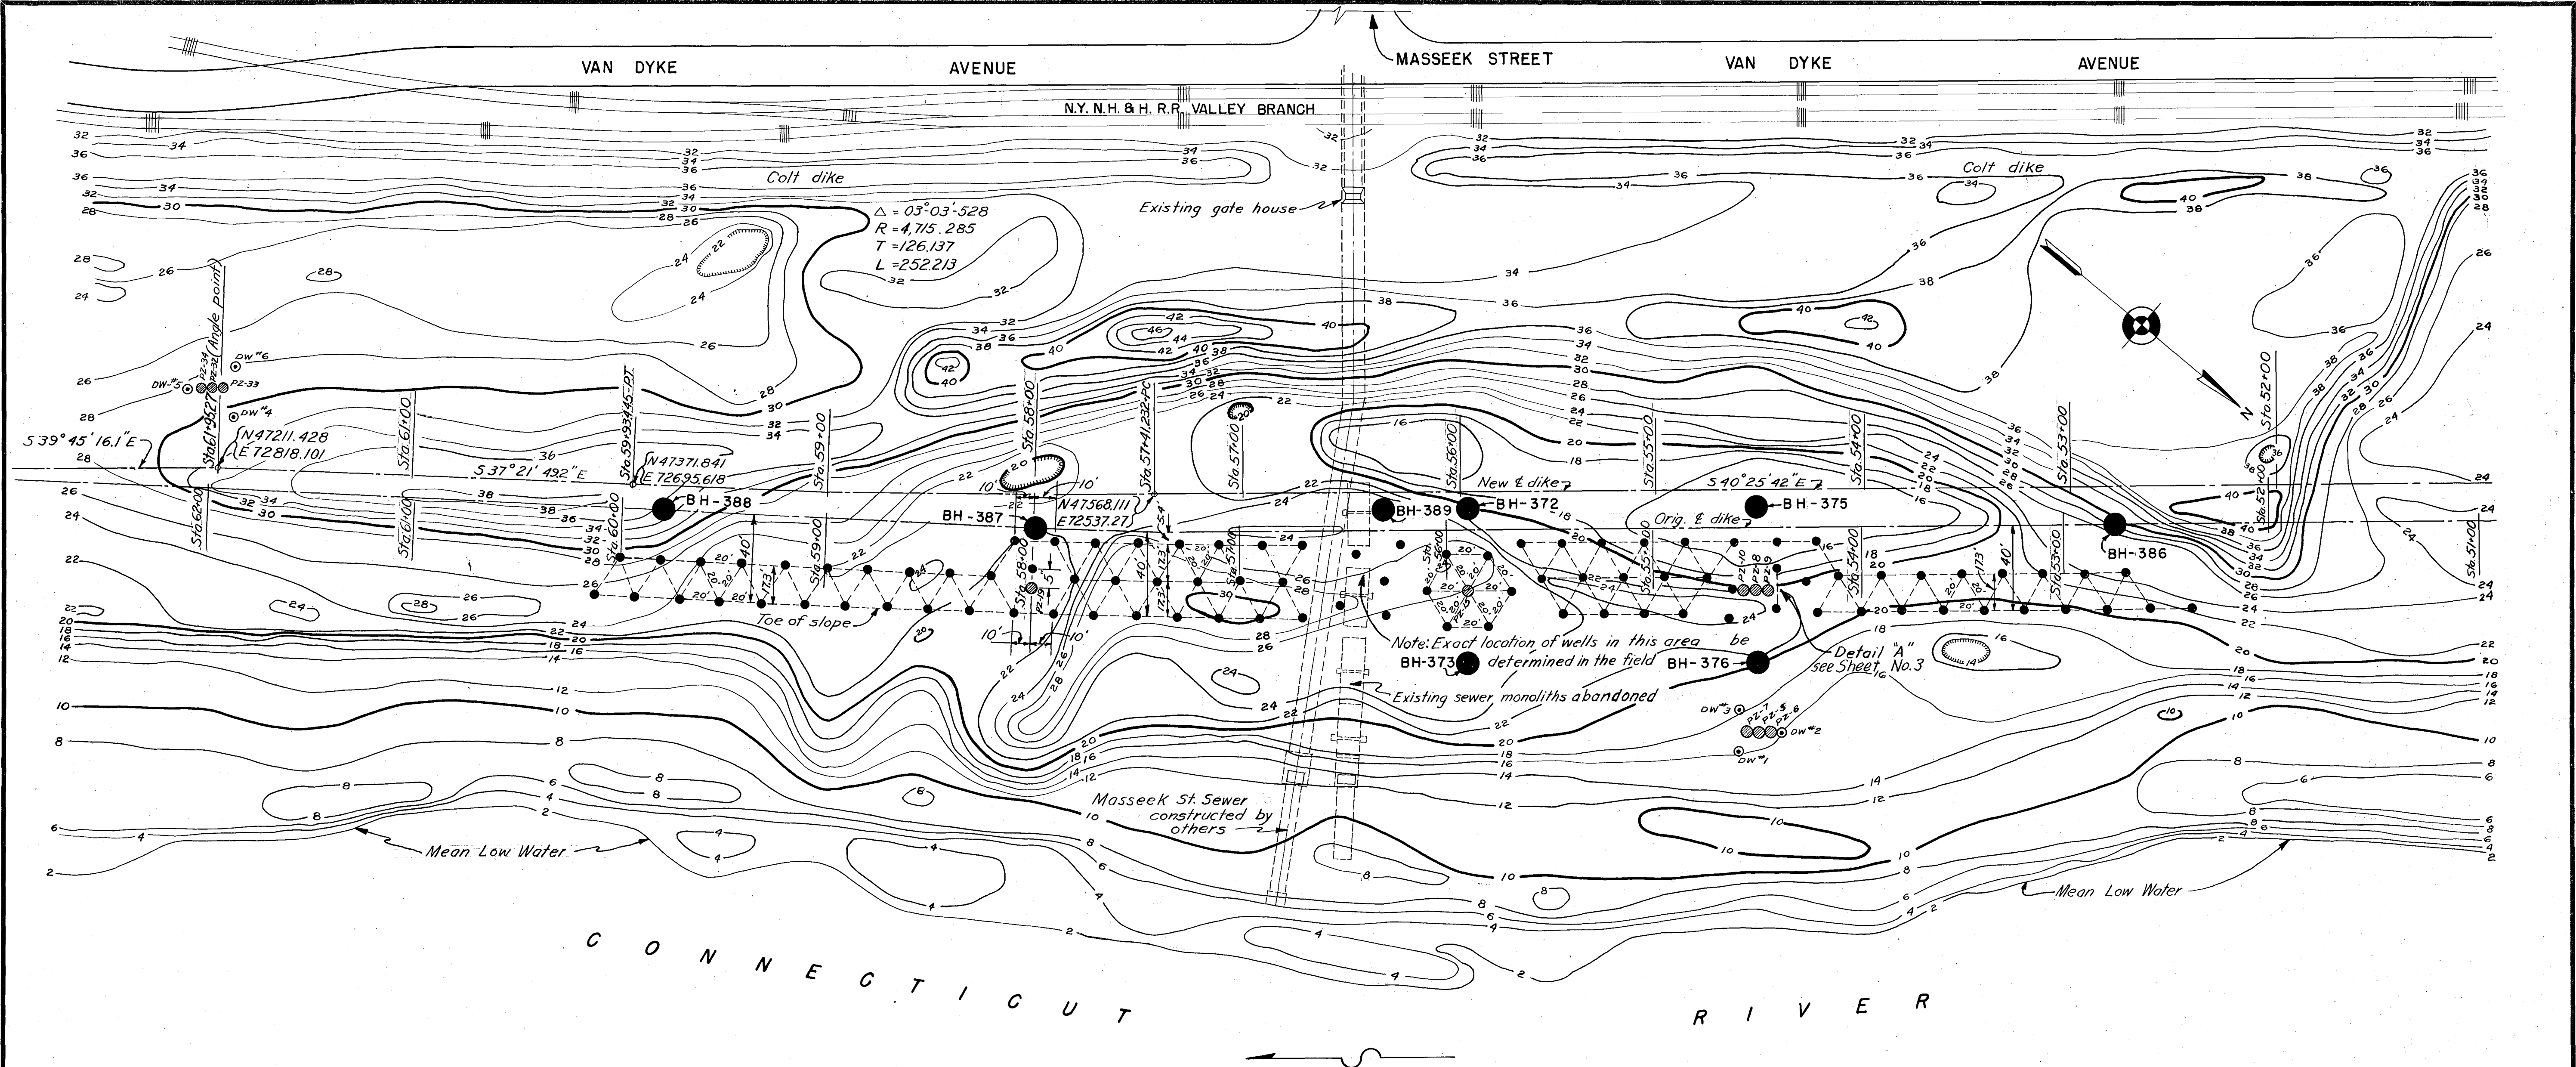

NOTES
Elevations refer to Mean Sea Level datum.
Existing piezometers to be suitably protected during operations.
All existing piezometers not shown.

- LEGEND**
- Bore holes taken after slide.
 - Foundation drain wells.
 - ⊙ Existing piezometers
 - ⊙ Existing experimental drain wells

TRACED FROM ORIGINAL SIGNED COPY ON FILE IN DISTRICT OFFICE

CONNECTICUT RIVER FLOOD CONTROL

HARTFORD DIKE
HARTFORD, CONN.

RECONSTRUCTION AT SLIDE STA. 44+45.68 TO STA. 65+00
FOUNDATION DRAIN WELLS STA. 52+30 ± TO STA. 60+10 ±
HIRED LABOR

GENERAL PLAN

CONNECTICUT RIVER CONNECTICUT

IN 4 SHEETS SCALE 1 IN. = 40 FT. SHEET NO. 2

U.S. ENGINEER OFFICE, PROVIDENCE, R.I., JAN. 1942

SUBMITTED: *John C. Dingwall* APPROVAL RECOMMENDED: *T. S. Burns* APPROVED: *H. S. Bishop*
SENIOR ENGINEER PRINCIPAL ENGINEER LT. COL., CORPS OF ENGINEERS
HEAD DESIGN SECTION CHIEF, ENGINEERING DIV. DISTRICT ENGINEER

DESIGN SECTION DRAWN: H.E.B.
E.D. Chase TRACED: F.D.M.
ASST. ENGINEER CHECKED: D.W.C.

FILE NO. CT-4-3125

KEY	DATE	REVISION (Indicated by Δ)	REV BY	CK. BY	AP. BY
	12/31/45	As-Built			