
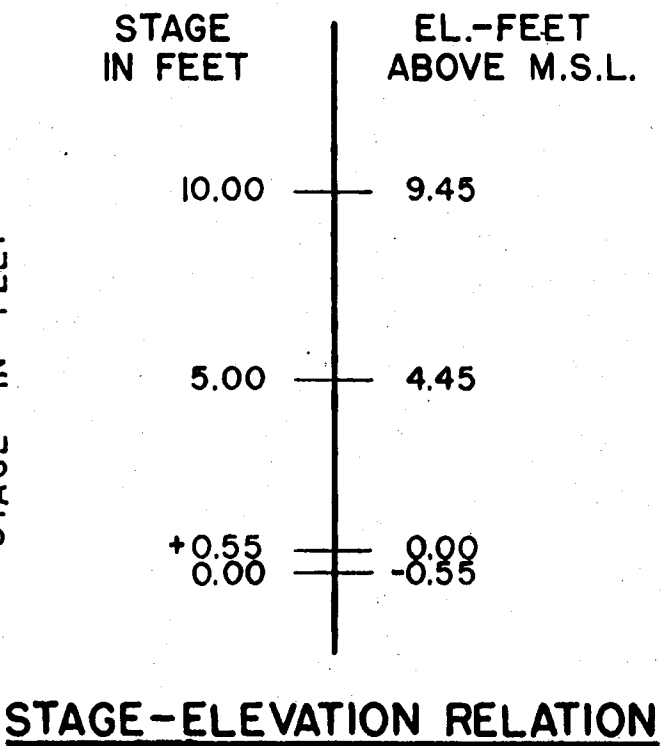


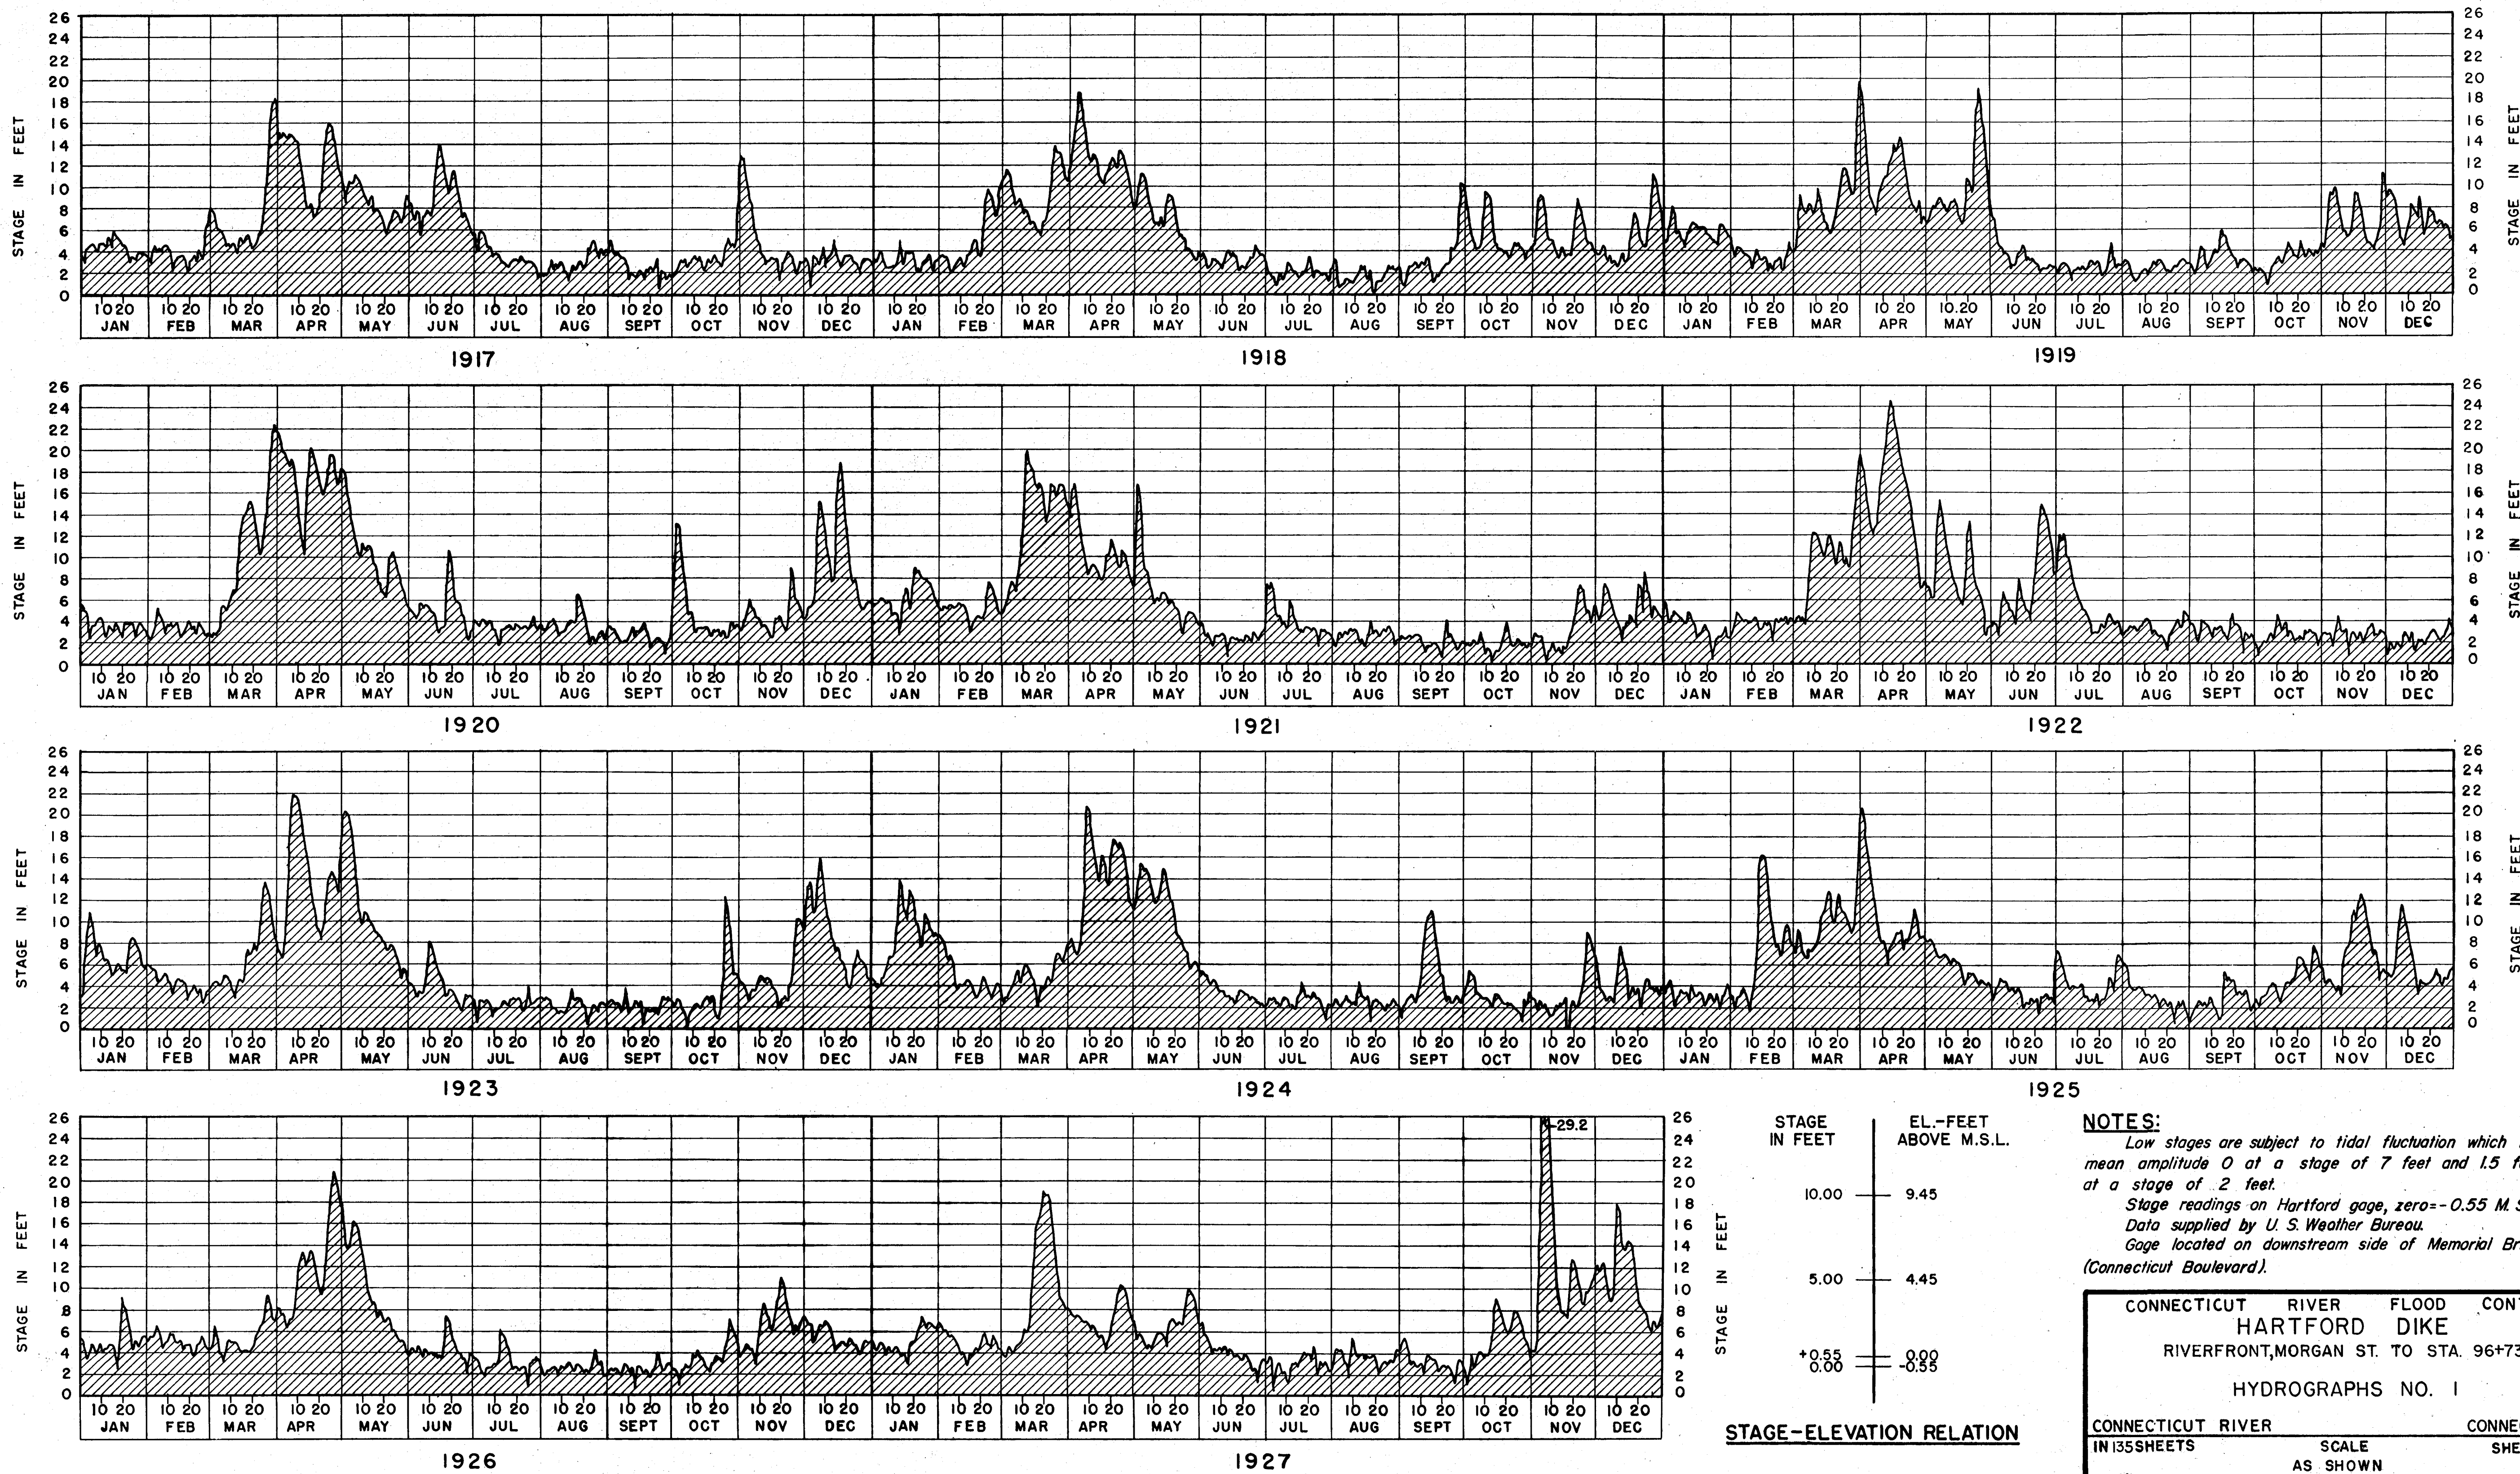

NOTES:
Low stages are subject to tidal fluctuation which has a mean amplitude 0 at a stage of 7 feet and 1.5 feet at a stage of 2 feet.
Stage readings on Hartford gage, zero = -0.55 M.S.L.
Data supplied by U. S. Weather Bureau.
Gage located on downstream side of Memorial Bridge (Connecticut Boulevard).

CONNECTICUT RIVER FLOOD CONTROL	
HARTFORD DIKE	
RIVERFRONT, MORGAN ST. TO STA. 96+73	
HYDROGRAPHS NO. 1	
CONNECTICUT RIVER IN 135 SHEETS	CONNECTICUT SHEET NO. 3
SCALE AS SHOWN	
U.S. ENGINEER OFFICE, PROVIDENCE, R.I., MAY 1940	
SUBMITTED: J. B. Nichols ENGINEER	APPROVAL RECOMMENDED: J. B. Nichols PRINCIPAL ENGINEER
HEAD, HYDRAULICS SECTION	CHIEF, F.C. ENGINEERING DIV.
COMPILED: J. B. Nichols ASSOC. ENGINEER	DRAWN BY: W.W.V. & F.C.T. TRACED BY: P.J.G. CHECKED BY: J.K.C.
FISCAL YEAR 1940	
FILE NO. CT-3-1171	

12-31-45	As Built				
DATE	REVISION	REV. BY	CK. BY	AP. BY	

File 11-14-3