
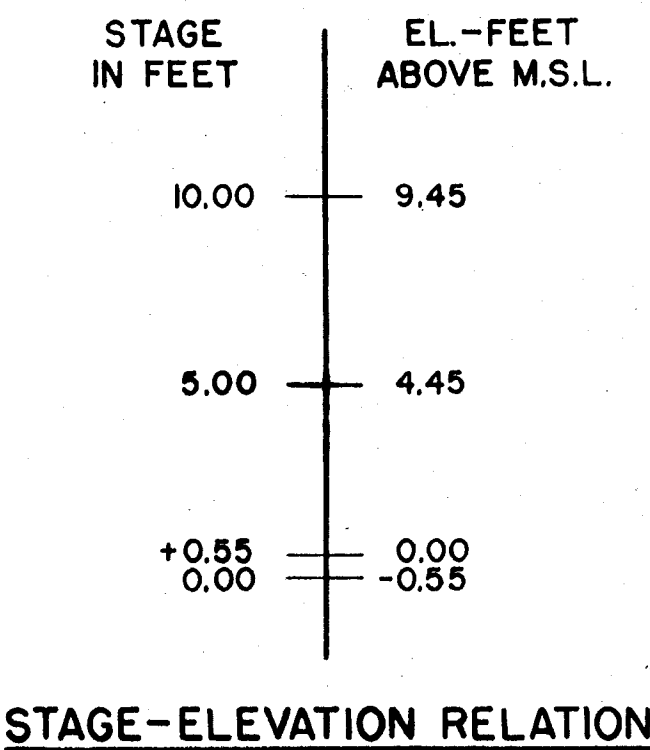


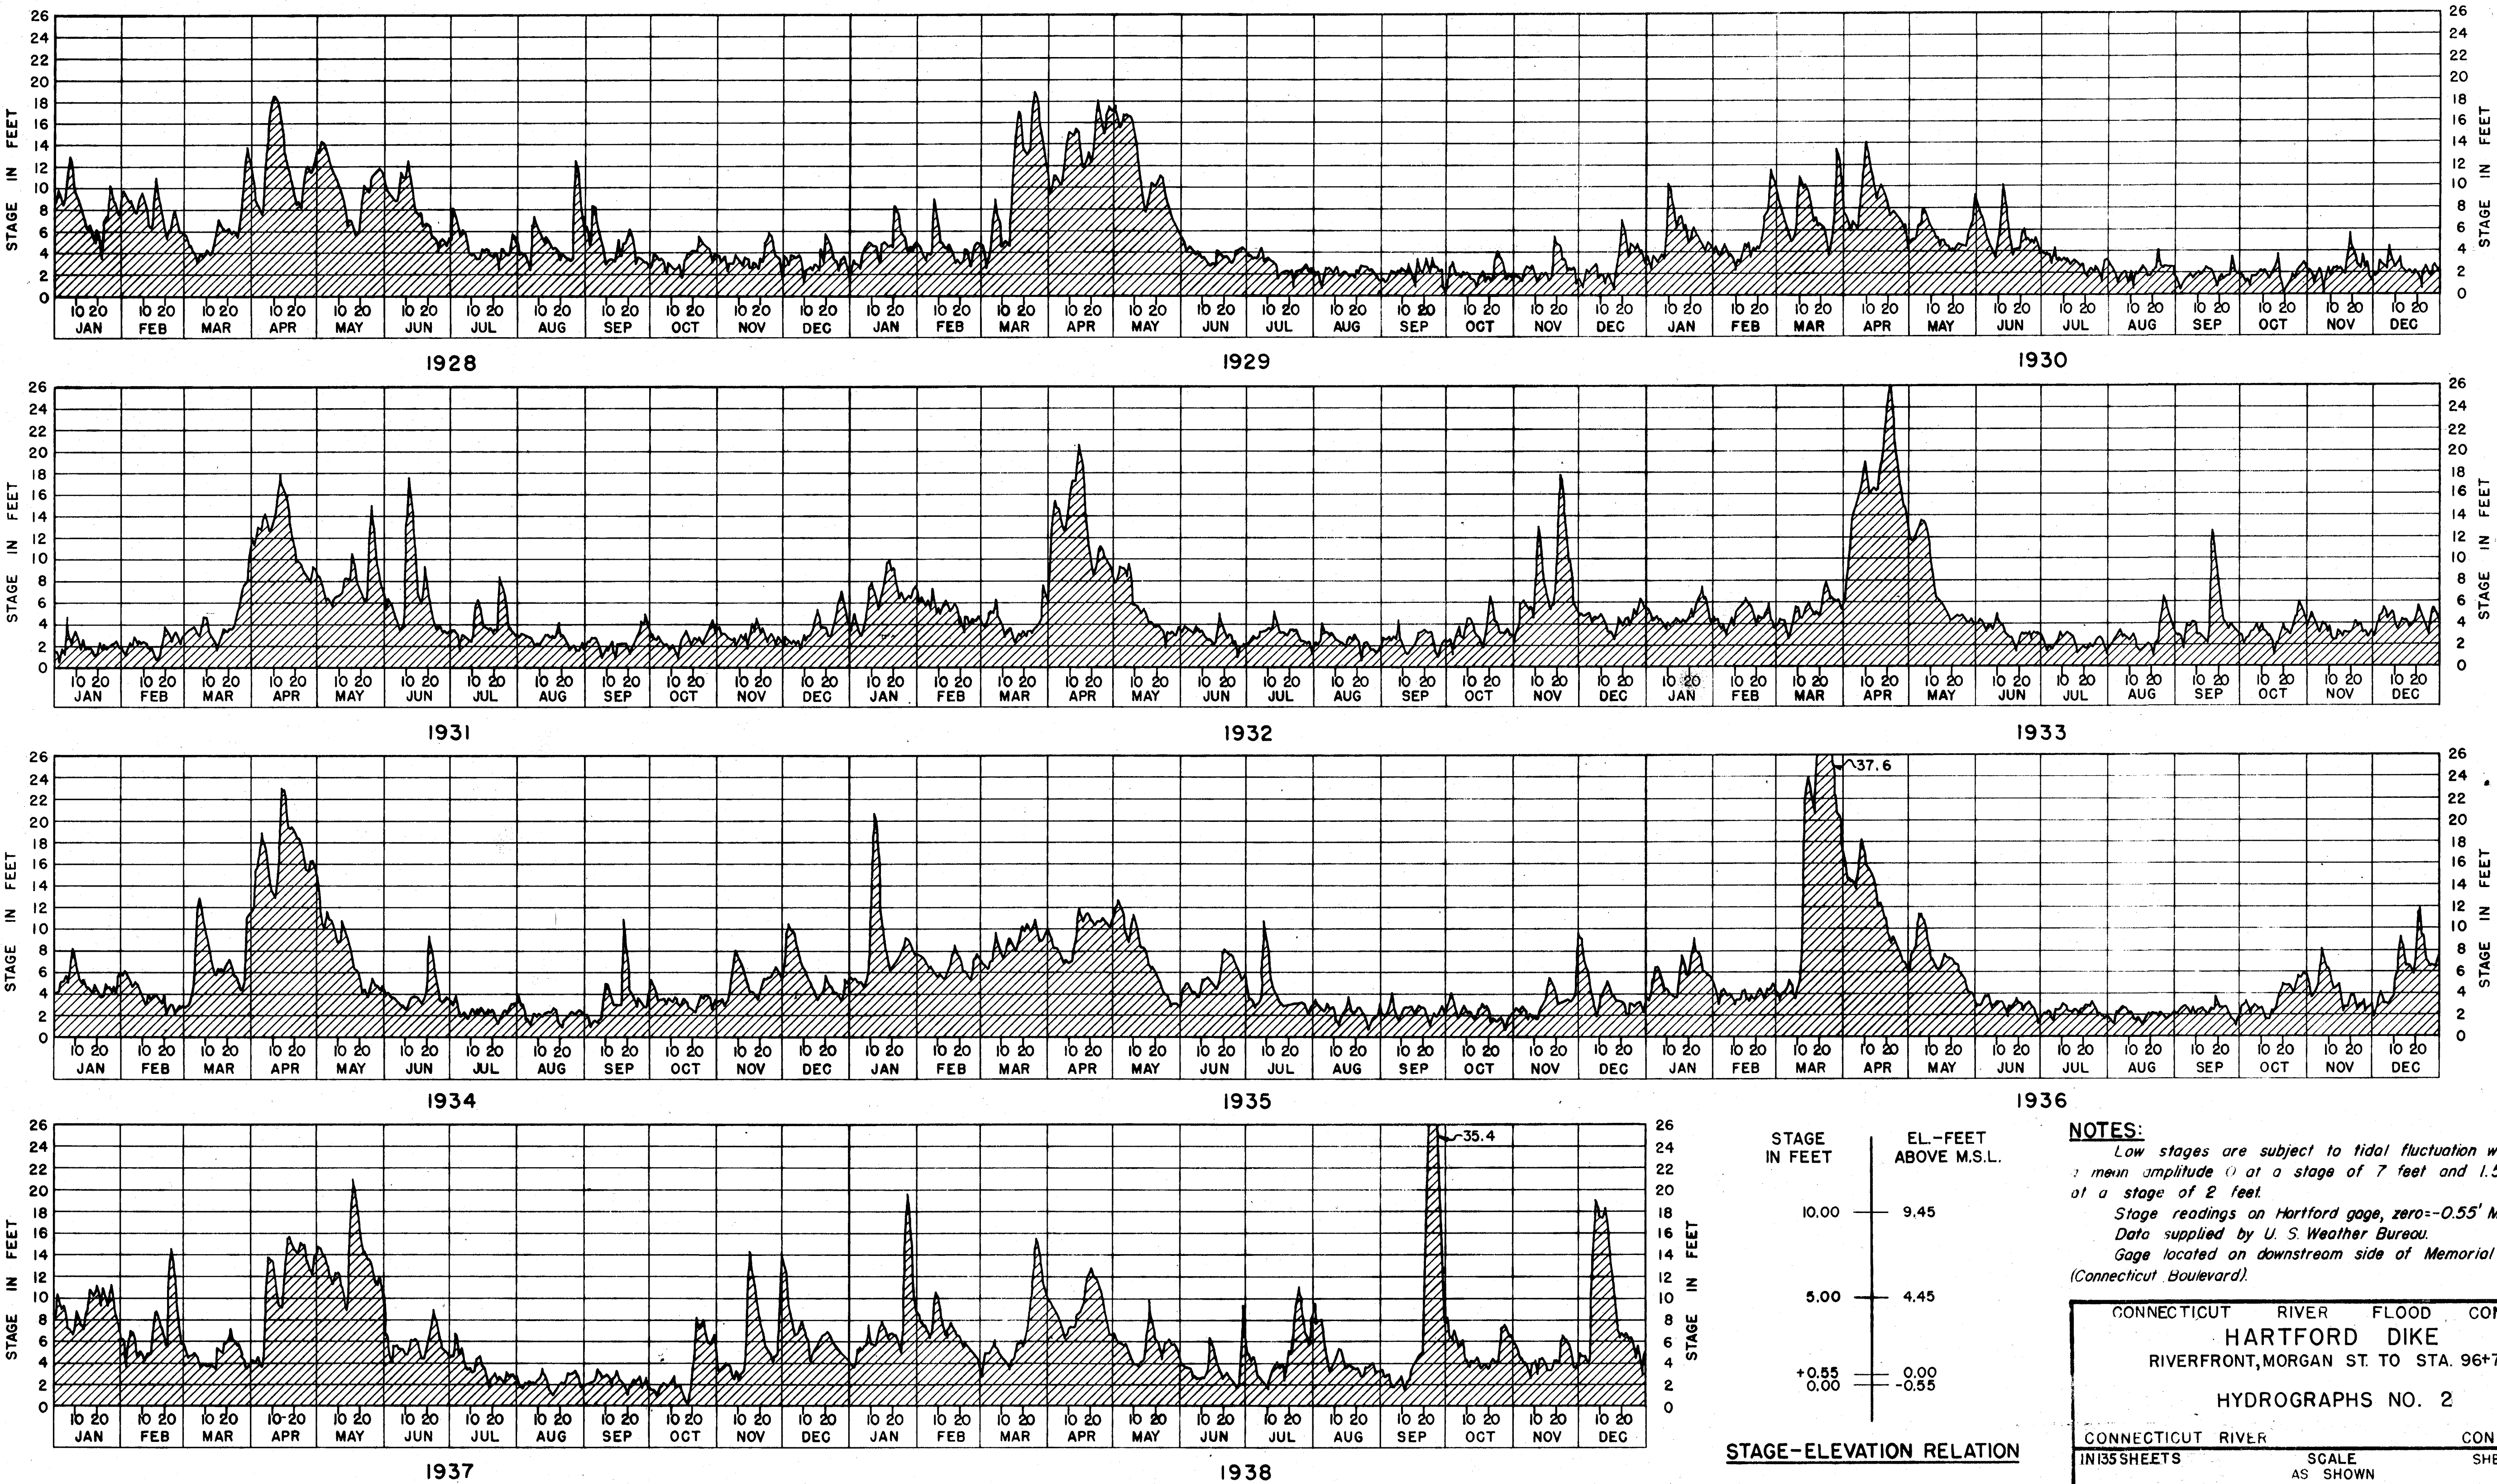

NOTES:
Low stages are subject to tidal fluctuation which has a main amplitude of 1 foot at a stage of 7 feet and 1.5 feet at a stage of 2 feet.
Stage readings on Hartford gage, zero = -0.55' M. S. L.
Data supplied by U. S. Weather Bureau.
Gage located on downstream side of Memorial Bridge (Connecticut Boulevard).

CONNECTICUT RIVER FLOOD CONTROL			
HARTFORD DIKE			
RIVERFRONT, MORGAN ST. TO STA. 96+73			
HYDROGRAPHS NO. 2			
CONNECTICUT RIVER		CONNECTICUT	
IN 135 SHEETS		SHEET NO. 4	
U. S. ENGINEER OFFICE, PROVIDENCE, R. I., MAY 1940			
SUBMITTED: <i>John B. Drish</i>		APPROVED: <i>W. W. M.</i>	
BY: <i>John B. Drish</i>		BY: <i>W. W. M.</i>	
CHIEF, HYDRAULICS SECTION		DISTRICT ENGINEER	
COMPILED: <i>John B. Drish</i>		FISCAL YEAR 1940	
DATE: 12-31-45		FILE NO. CT-3-1172	

12-31-45	As Built				
DATE	REVISION	REV. BY	CK. BY	AP. BY	