
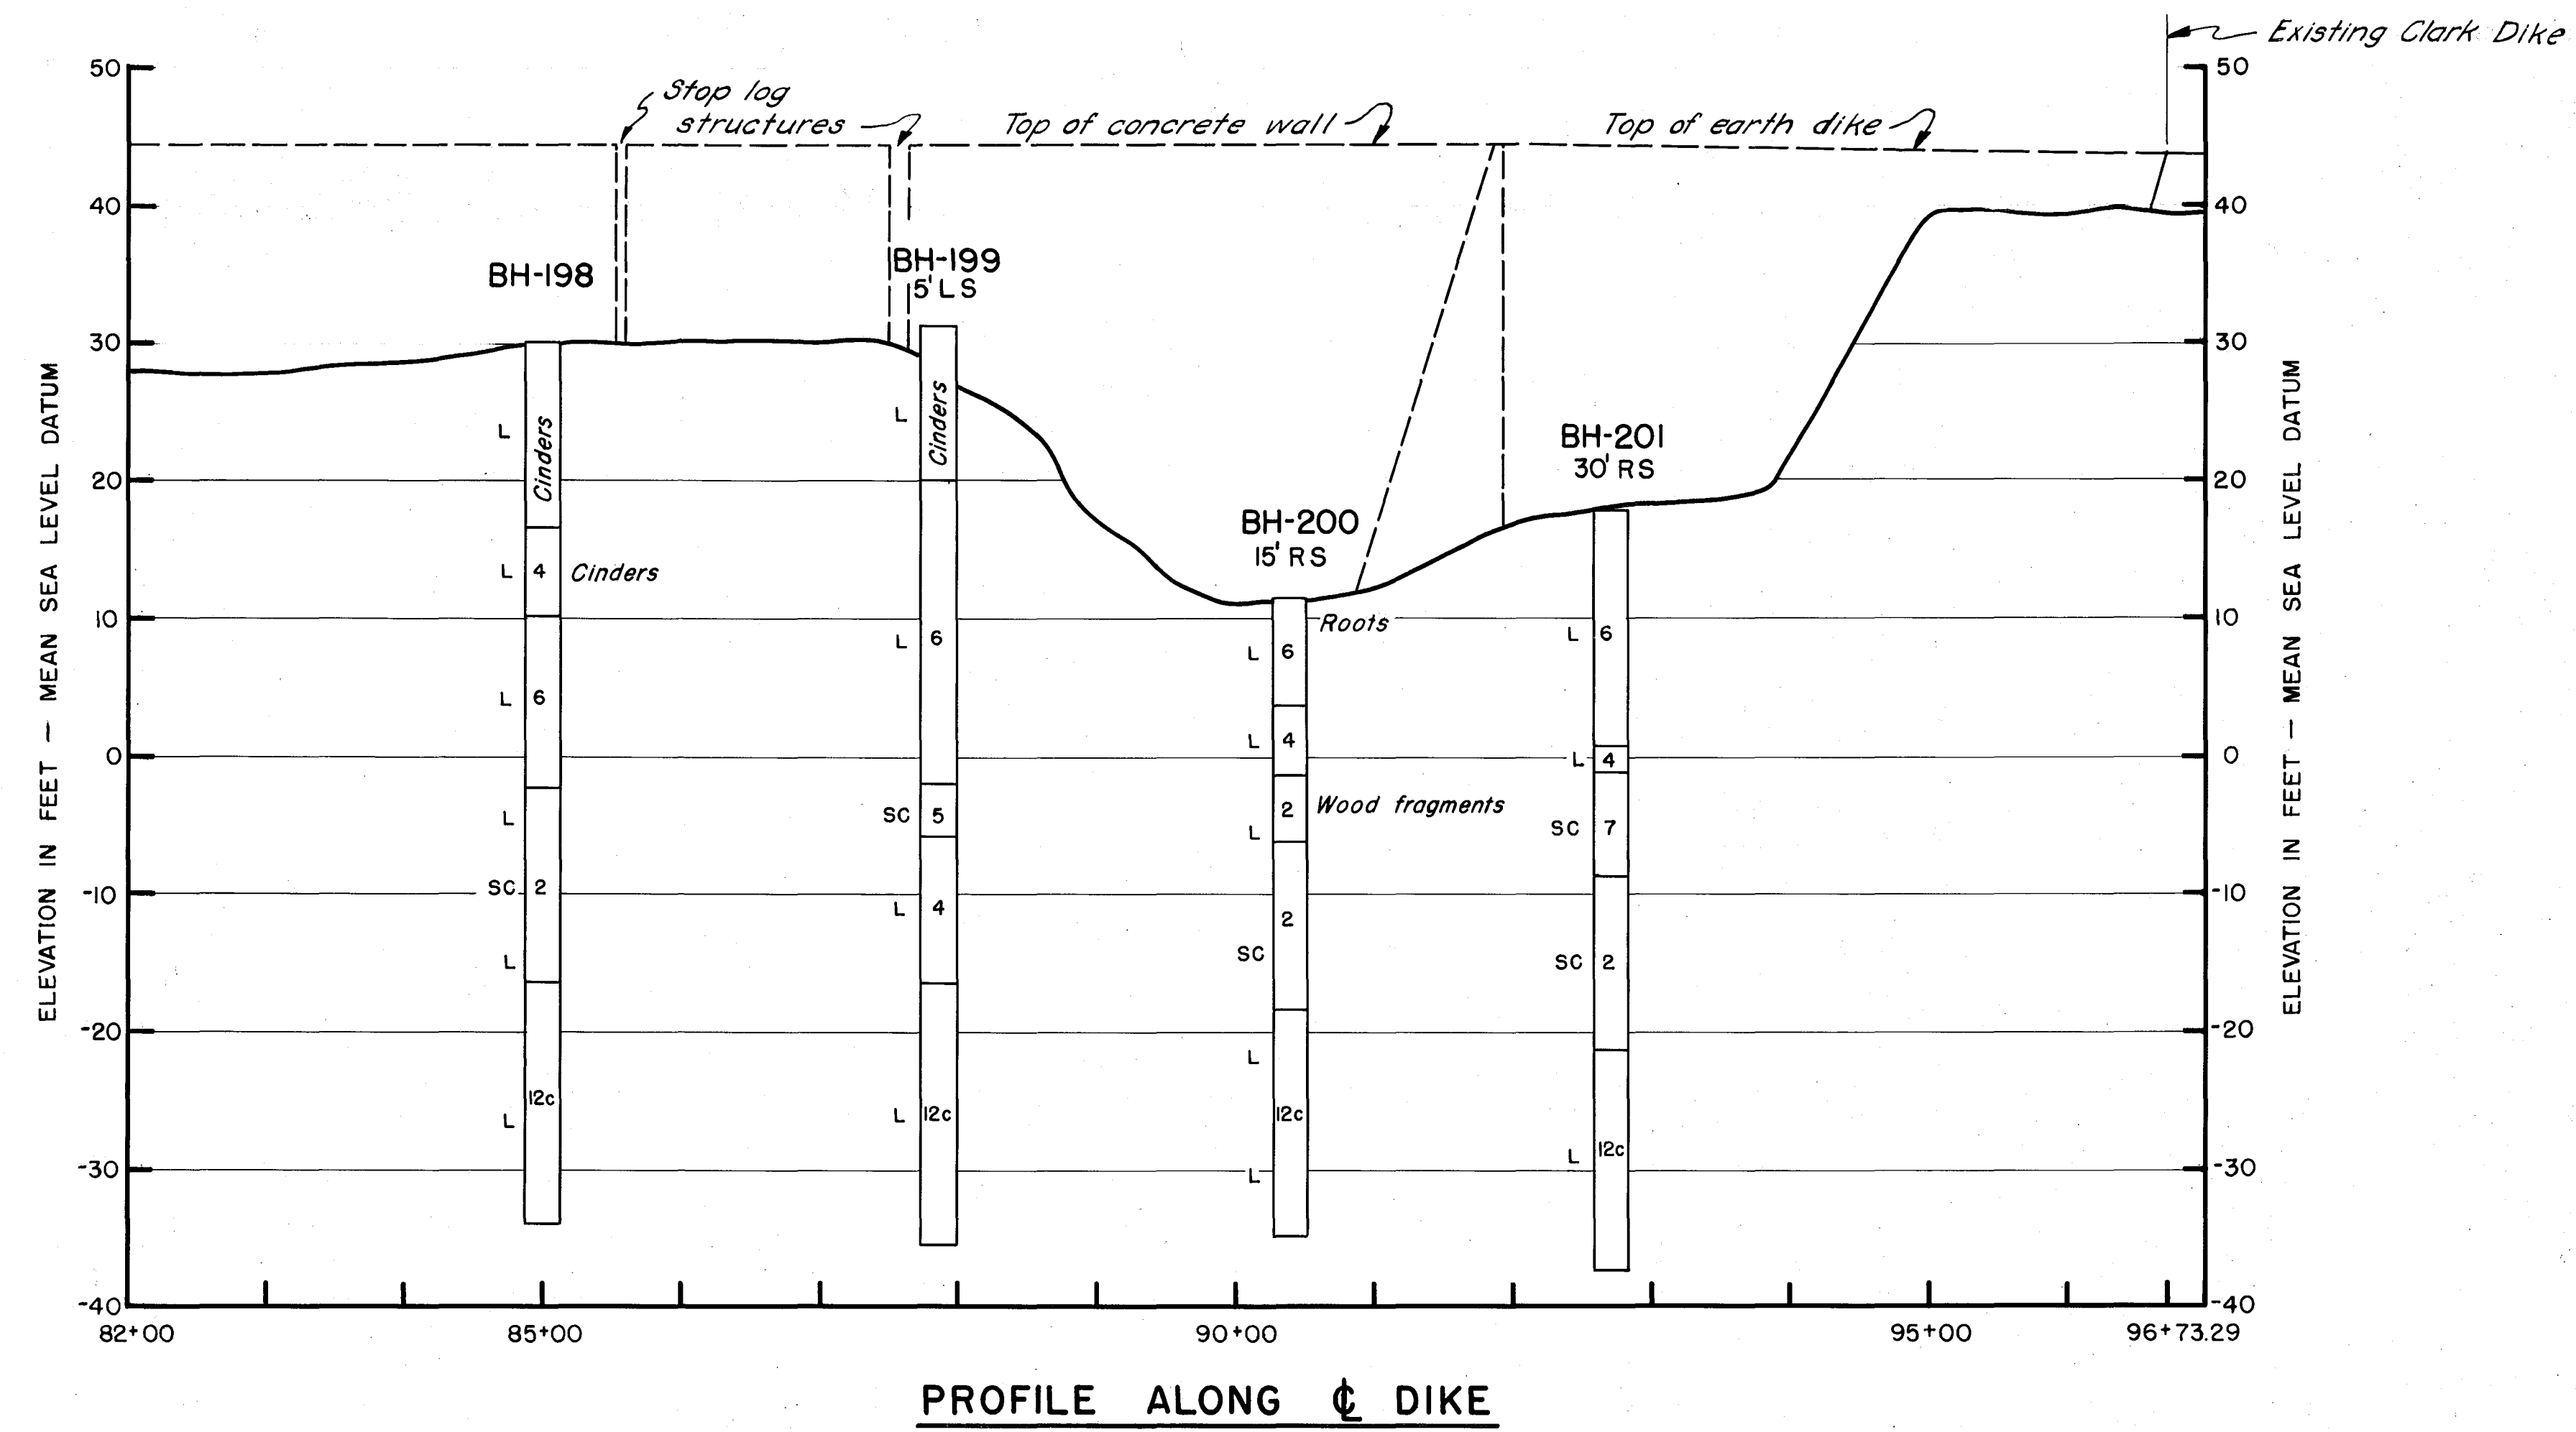


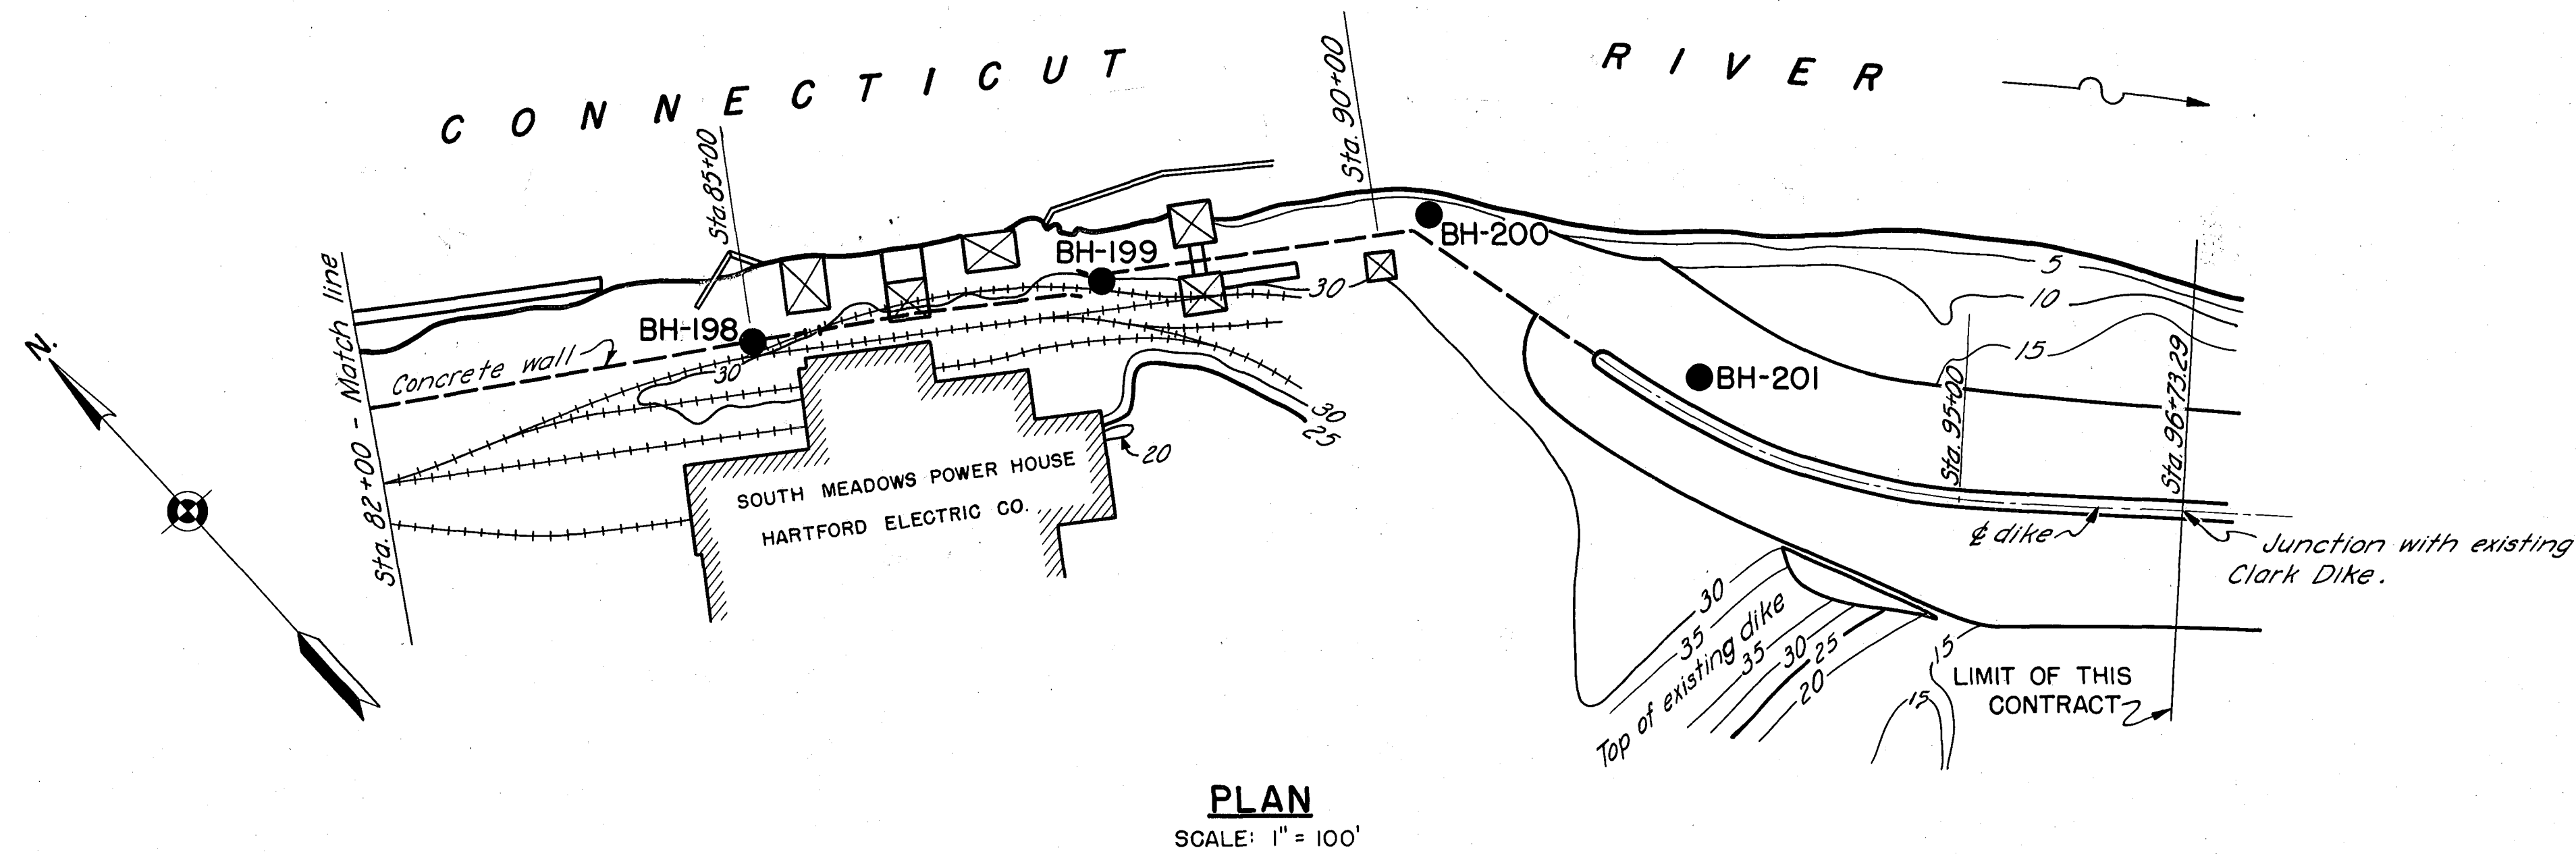

NOTE
For legend, general notes, and description of soil classes see Sheet No. 7.

CONNECTICUT RIVER FLOOD CONTROL			
HARTFORD DIKE			
RIVERFRONT, MORGAN ST. TO STA. 96+73			
SUBSURFACE EXPLORATIONS NO. 5			
CONNECTICUT RIVER		CONNECTICUT	
IN 135 SHEETS		SHEET NO. 9	
SCALE: 1 IN. = 100 FT.		100' 0 100' 200'	
U.S. ENGINEER OFFICE, PROVIDENCE, R.I., MAY 1940			
SUBMITTED: <i>Frank J. Jellison</i>		APPROVAL RECOMMENDED: <i>W. B. Burns</i>	
HEAD, GEOLOGY SECTION		PRINCIPAL ENGINEER	
COMPILED: <i>W. A. Magill</i>		DRAWN: R. R. L.	
ASST. ENGINEER		TRACED: L. V. P.	
		FISCAL YEAR 1940	
		FILE NO. CT-2-1278	

KEY	DATE	REVISION (Indicated by Δ)	REV. BY	CK. BY	AP. BY
	12-31-45	As Built			