


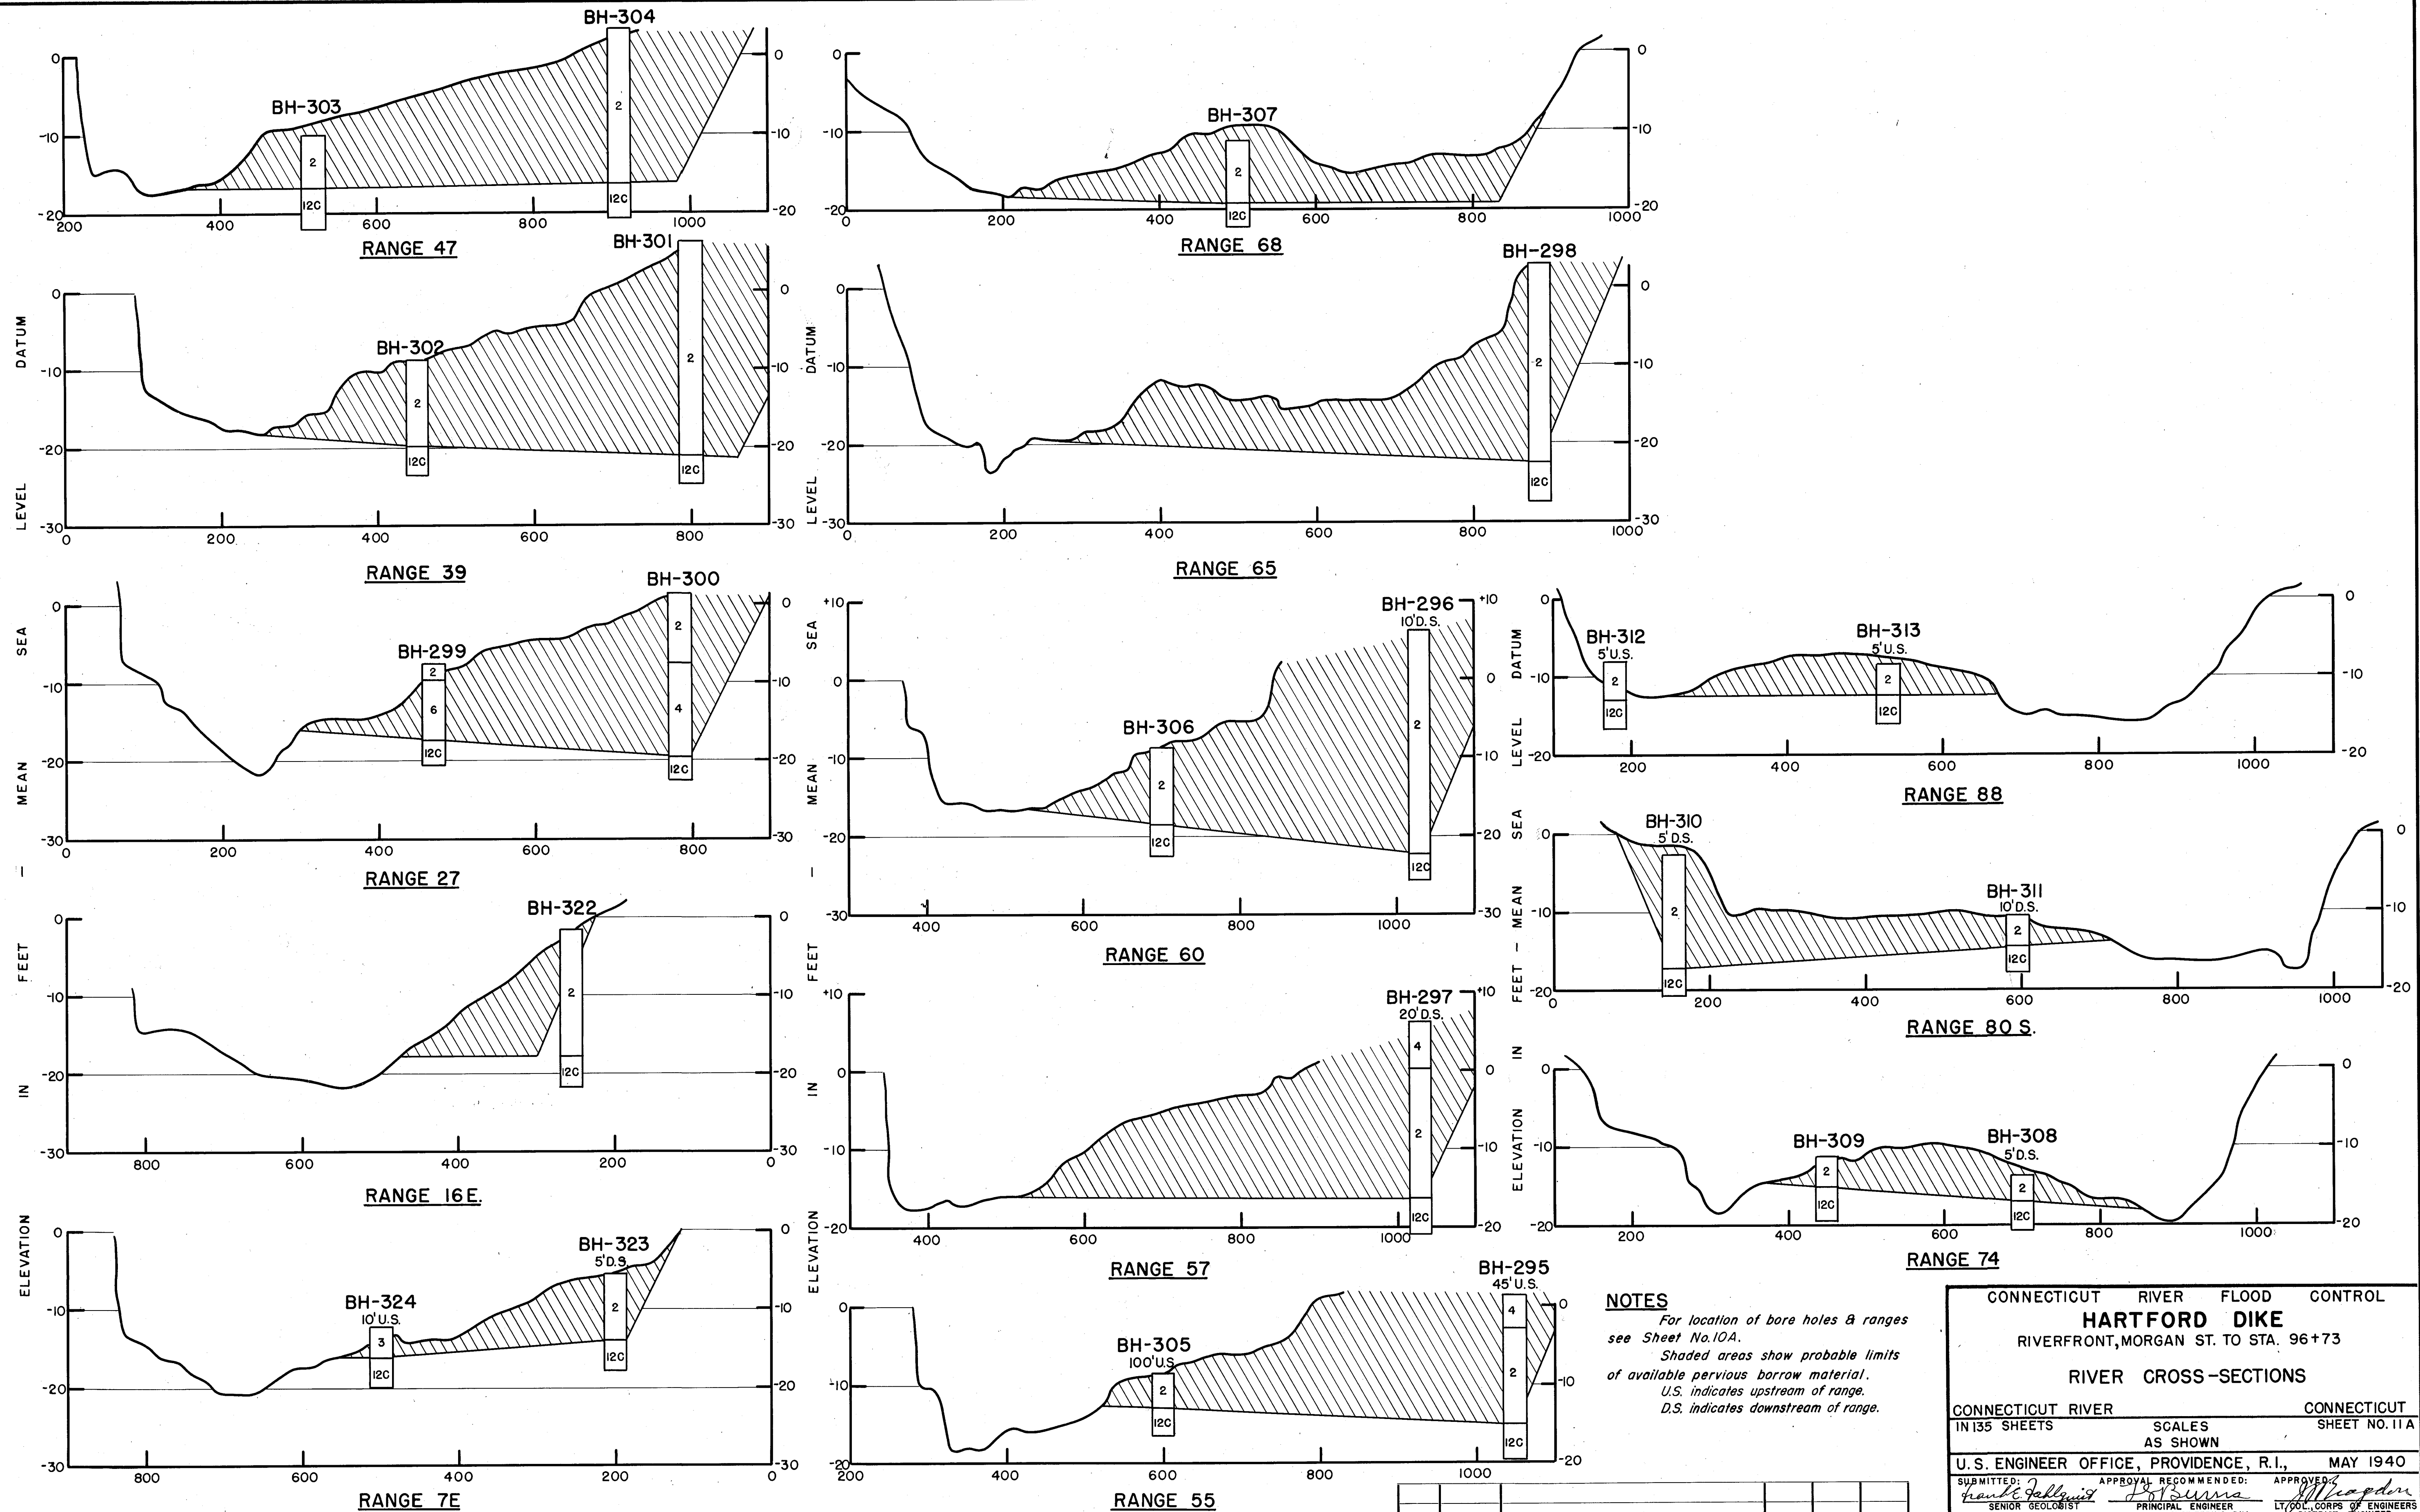

CROSS-SECTIONS IN RIVER - LOOKING UPSTREAM

NOTES

For location of bore holes & ranges see Sheet No. 10A.
Shaded areas show probable limits of available pervious borrow material.
U.S. indicates upstream of range.
D.S. indicates downstream of range.

KEY	DATE	REVISION (Indicated by Δ)	REV. BY	CK. BY	AP. BY
	12-31-45	As Built			

CONNECTICUT RIVER FLOOD CONTROL			
HARTFORD DIKE			
RIVERFRONT, MORGAN ST. TO STA. 96+73			
RIVER CROSS-SECTIONS			
CONNECTICUT RIVER	CONNECTICUT		
IN 135 SHEETS	SCALES AS SHOWN	SHEET NO. 11A	
U.S. ENGINEER OFFICE, PROVIDENCE, R.I., MAY 1940			
SUBMITTED: Frank J. Quinn	APPROVAL RECOMMENDED: J. J. Quinn	APPROVED: J. J. Quinn	
SENIOR GEOLOGIST	PRINCIPAL ENGINEER	DISTRICT ENGINEER	
HEAD, GEOLOGY SECTION	CHIEF, E.G. ENGINEERING DIV.		
COMPILED: J. J. Quinn	DRAWN: F. J. Quinn	FISCAL YEAR 1940	
ASST. ENGINEER	CHECKED: J. J. Quinn	FILE NO. CT-2-1298	

File 11-14-3