



RECORD OF BORE HOLES IN BORROW AREA H

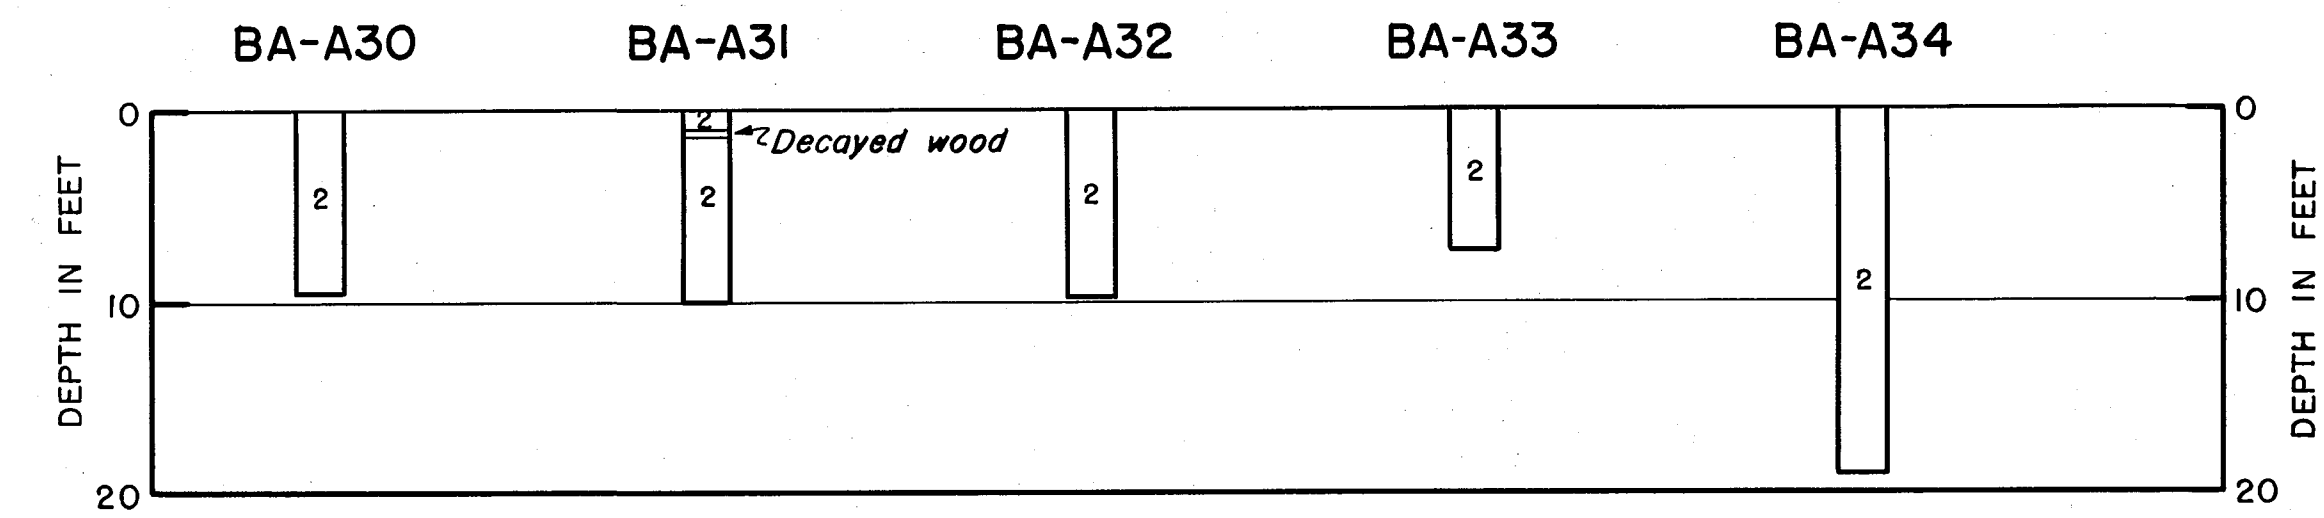

RECORD OF AUGER BORINGS IN BORROW AREA A4

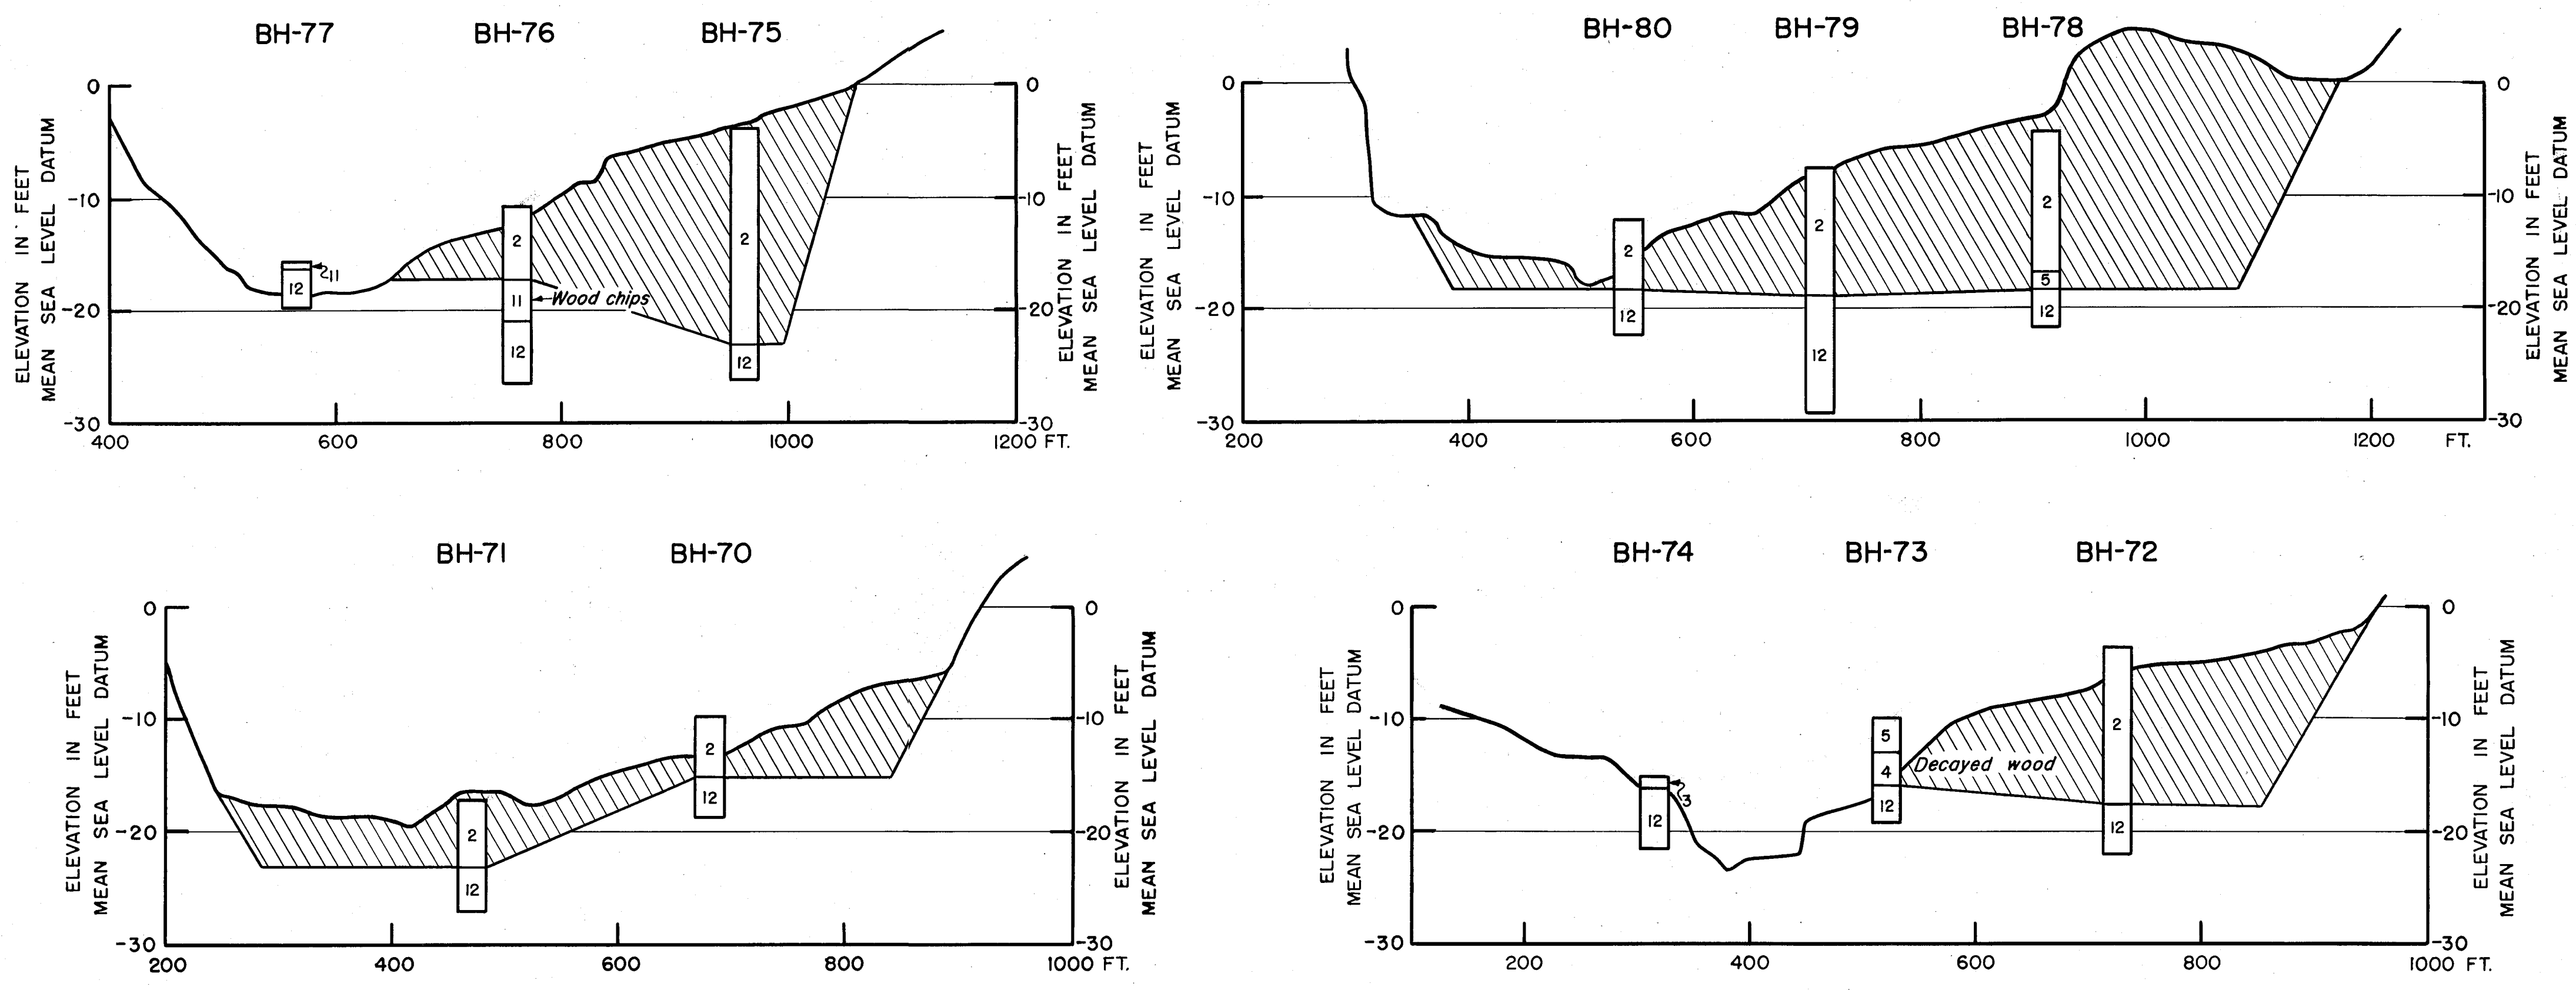

CROSS-SECTIONS IN RIVER-LOOKING UPSTREAM

NOTES
For general notes, legend, and description of soil classes see Sheet No. 7.
For locations of explorations see Sheet No. 10.
Shaded areas show limits of suitable borrow.
Elevations refer to Mean Sea Level Datum.
For additional cross-sections in the river, see Sheet No. 11A.

CONNECTICUT RIVER FLOOD CONTROL			
HARTFORD DIKE			
RIVERFRONT, MORGAN ST. TO STA. 96+73			
RECORD OF BORROW EXPLORATIONS			
CONNECTICUT RIVER		CONNECTICUT	
IN 135 SHEETS		SHEET NO. 11	
U.S. ENGINEER OFFICE, PROVIDENCE, R.I., MAY 1940			
SUBMITTED: <i>Frank J. Talbot</i>		APPROVAL RECOMMENDED: <i>W. B. Burns</i>	
SENIOR GEOLOGIST		PRINCIPAL ENGINEER	
HEAD, GEOLOGY SECTION		CHIEF, F.C. ENGINEERING DIV.	
COMPILED: <i>Wm. A. Hodge</i>		DRAWN: J. NCL - P.H.S.	
ASS'T. ENGINEER		CHECKED: <i>W. B. Burns</i>	
FISCAL YEAR 1940		FILE NO. CT-2-1280	

KEY	DATE	REVISION (Indicated by Δ)	REV. BY	CK. BY	AP. BY
	12-31-45	As Built			

File 11-14-3