


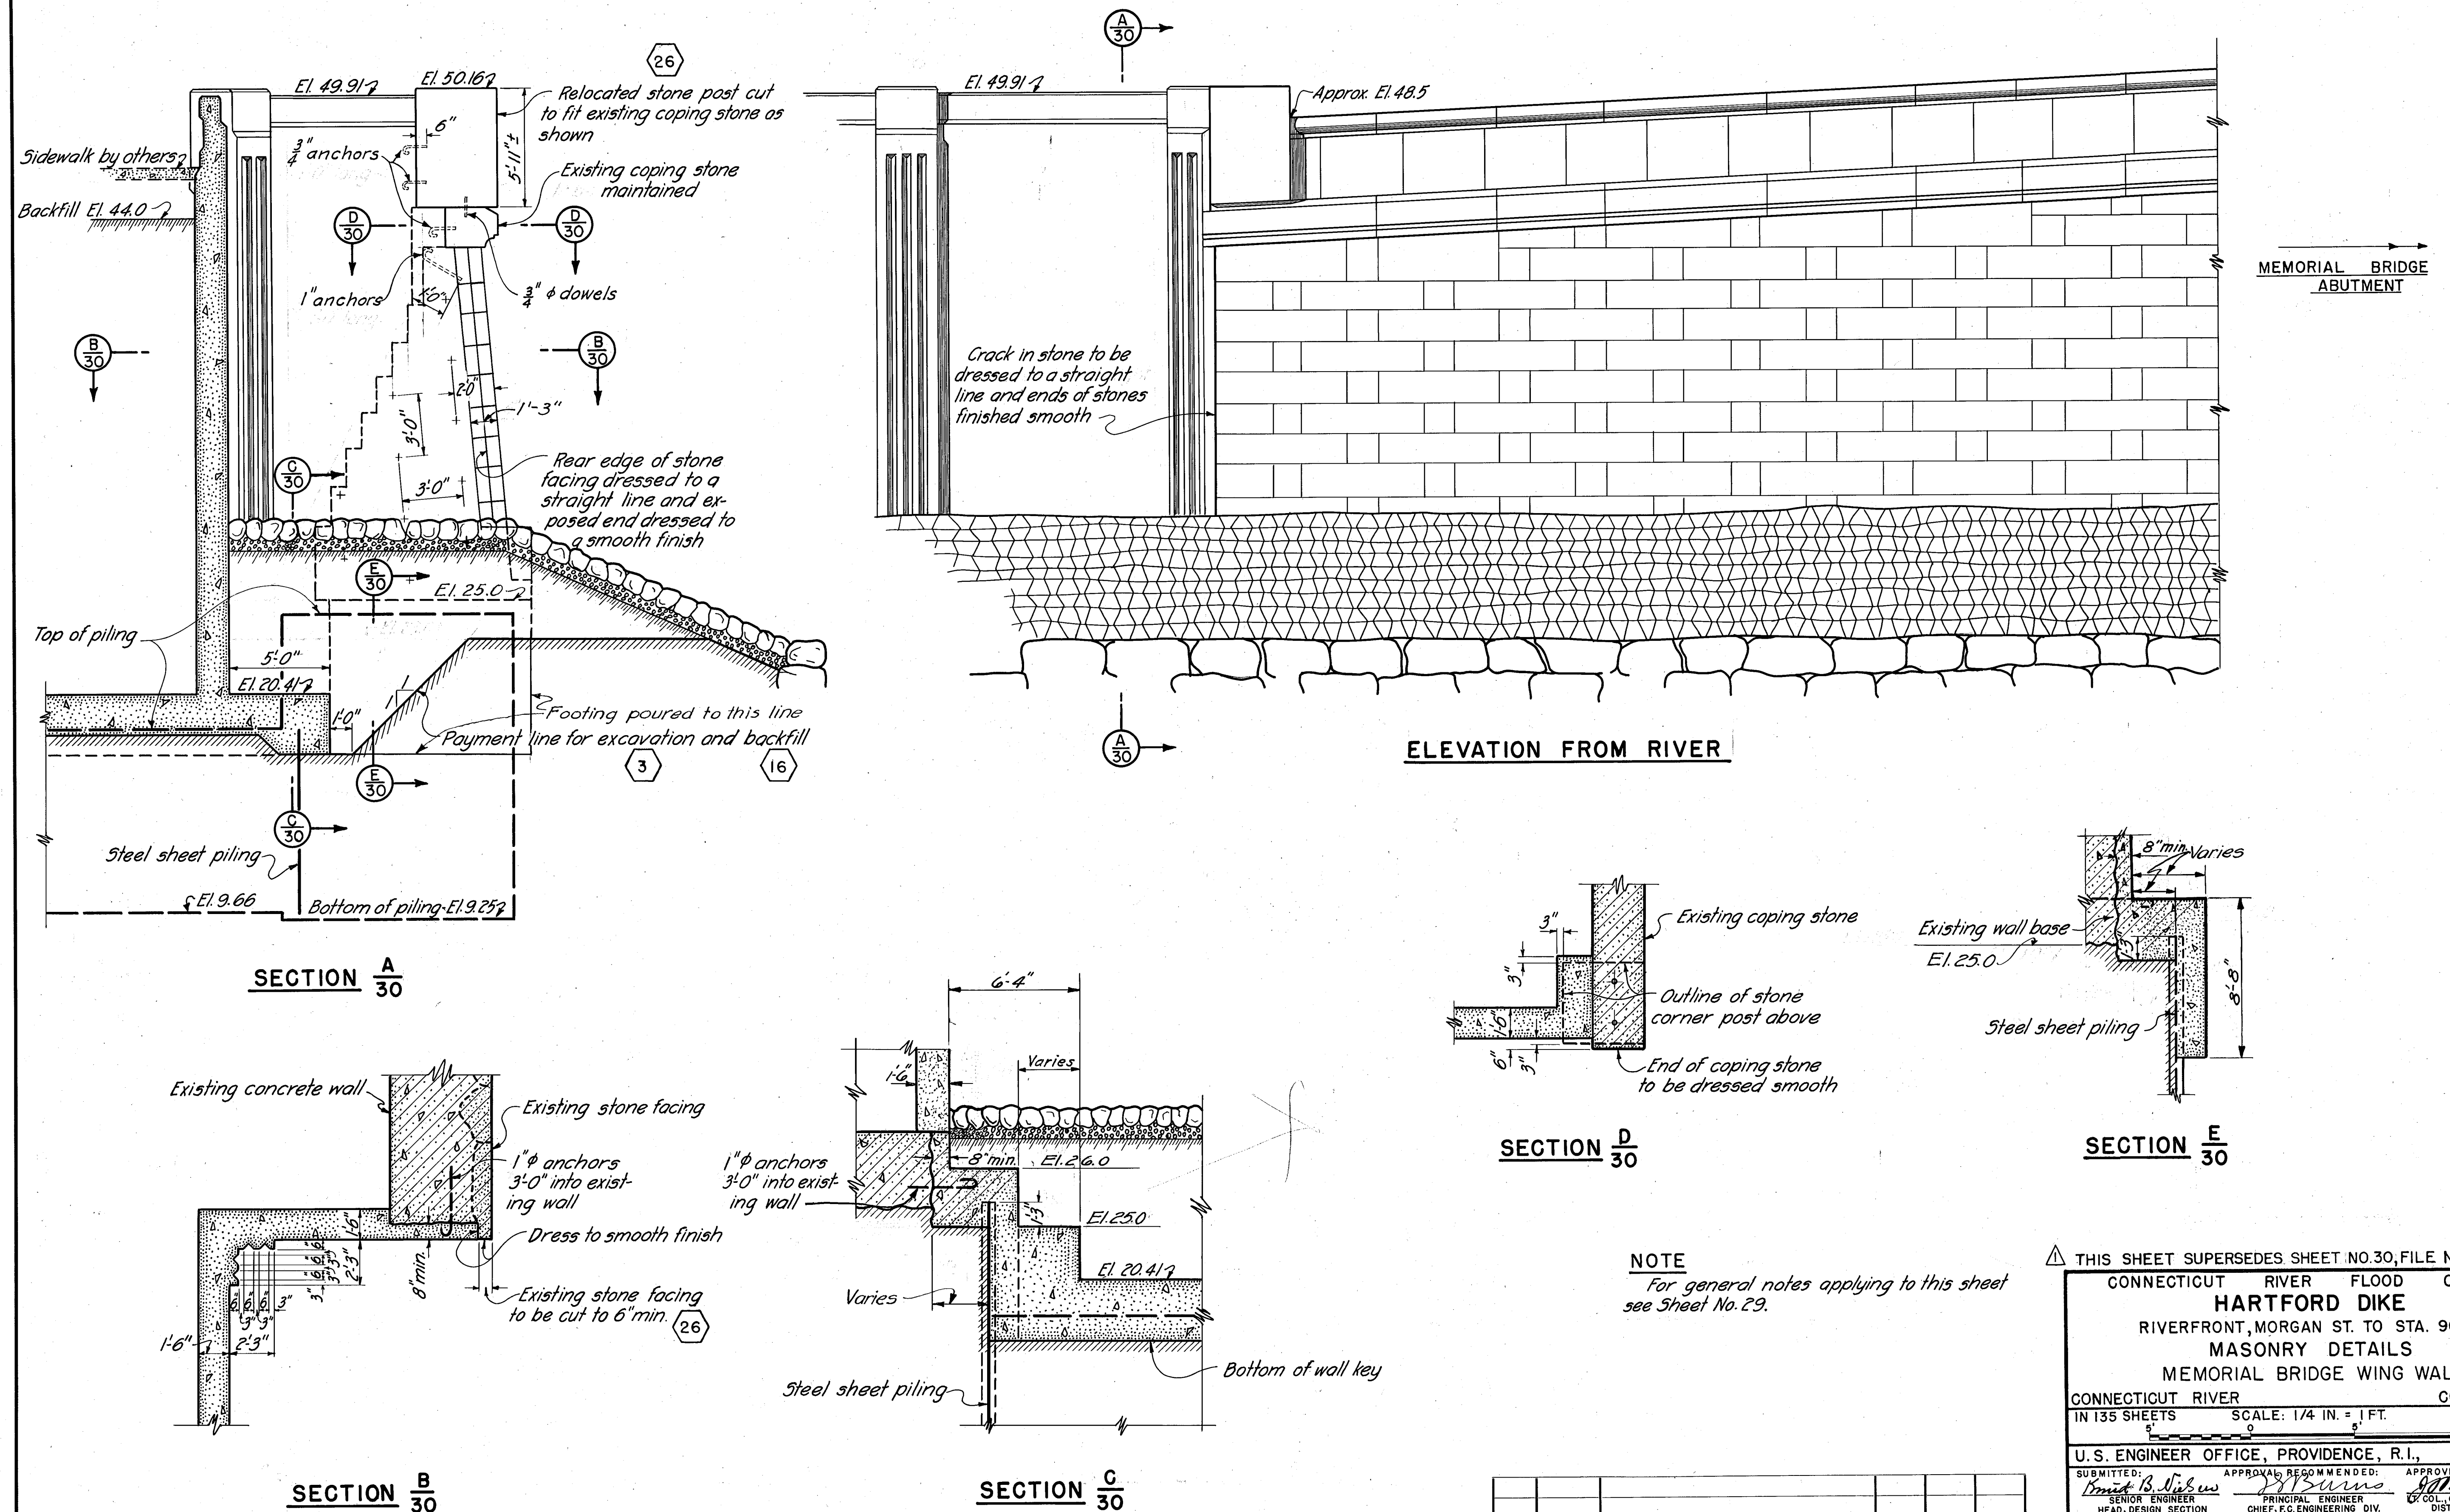

THIS SHEET SUPERSEDES SHEET NO. 30, FILE NO. CT-4-2490

CONNECTICUT RIVER FLOOD CONTROL

HARTFORD DIKE

RIVERFRONT, MORGAN ST. TO STA. 96+73

MASONRY DETAILS

MEMORIAL BRIDGE WING WALL

CONNECTICUT RIVER CONNECTICUT
IN 135 SHEETS SCALE: 1/4 IN. = 1 FT. SHEET NO. 30

U. S. ENGINEER OFFICE, PROVIDENCE, R. I., AUG. 1940

SUBMITTED: *W. B. Nisewander* APPROVAL, RECOMMENDED: *W. B. Nisewander* APPROVED: *W. B. Nisewander*
SENIOR ENGINEER PRINCIPAL ENGINEER COL. CORPS OF ENGINEERS
HEAD, DESIGN SECTION CHIEF, F.C. ENGINEERING DIV. DISTRICT ENGINEER
DESIGNED: *W. B. Nisewander* DRAWN: M. B. M. E. FISCAL YEAR 1940
ASSOC. ENGINEER TRACED: L. A. O. CHECKED: G. B. C. FILE NO. CT-4-2669

KEY	DATE	REVISION (Indicated by Δ)	REV. BY	CK. BY	AP. BY
	12-31-45	As built revisions			