
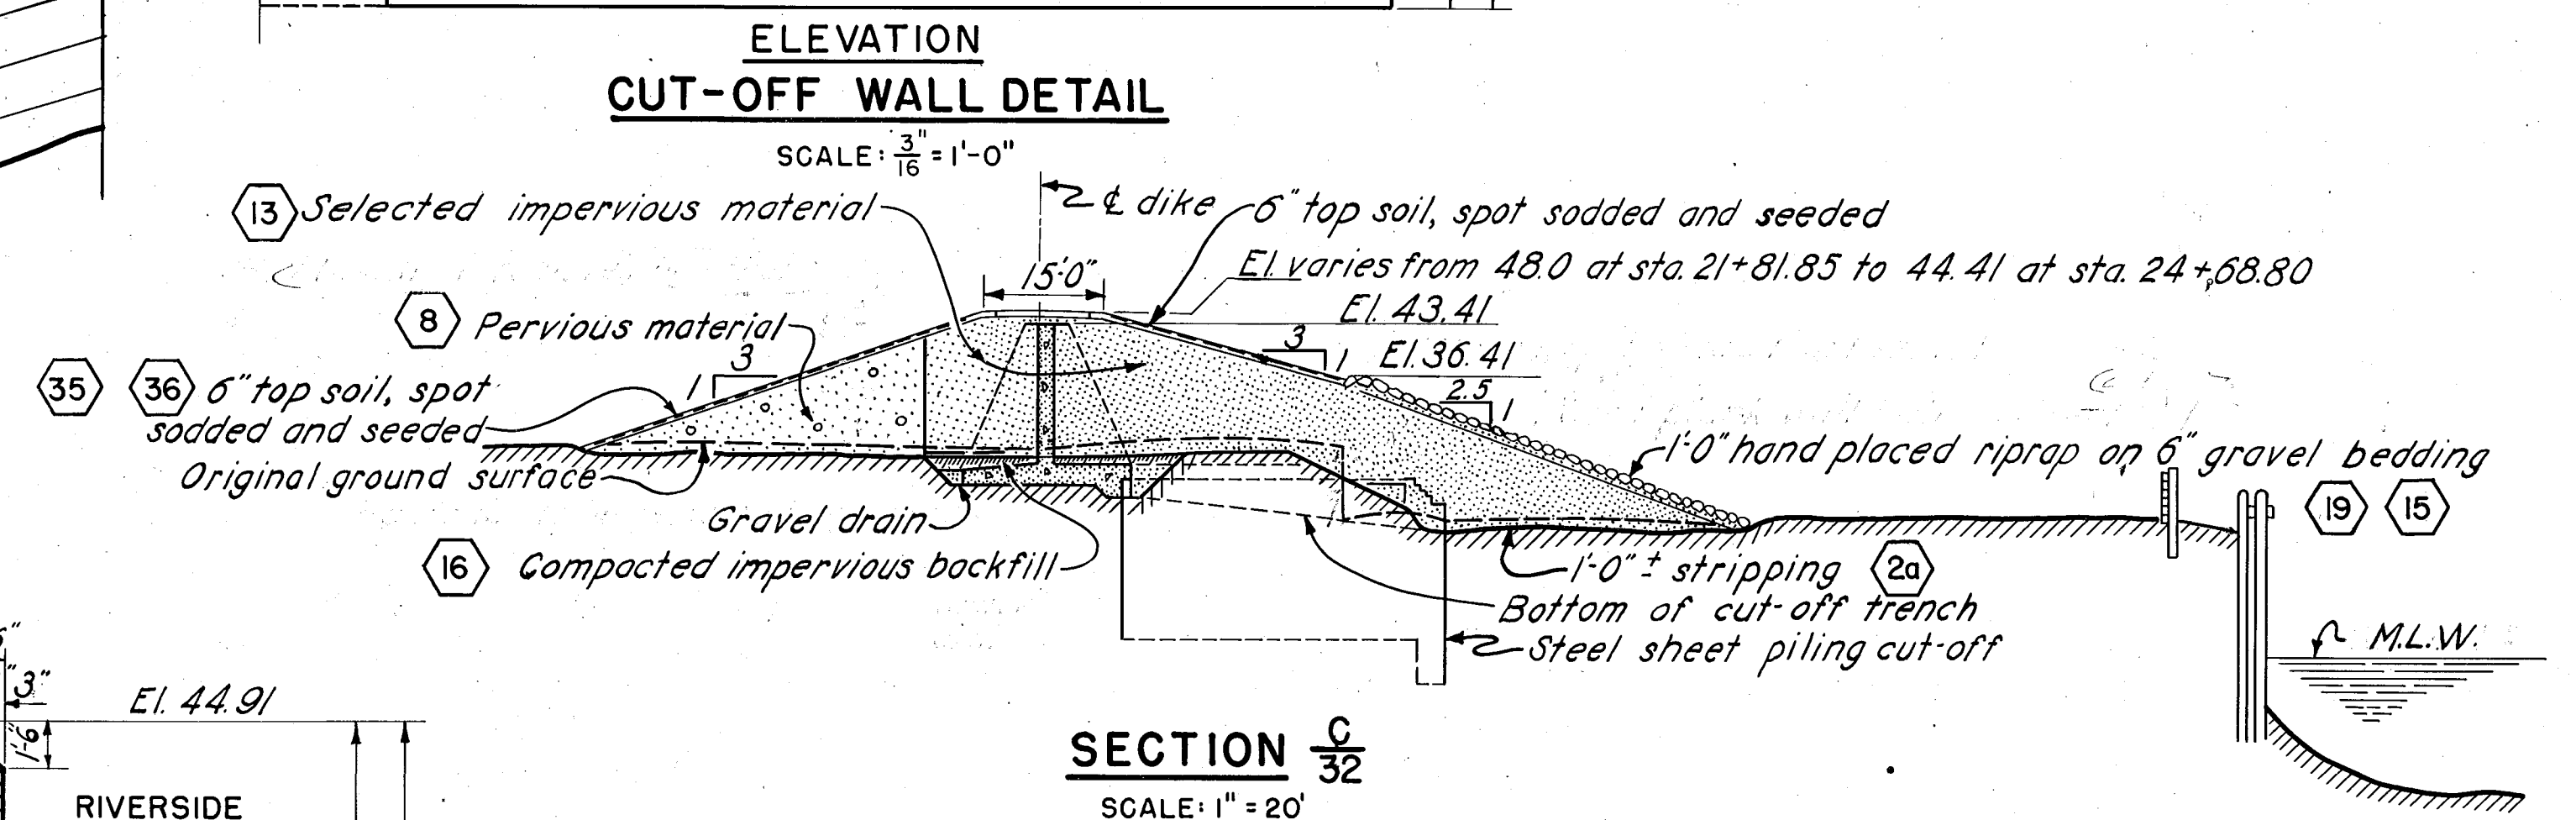
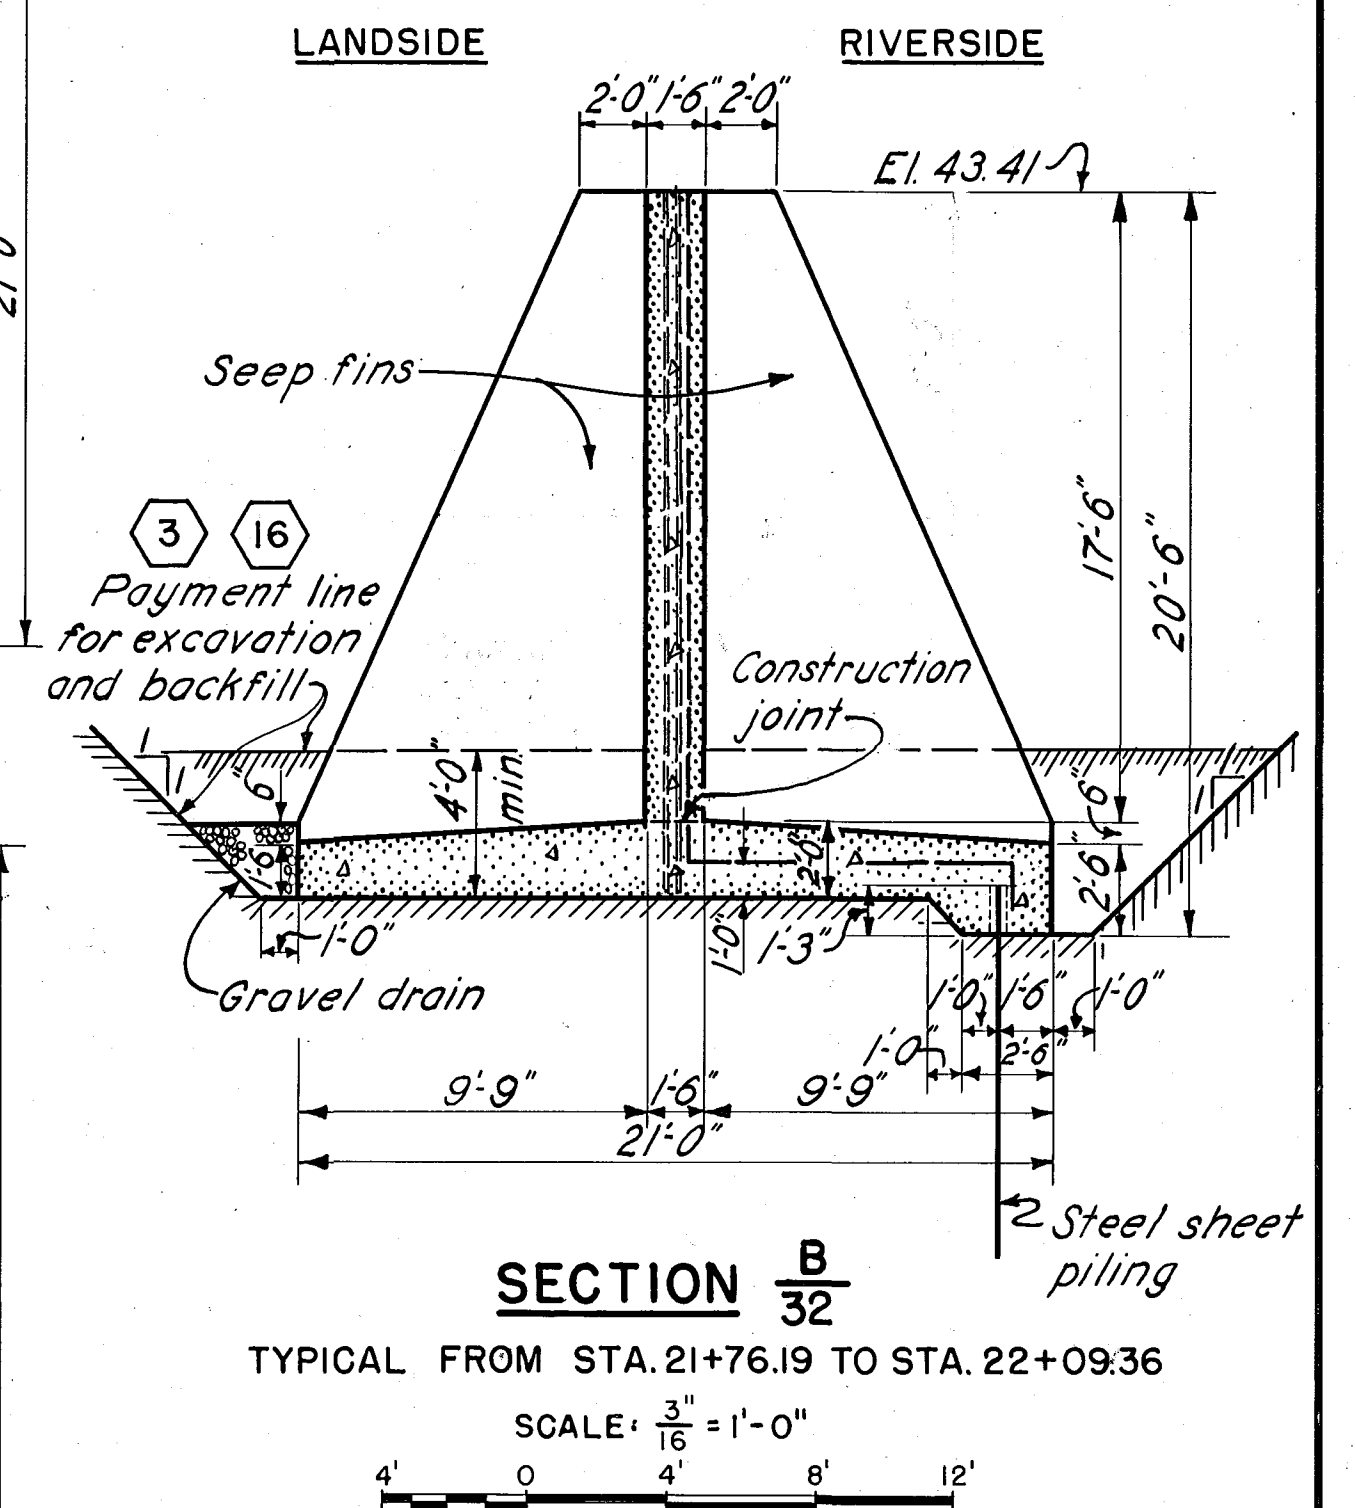


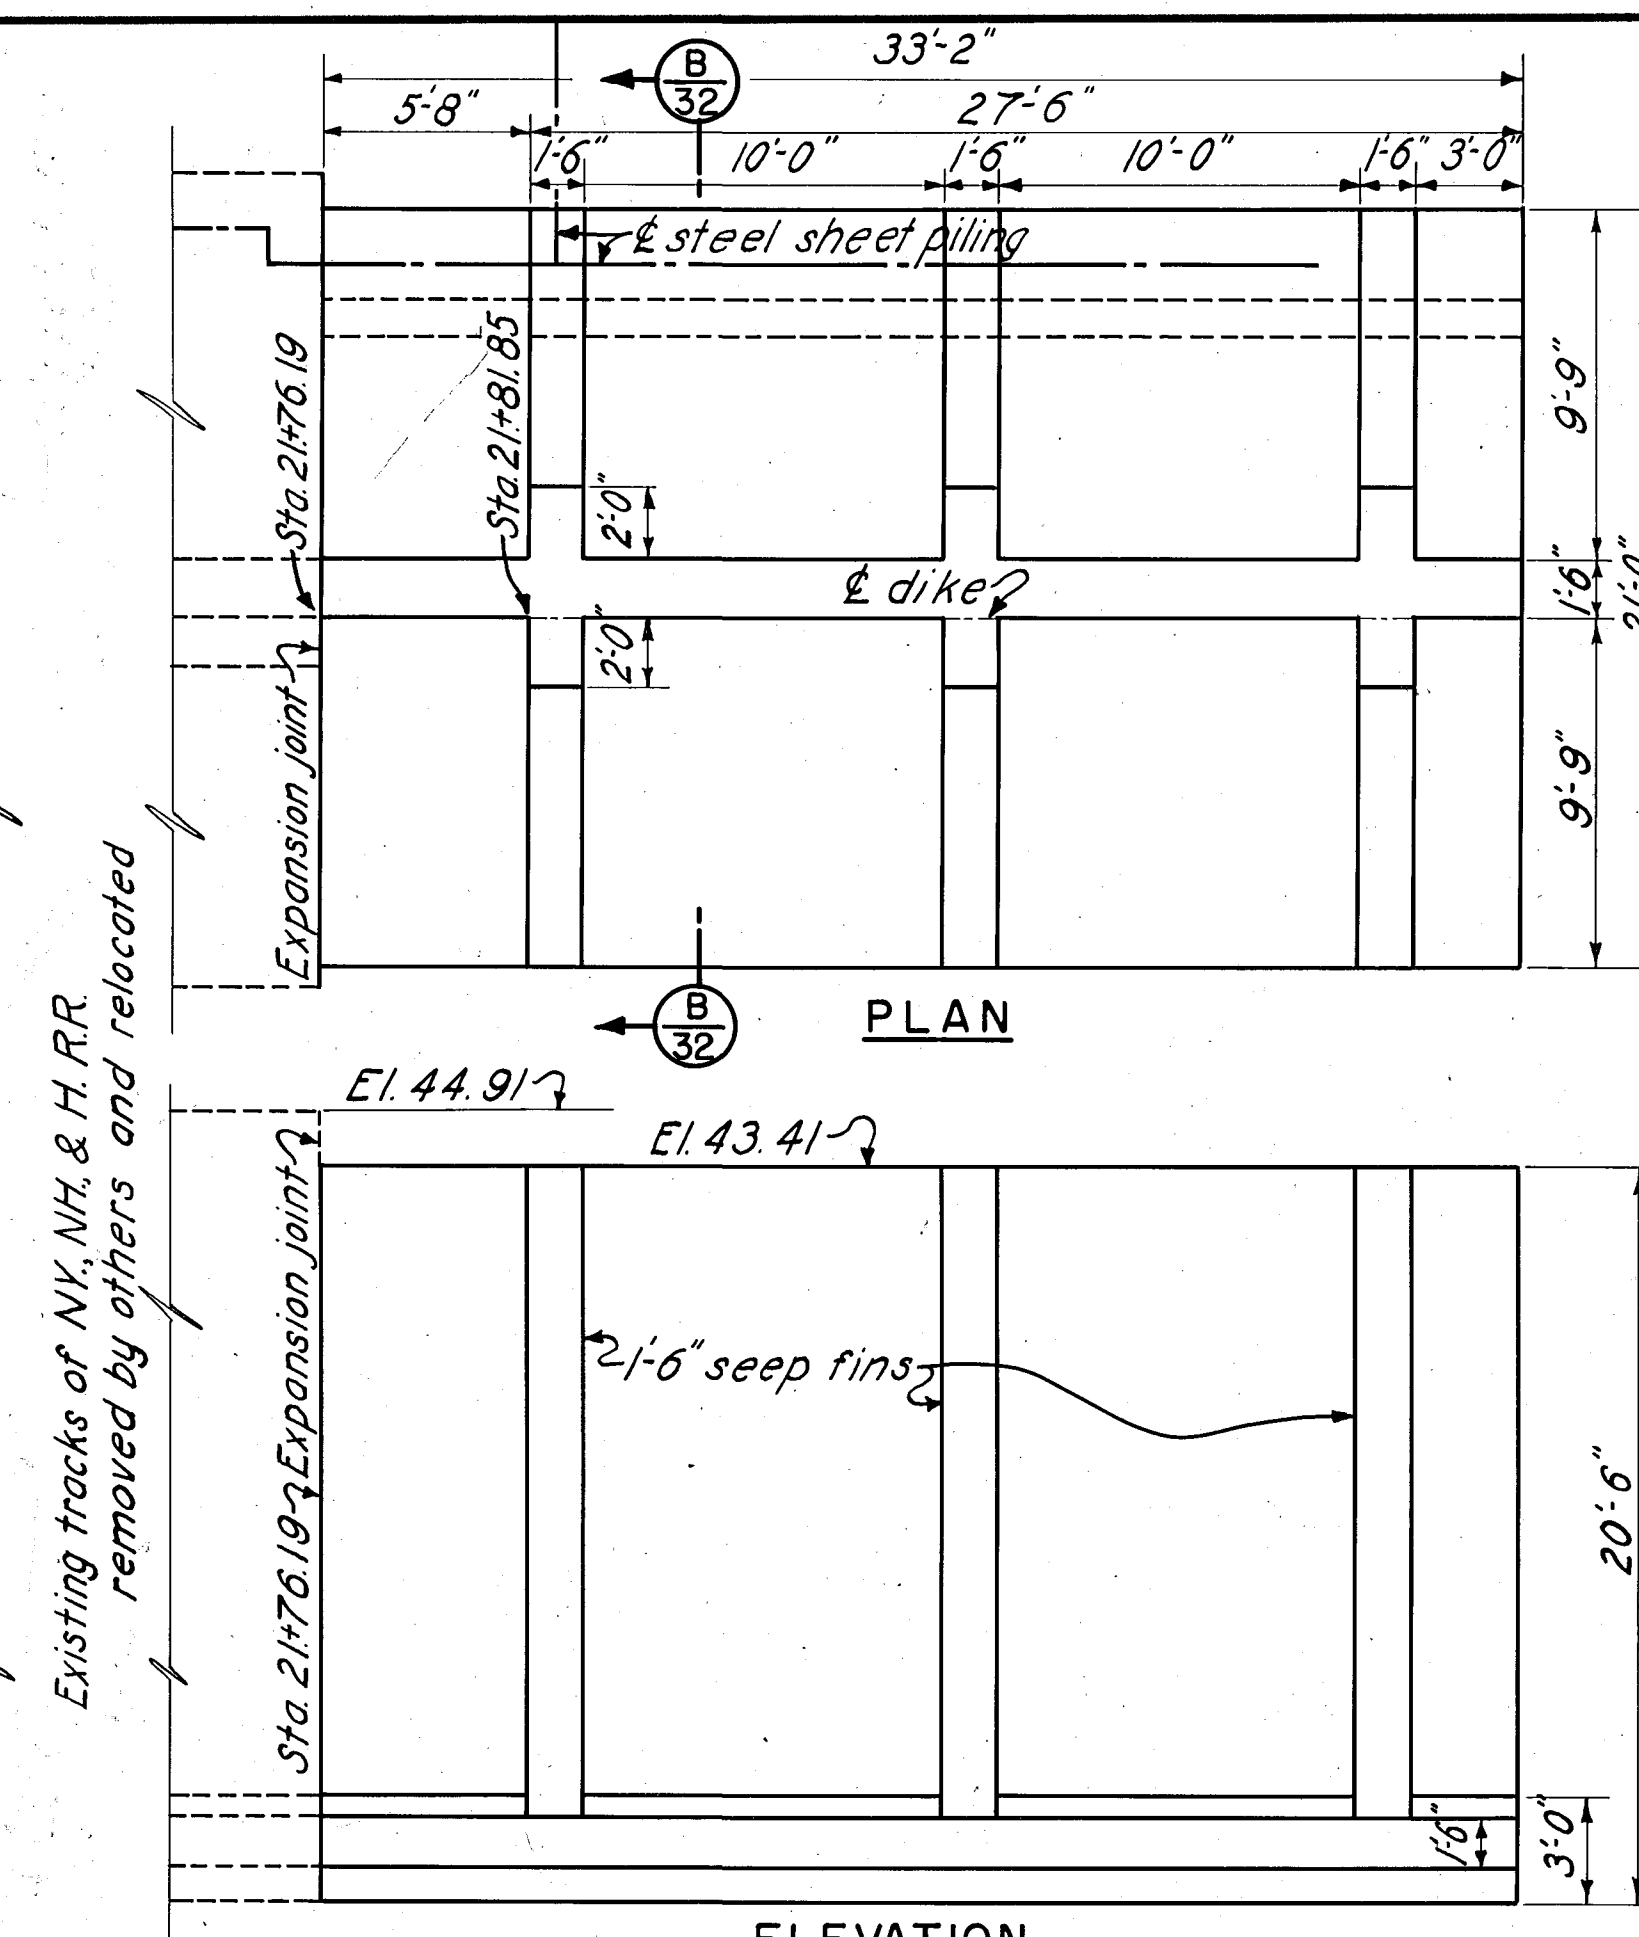

NOTES

For general notes see Sheet No. 12
For details concrete wall see Sheet No. 73
For details of steel sheet piling see
Sheets No. 78 and 79
All exposed edges of concrete structures
shall be chamfered one inch except as noted.
All concrete shown shall be class "A" and
payment will be made under Item No. 24.

	12-31-45	As built revisions			
2	10/11/40	Length of steel sheet piling changed	PC.#:	KN	JR
KEY	DATE	REVISION (Indicated by Δ)	REV. BY	CK. BY	AP. BY

CONNECTICUT RIVER		FLOOD CONTROL	
HARTFORD DIKE			
RIVERFRONT, MORGAN ST. TO STA. 96+73			
WALL-DIKE CONNECTION			
STA. 22+00			
CONNECTICUT RIVER		CONNECTICUT	
IN 135 SHEETS	SCALE: 1 IN. = 20 FT.	SHEET NO. 32	
20' 0' 20' 40'			
U. S. ENGINEER OFFICE, PROVIDENCE, R.I.,		MAY 1940	
SUBMITTED:	APPROVAL RECOMMENDED:	APPROVED:	
<i>Wm. B. Little</i>	<i>W. C. Perkins</i>	<i>W. C. Perkins</i>	
SENIOR ENGINEER	SENIOR ENGINEER	DISTRICT ENGINEER	
HEAD, DESIGN SECTION	CHIEF, P.C. ENGINEERING DIV.		
DESIGNED:	DRAWN: H.C.J. - P.D.M.	FISCAL YEAR 1940	
<i>J. S. Anthier</i>	TRACED: J.R.G.		
ASSOC. ENGINEER	CHECKED: <i>W.C.R.</i>	FILE NO. CT-4-2492-	