
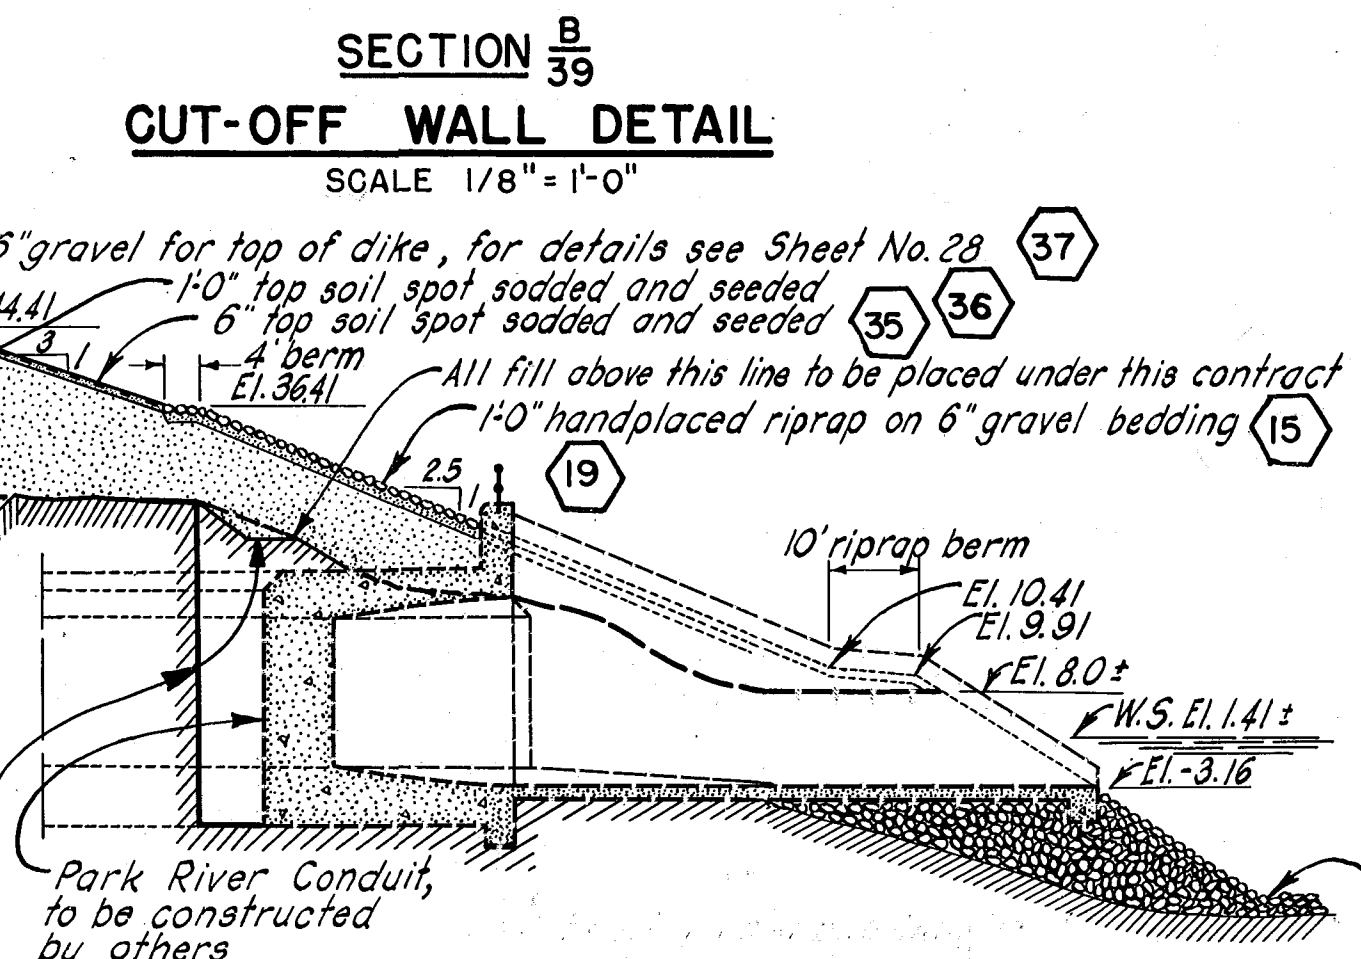
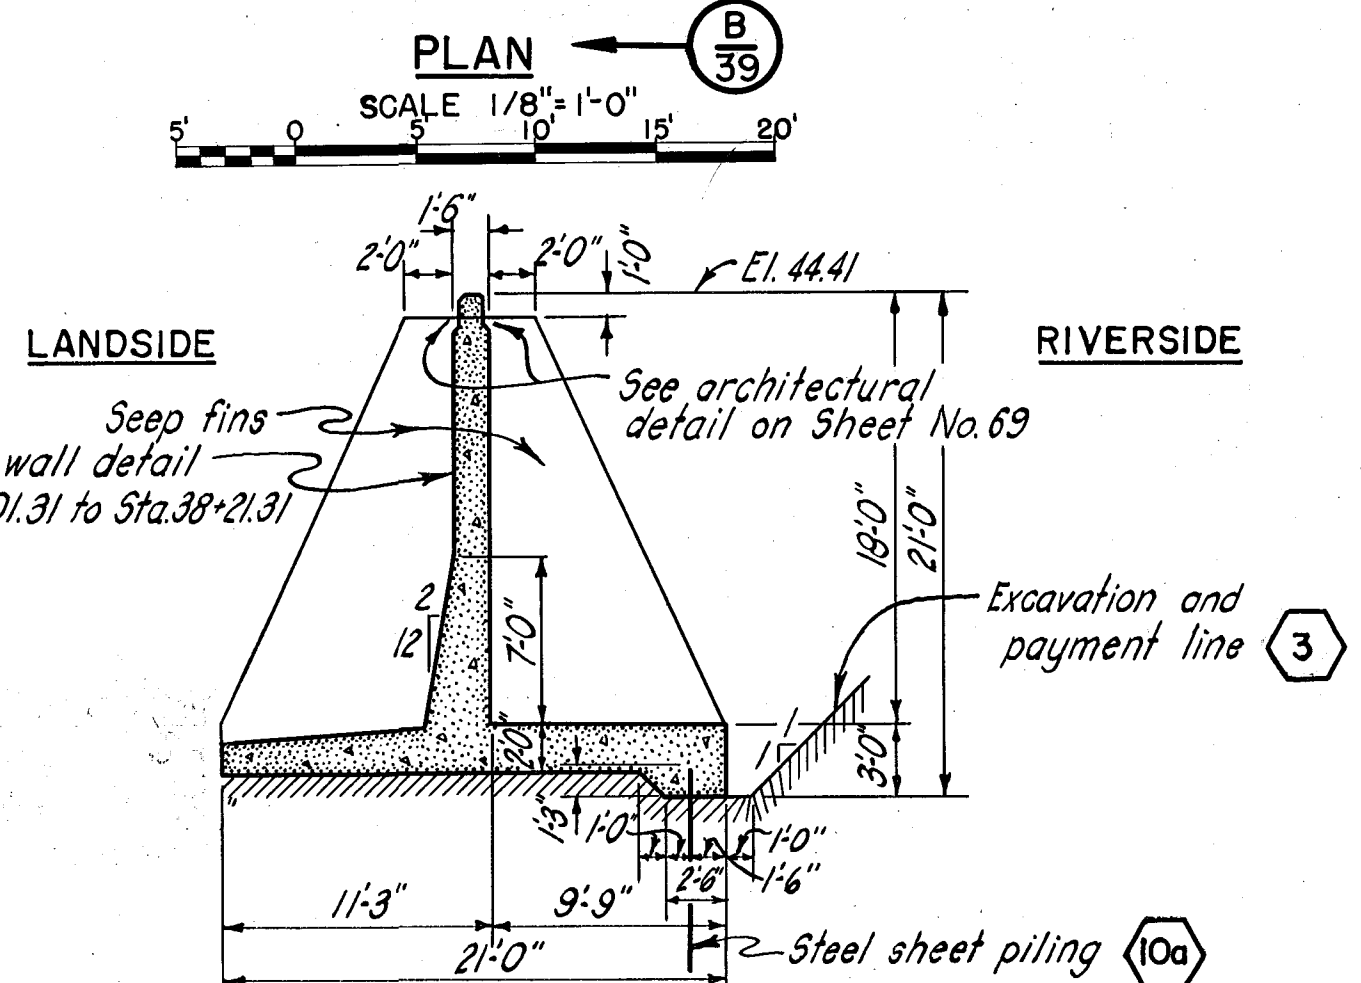
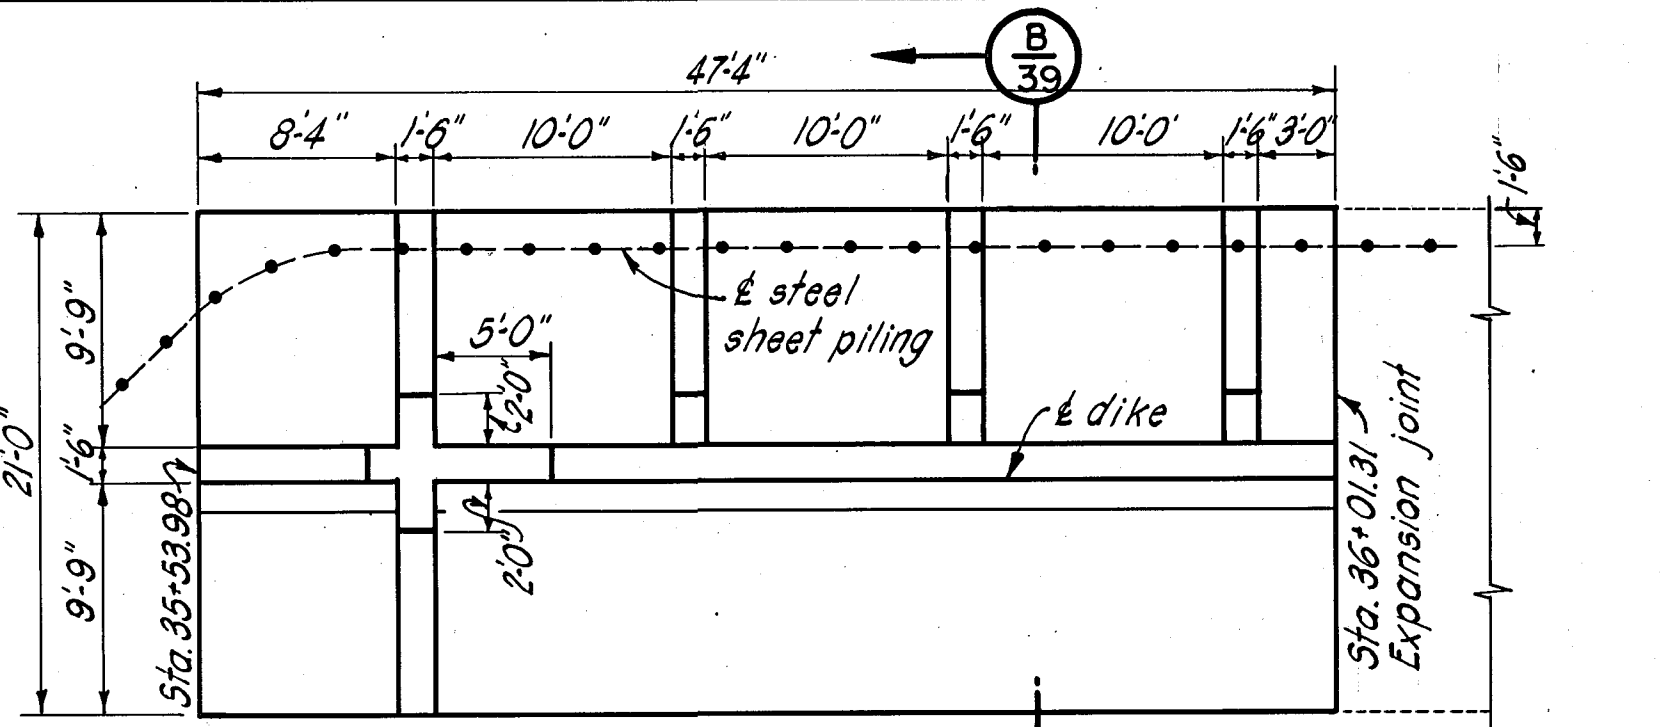


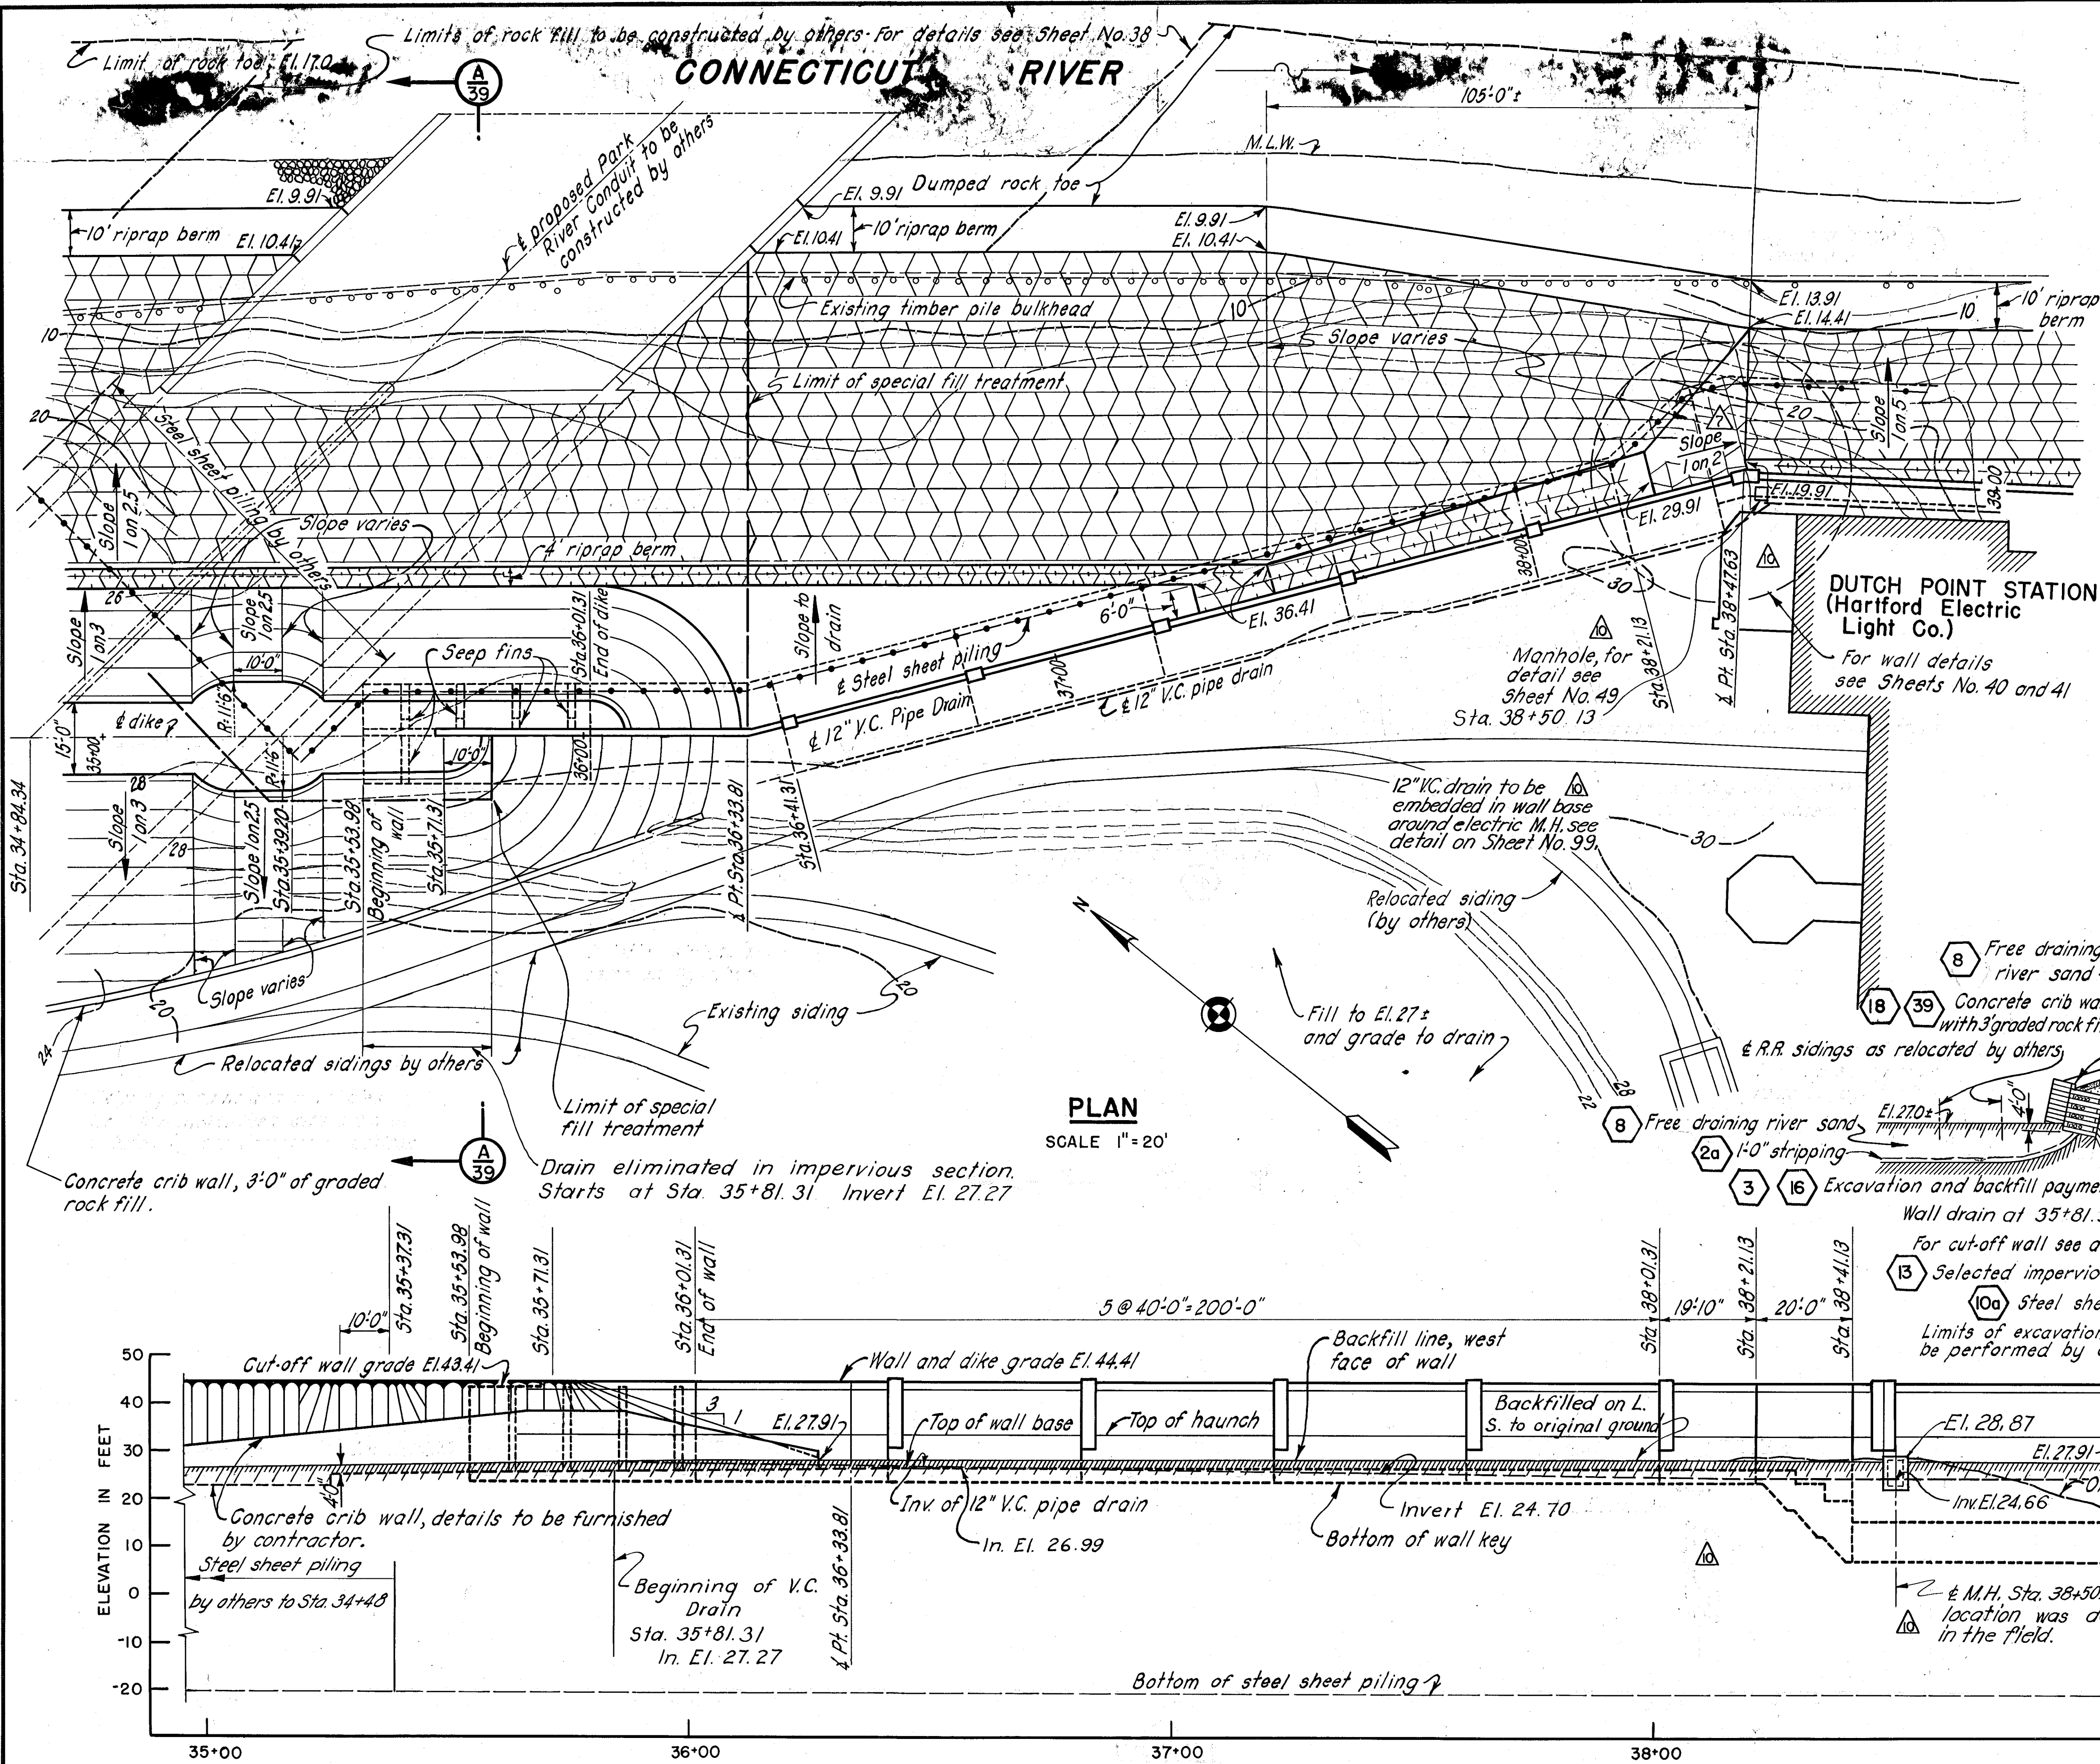

NOTES:
For general notes see Sheet No. 12.
For limits of work to be performed by others under Park River Conduit Contract see Sheet No. 38.

CONNECTICUT RIVER FLOOD CONTROL			
HARTFORD DIKE			
RIVERFRONT, MORGAN ST. TO STA. 96+73			
PLAN DETAILS AND SECTIONS			
STA. 35+00 TO STA. 39+00			
CONNECTICUT RIVER		CONNECTICUT	
IN 135 SHEETS		SHEET NO. 39	
SCALE: 1 IN. = 20 FT.		SCALE: 1 IN. = 20 FT.	
U. S. ENGINEER OFFICE, PROVIDENCE, R.I., MAY 1940			
SUBMITTED: <i>Amos B. Nichols</i>		APPROVAL: <i>J. B. Burns</i>	
SENIOR ENGINEER		PRINCIPAL ENGINEER	
HEAD, DESIGN SECTION		CHIEF, F.C. ENGINEERING DIV.	
DESIGNED: <i>J. H. Hester</i>		DRAWN: H. G. J.	
ASSOC. ENGINEER		TRACED: J. A. G.	
		CHECKED: <i>W. C. C.</i>	
		FISCAL YEAR 1940	
		FILE NO. CT-4-2499	

12-31-45	As built revisions	P.C.H.	10	240
10/6/41	Drain revised	W.C.C.	10	240
3/10/41	Riverside slope revised	W.C.C.	10	240
KEY	DATE	REVISION (Indicated by Δ)	REV. BY	CK. BY