




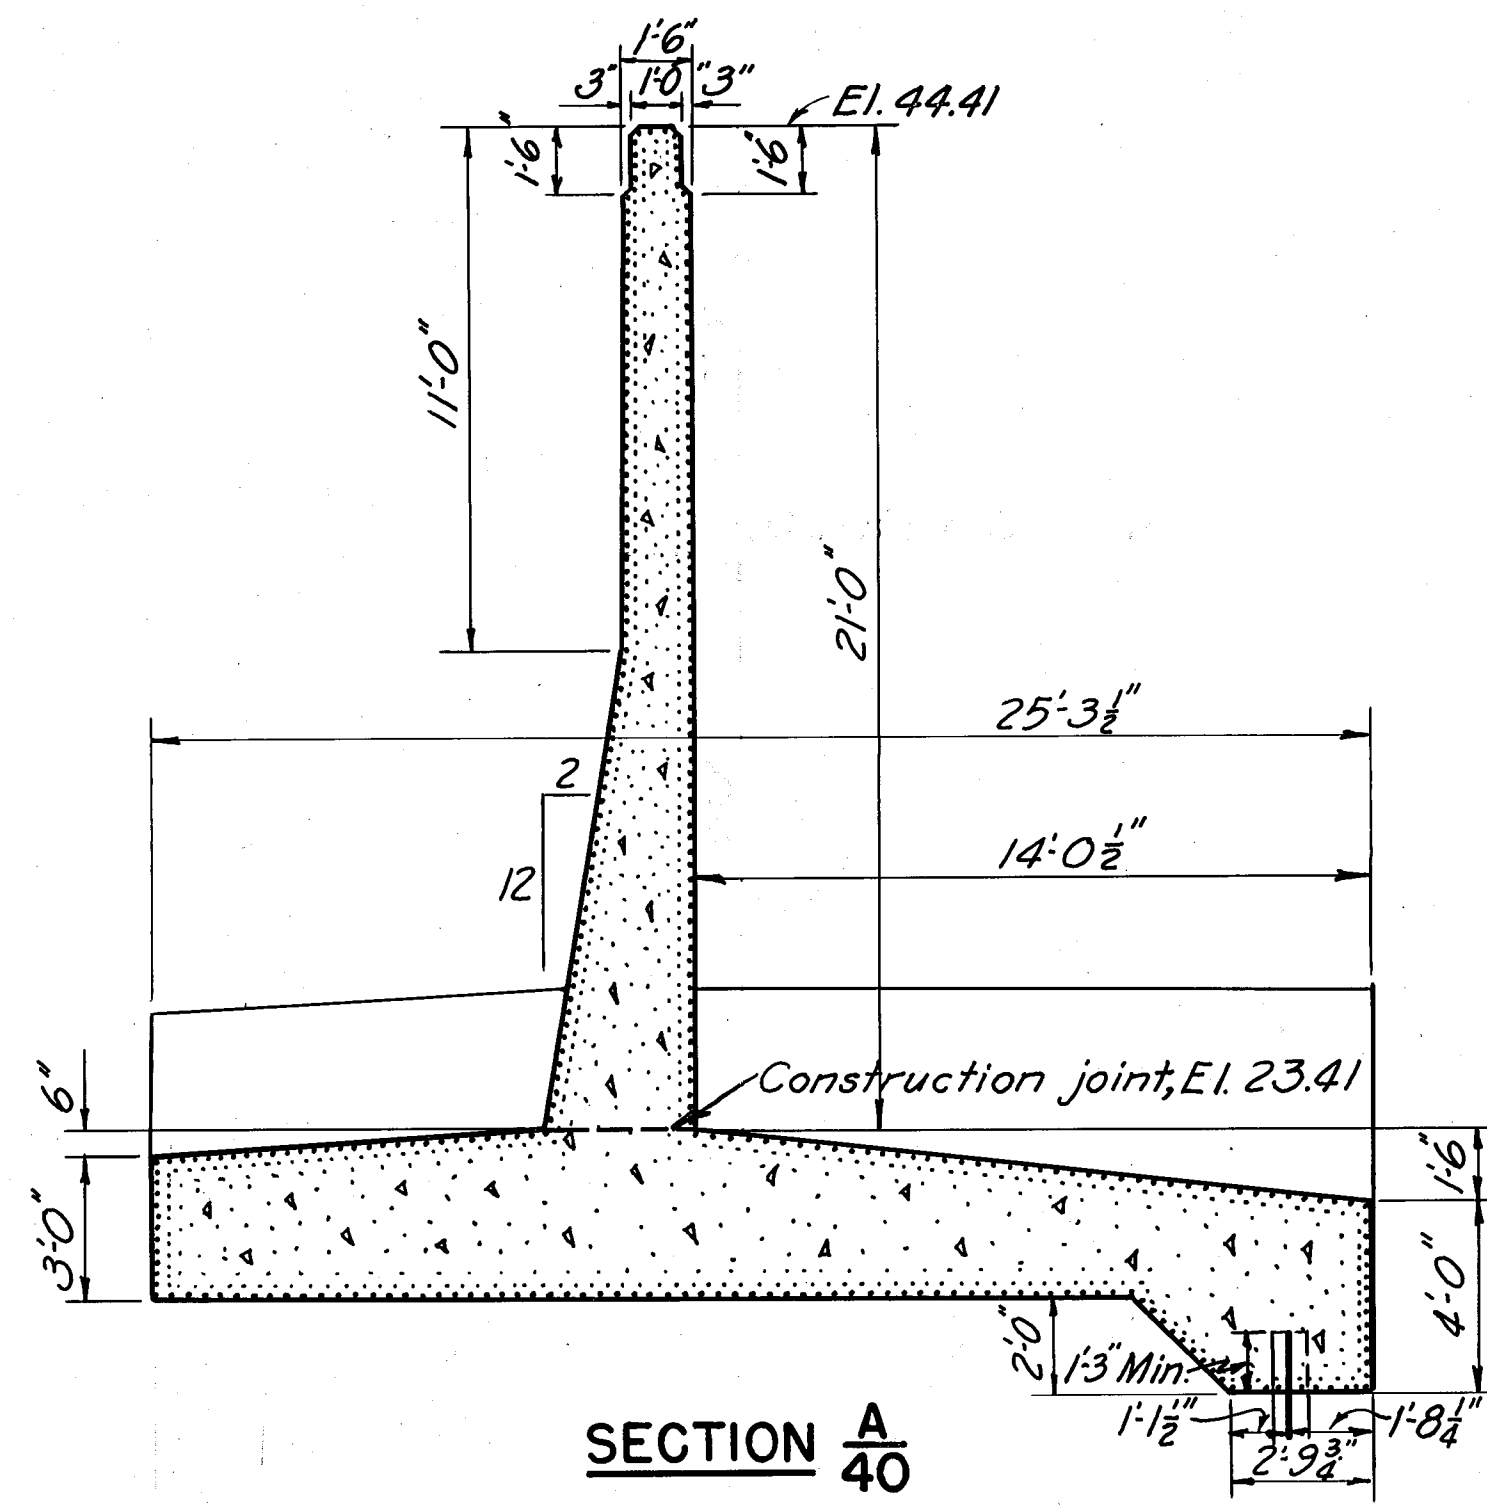


SECTION A 40

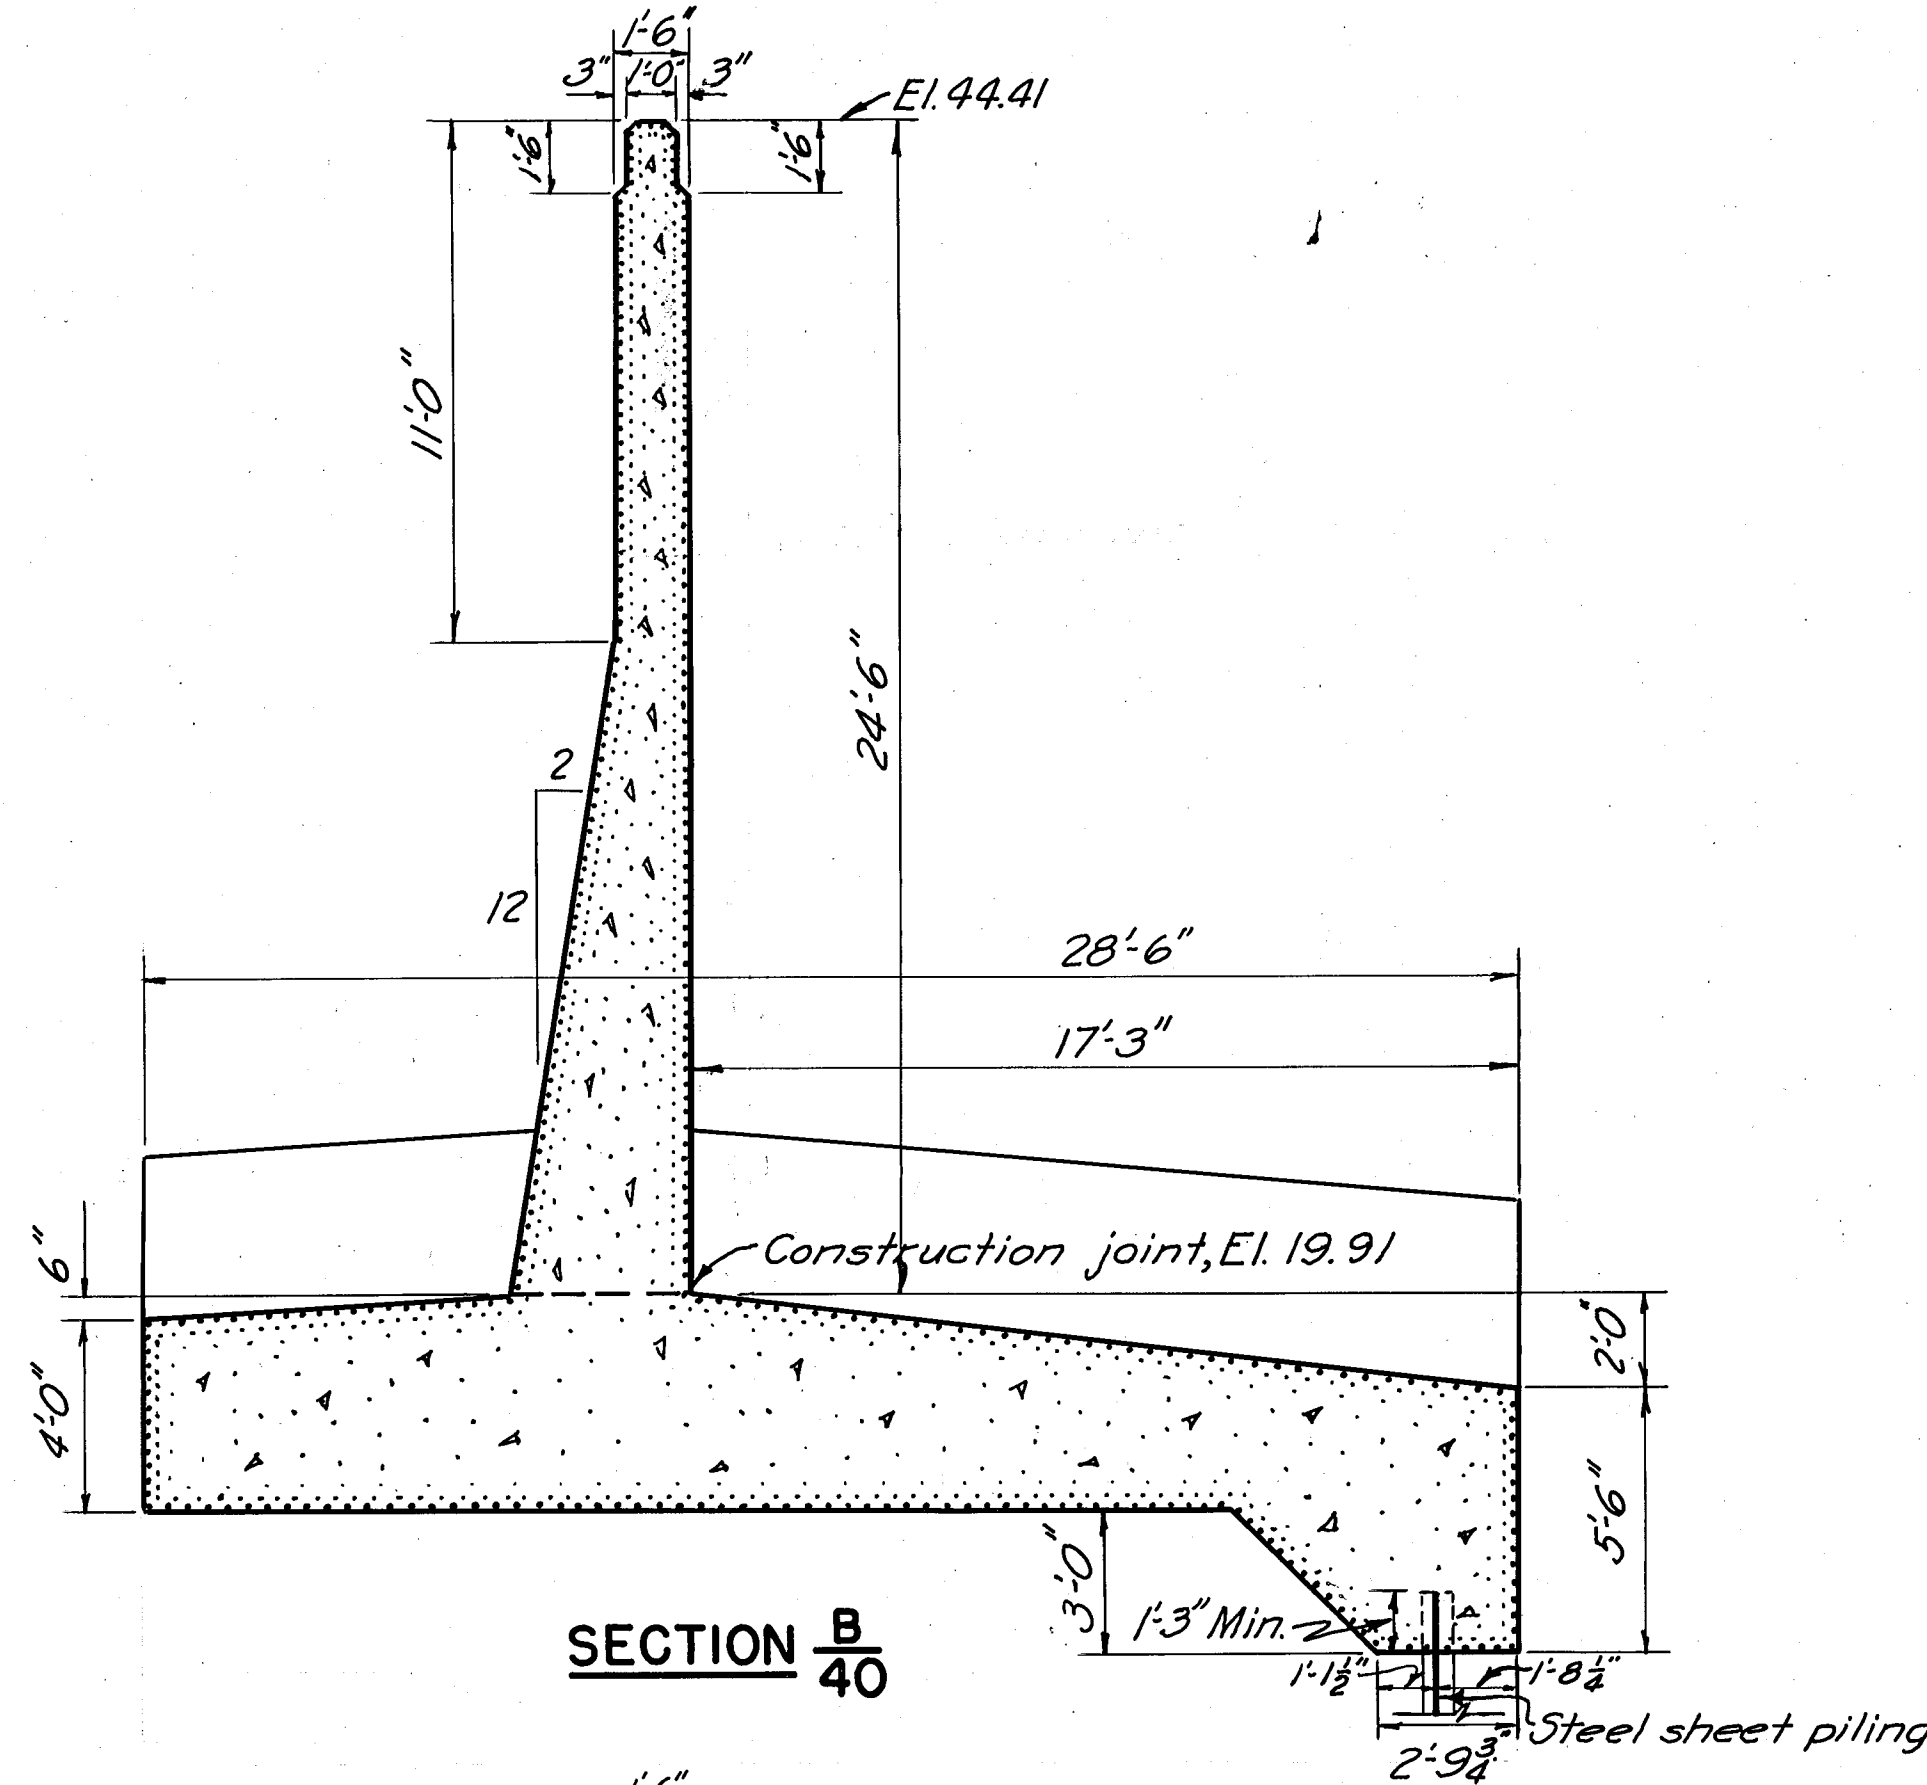


SECTION B 40

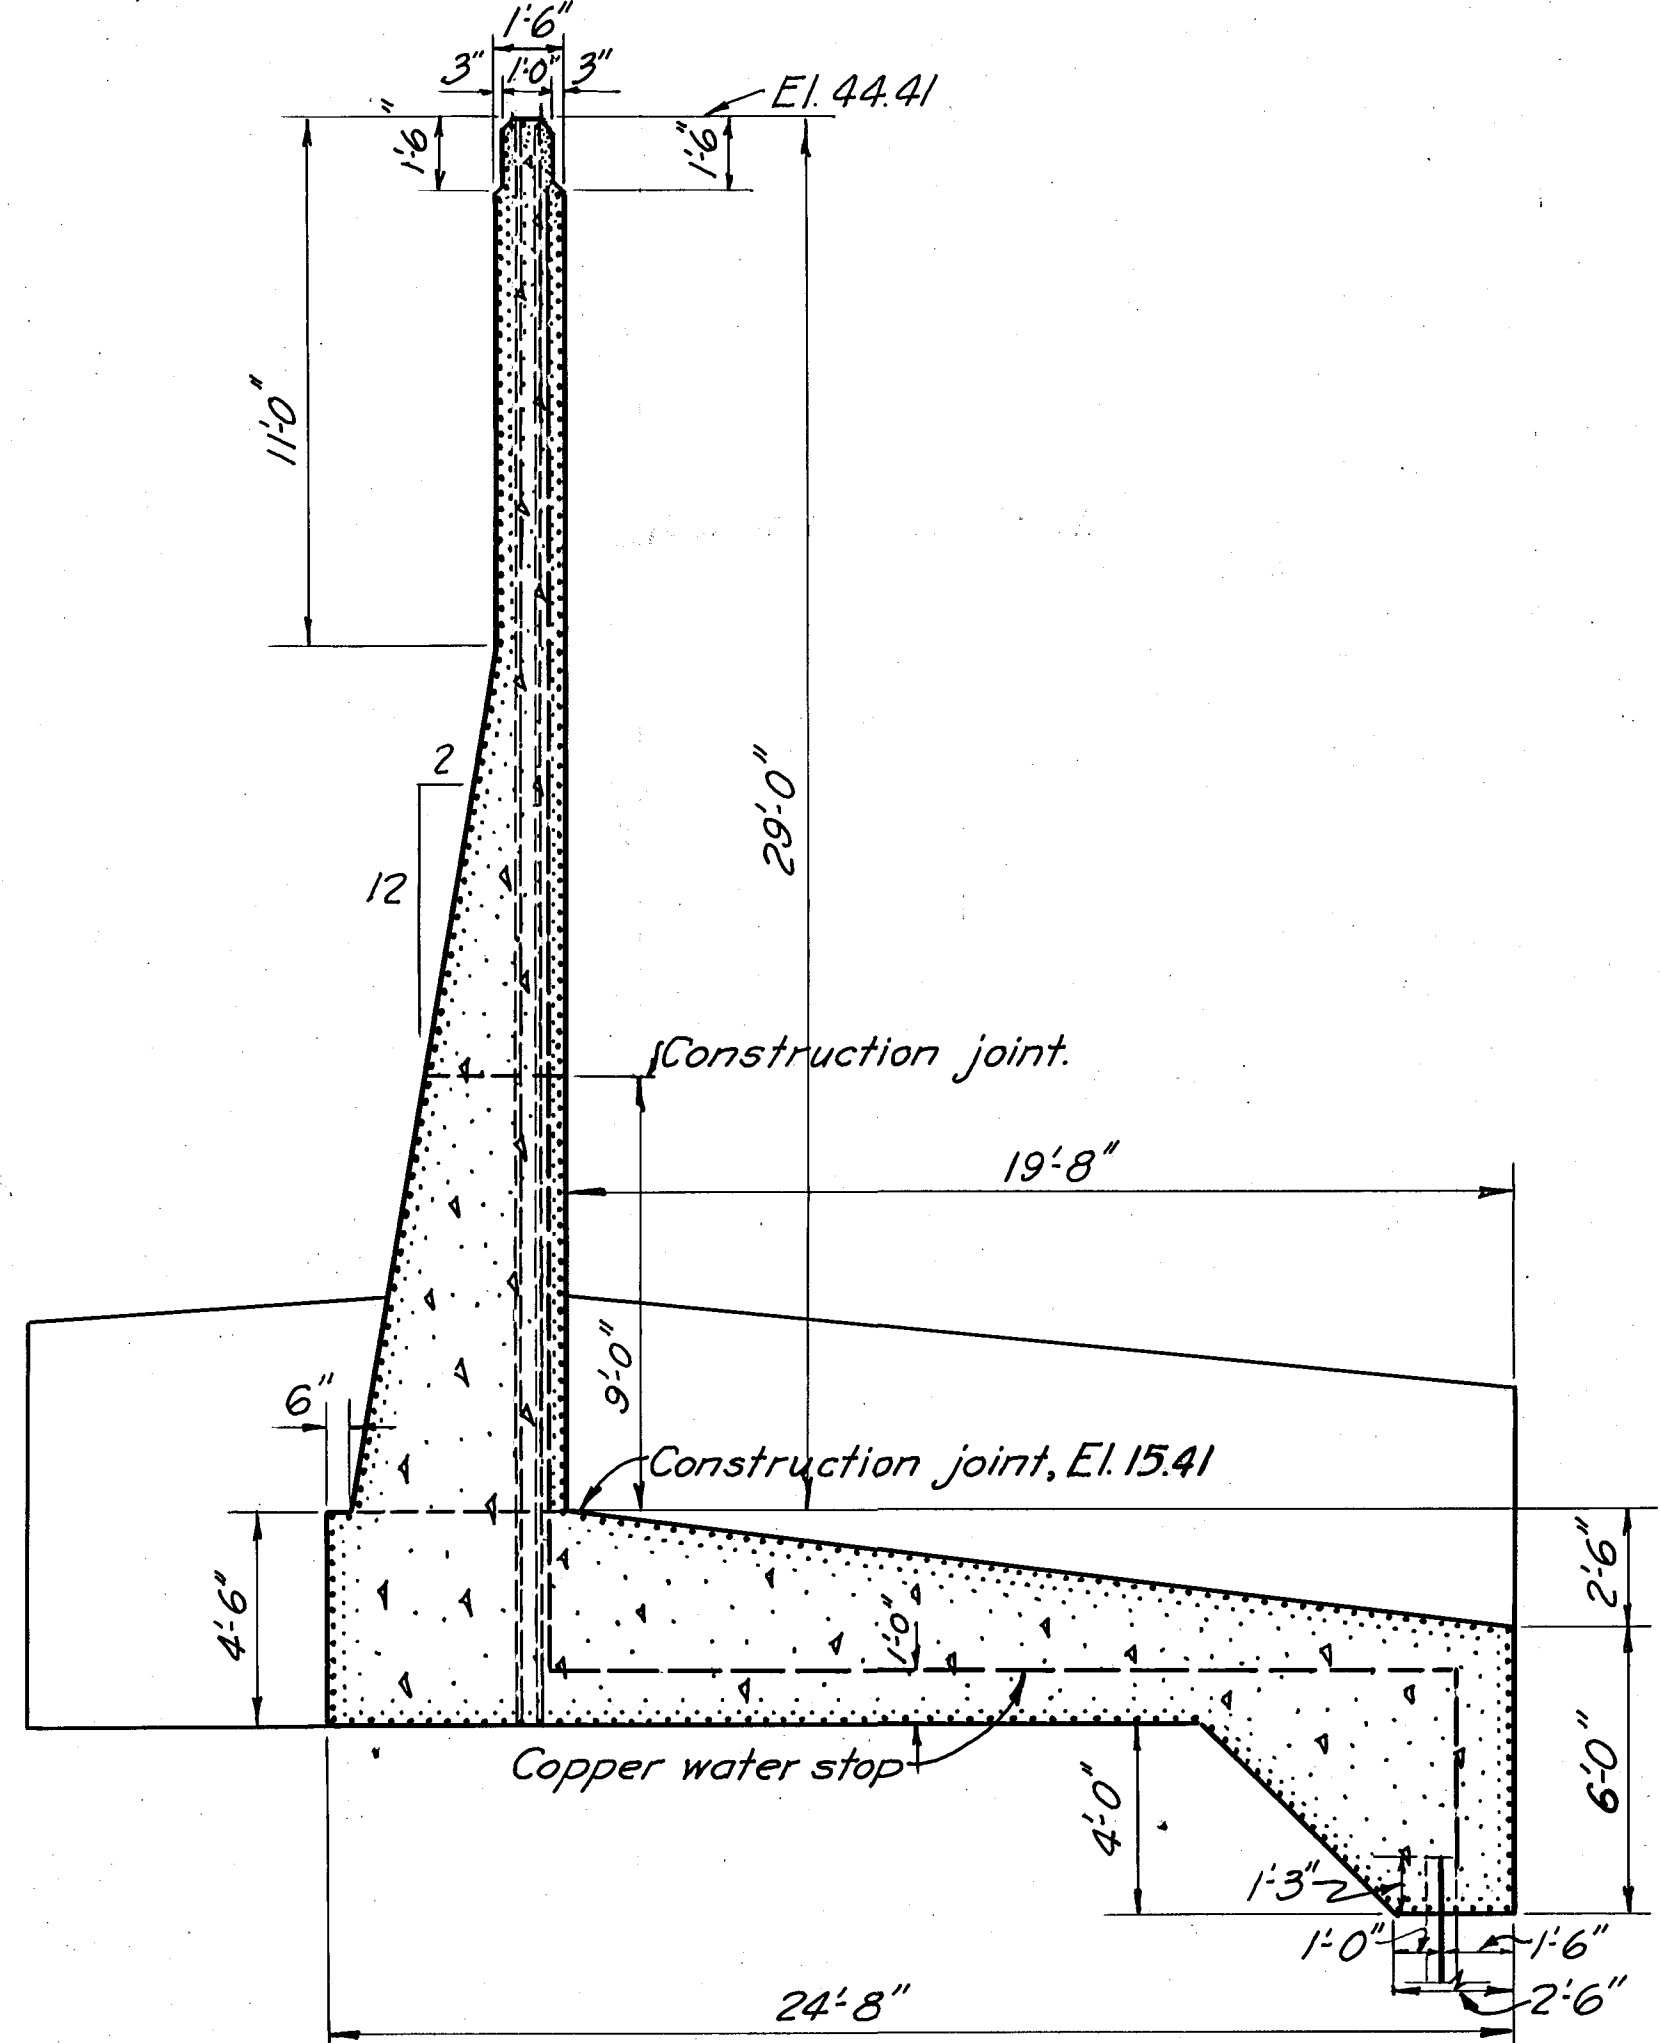

SECTION C 40

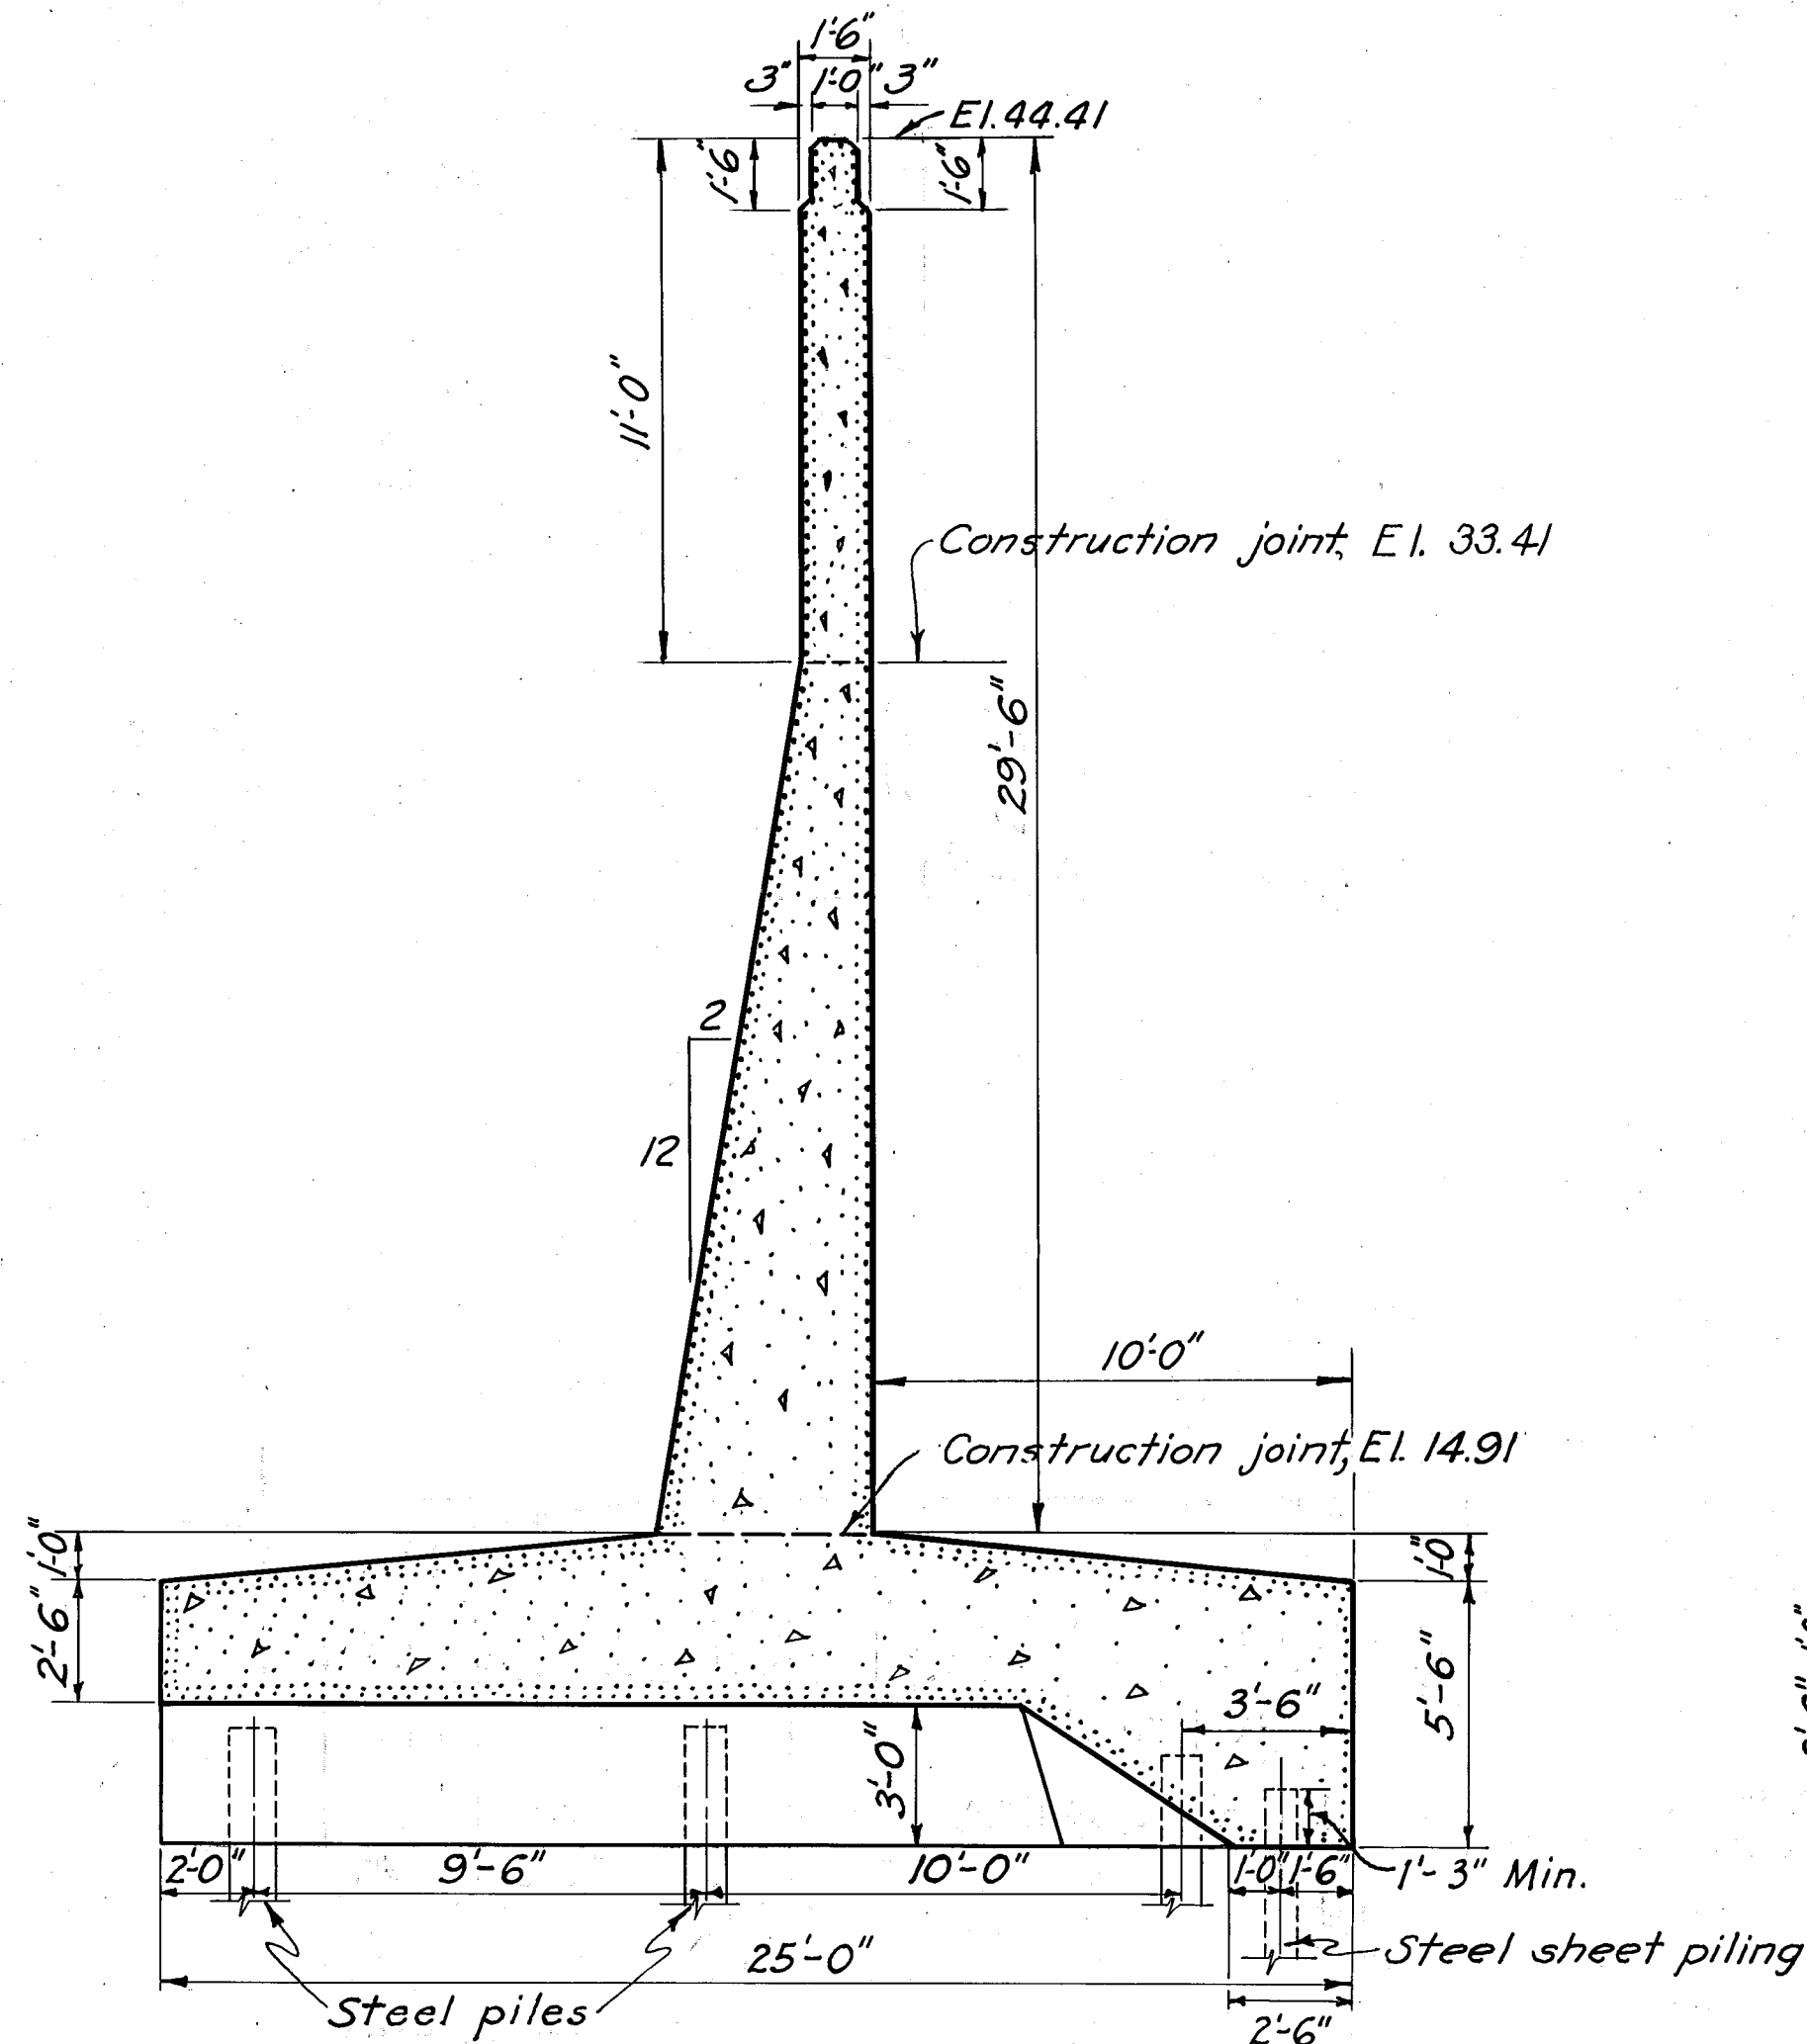

SECTION H 40-45

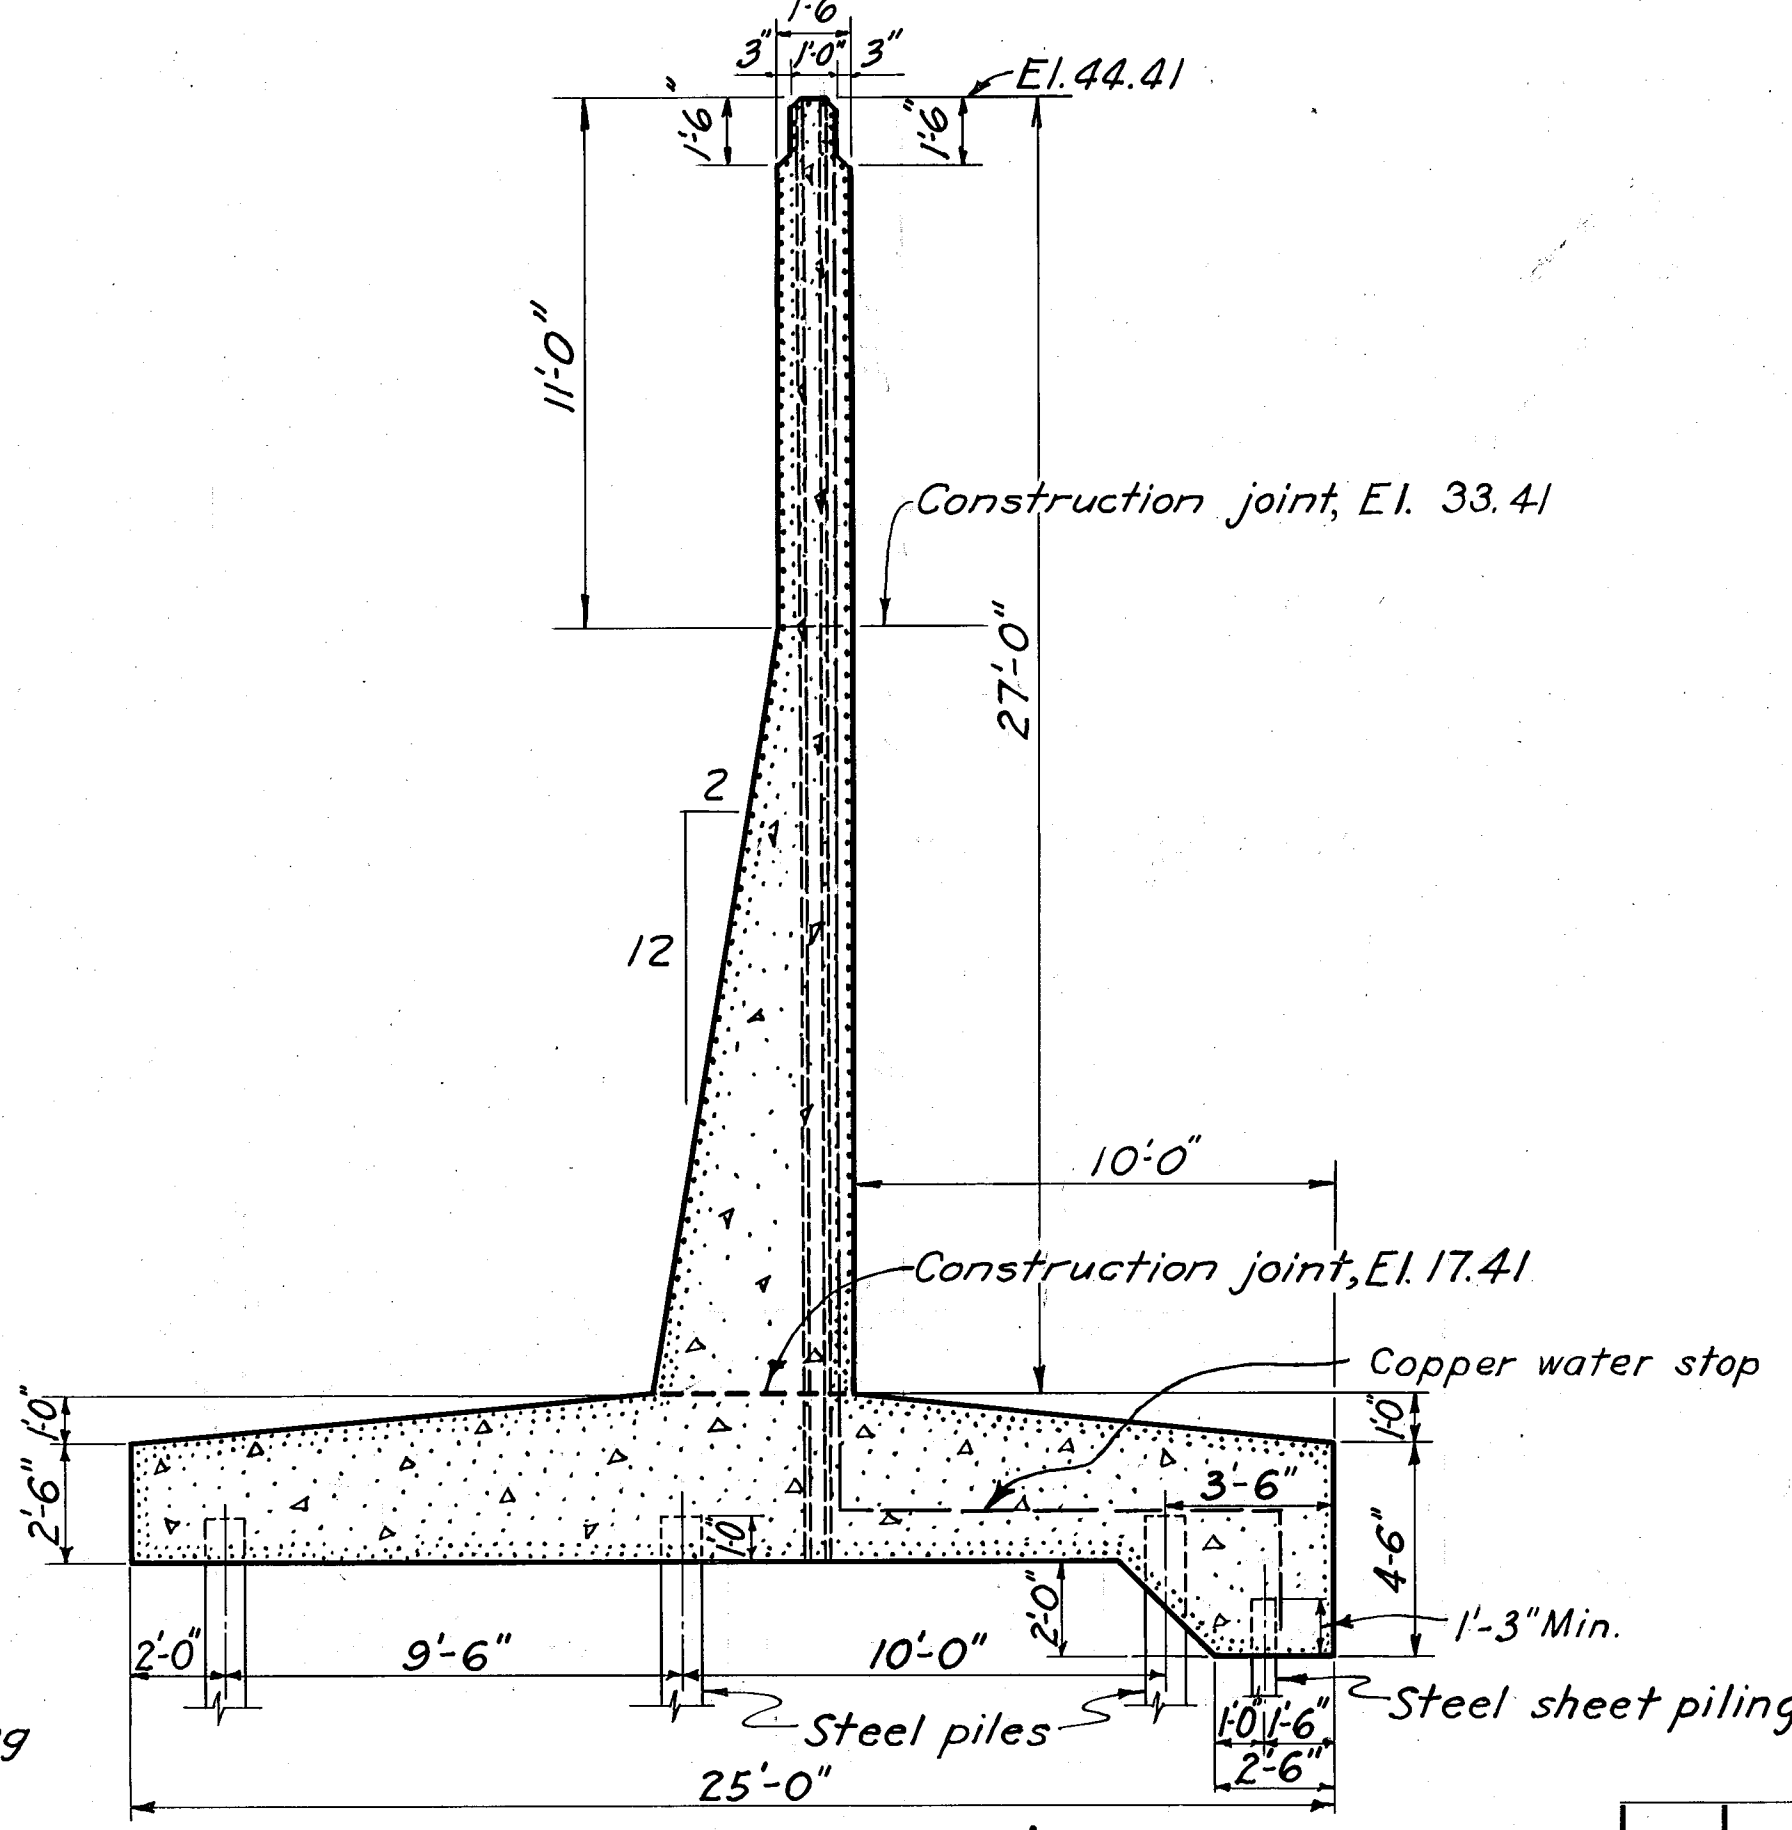

SECTION J 40-45

TYPICAL FROM STA. 41+21.05 TO STA. 43+82.63

NOTES
For general notes see Sheet No. 40.
Construction joints in walls from Sta 41+02.63 to 44+90 have been laid out to be consistent with contractors approved drawings

CONNECTICUT RIVER FLOOD CONTROL			
HARTFORD DIKE			
RIVERFRONT, MORGAN ST. TO STA. 96+73.			
CORNER DETAILS NO. 2			
STA. 38+47. AND STA. 41+02.			
CONNECTICUT RIVER		CONNECTICUT	
IN 135 SHEETS		SCALE: 1/4 IN. = 1 FT.	
SHEET NO. 41			
U.S. ENGINEER OFFICE, PROVIDENCE, R.I., MAY 1940			
SUBMITTED: <i>W. B. Fisher</i>		APPROVAL RECOMMENDED: <i>W. B. Fisher</i>	
HEAD, DESIGN SECTION		PRINCIPAL ENGINEER	
DESIGNED: <i>W. B. Fisher</i>		TRACED: E.A.H.	
ASSOC. ENGINEER		CHECKED: <i>W. B. Fisher</i>	
		FISCAL YEAR 1940	
		FILE NO. CT-4-2501	

12-31-45	As built revisions				
3-10-41	Wall sections revised.	WQE	1/2	WQE	
KEY	DATE	REVISION (Indicated by Δ)	REV. BY	CK. BY	AP. BY