


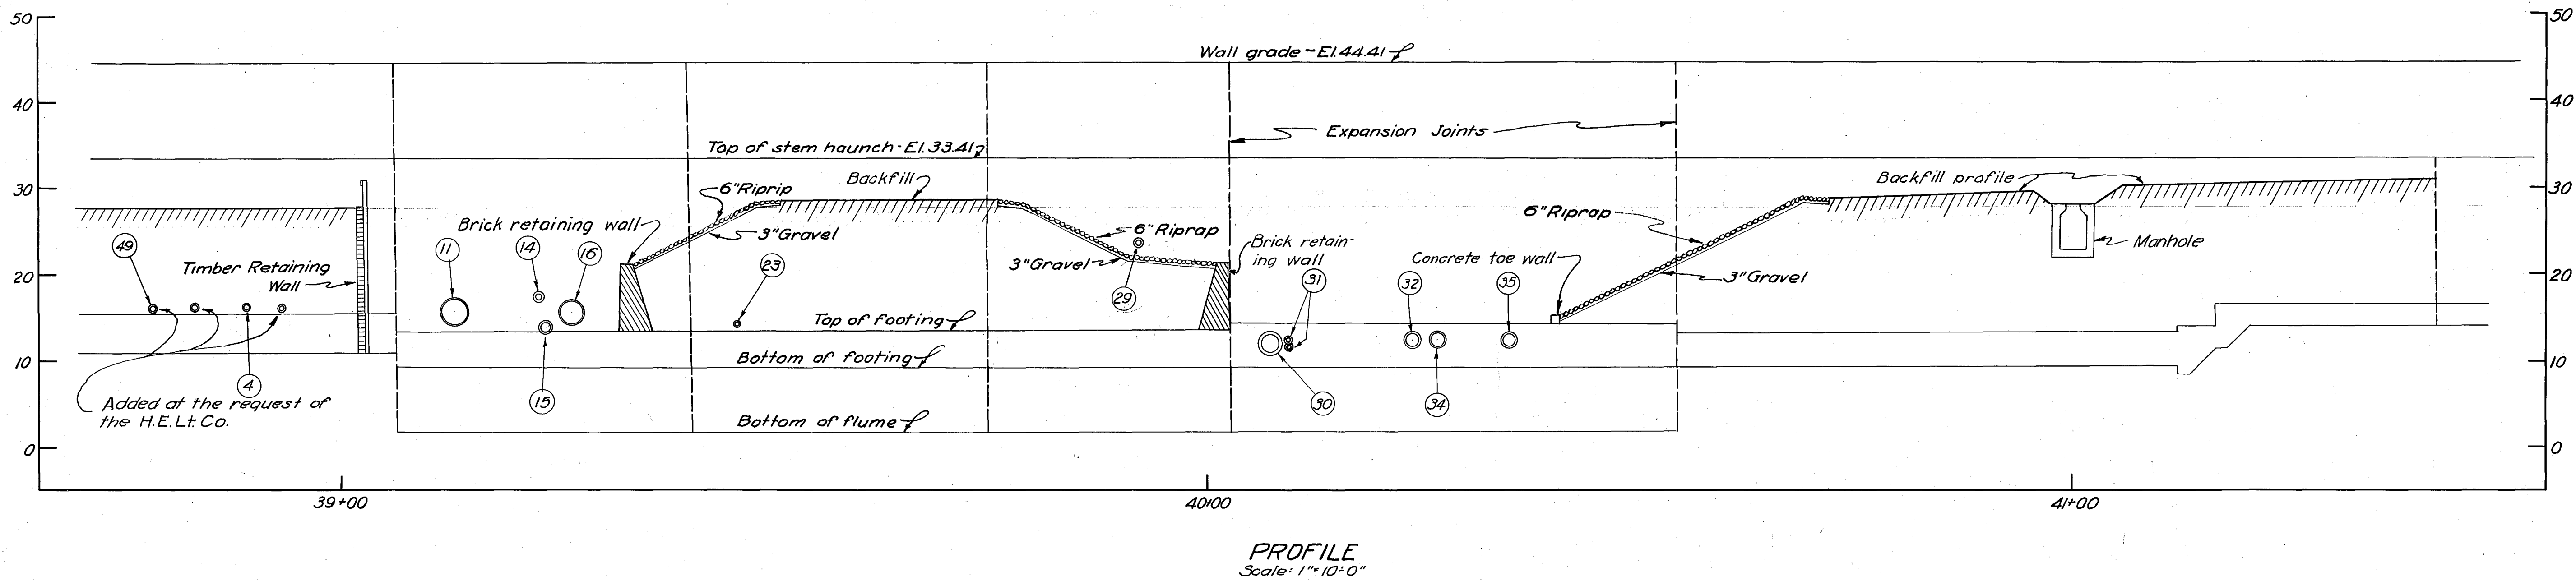

Index Number	Removed as req'd or rel'd for con- str. by				Repl'd as neces- sary by				Valves			Remarks	Index Number	Removed as req'd or rel'd for con- str. by				Repl'd as neces- sary by				Valves			Remarks																																																																																																																																																																																																																																																																																																																																																																																																																																																																																																																																																																																																																																																																																																																																																																																																																																																																																																																																																																																																																																																																																																																																																																																																																																																																																												
	Cont'r	Others	Cont'r	Others	Number	Name & Type	Furnish- ed by	Cont'r	Others	Cont'r	Others			Number	Name & Type	Furnish- ed by	Cont'r	Others	Cont'r	Others	Number	Name & Type	Furnish- ed by																																																																																																																																																																																																																																																																																																																																																																																																																																																																																																																																																																																																																																																																																																																																																																																																																																																																																																																																																																																																																																																																																																																																																																																																																																																																																														
1		X		X	0							10" Water line - Relocated outside of area	24	X				0						14" Discharge - No 4 Condenser Abandoned.	47	X				0																																																																																																																																																																																																																																																																																																																																																																																																																																																																																																																																																																																																																																																																																																																																																																																																																																																																																																																																																																																																																																																																																																																																																																																																																																																																																							

NOTES:
All elevations refer to M.S.L. Datum
Index No 27, Concrete flume, See sheet 44 of contract plans.
Index No 33, Walkway, see sheet 48 of contract plans.
For general arrangement of relocated pipes see Sheet No. 43.
For toe drain details through Access Pits see Change Order No. 23 plans.
This sheet supersedes the index on Sheet No. 42 of the contract plans.

THIS SHEET ADDED TO SET

CONNECTICUT	RIVER	FLOOD	CONTROL
HARTFORD DIKE			
RIVERFRONT, MORGAN ST. TO STA. 97+05			
KEY PLAN OF EXISTING STRUCTURES			
DUTCH POINT STATION			
CONNECTICUT	RIVER	CONNECTICUT	
IN	SHEETS	SCALE: 1 IN. = 10 FT.	SHEET NO. 42B
U.S. ENGINEER OFFICE PROVIDENCE, R.I. DATE: FEB 1943			
SUBMITTER	APPROVAL	RECOMMENDED	APPROVED
J. C. Dingwall	J. C. Dingwall	J. C. Dingwall	J. C. Dingwall
SENIOR ENGINEER	PRINCIPAL ENGINEER	PRINCIPAL ENGINEER	COL., CORPS OF ENGRS
HEAD, DESIGN SECTION	CHIEF, ENGINEERING DIV.	CHIEF, ENGINEERING DIV.	DISTRICT ENGINEER
PREPARED BY: Paul L. Anderson	DRAWN BY:	CHECKED BY:	FILE NO. CT-4-3445
RESIDENT ENGR			

KEY	DATE	REVISION	REV. BY	CHK. BY	AP. BY
	12-31-45	As Built			