


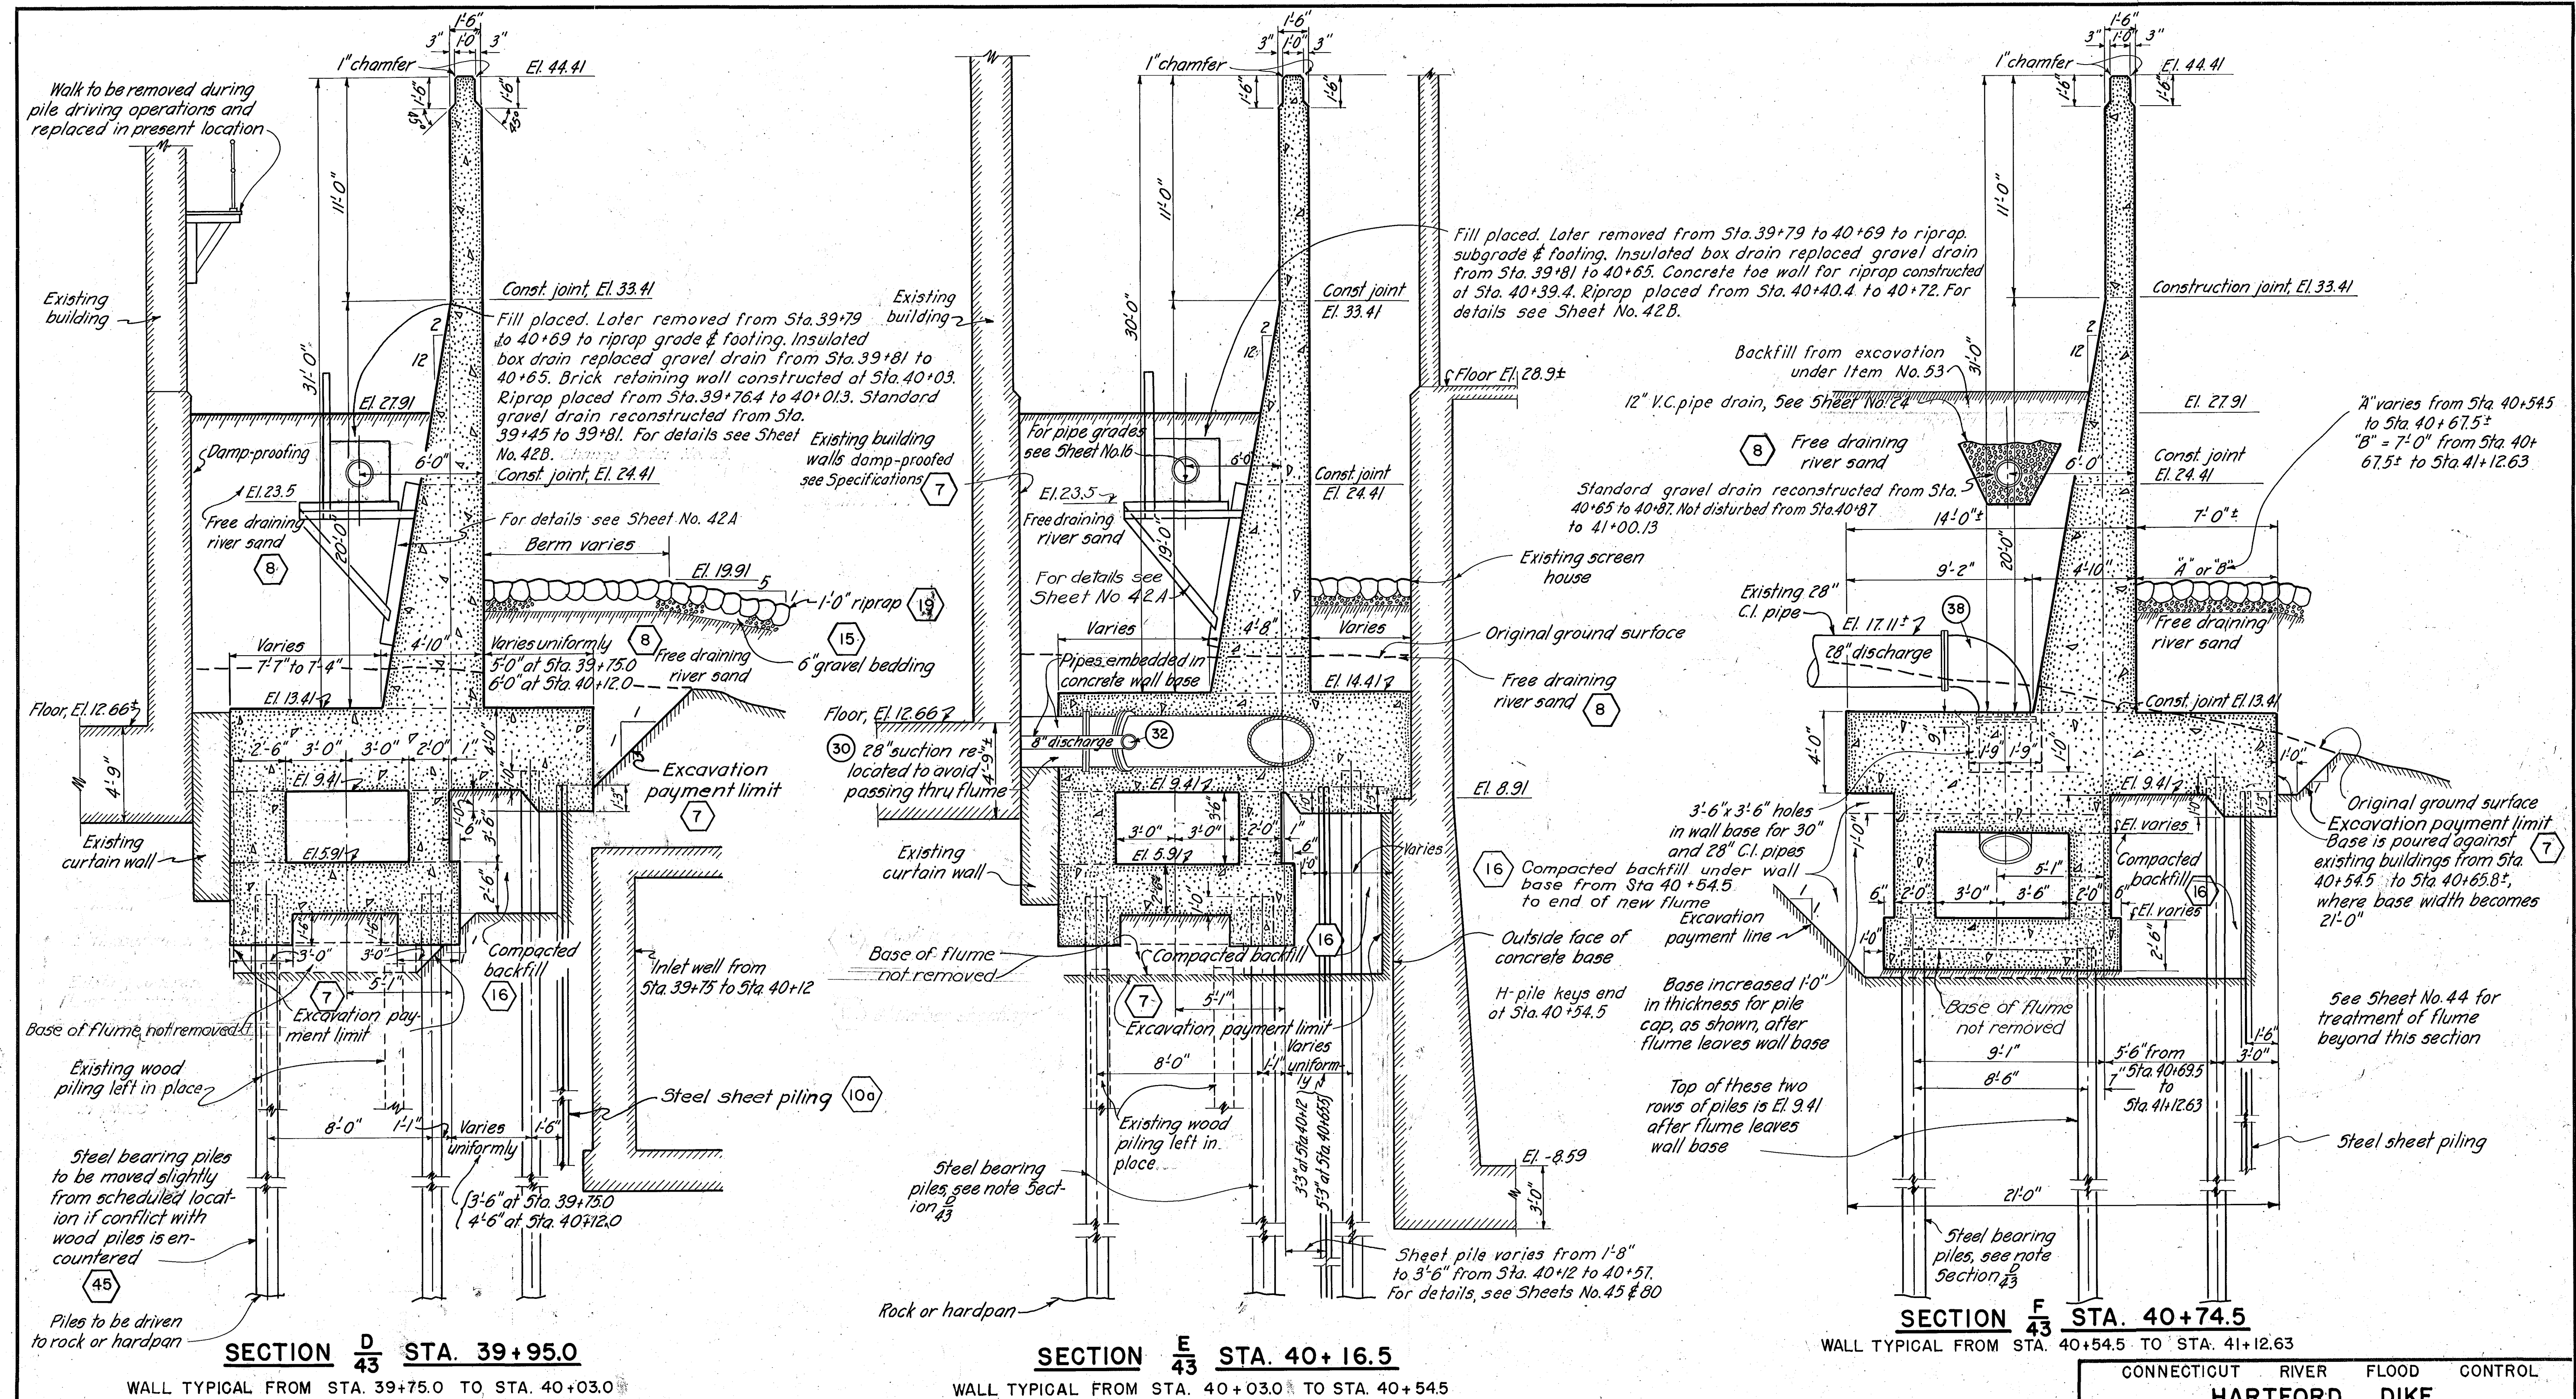

NOTE

For general notes applying to this sheet, see Sheet No. 46

THIS SHEET SUPERSEDES SHEET NO. 47, FILE NO. CT-4-2507

KEY	DATE	REVISION (Indicated by Δ)	REV. BY	CK. BY	AP. BY
	12-31-45	As built revisions			

CONNECTICUT RIVER FLOOD CONTROL
HARTFORD DIKE
RIVERFRONT, MORGAN ST. TO STA. 96+73
CONCRETE WALL DETAILS NO. 2
DUTCH POINT STATION

CONNECTICUT RIVER	CONNECTICUT
IN 135 SHEETS	SHEET NO. 47
SCALE: 1/4" = 1' FT.	
U.S. ENGINEER OFFICE, PROVIDENCE, R.I., JUNE 1941	
SUBMITTED: J. C. Signell	APPROVED: J. C. Signell
DESIGNED: J. C. Signell	TRACED: L. A. O.
ASST. ENGINEER	CHECKED: J. C. Signell
FISCAL YEAR 1940	FILE NO. CT-4-2967