



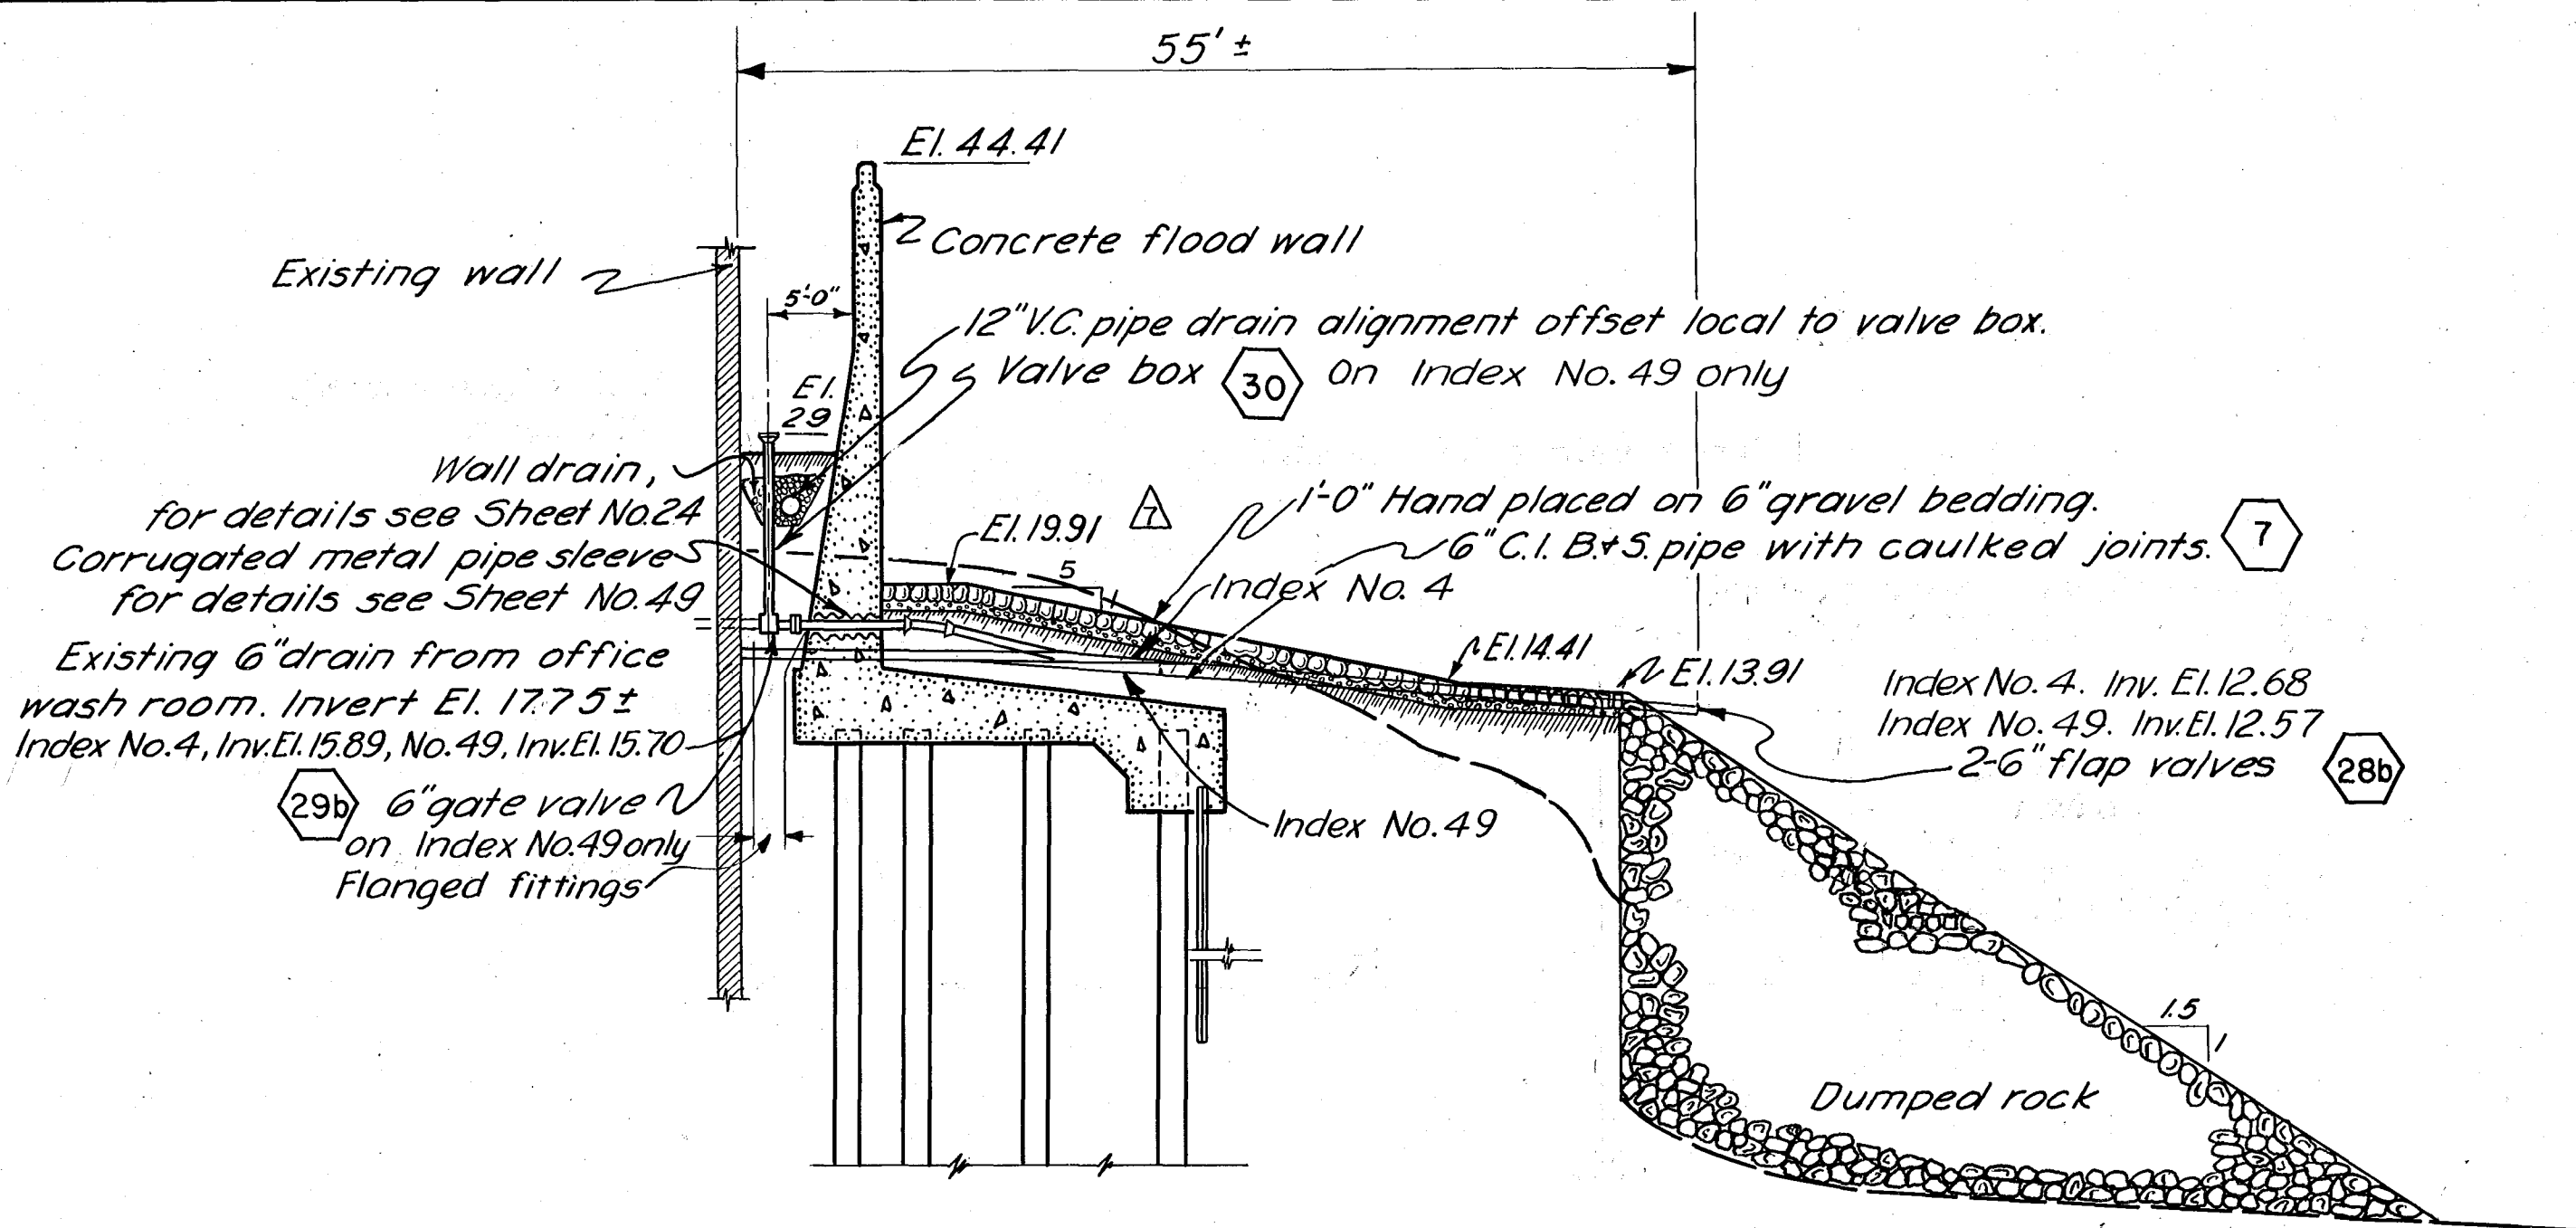


SECTION AT STA. 38+86.0±

SHOWING TREATMENT OF 6" SANITARY SEWER AND 6" AIR WASH DRAIN
INDEX NO. 4 @ STA. 38+89.4 AND NO. 49 AT 38+78.7
SCALE 1"=10'

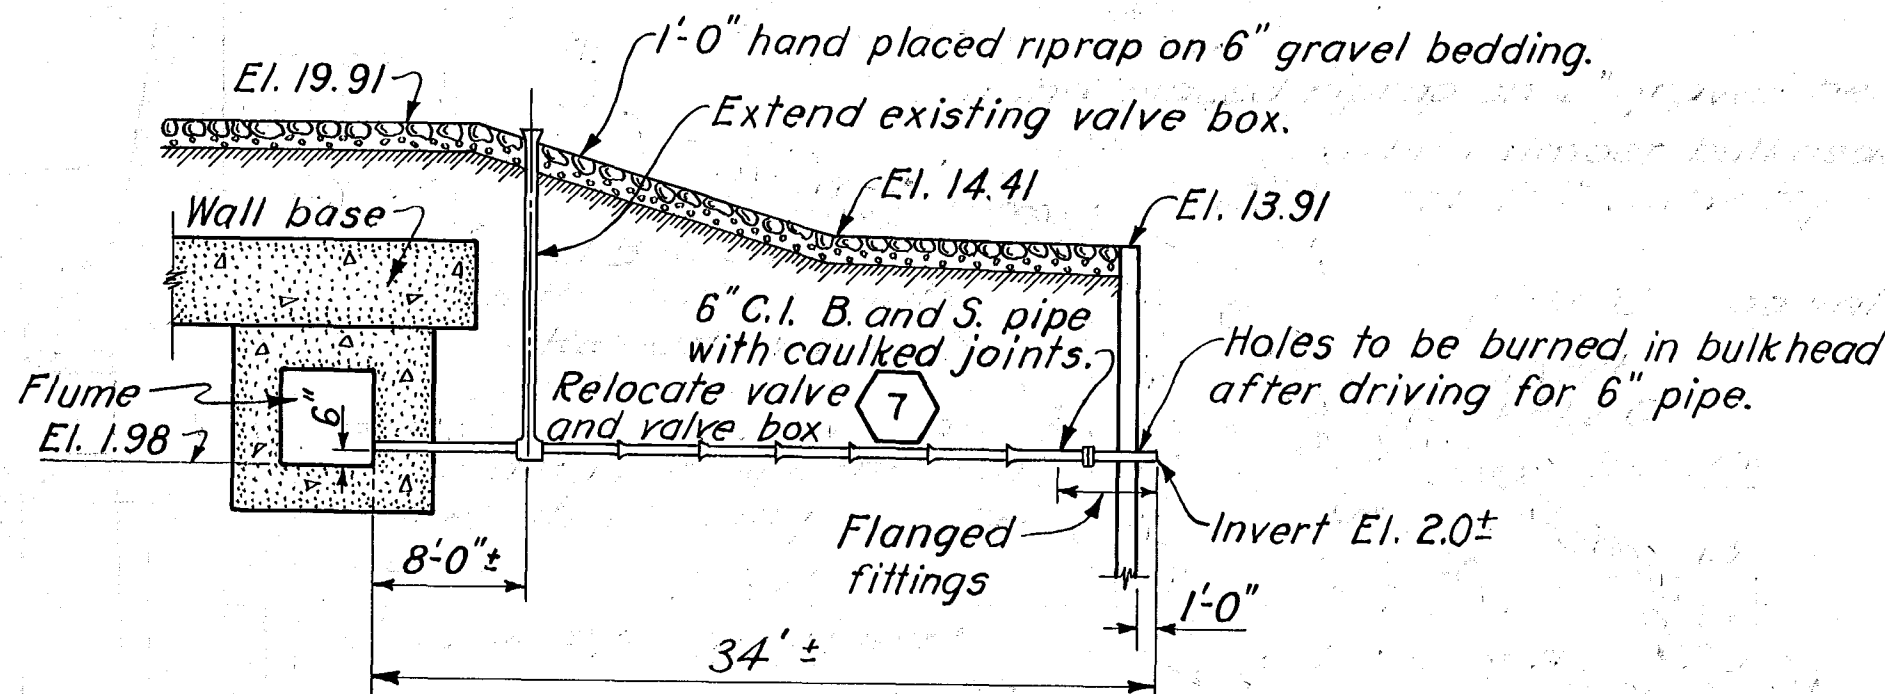


SECTION H 44

SCALE 1"=10'

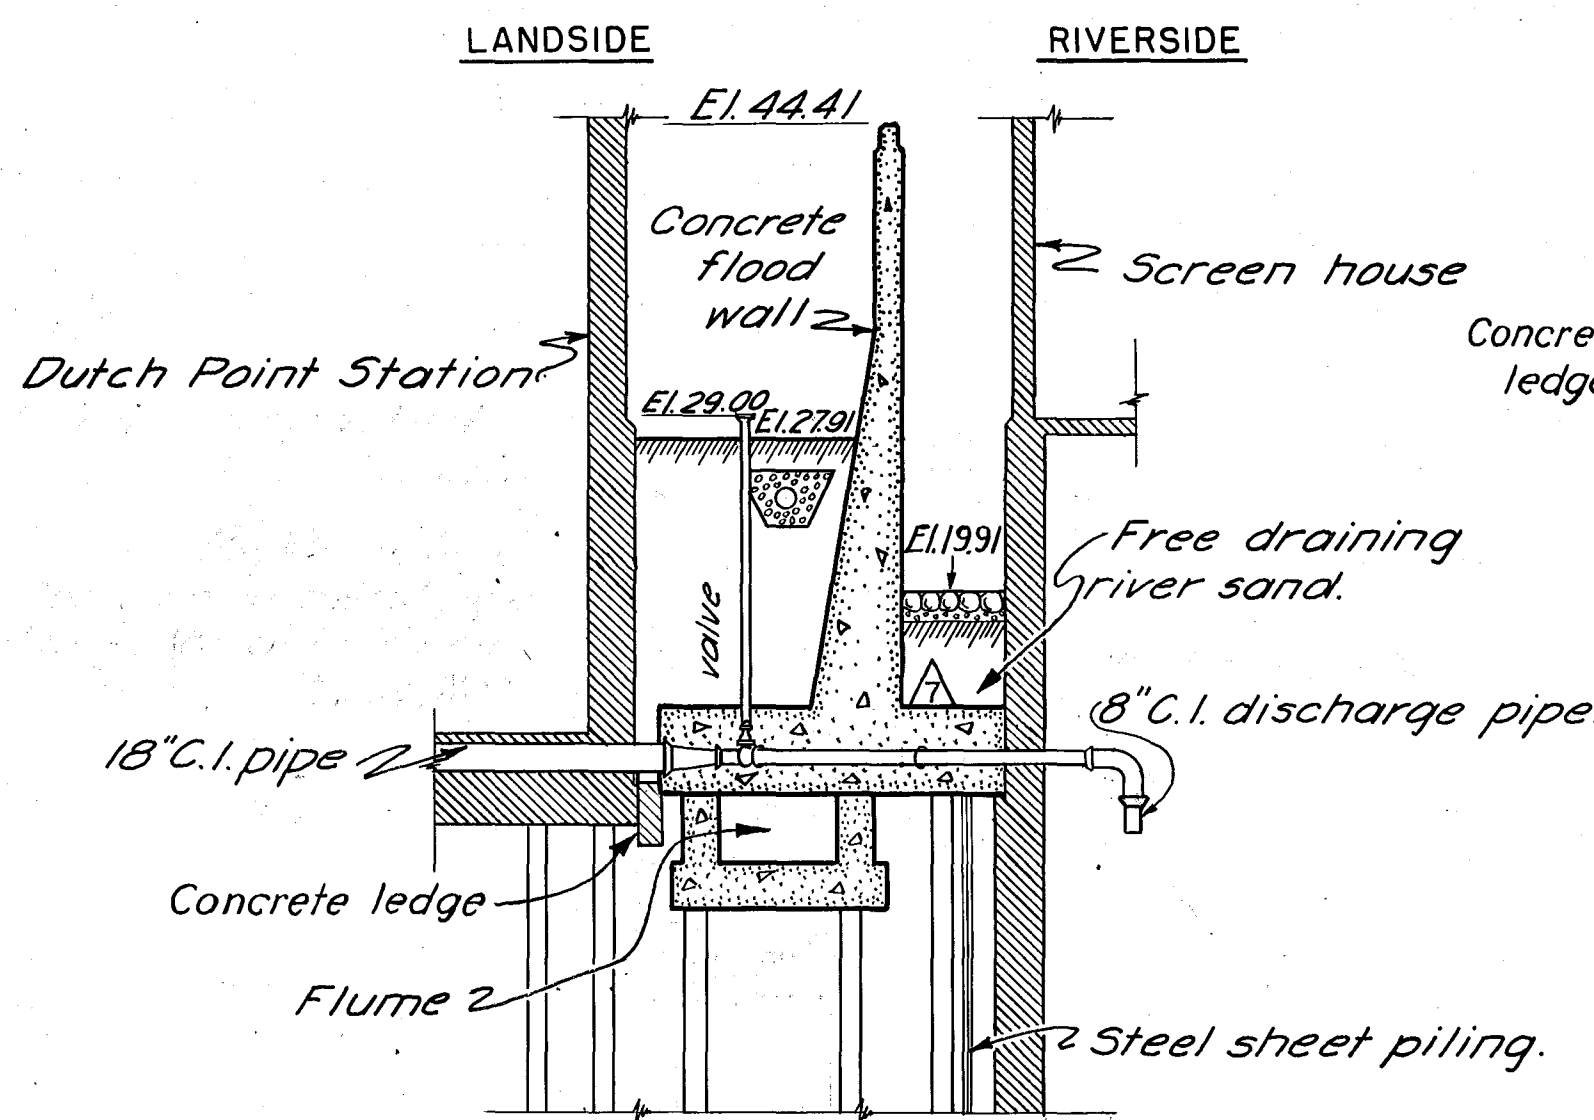



SECTION ALONG 8" DISCHARGE PIPE

STATION 40+20±
INDEX NO. 32
SCALE 1"=10'

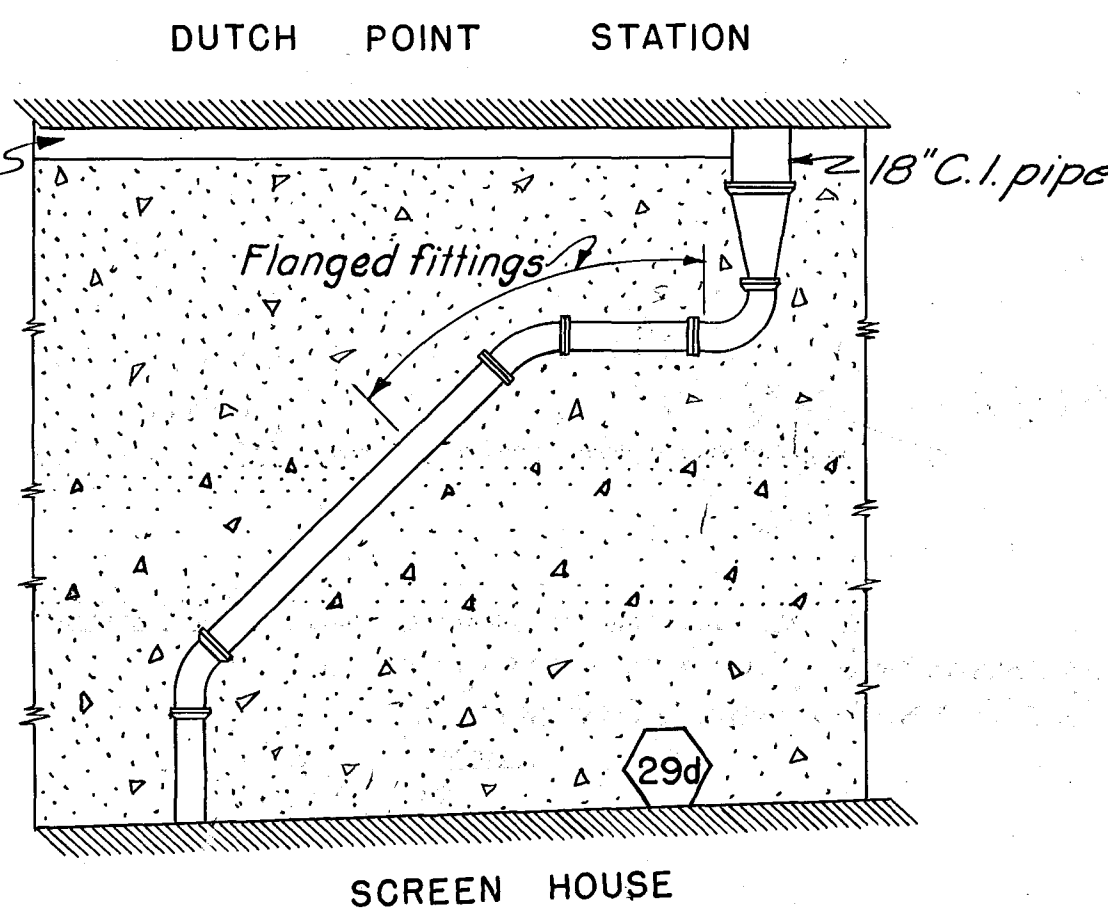

PLAN OF 8" DISCHARGE PIPE

INDEX NO. 32
SCALE 3/16" = 1'-0"

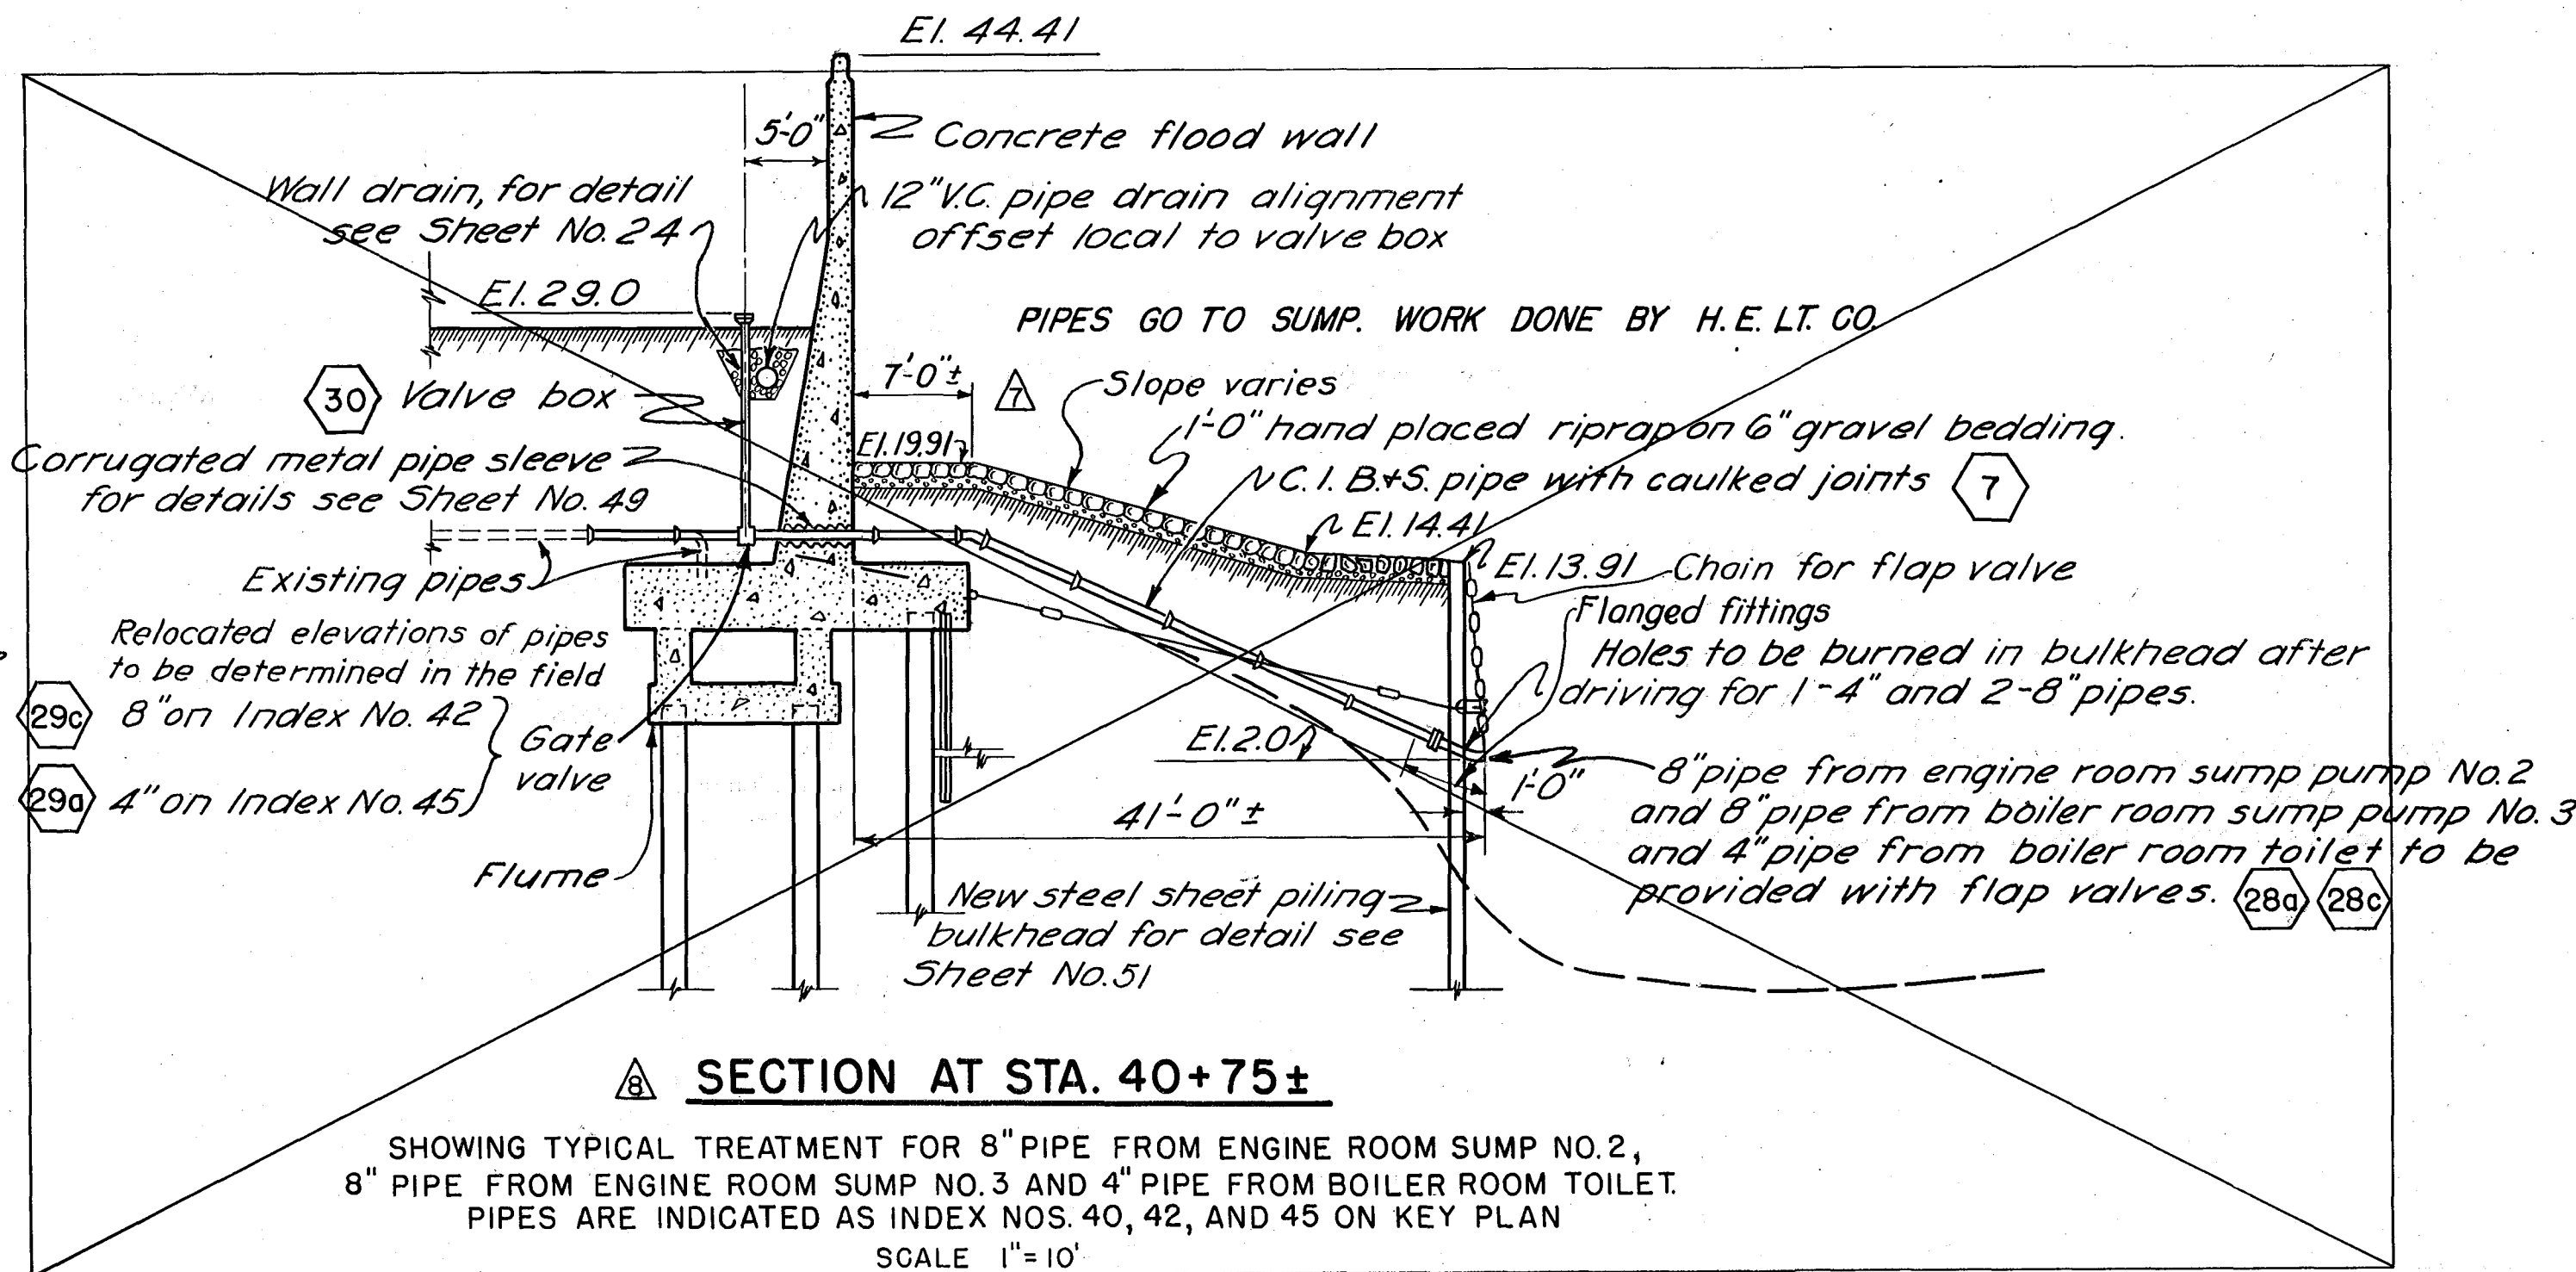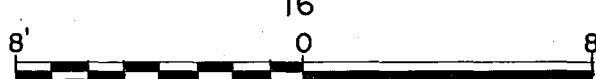

SECTION AT STA. 40+75±

SHOWING TYPICAL TREATMENT FOR 8" PIPE FROM ENGINE ROOM SUMP NO. 2,
8" PIPE FROM ENGINE ROOM SUMP NO. 3 AND 4" PIPE FROM BOILER ROOM TOILET.
PIPES ARE INDICATED AS INDEX NOS. 40, 42, AND 45 ON KEY PLAN
SCALE 1"=10'

NOTES

All elevations refer to Mean Sea Level Datum.
For key plan of existing structures and pipes see Sheet No. 42.
For details of concrete walls see Sheets No. 46 and 47.
For details of bank treatment see Sheets No. 16+43.
For key to Index Nos. see Sheet No. 42.
Valve box assemblies to be Clow-National A 1536 with lock cover A-1544 or equal.

KEY	DATE	REVISION (Indicated by Δ)	REV. BY	CK. BY	AP. BY
Δ	12-31-45	As built revisions			
Δ	6/5/41	Position of Flume changed.	W.D.C.	W.D.C.	W.D.C.
Δ	3/10/41	Riverside fill revised.	W.D.C.	W.D.C.	W.D.C.

CONNECTICUT RIVER FLOOD CONTROL		
HARTFORD DIKE		
RIVERFRONT, MORGAN ST. TO STA. 96+73		
MISCELLANEOUS DETAILS NO. 1.		
DRAIN THROUGH WALL		
CONNECTICUT RIVER	CONNECTICUT	
IN 135 SHEETS	SCALE 1 IN. = 10 FT.	SHEET NO. 50
U. S. ENGINEER OFFICE, PROVIDENCE, R. I., MAY 1940		
SUBMITTED:	APPROVAL RECOMMENDED:	APPROVED:
DESIGNED:	DRAWN:	FISCAL YEAR 1940
CHECKED:	CHECKED:	FILE NO. CT-4-2510