



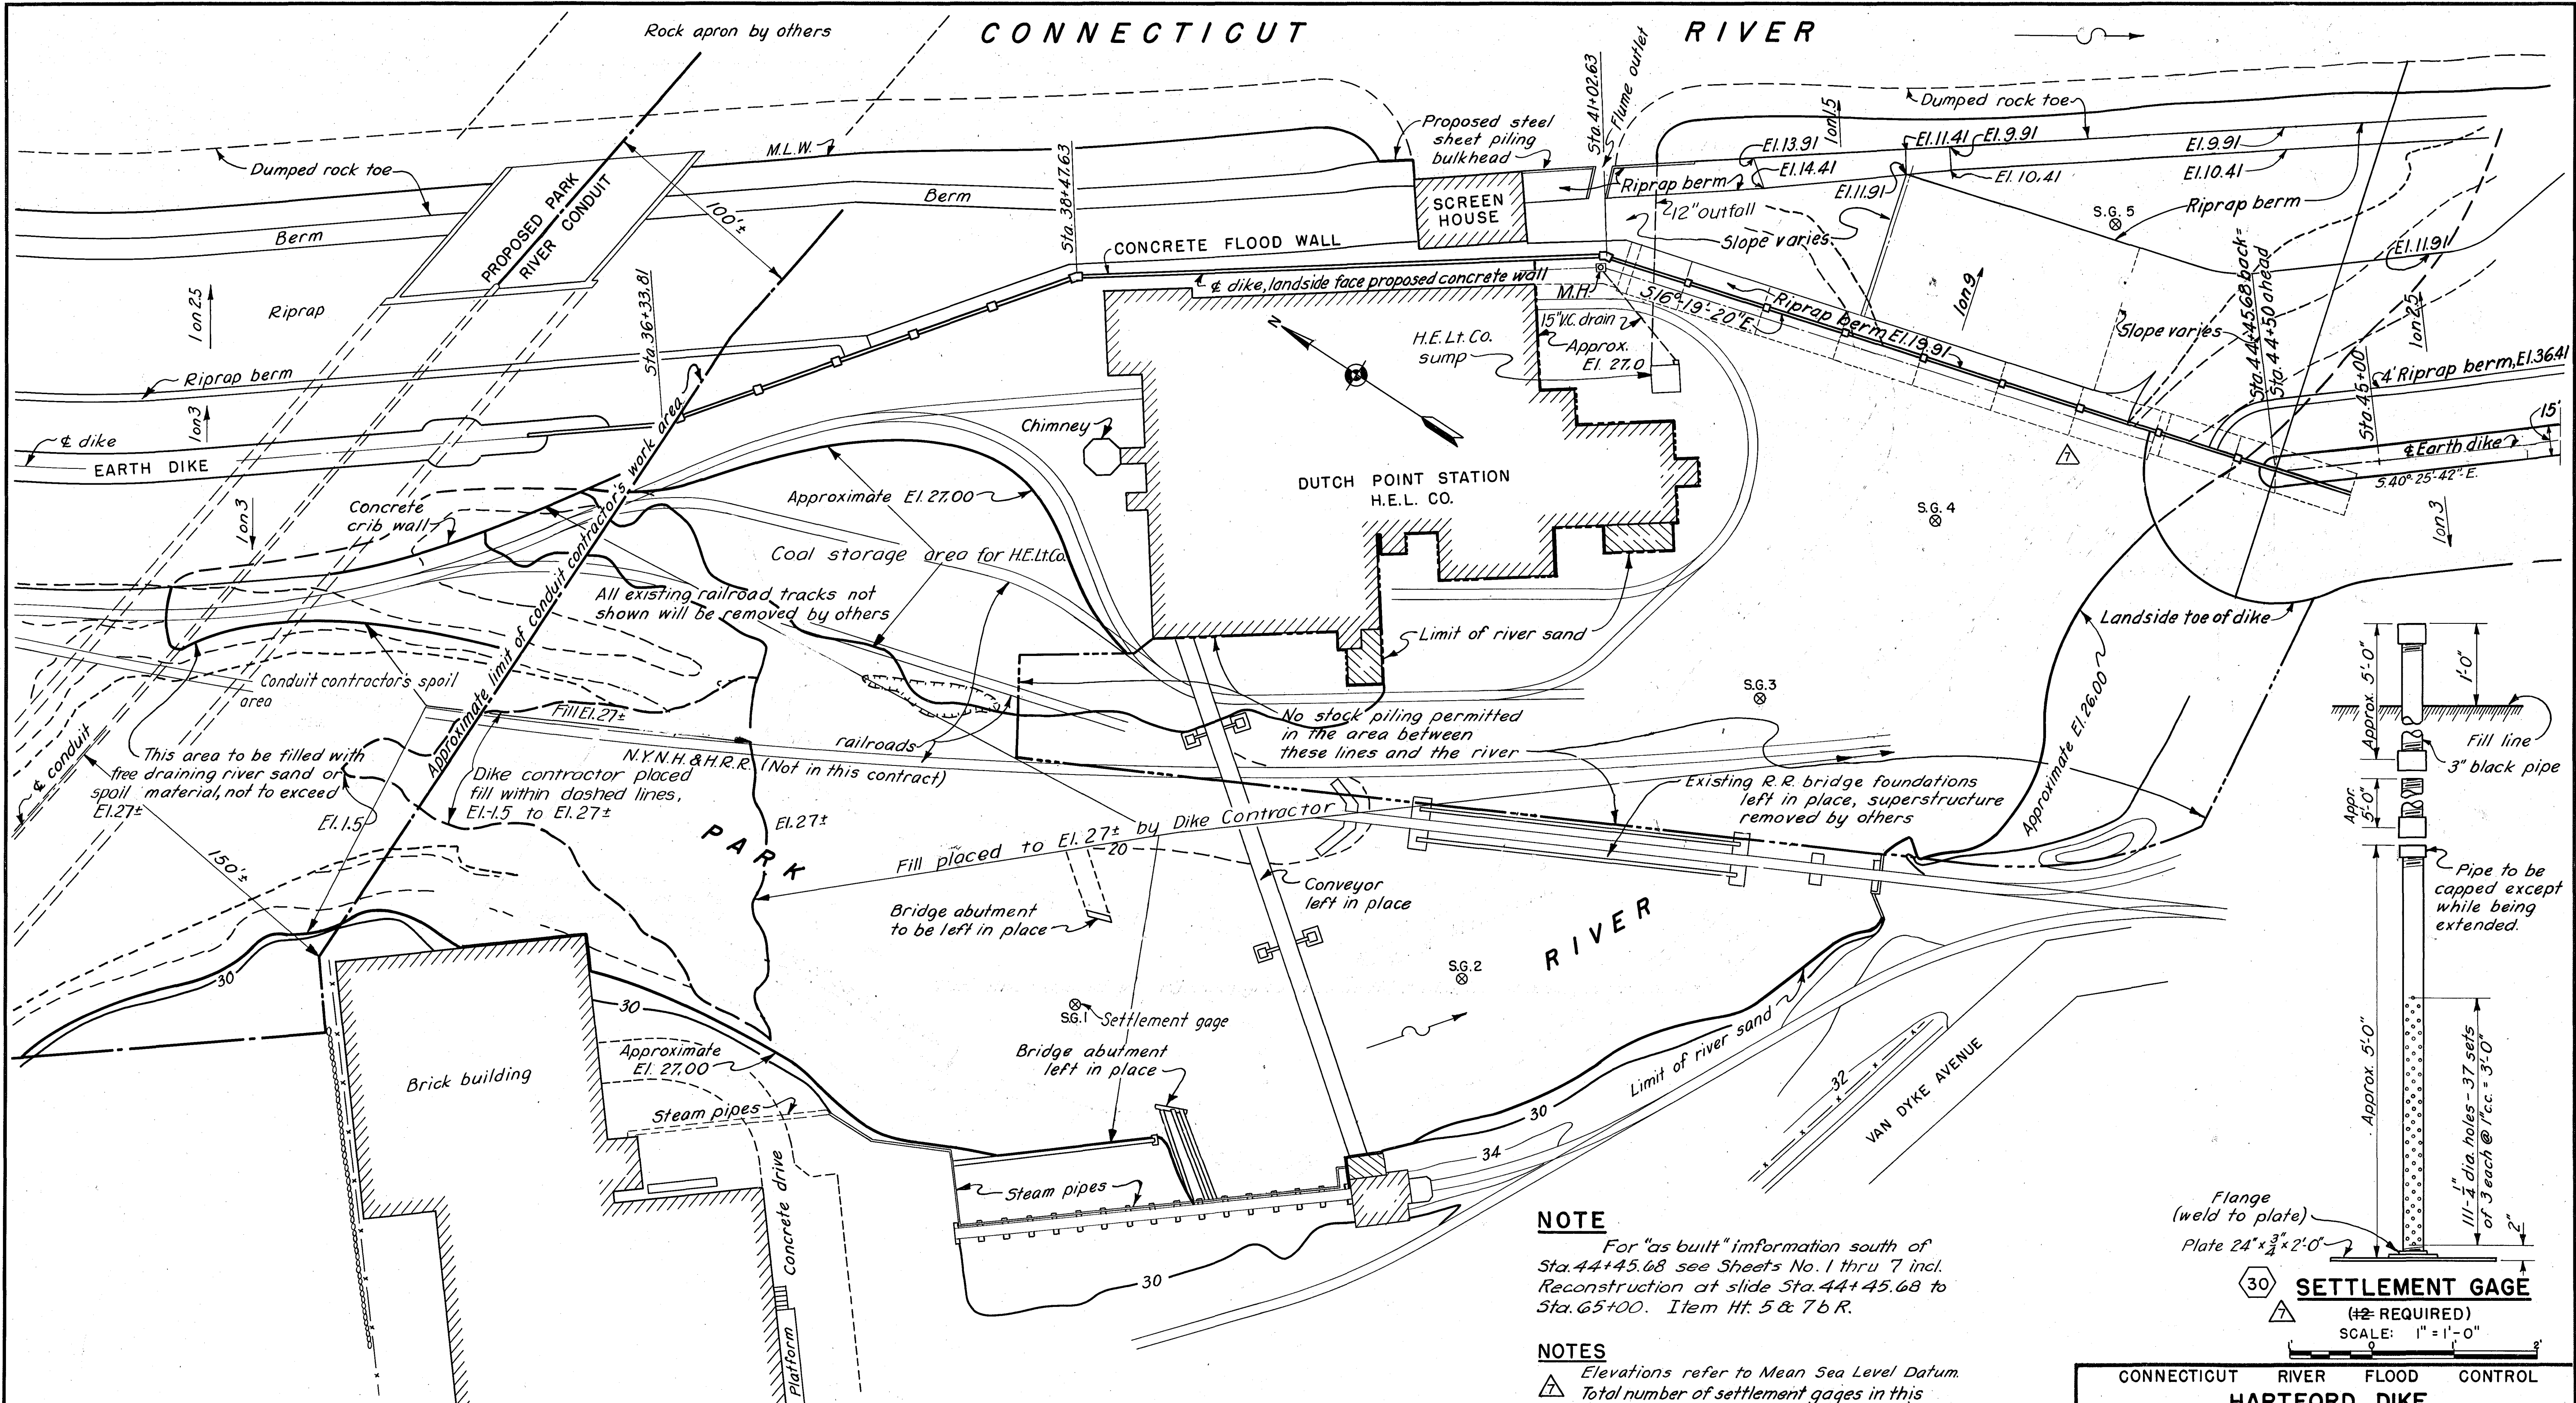

PLAN
SCALE: 1" = 40'

NOTE
For "as built" information south of Sta. 44+45.68 see Sheets No. 1 thru 7 incl. Reconstruction at slide Sta. 44+45.68 to Sta. 65+00. Item Ht. 5 & 7 b R.

NOTES
Elevations refer to Mean Sea Level Datum.
Total number of settlement gages in this area, 6; approximate locations marked S.G.

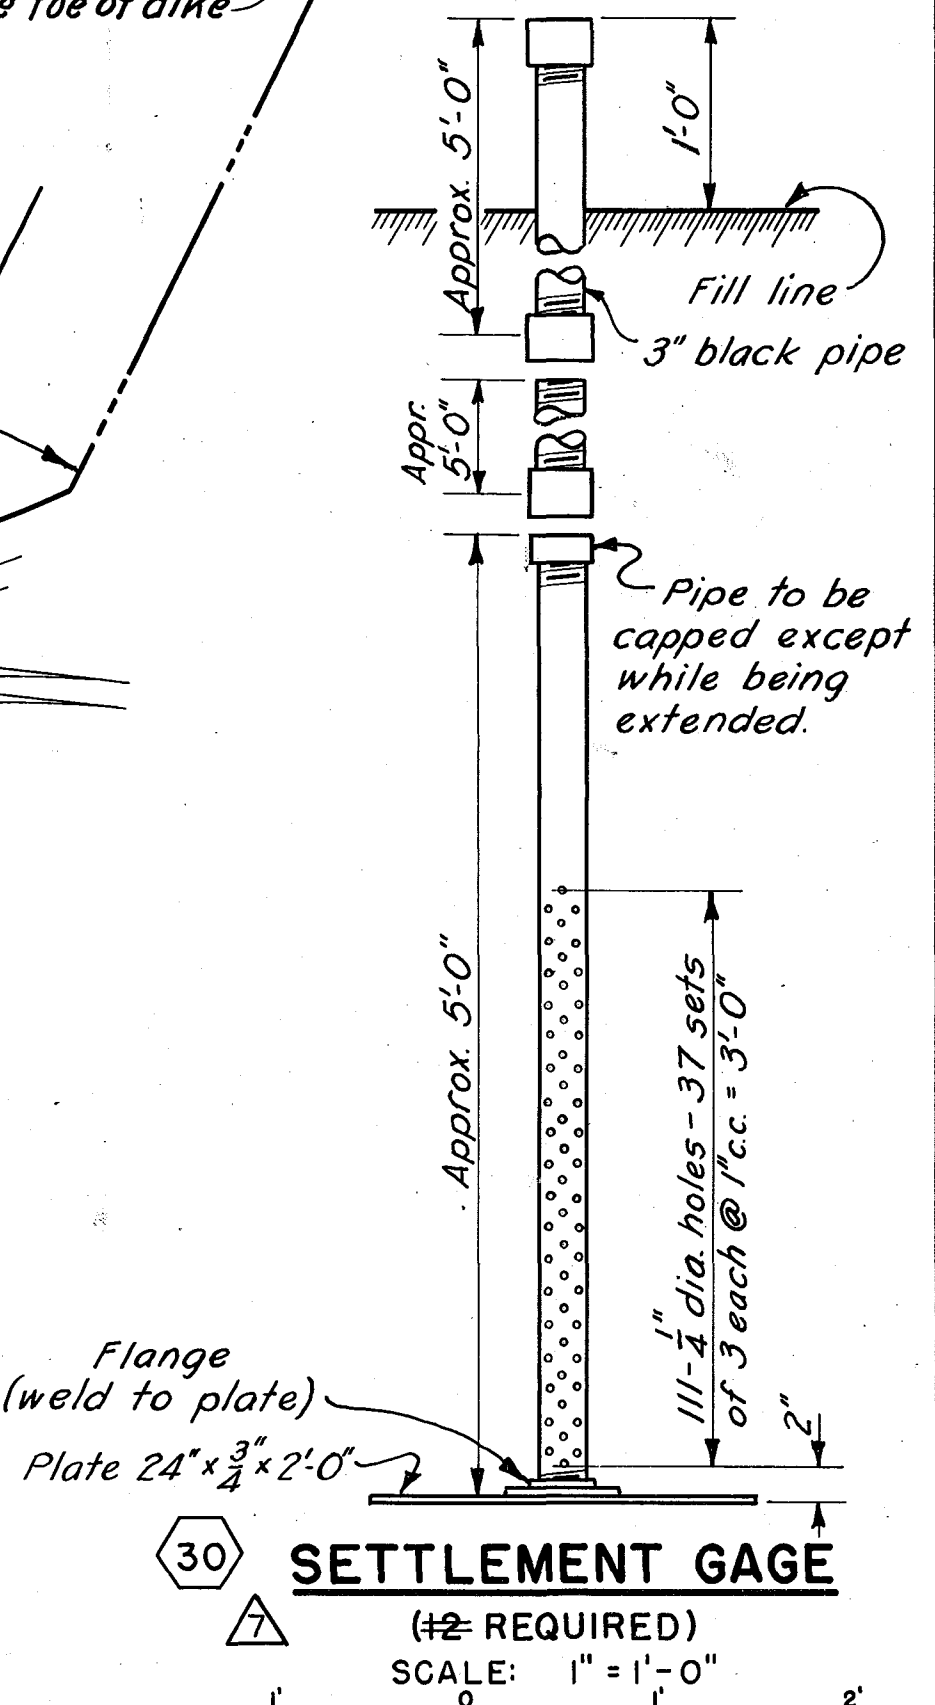

KEY	DATE	REVISION (Indicated by Δ)	REV. BY	CK. BY	AP. BY
Δ	12-31-45	As built revisions			
Δ	3-10-41	Wall extended - Gages removed.	WAG	1831	2804

CONNECTICUT RIVER FLOOD CONTROL	
HARTFORD DIKE	
RIVERFRONT, MORGAN ST. TO STA. 96+73	
FOUNDATION TREATMENT PLAN	
PARK RIVER	
CONNECTICUT RIVER	CONNECTICUT
IN 135 SHEETS	SHEET NO. 52
SCALE: 1 IN. = 40 FT.	
U. S. ENGINEER OFFICE, PROVIDENCE, R.I., MAY 1940	
SUBMITTED: <i>W. B. Wilson</i>	APPROVED: <i>W. B. Wilson</i>
SENIOR ENGINEER	PRINCIPAL ENGINEER
HEAD, DESIGN SECTION	CHIEF, F.O. ENGINEERING DIV.
DESIGNED: <i>W. B. Wilson</i>	DRAWN: P.D.M. & D.W.C.
ASSOC. ENGINEER	TRACED: K.H.W.
	CHECKED: WAG
	FISCAL YEAR 1940
	FILE NO. CT-4-2512