




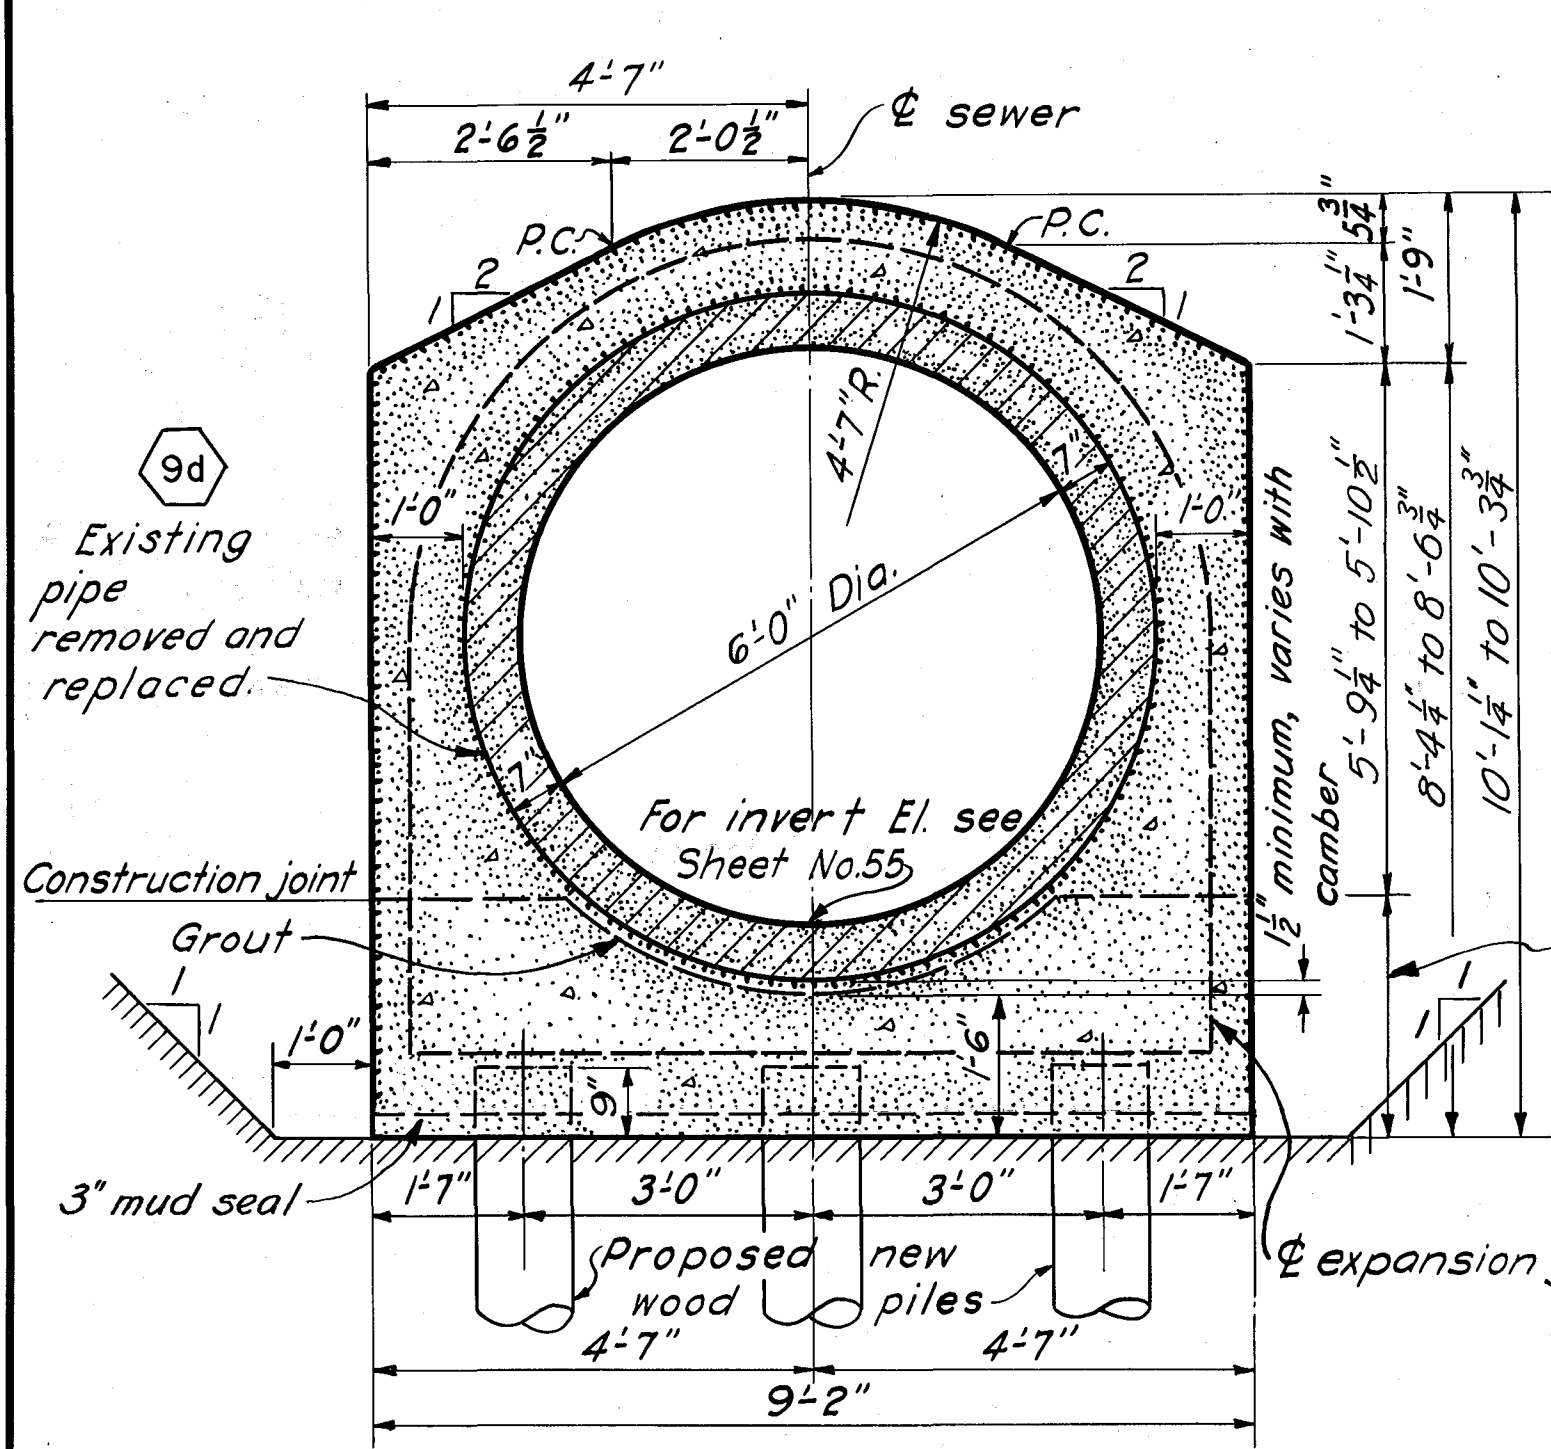


SECTION A-55
TYPICAL BETWEEN STA. 1+96.35 AND STA. 2+66.0
SCALE: 1/2" = 1'-0"

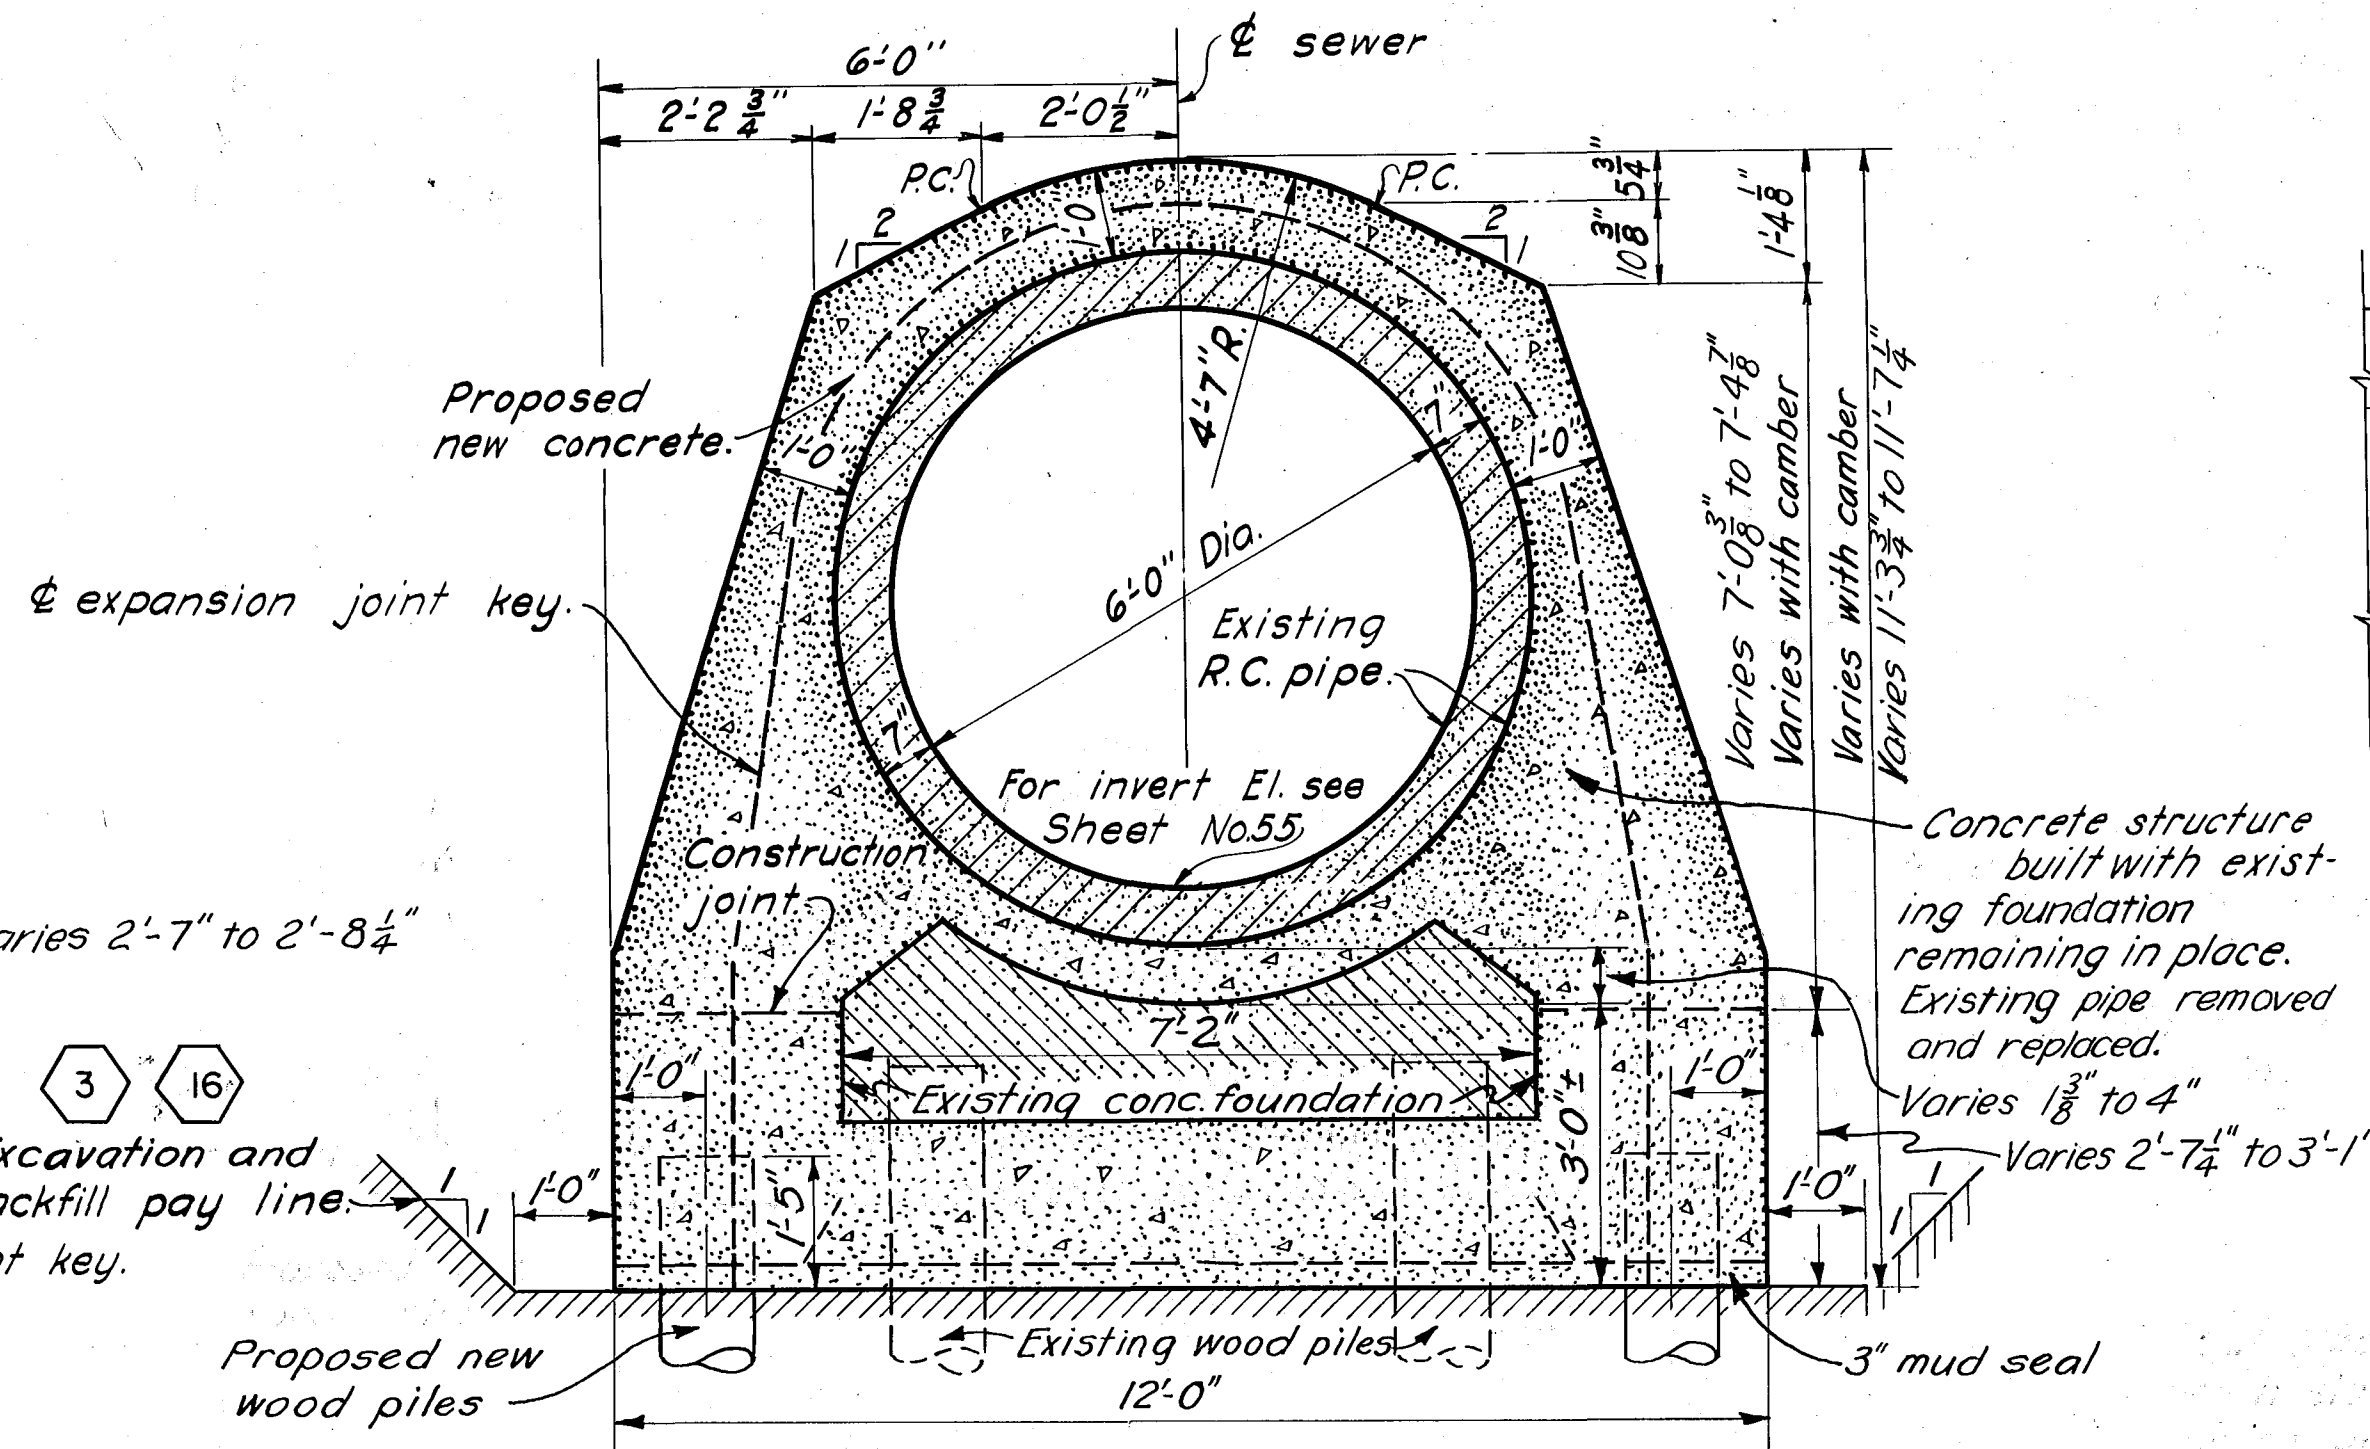

SECTION B-55
TYPICAL BETWEEN STA. 1+71.70 AND STA. 1+96.35
SCALE: 1/2" = 1'-0"

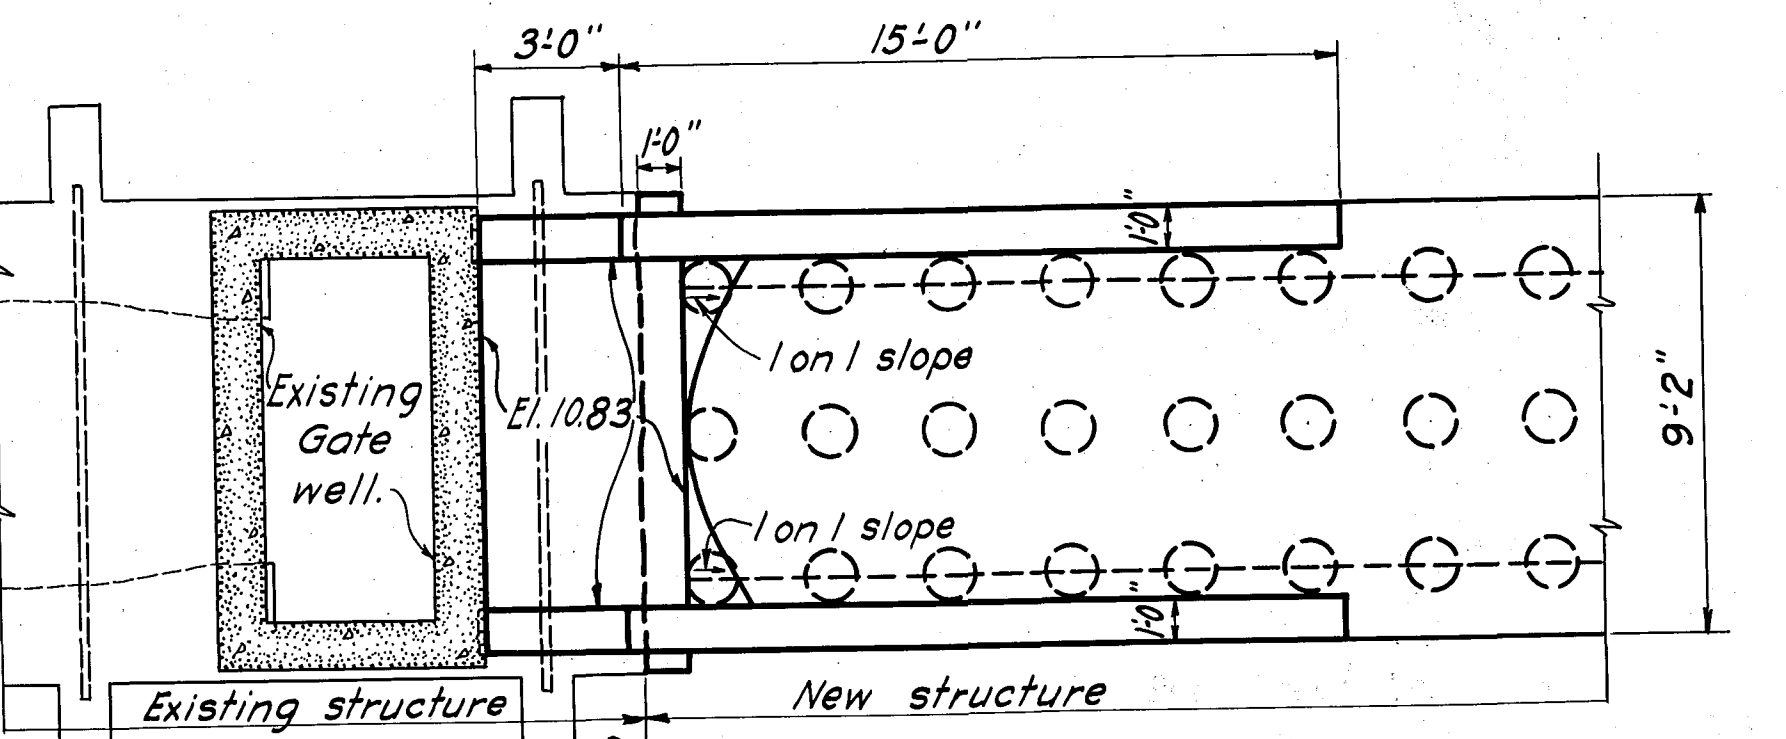

PLAN

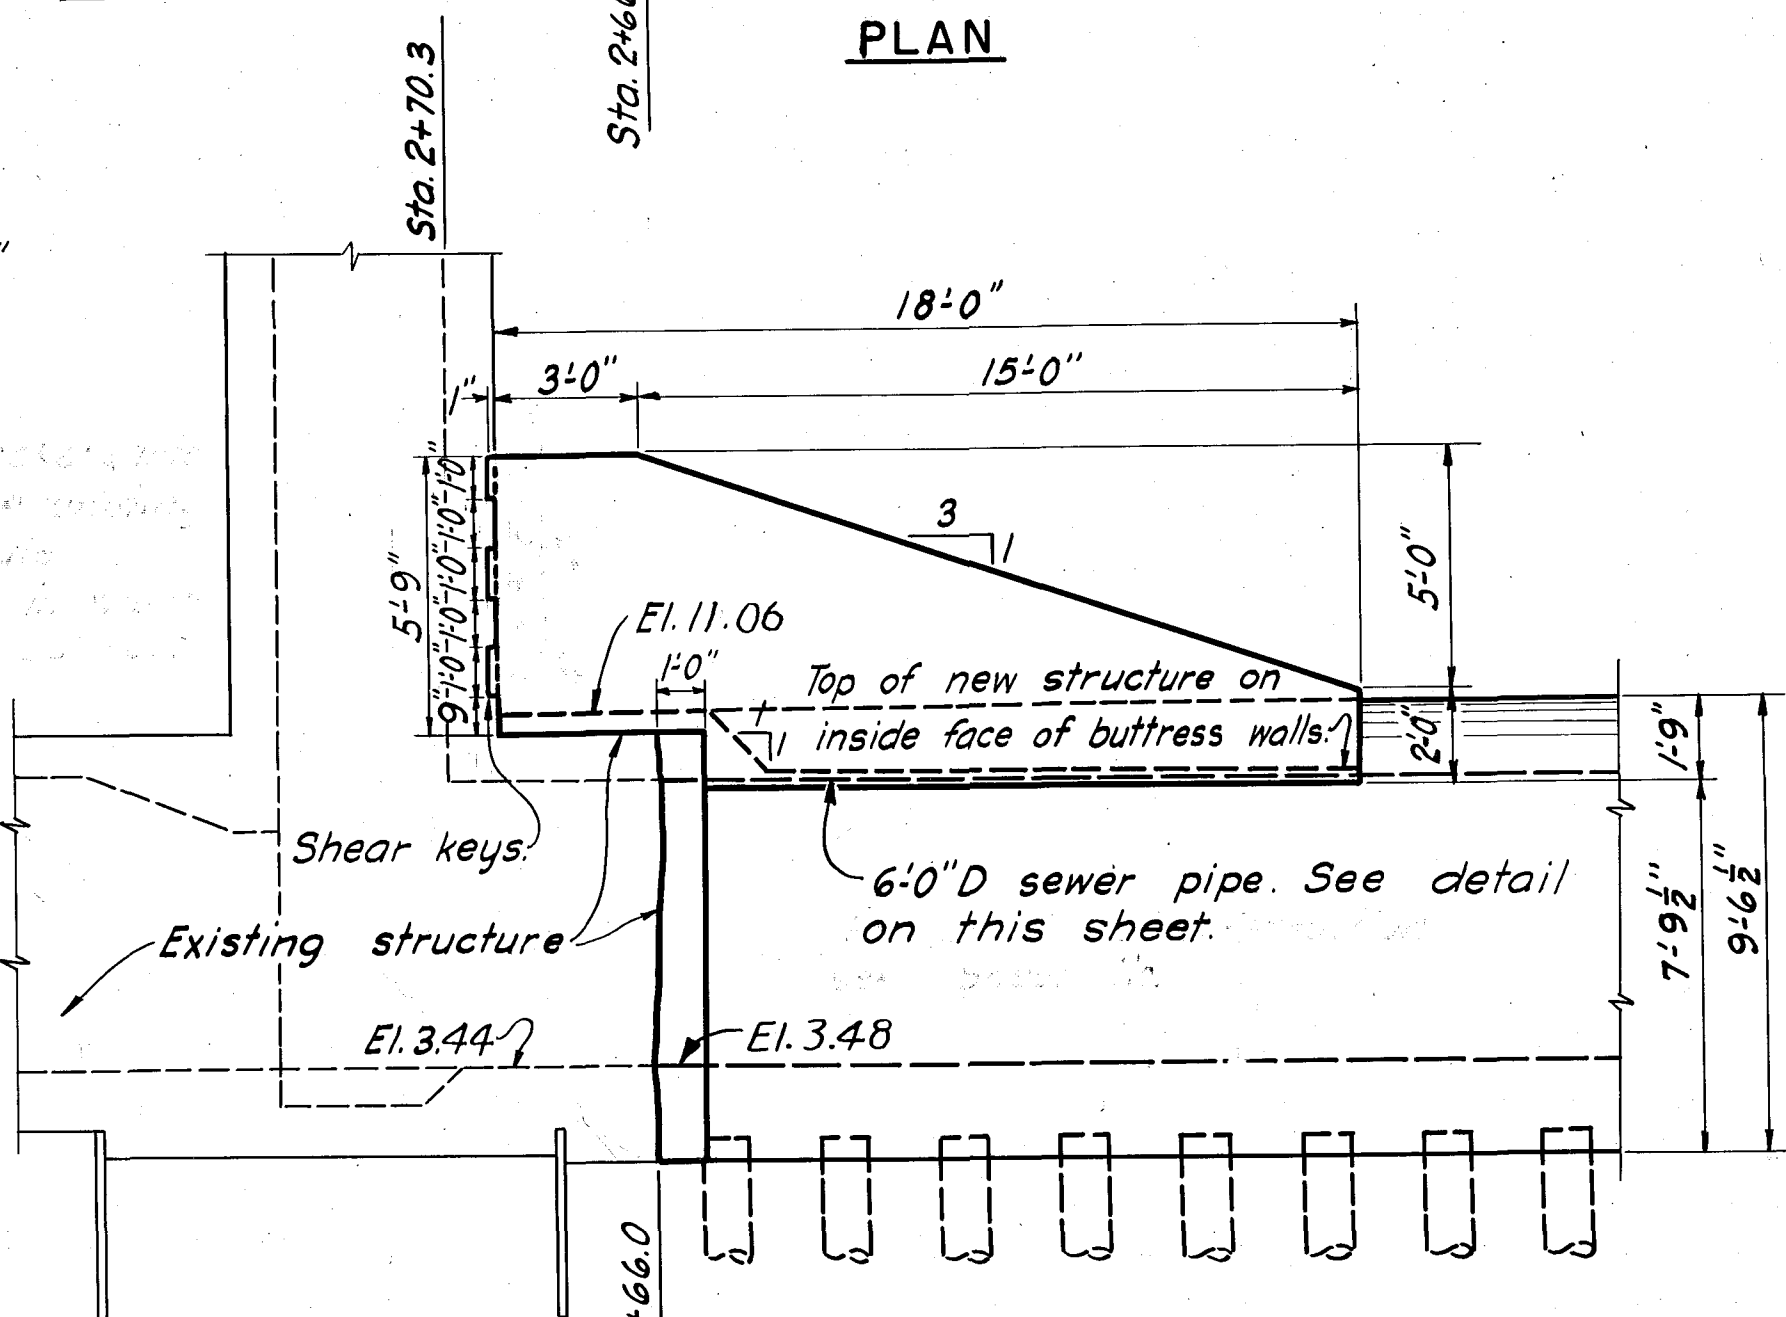

ELEVATION

BUTRESS WALLS DETAILS

SCALE: 1/4" = 1'-0"


NOTES

For general notes applying to this sheet see Sheet No. 55.
For details of steel reinforcement see Sheets No. 110 and 111.
All concrete to be Class "A" concrete.

NOTE


For "as built" information covering Section B see Sheet No. 3 of Supplemental Agreement; Reconstruction of Massee St. Sewer, Item Ht. 58-76R, Detail of Massee Conduit.

CONNECTICUT RIVER FLOOD CONTROL			
HARTFORD DIKE			
RIVERFRONT, MORGAN ST. TO STA. 96+73			
CONDUIT DETAILS			
MASSEK STREET			
CONNECTICUT RIVER	SCALE: 1/4" = 1'-0"	CONNECTICUT	SHEET NO. 56
U.S. ENGINEER OFFICE, PROVIDENCE, R.I., MAY 1940			
SUBMITTED:	APPROVED:	RECOMMENDED:	APPROVED:
11/15/40	11/15/40	11/15/40	11/15/40
10/31/40	10/31/40	10/31/40	10/31/40
KEY	DATE	REVISION (Indicated by Δ)	REV. BY CK. BY AP. BY

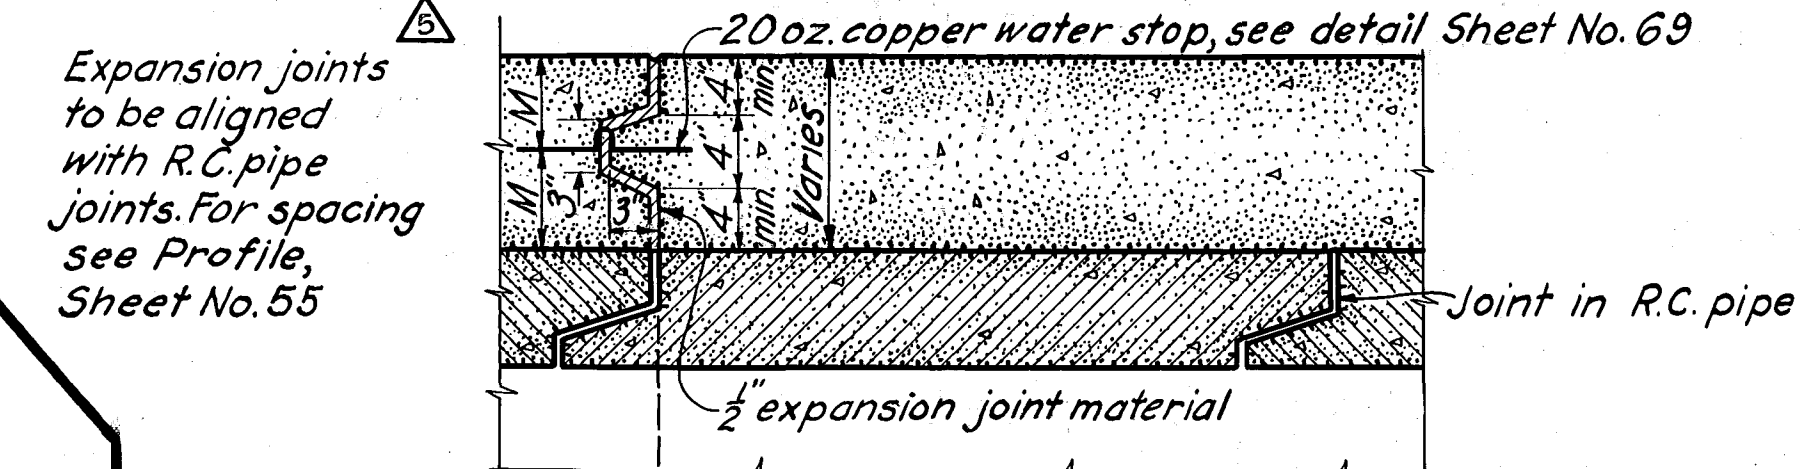


DETAIL OF EXPANSION JOINT

SCALE: 1" = 1'-0"

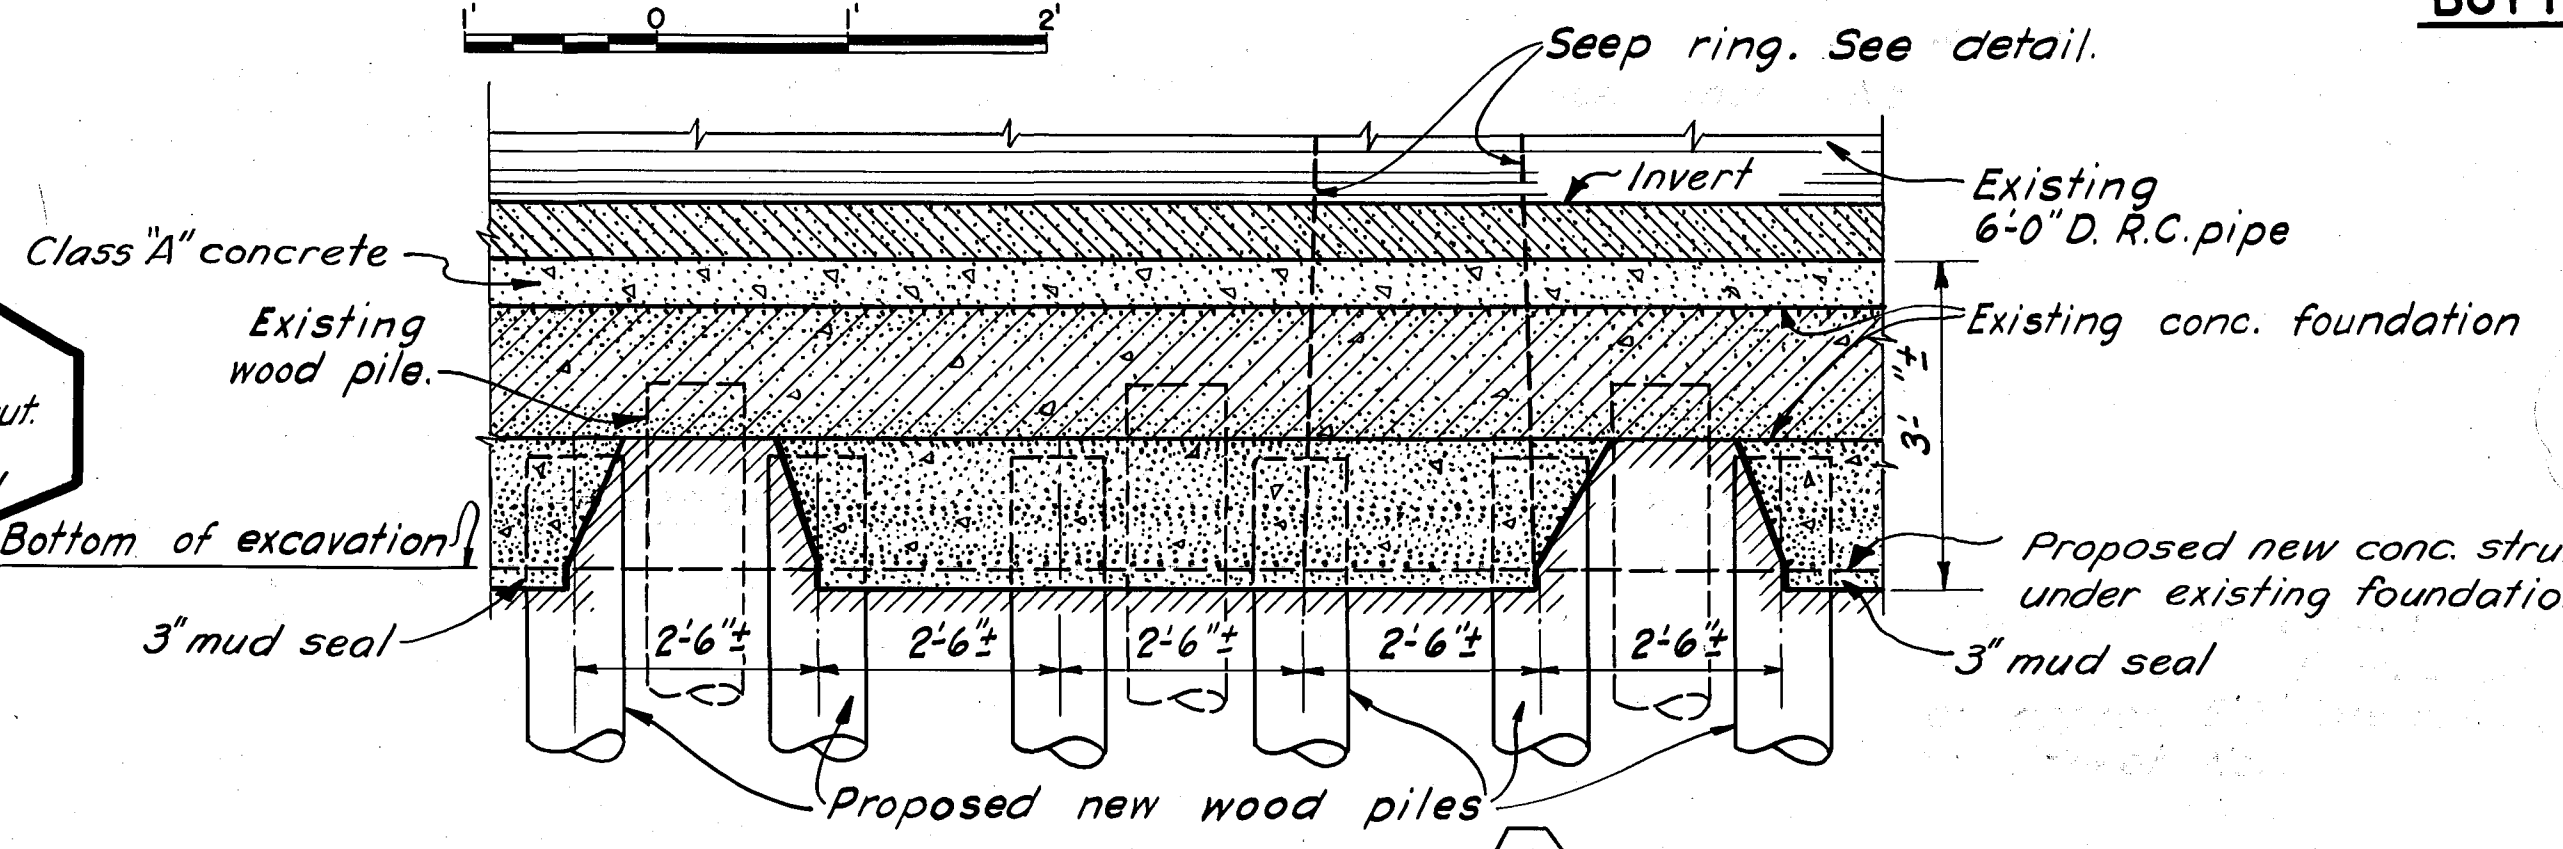

PART OF PROFILE ENLARGED

TYPICAL BETWEEN STA. 1+71.70 AND STA. 1+96.0
SCALE: 1/2" = 1'-0"

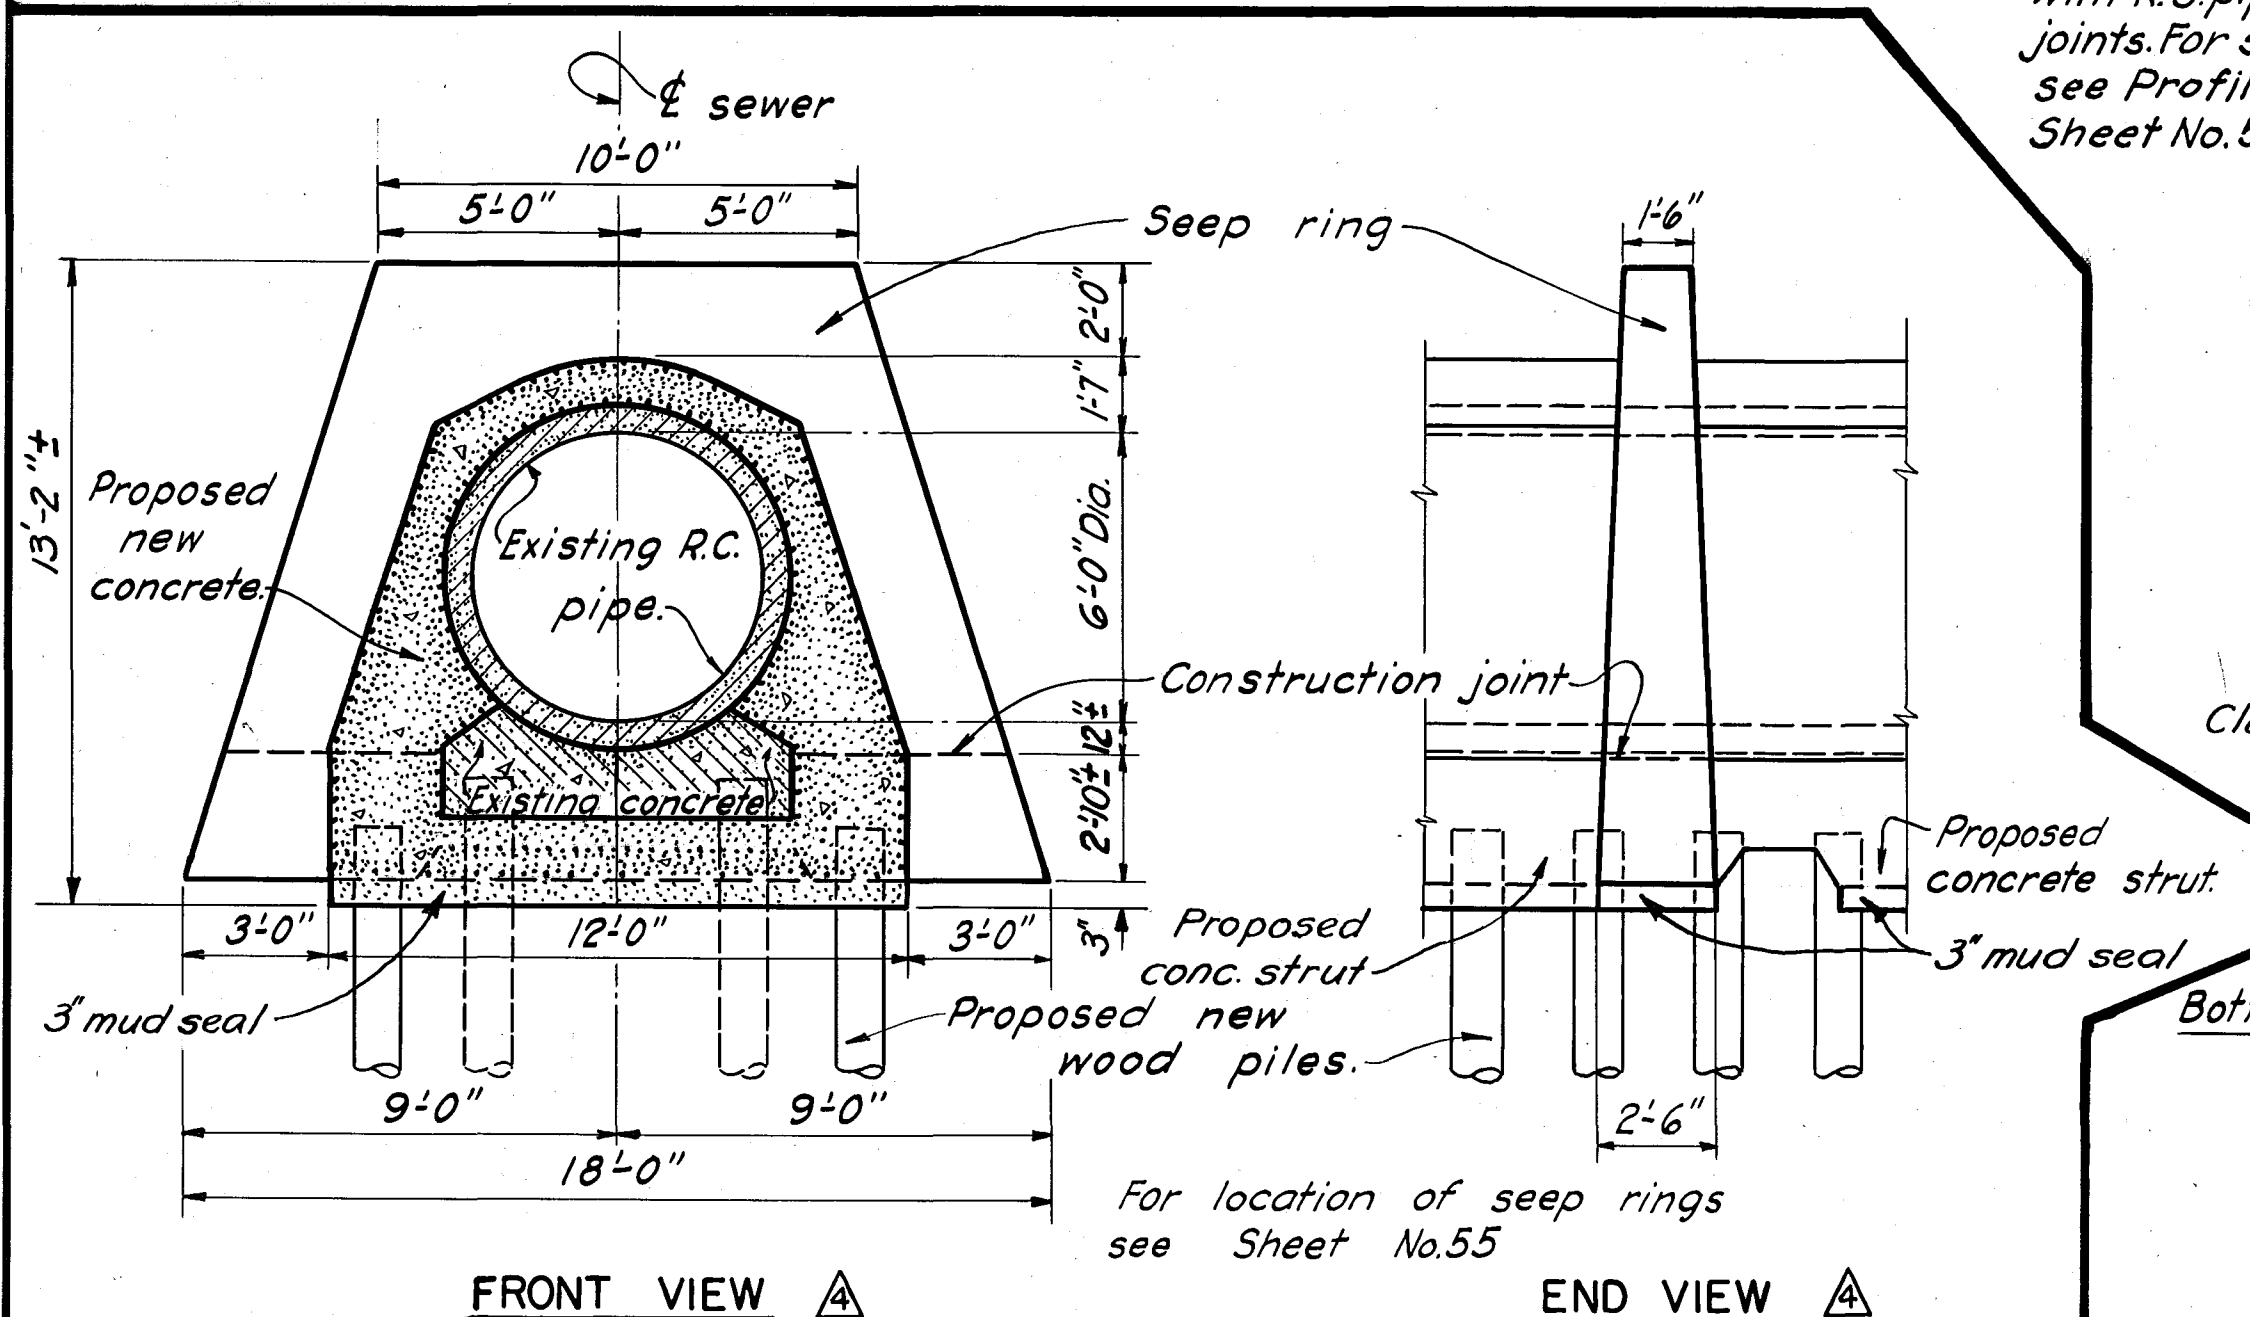

FRONT VIEW

END VIEW

SEEP RING DETAILS

SCALE: 1/4" = 1'-0"

FOR DETAILS USED, SEE RECONSTRUCTION OF MASSEK ST. SEWER, SHEET NO. 6, FILE NO. CT-4-3130.