
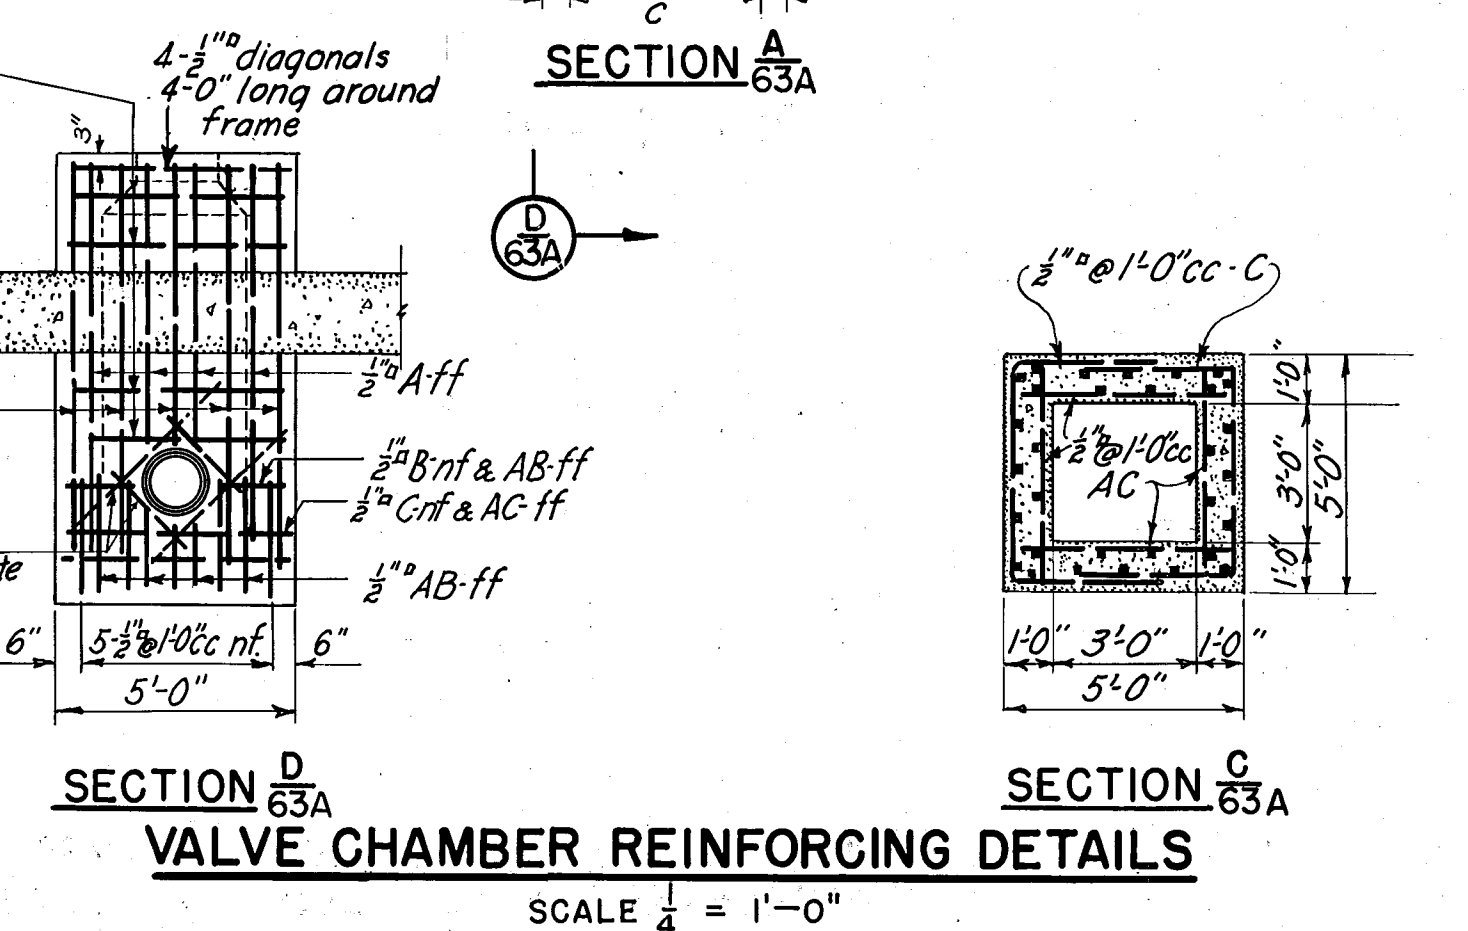
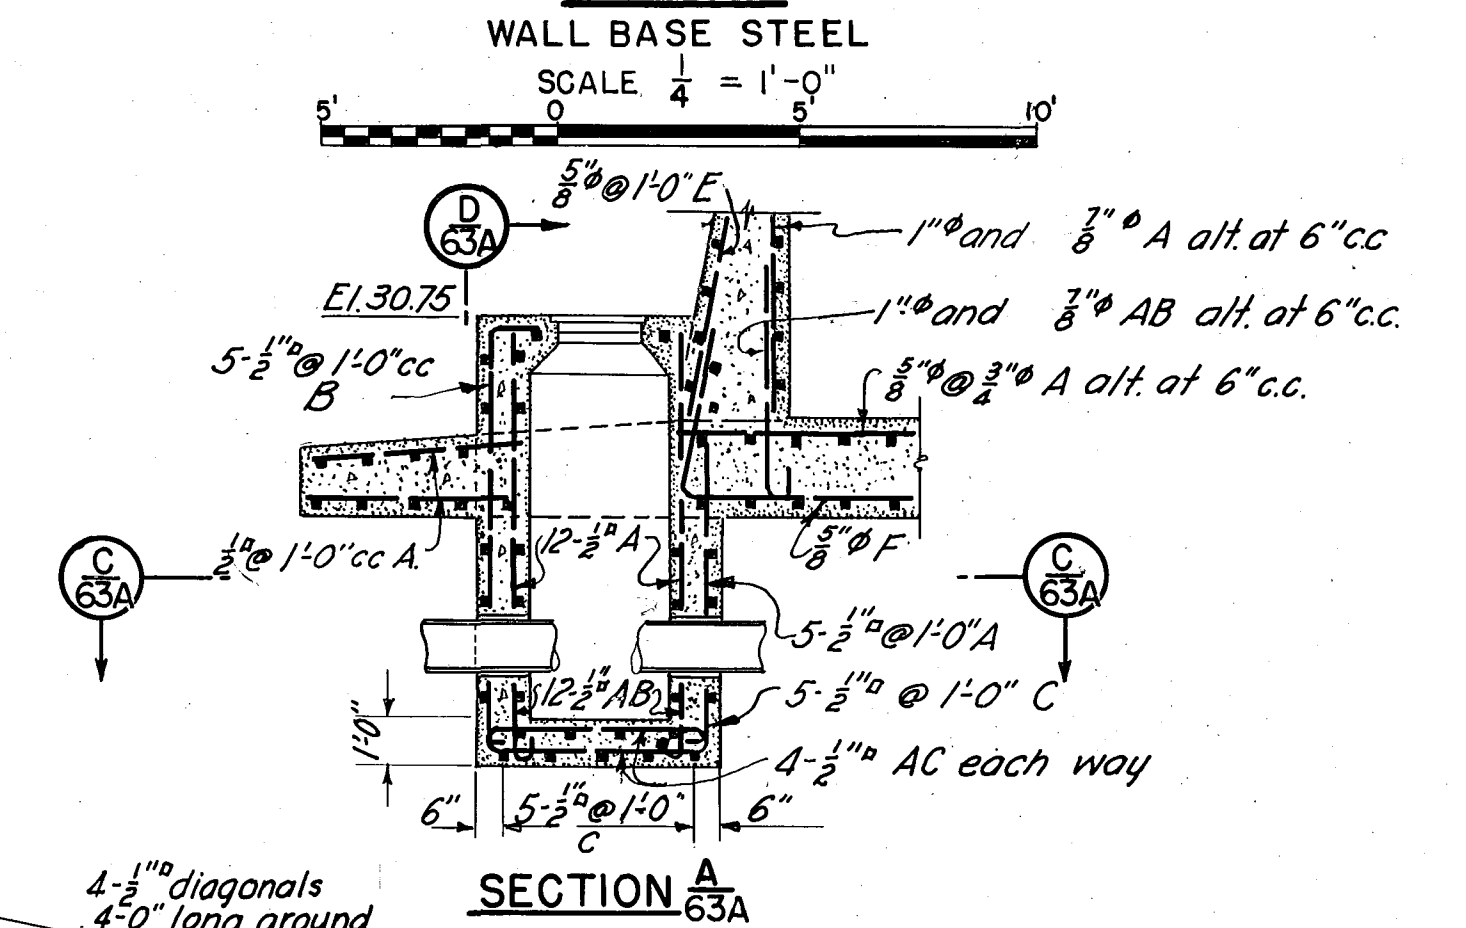


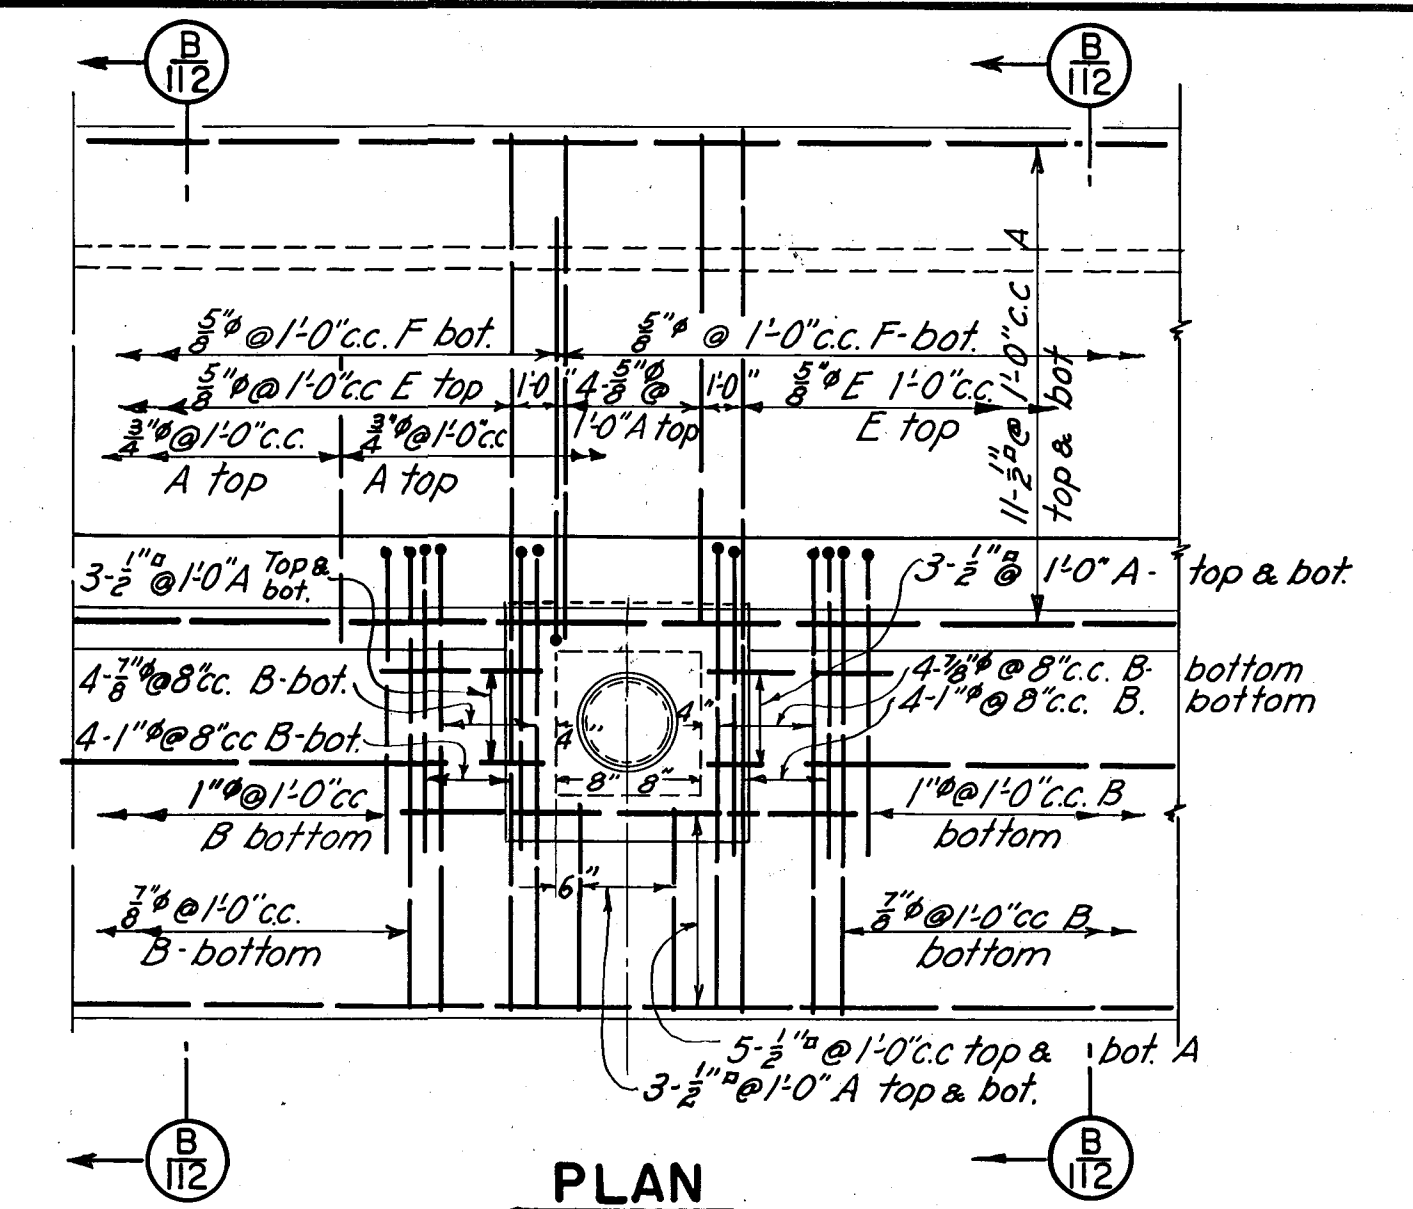

THIS SHEET ADDED TO SET AS OF CHANGE ORDER NO. 5

12/31/45	As built revisions						
KEY	DATE	REVISION (INDICATED BY Δ)	REV. BY	CK. BY	AP. BY		

CONNECTICUT RIVER FLOOD CONTROL
HARTFORD DIKE
 RIVERFRONT. MORGAN ST. TO STA. 96+73
 DETAIL OF ROOF DRAIN OUTFALL AT STA. 84+21±
 SOUTH MEADOWS STATION

CONNECTICUT RIVER CONNECTICUT
 IN 135 SHEETS SCALE 1/2" IN. = 1' FT. SHEET NO. 63A

U. S. ENGINEER OFFICE, PROVIDENCE, R. I., FEB. 1941

SUBMITTED: <i>Amos B. Watson</i> SENIOR ENGINEER HEAD DESIGN SECTION	APPROVAL RECOMMENDED: <i>Edg. Swins</i> PRINCIPAL ENGINEERING CHIEF F.O. ENGINEERING DIV.	APPROVED: <i>W. J. Snyder</i> IN. COL., CORPS OF ENGINEERS DISTRICT ENGINEER
DESIGNED: <i>W. J. Snyder</i> ASSOC. ENGINEER	DRAWN: D. W. C. TRACED: M. H. L. CHECKED: J. S. Jr.	FISCAL YEAR 1941 FILE NO. CT. 4-2849