

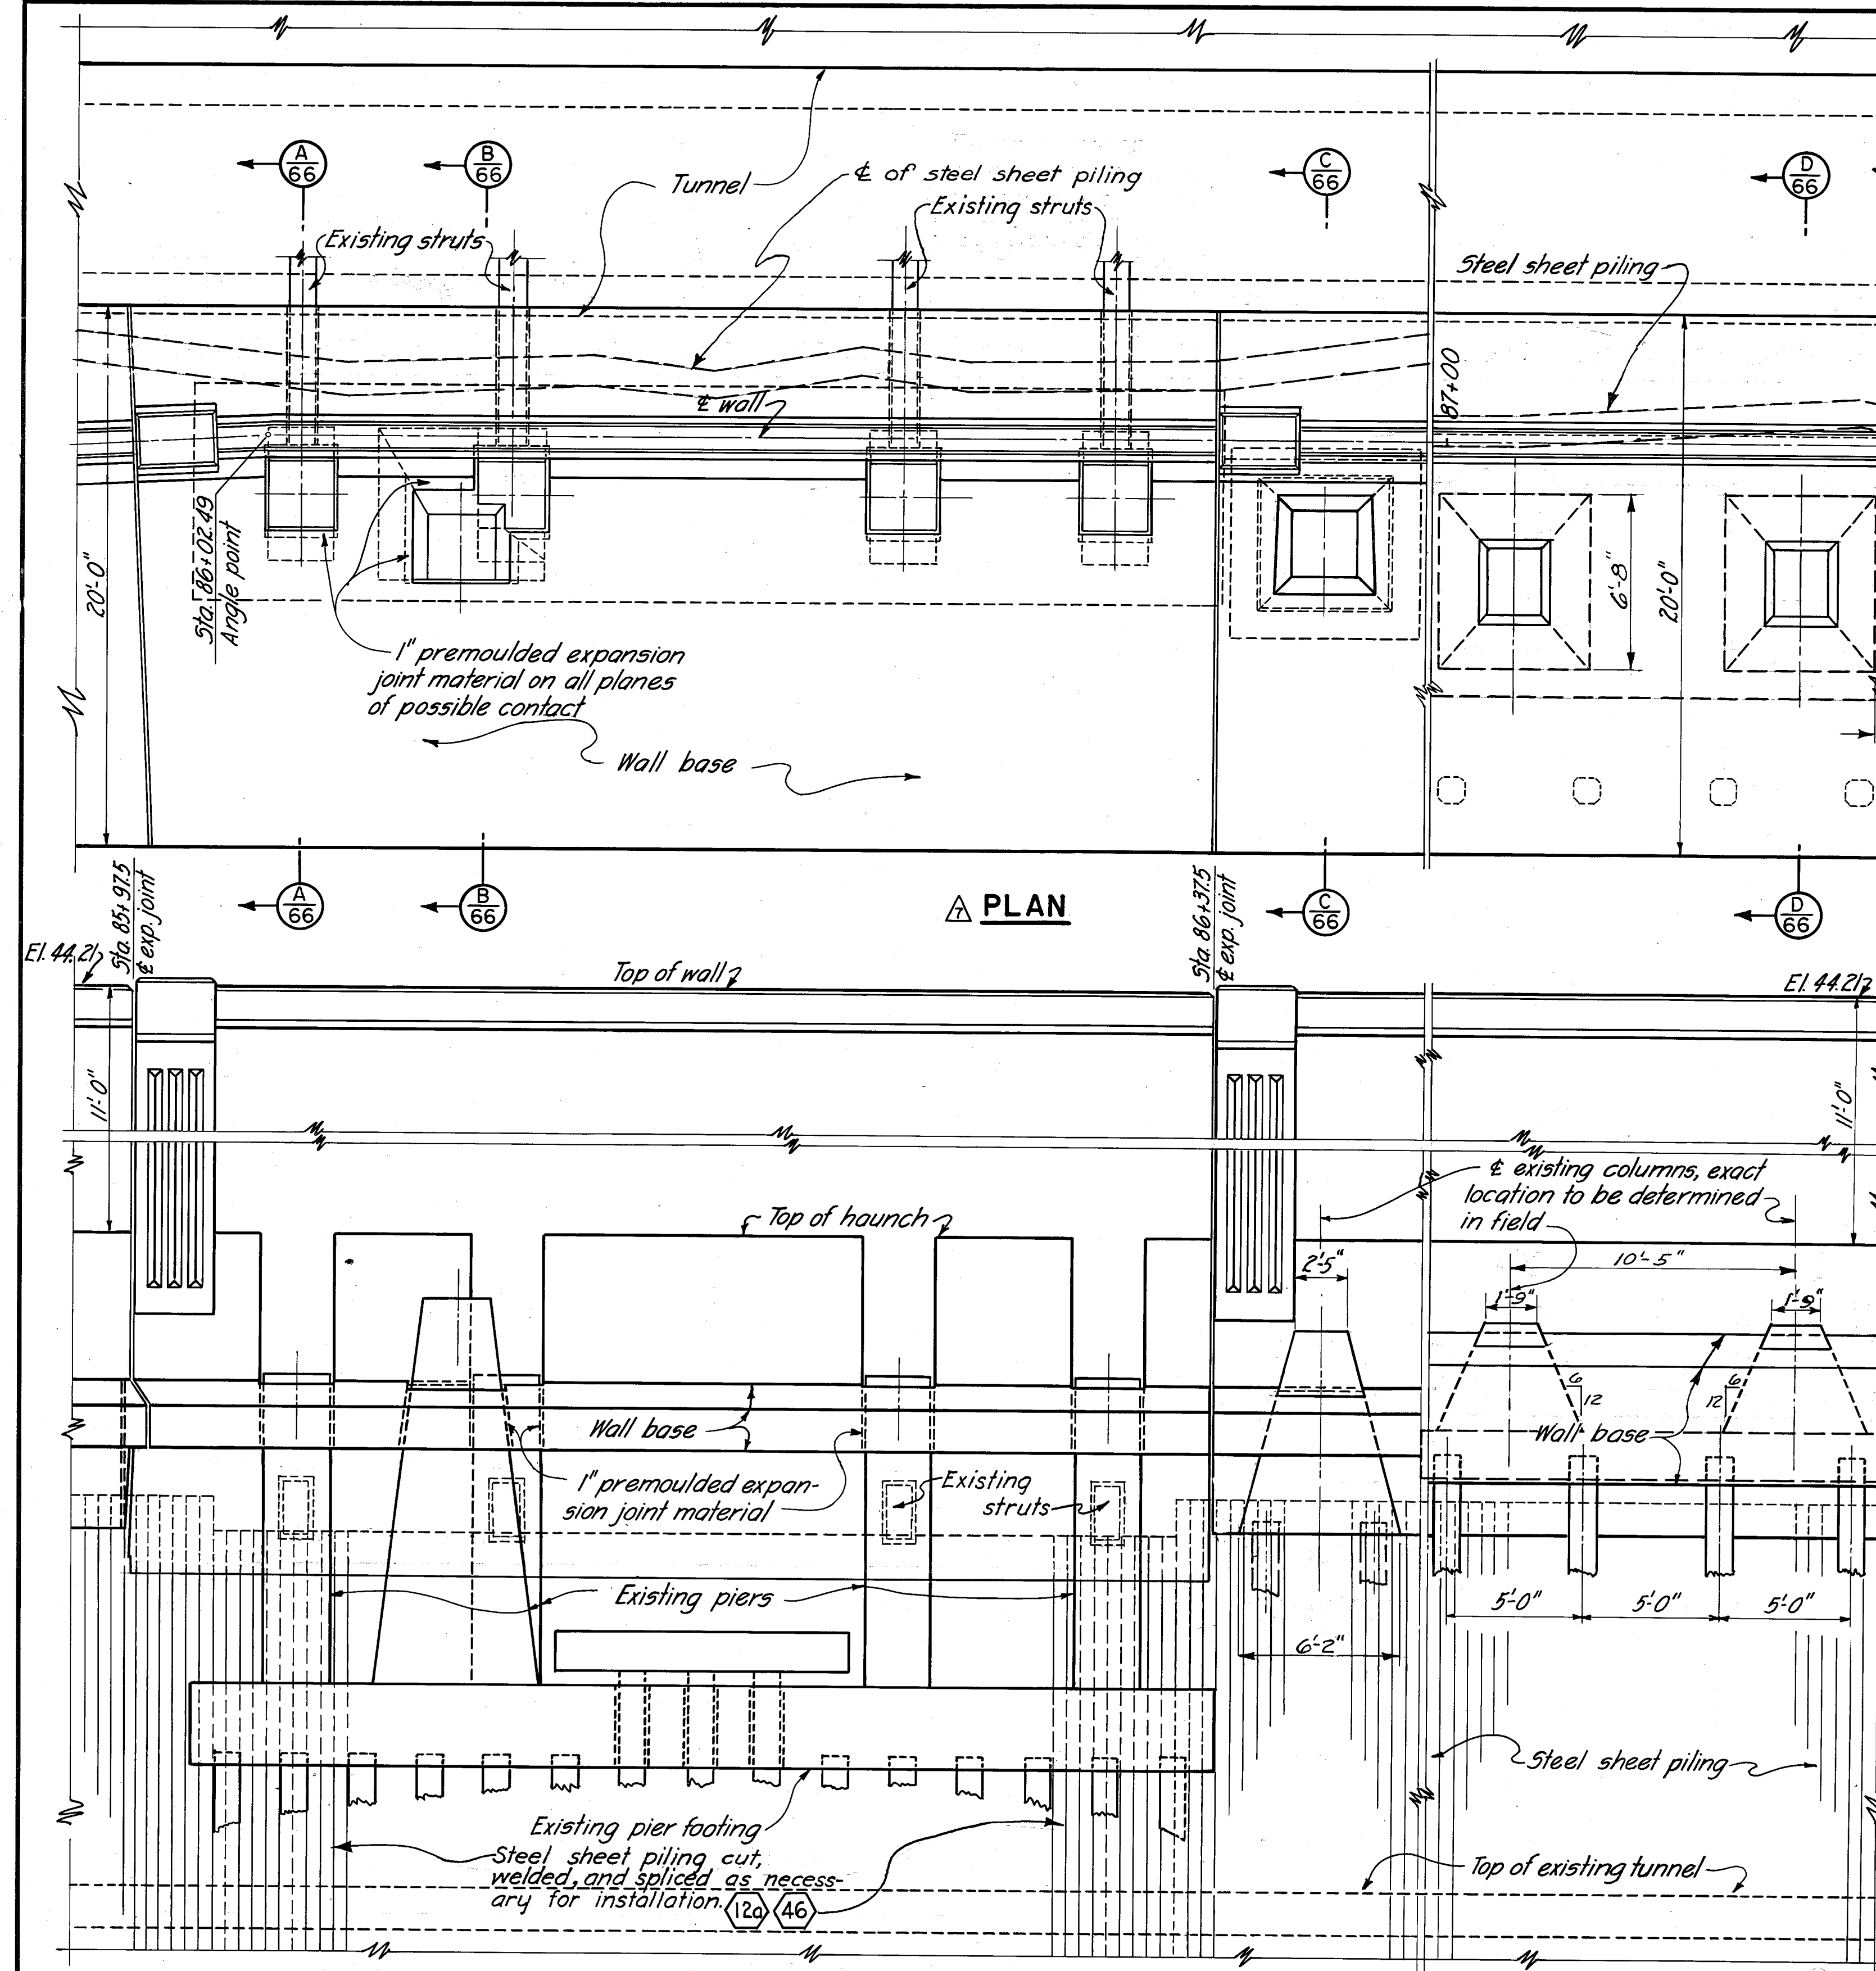


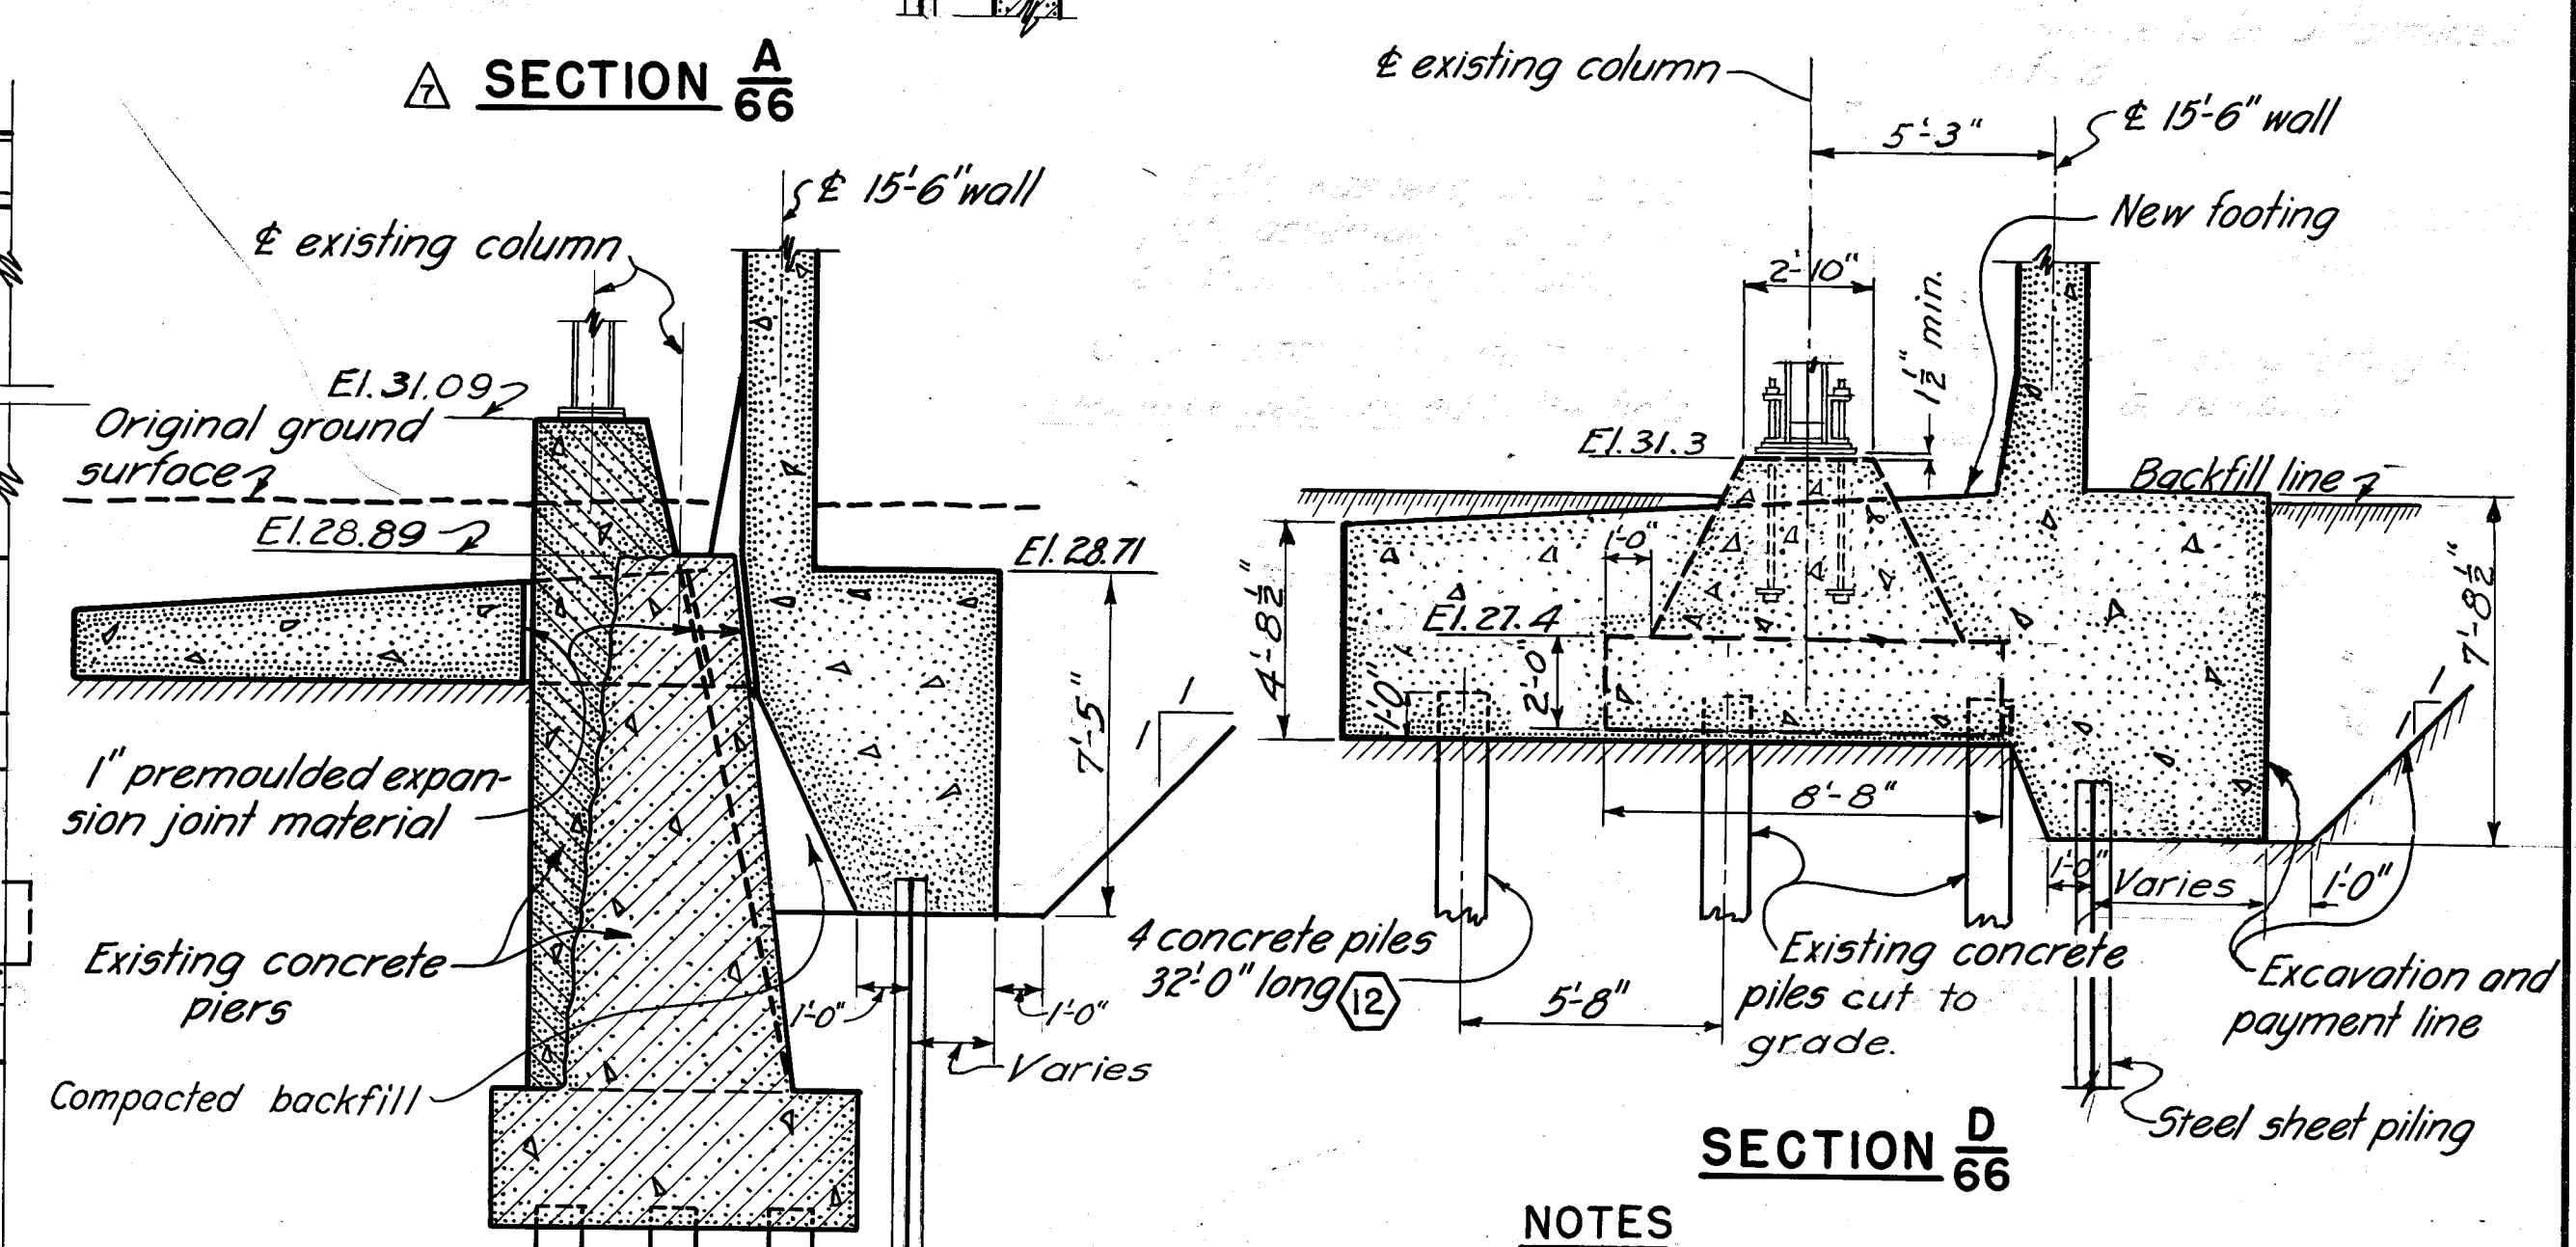

LANDSIDE ELEVATION

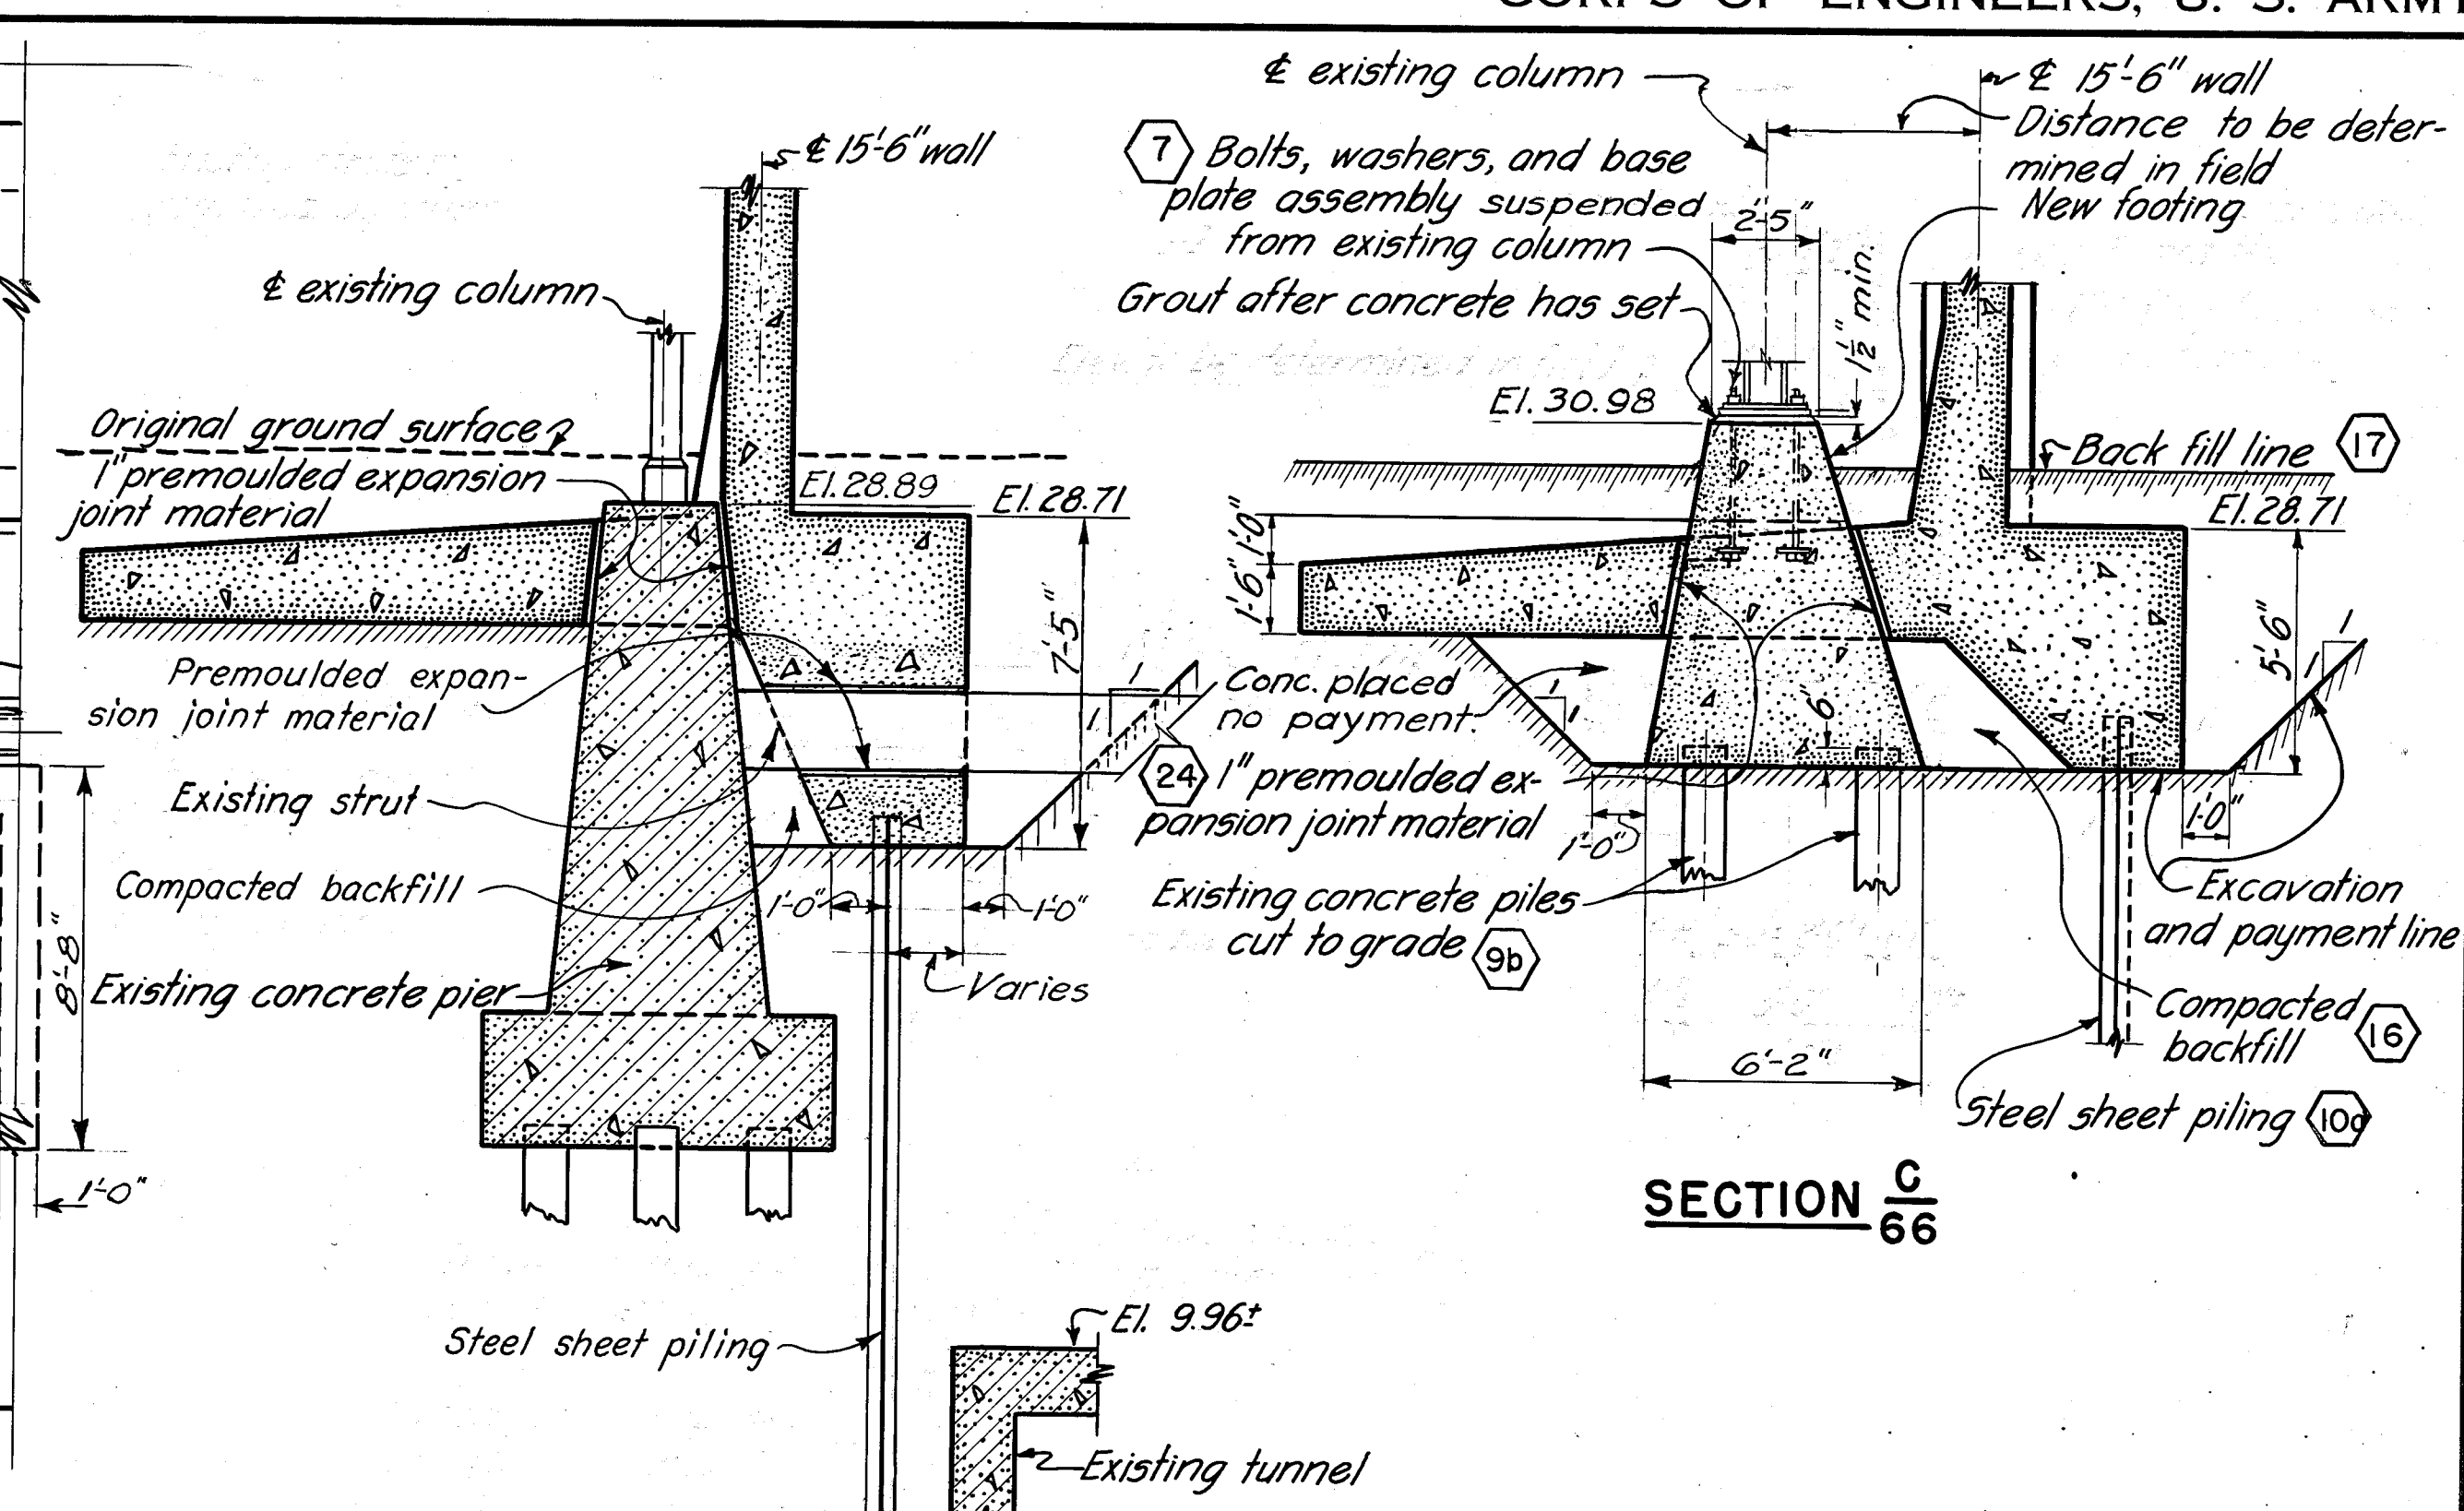

- NOTES**
- For general notes applying to this sheet, see Sheet No. 20.
 - For plan and profile, see Sheets No. 60 & 61.
 - For steel reinforcing details, see Sheets No. 115, 116, & 117.

CONNECTICUT RIVER FLOOD CONTROL			
HARTFORD DIKE			
RIVERFRONT, MORGAN ST. TO STA. 96+73			
MISCELLANEOUS CONCRETE DETAILS NO. 1			
SOUTH MEADOWS STATION			
CONNECTICUT RIVER	CONNECTICUT	SHEET NO. 66	
IN 135 SHEETS	SCALE: 1/4 IN. = 1 FT.	SHEET NO. 66	
U.S. ENGINEER OFFICE, PROVIDENCE, R.I., MAY 1940			
SUBMITTED:	APPROVAL RECOMMENDED:	APPROVED:	
<i>W. B. Smith</i>	<i>W. B. Smith</i>	<i>W. B. Smith</i>	
SENIOR ENGINEER	PRINCIPAL ENGINEER	DISTRICT ENGINEER	
HEAD, DESIGN SECTION	CHIEF, F.C. ENGINEERING DIV.	DISTRICT ENGINEER	
DESIGNED:	DRAWN:	FISCAL YEAR 1940	
<i>W. B. Smith</i>	R.S.S. & A.K.	FILE NO. CT-4-2526	
REV. BY	CK. BY	AP. BY	
W. B. Smith	W. B. Smith	W. B. Smith	

12-31-45	As built revisions			
3-10-41	Curtain wall raised	W. B. Smith	1941	2813
KEY	DATE	REVISION (Indicated by Δ)	REV. BY	CK. BY