

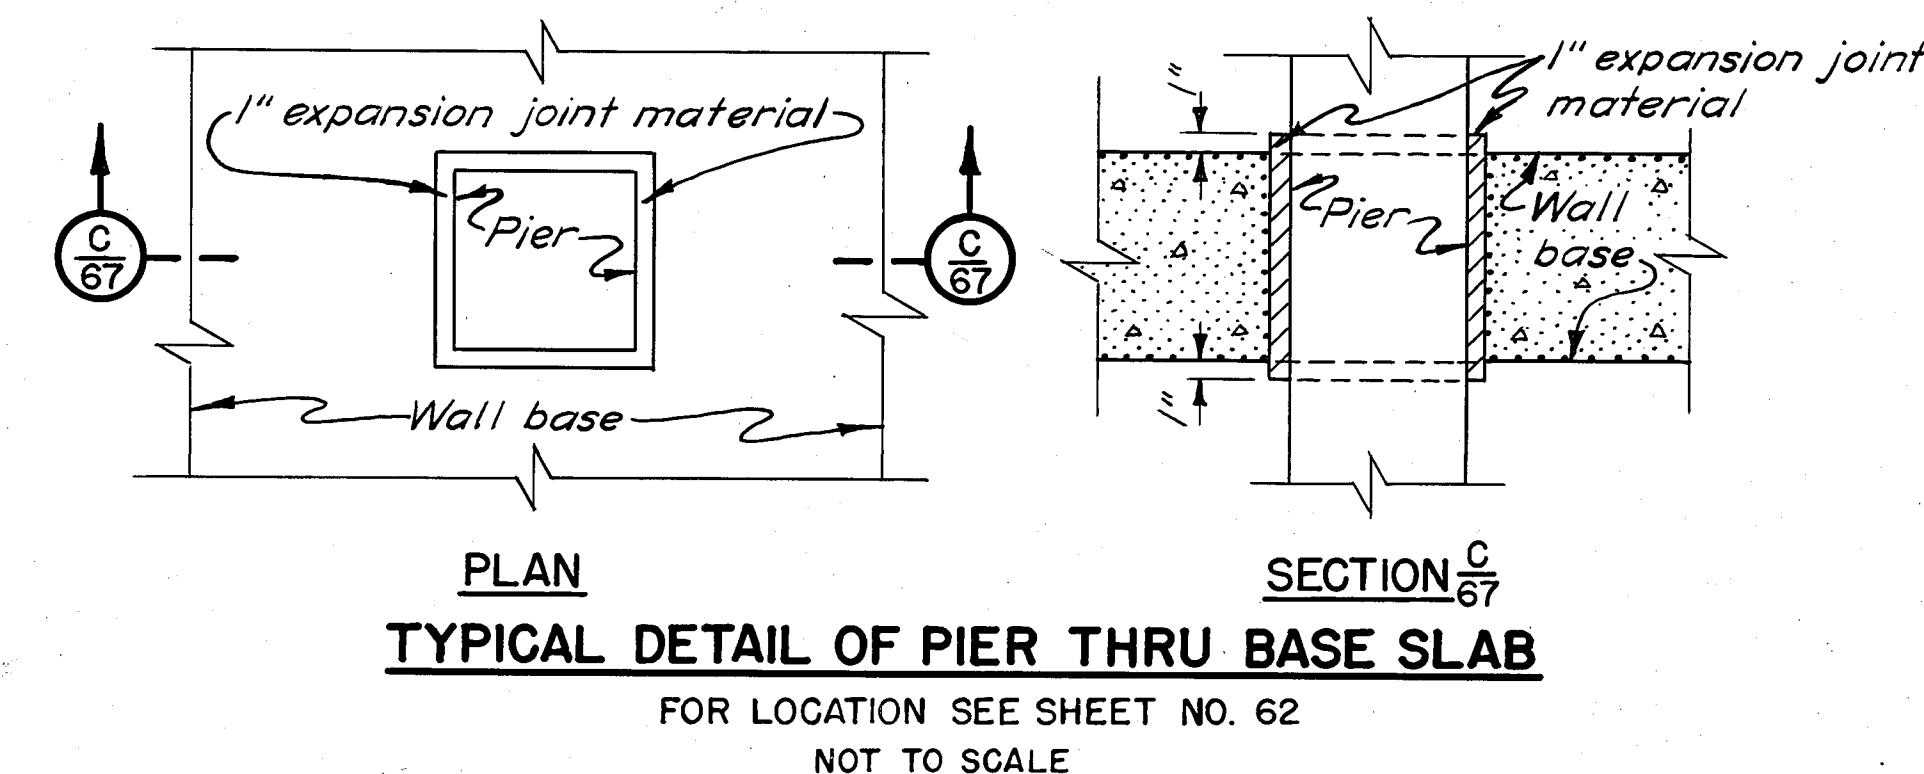
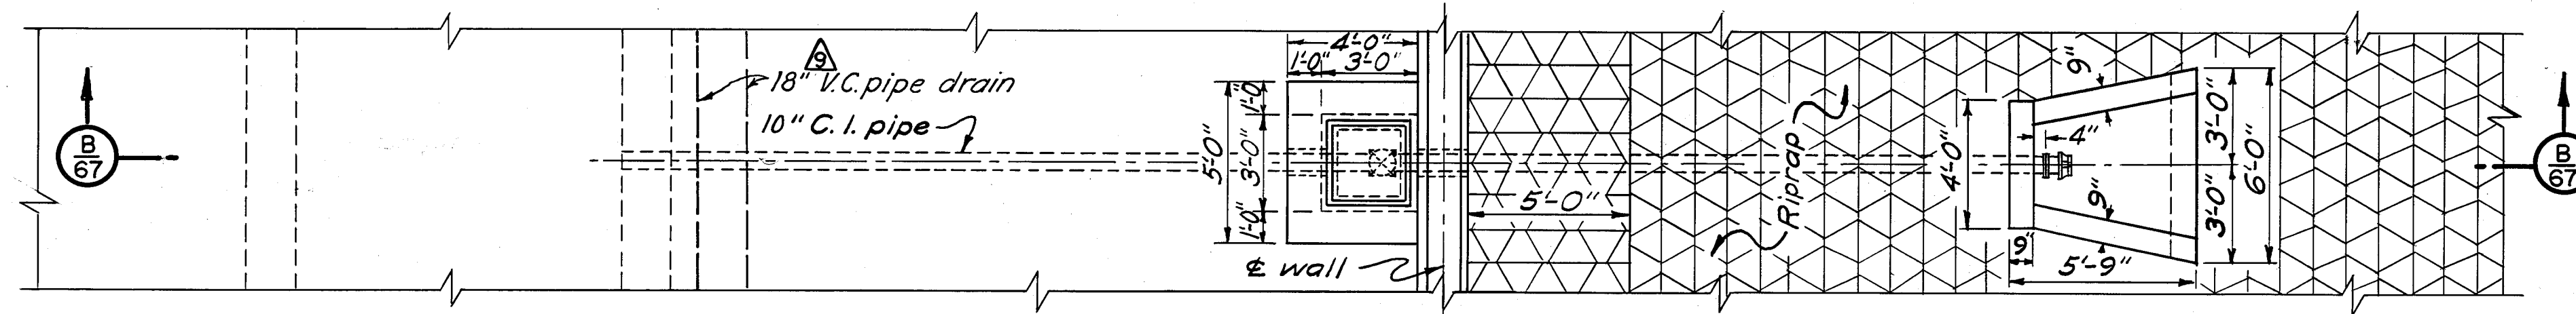
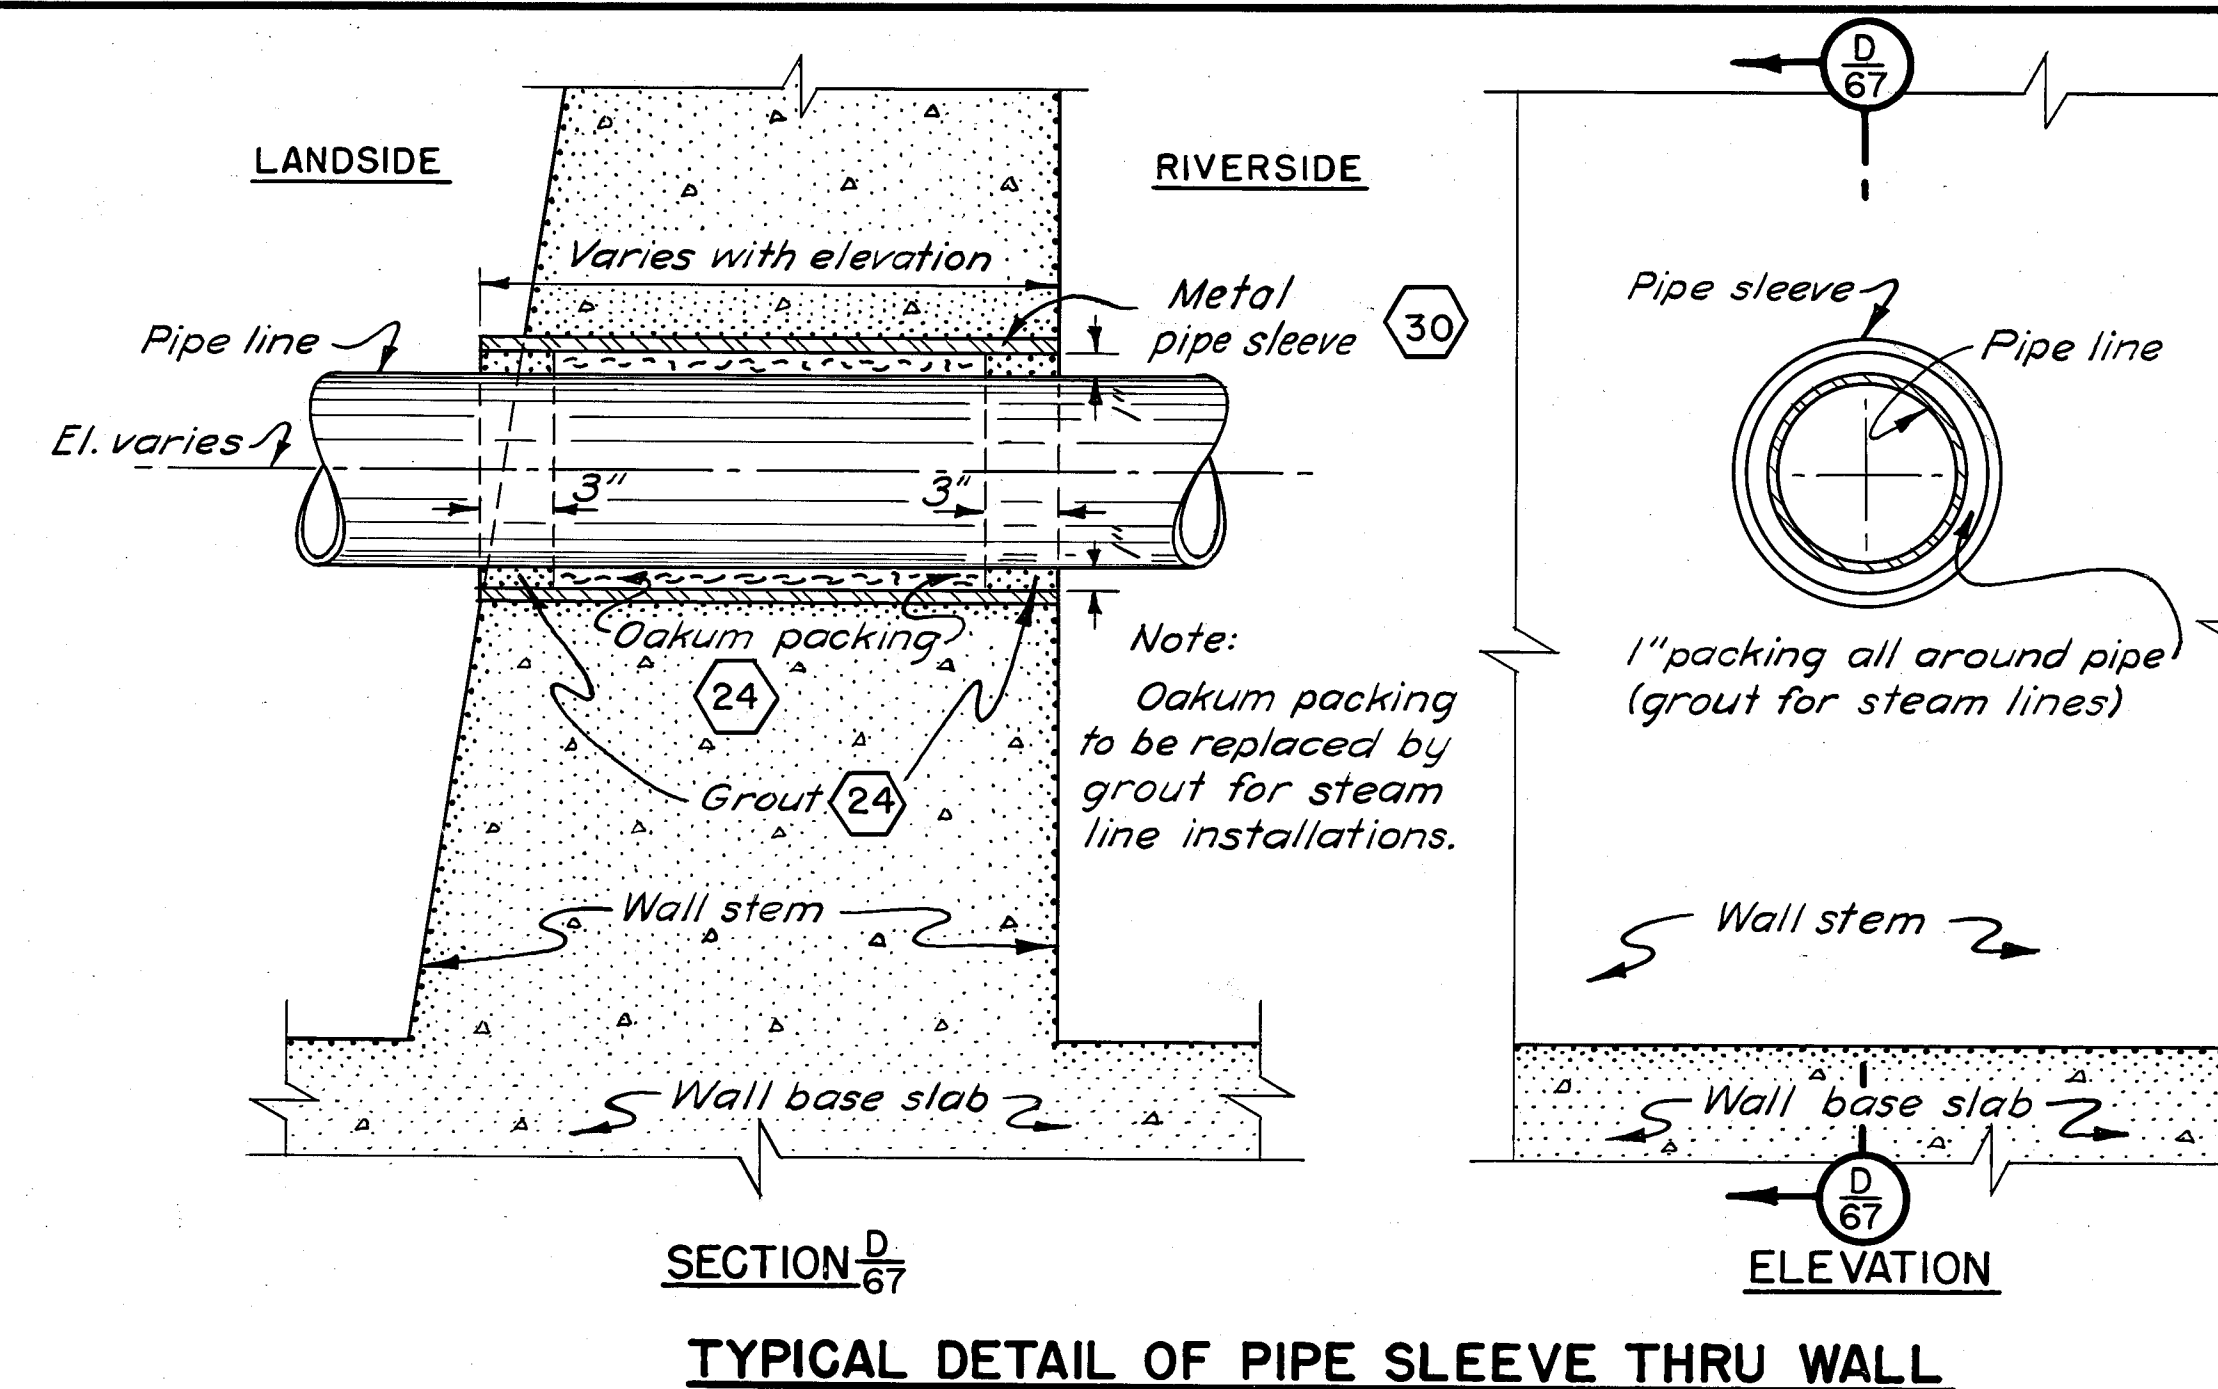


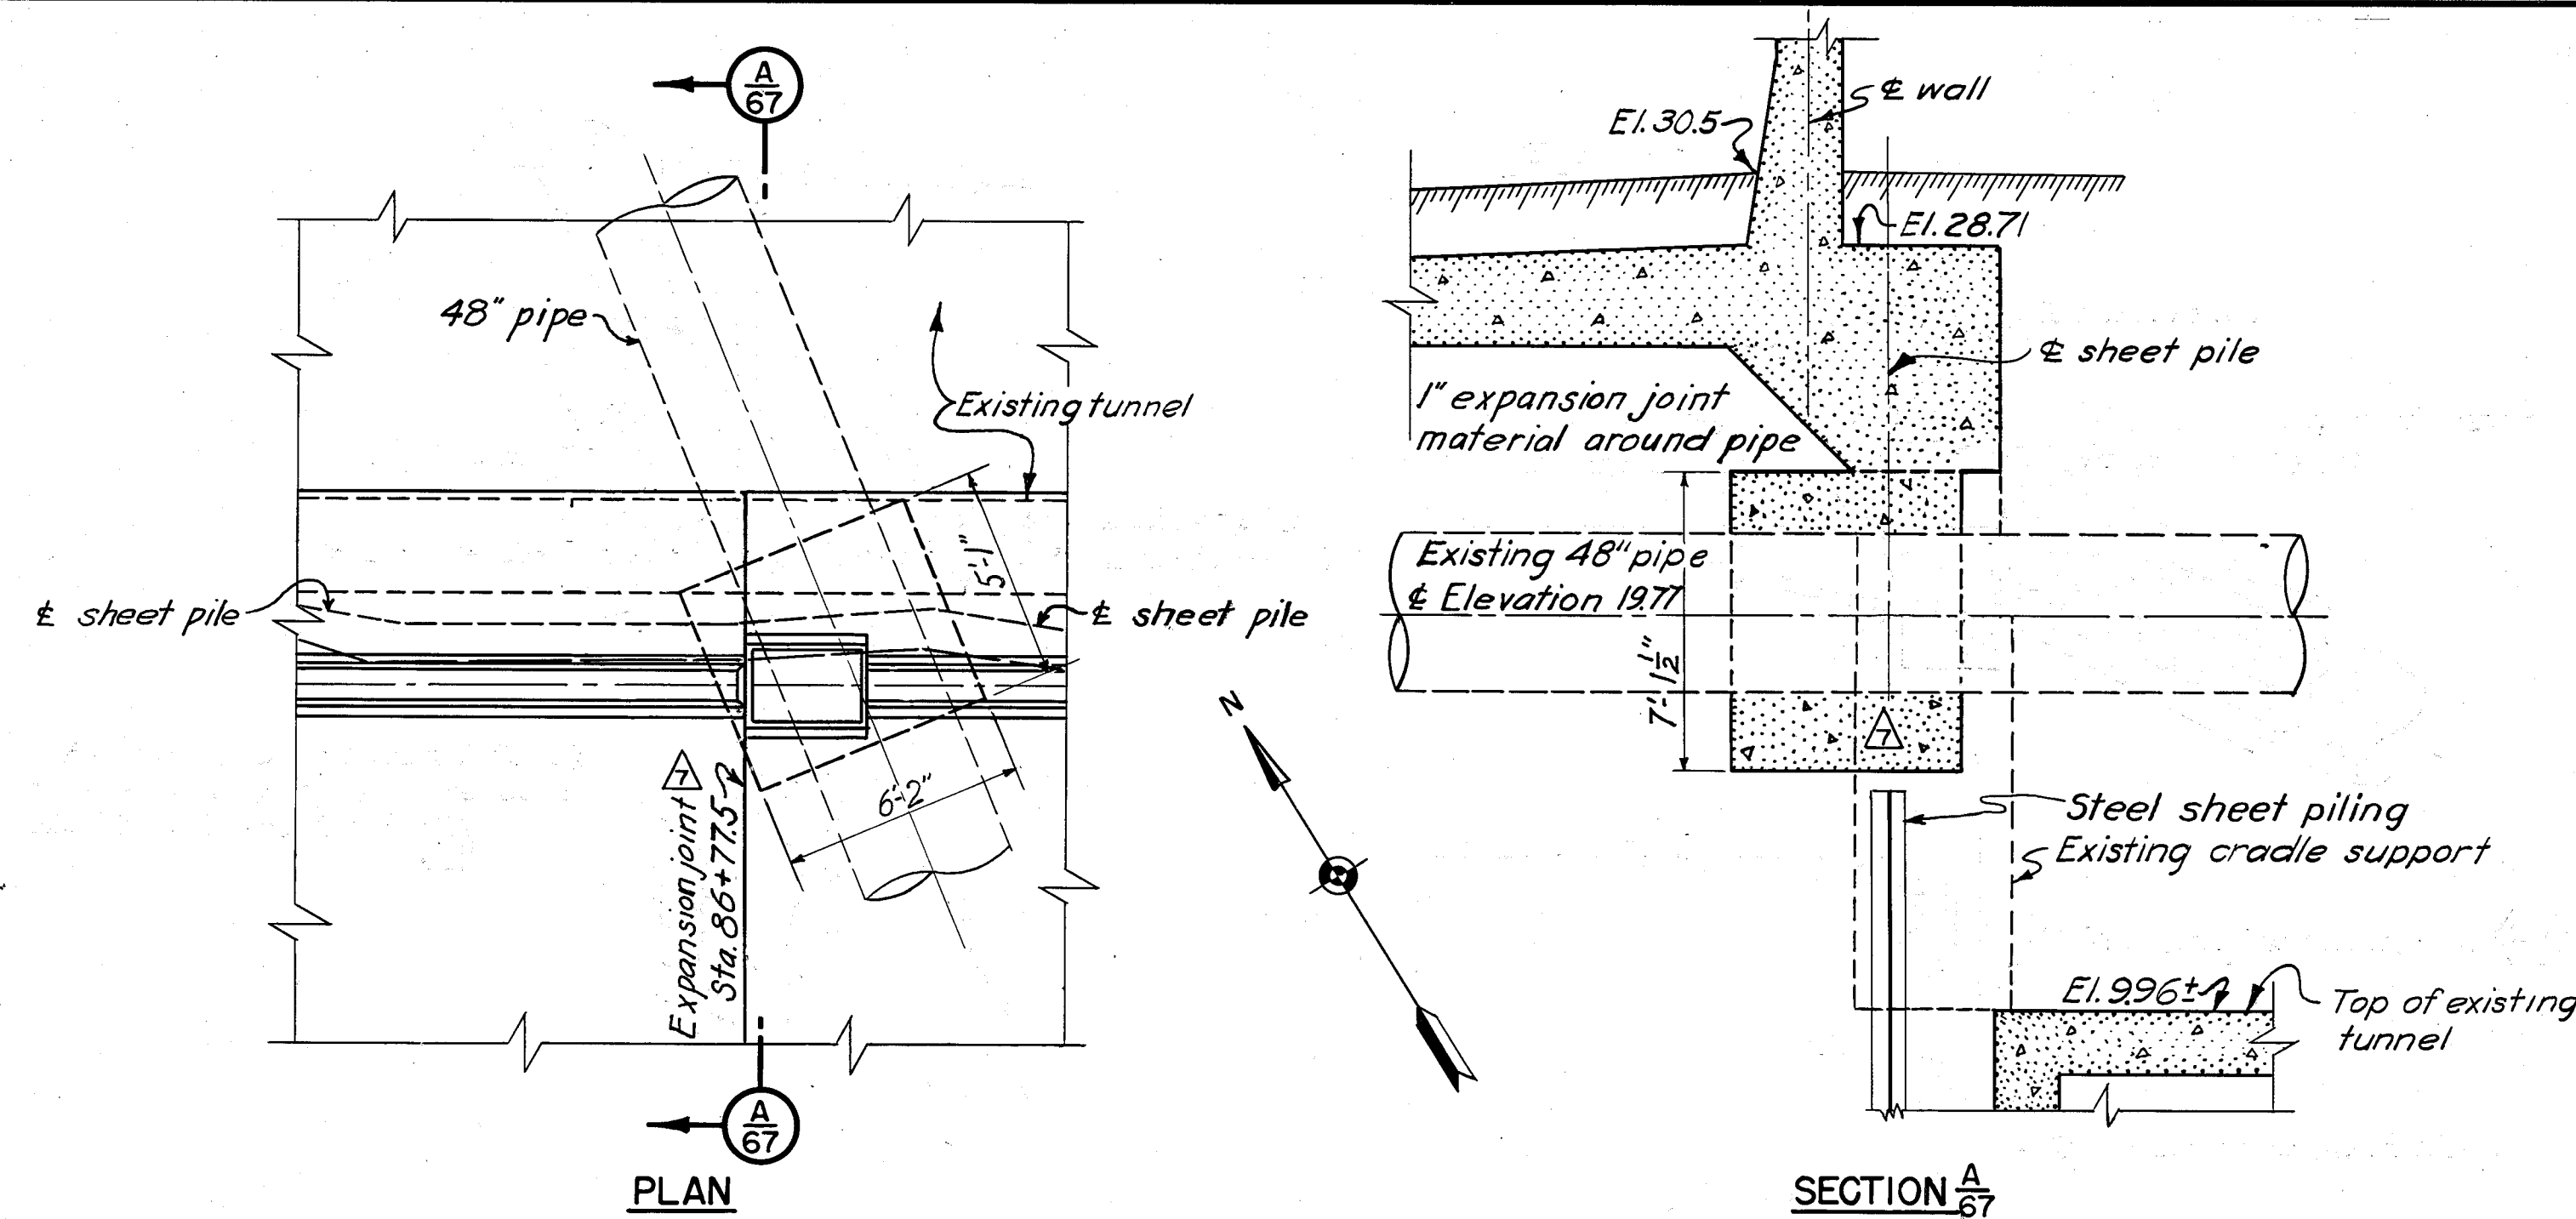

NOTES

For general notes applying to this sheet see Sheet No. 20.
For Plan and Profile see Sheet No. 62.
For steel reinforcing details see Sheets No. 120 & 126.

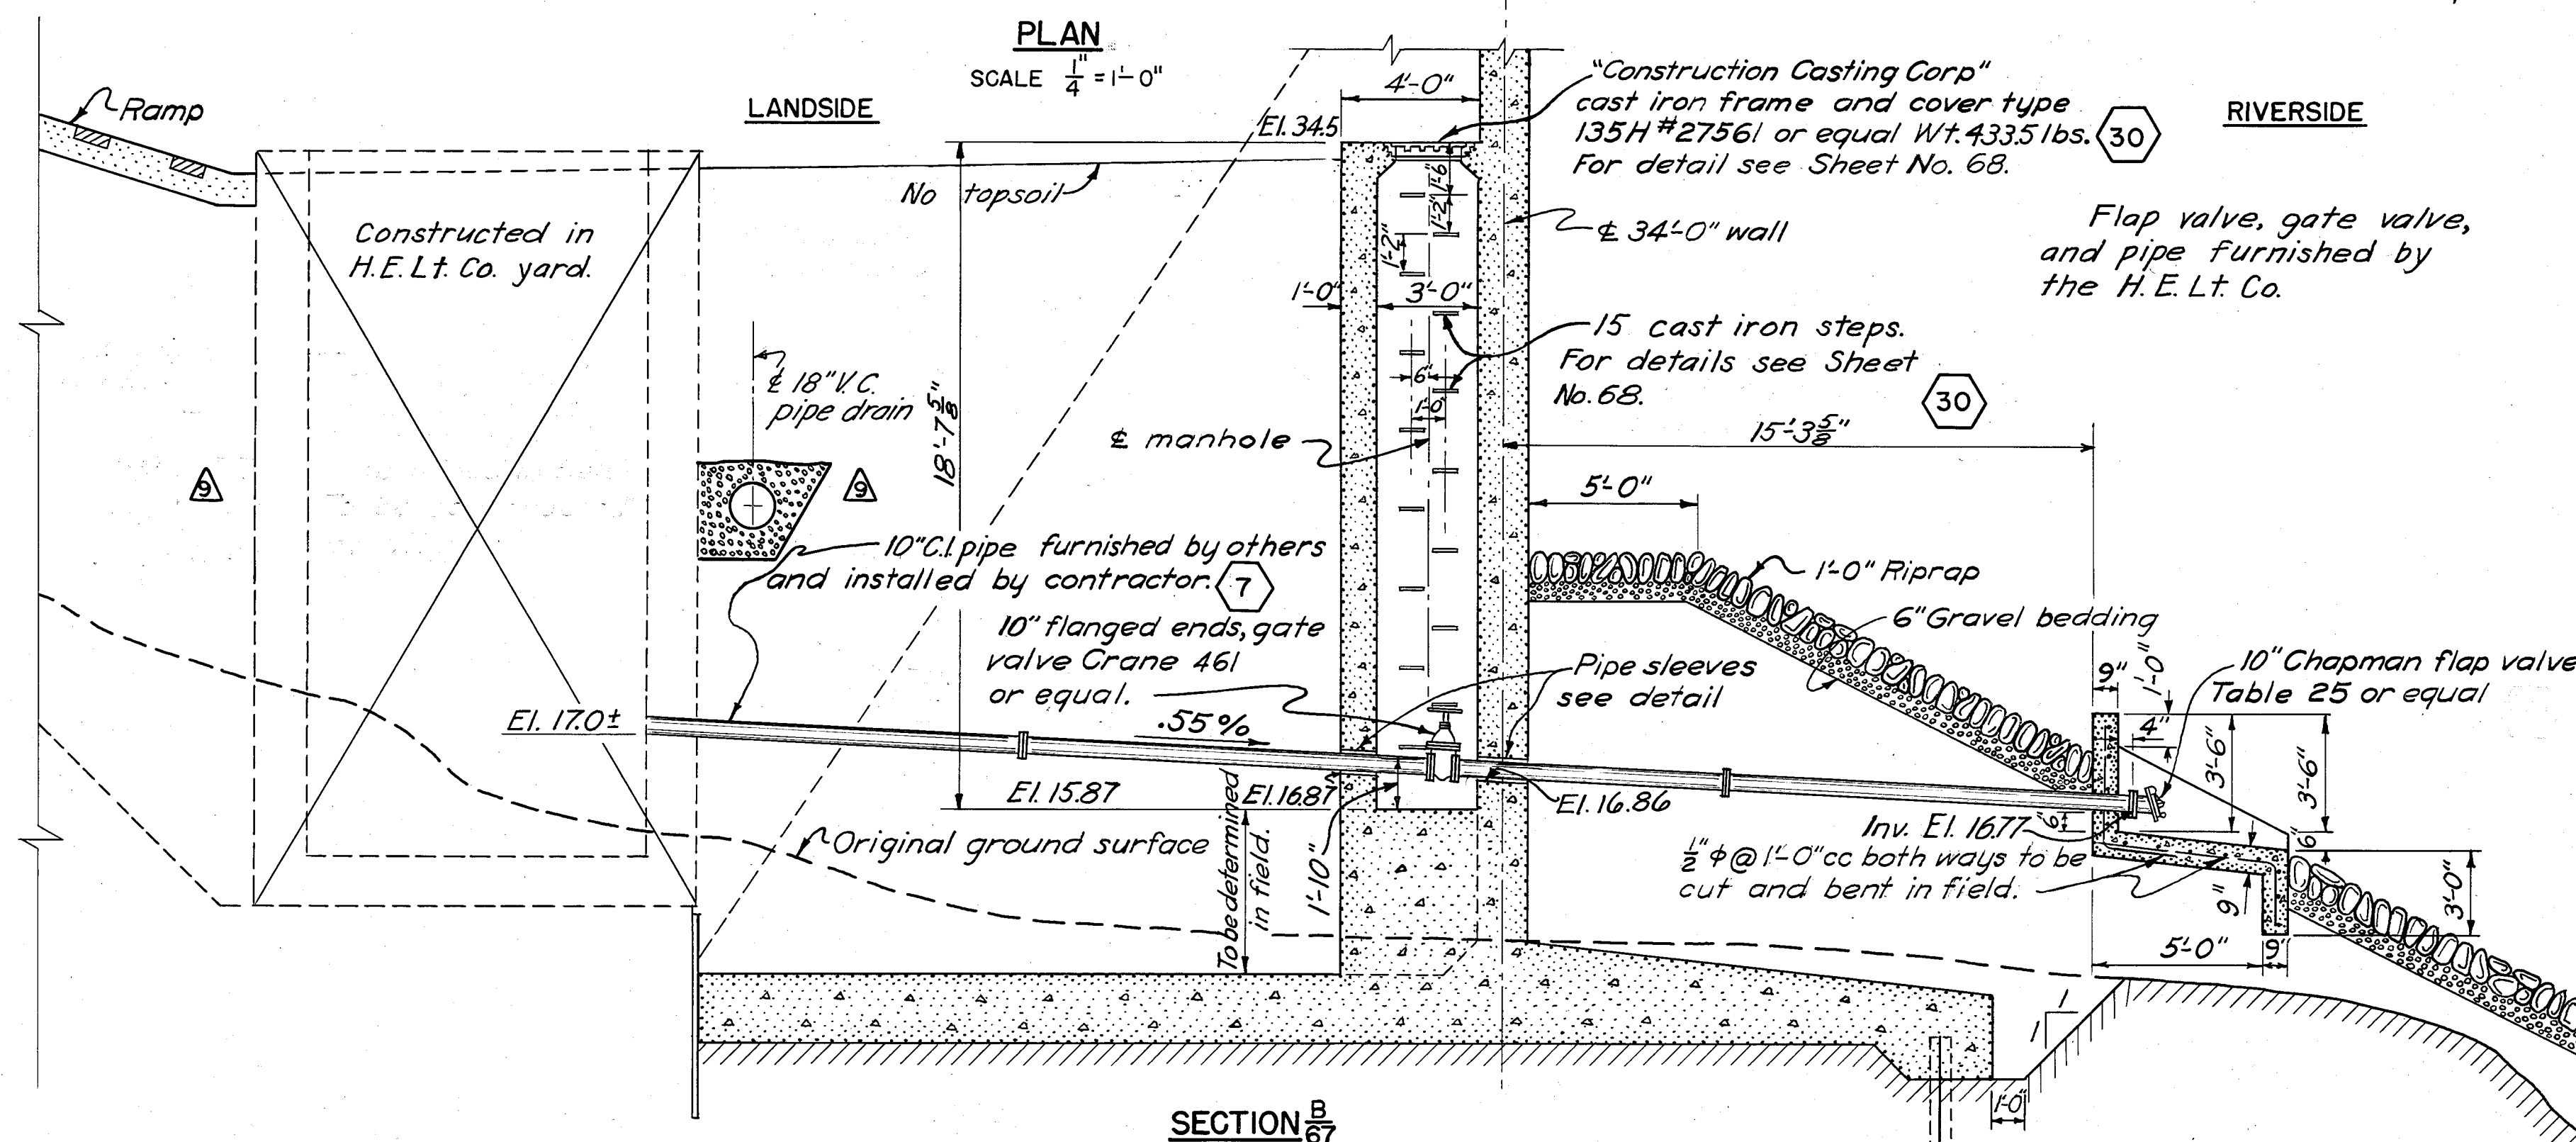

12-31-45	As built revisions	PC#	10	30
8-7-41	18" V.C. pipe drain relocated	WQE	10	30
3/10/41	Curtain wall removed.	WQE	10	30
KEY	DATE	REVISION (Indicated by Δ)	REV. BY	CK. BY

CONNECTICUT RIVER FLOOD CONTROL			
HARTFORD DIKE			
RIVERFRONT, MORGAN ST. TO STA. 96+73			
MISCELLANEOUS CONCRETE DETAILS NO. 2			
SOUTH MEADOWS STATION			
CONNECTICUT RIVER		CONNECTICUT	
IN 135 SHEETS		SHEET NO. 67	
SCALE 1/4" = 1'-0"			
U.S. ENGINEER OFFICE, PROVIDENCE, R.I., MAY 1940			
SUBMITTED:		APPROVED:	
HEAD, DESIGN SECTION		CHIEF, F.C. ENGINEERING DIV.	
DESIGNED BY:		DRAWN BY:	
CHECKED BY:		FISCAL YEAR 1940	
FILE NO. CT-4-2527		Ht. 587b	