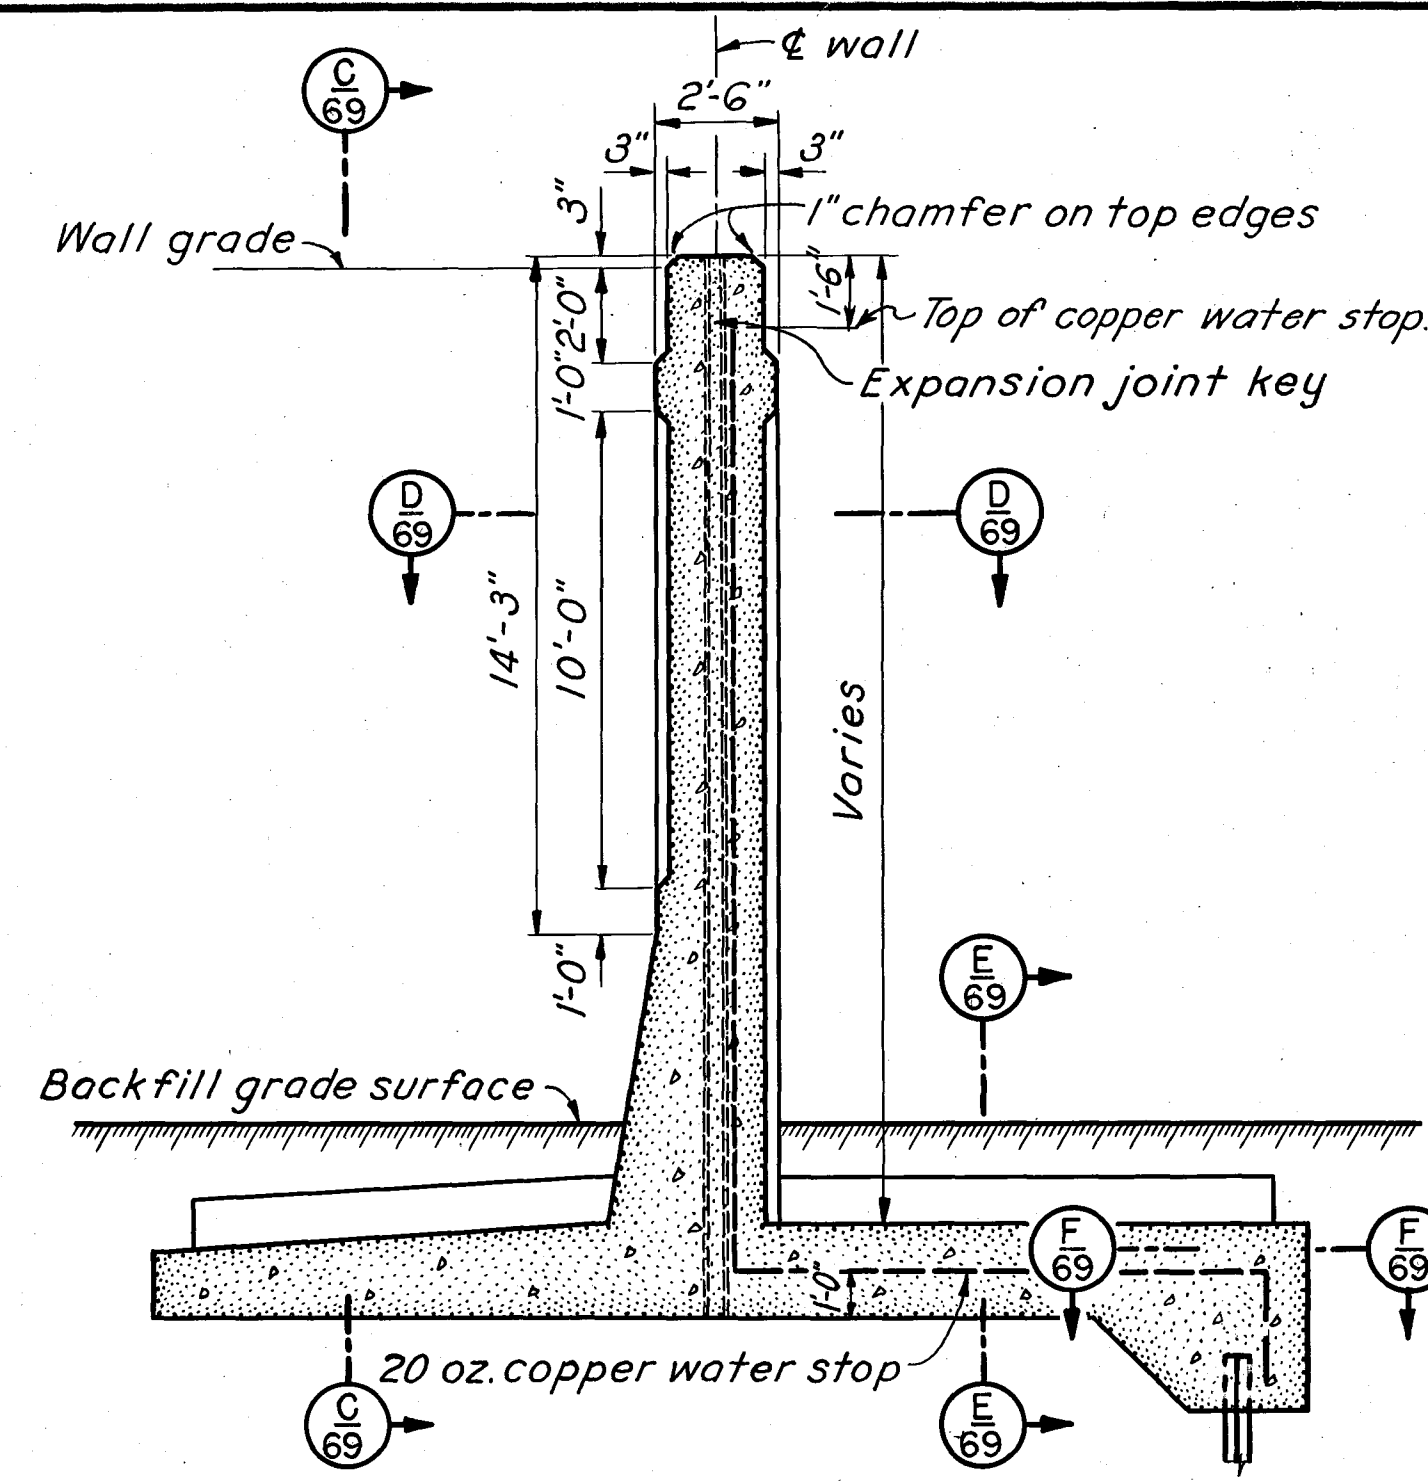
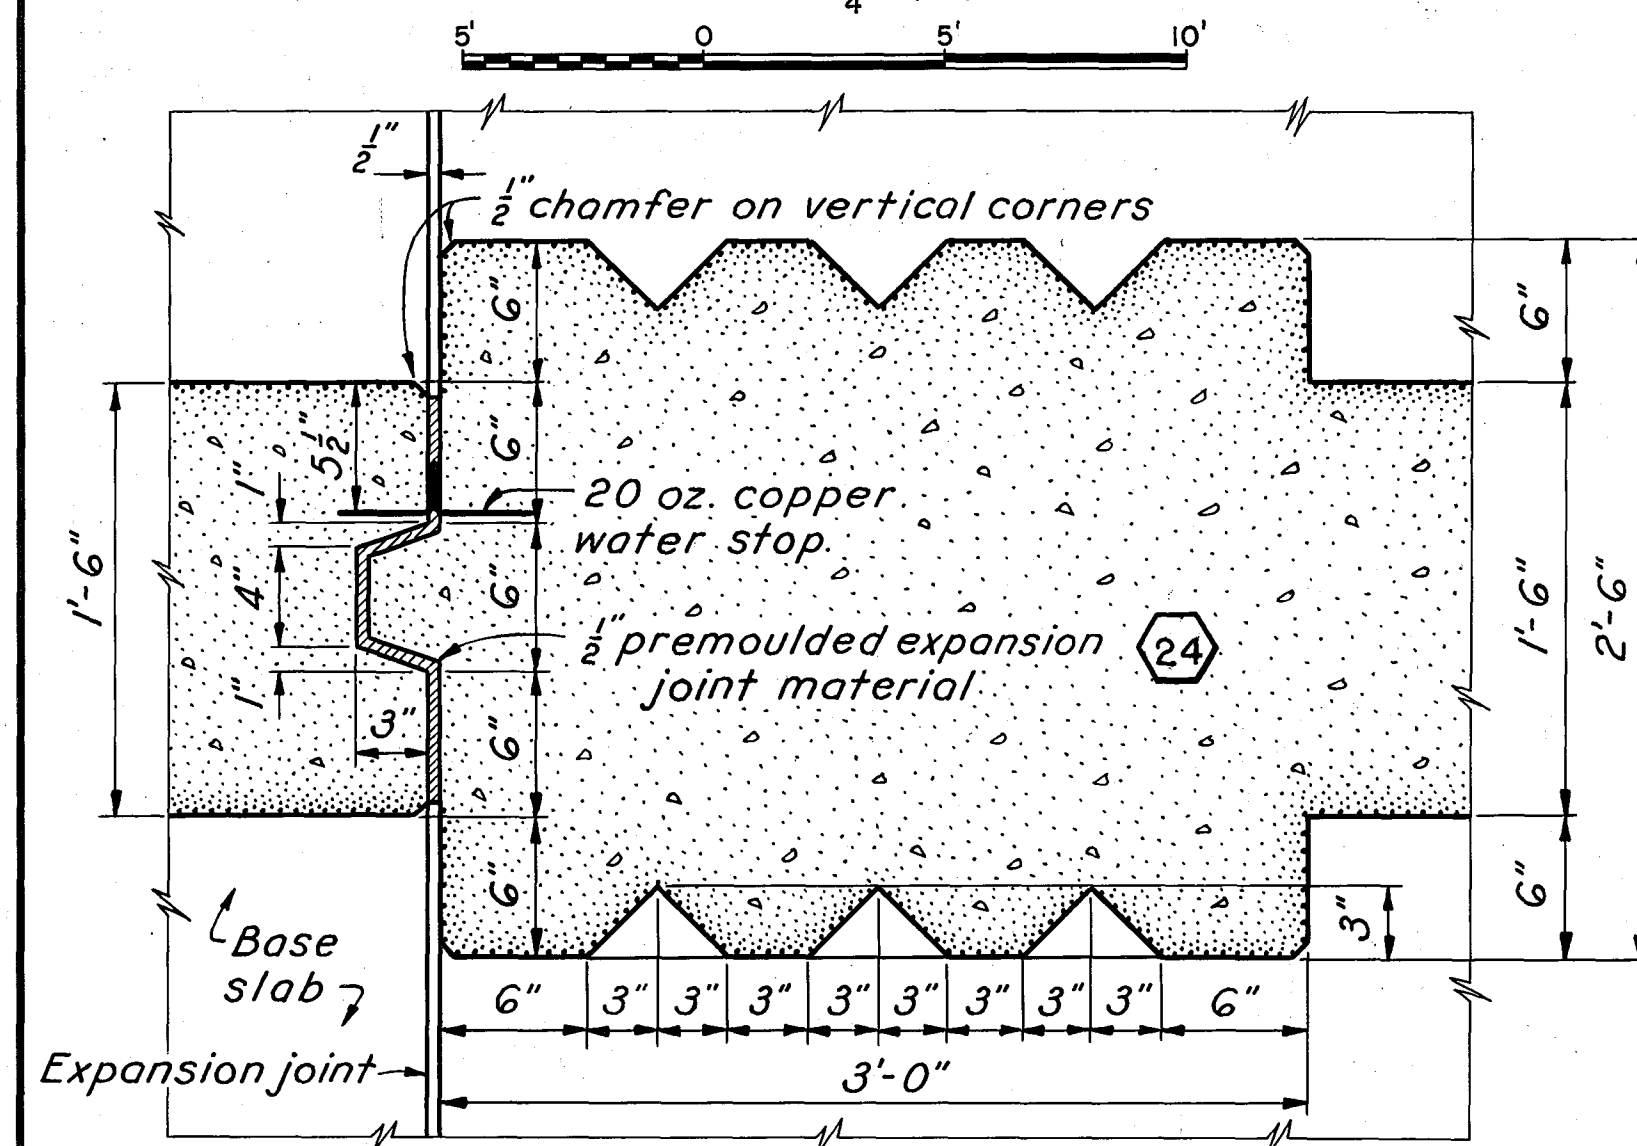
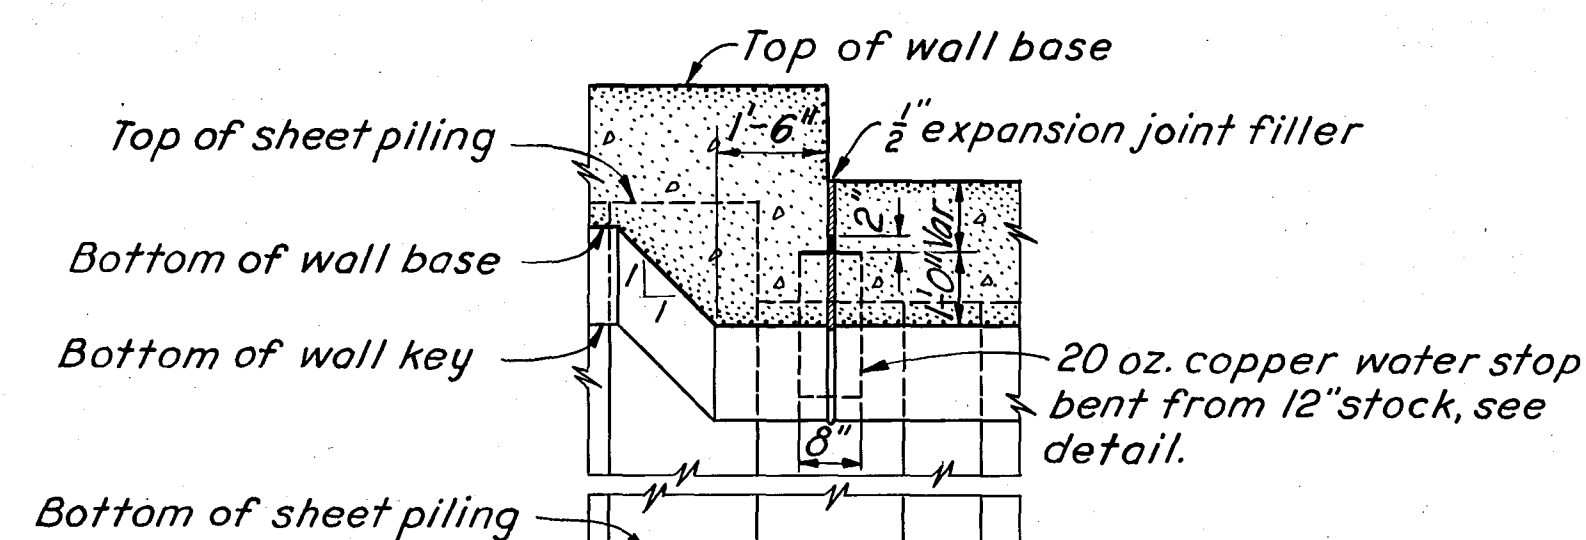




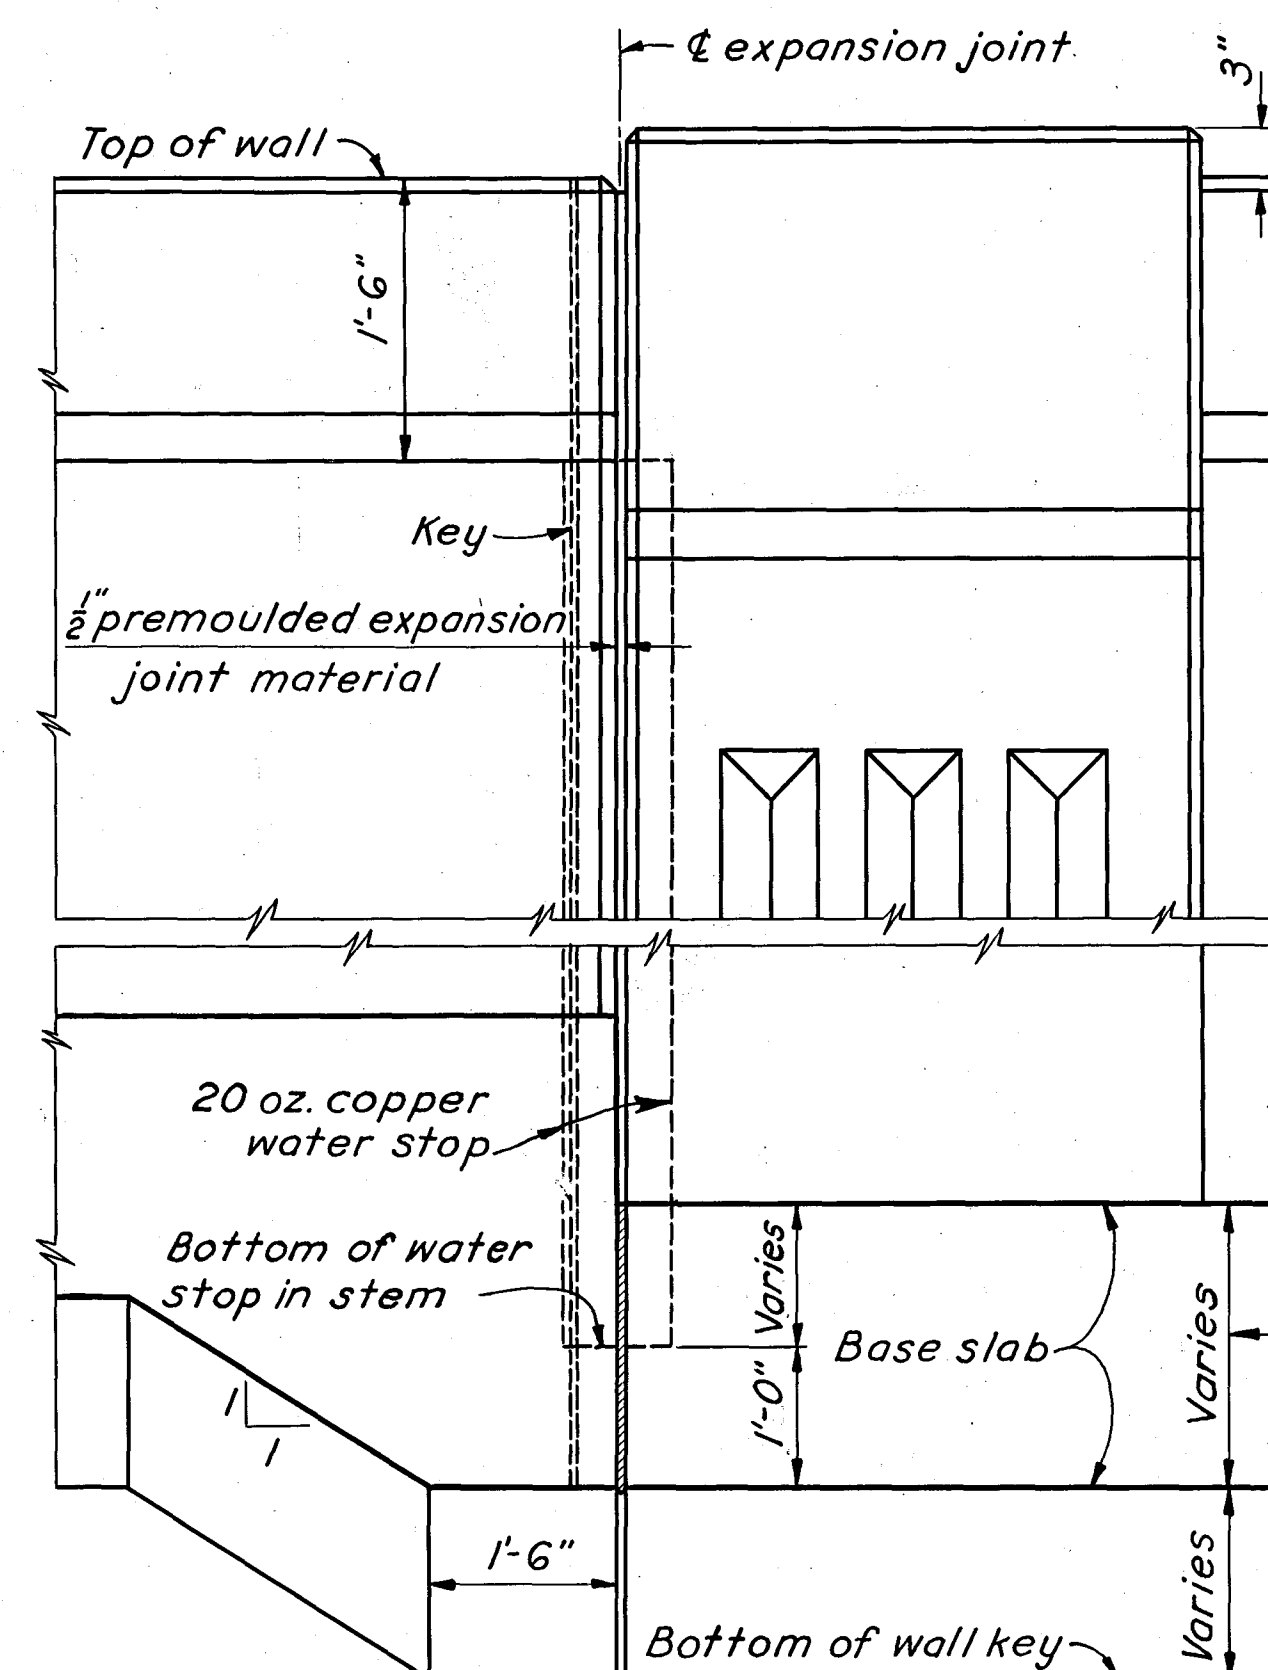
SECTION ON CL OF PILASTERS

SCALE: $\frac{1}{4}$ " = 1'-0"

SECTION D 69

SCALE: $\frac{1}{2}$ " = 1'-0"

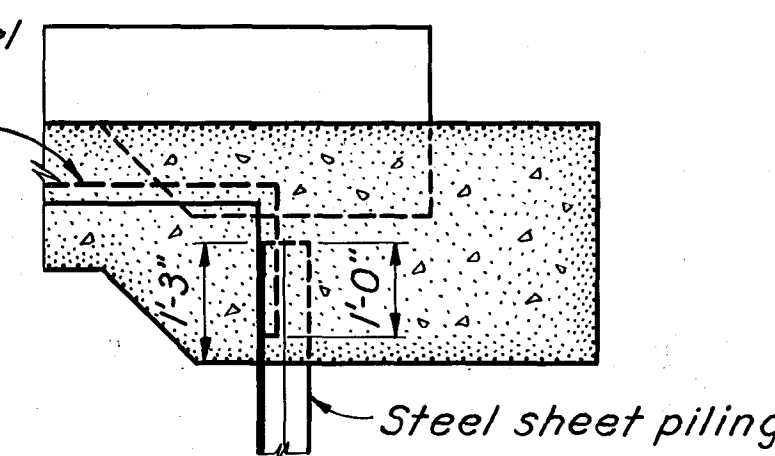
SECTION E 69

SCALE: $\frac{1}{2}$ " = 1'-0"

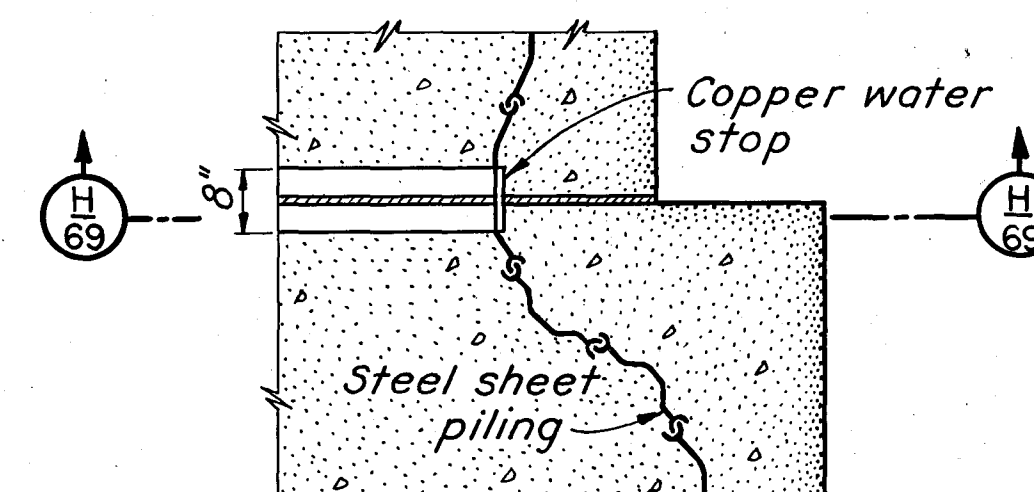
SECTION C 69

TYPICAL TREATMENT OF JOINT
AT CHANGE OF BASE ELEVATION

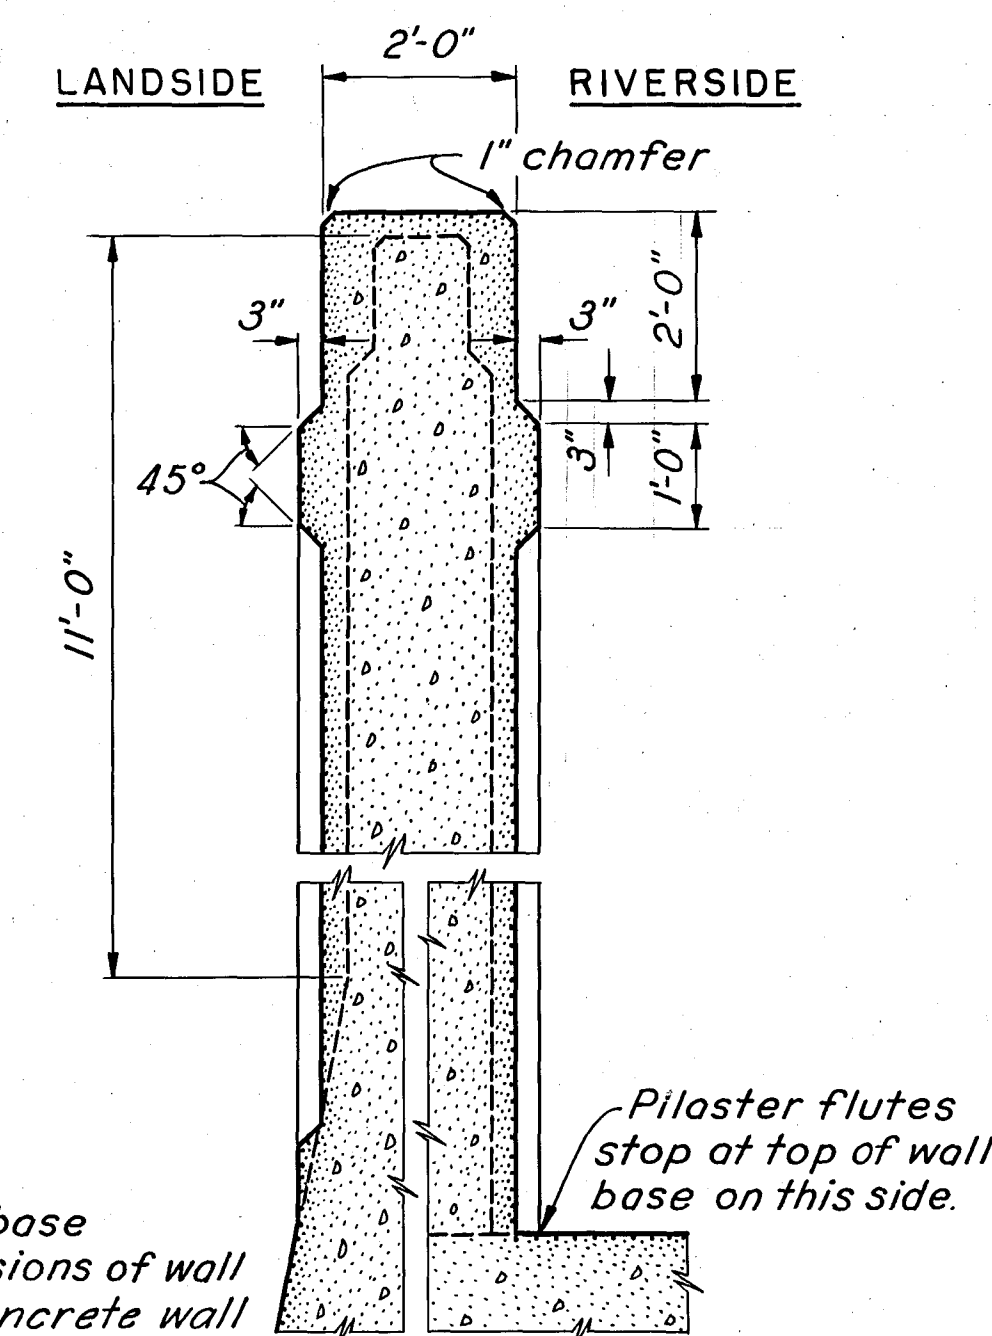
SCALE: 1" = 1'-0"

Copper water stop
lapped 1'-0" over steel
sheet piling to form
water tight seal.

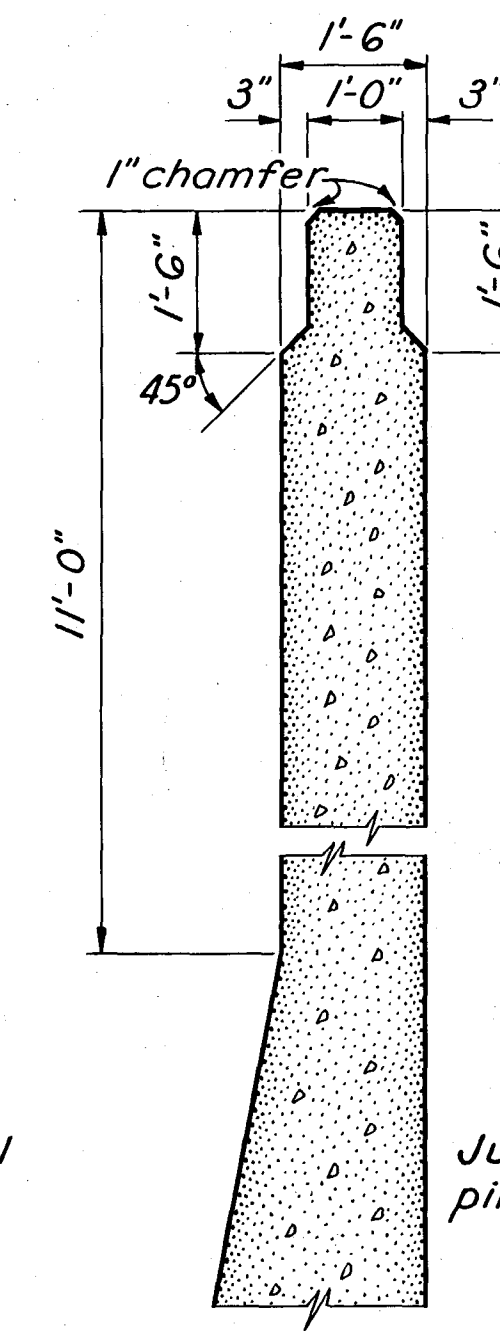
SECTION H 69

SCALE: $\frac{1}{2}$ " = 1'-0"

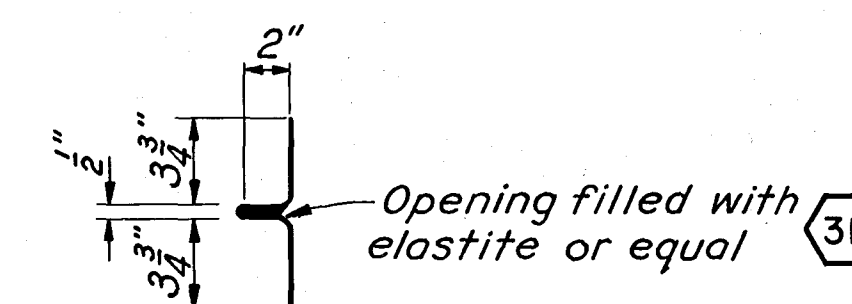
SECTION F 69

SCALE: $\frac{1}{2}$ " = 1'-0"

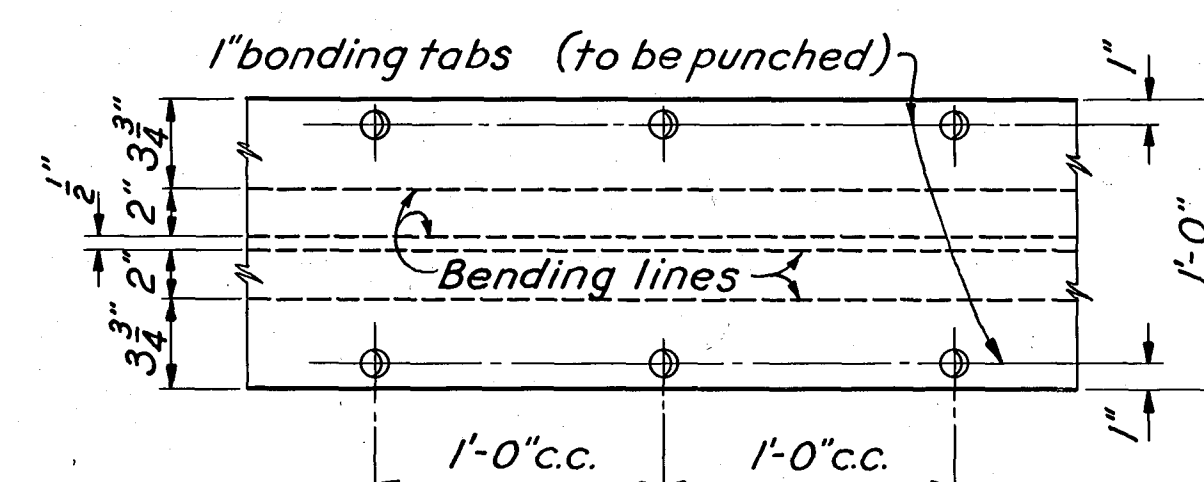
SECTION A 69

SCALE: $\frac{1}{2}$ " = 1'-0"

SECTION B 69

SCALE: $\frac{1}{2}$ " = 1'-0"

SECTION



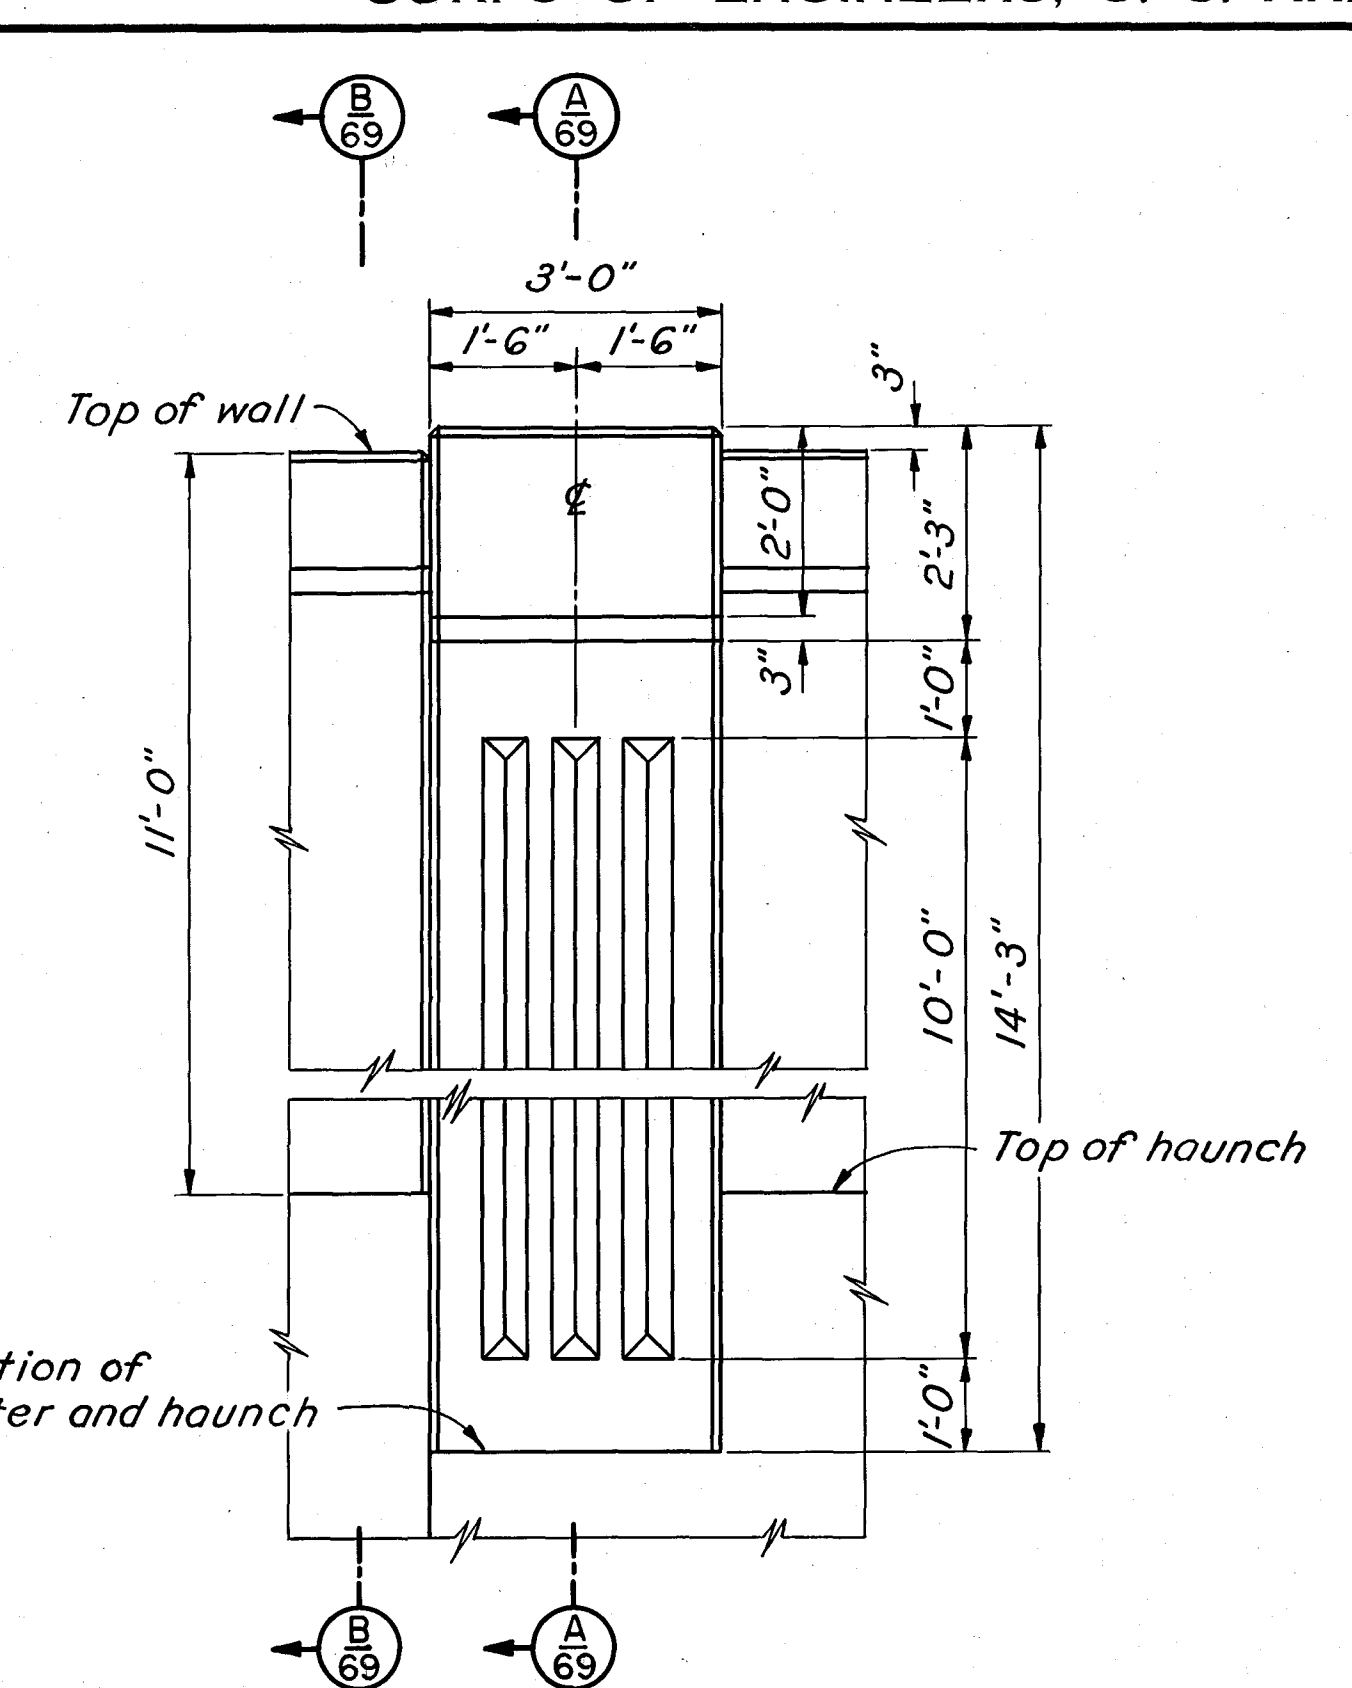
DETAIL OF COPPER WATER STOP 31

SCALE: $\frac{1}{2}$ " = 1'-0"

△ SCHEDULE OF ARCHITECTURAL TREATMENT

- Sta. 0+70.2 to 4+71.19 - Riverside pilasters and parapet.
- Sta. 4+71.19 to 16+31.19 - Riverside and landside pilasters, standard top treatment, both sides.
- Sta. 16+31.19 to 17+91.19 - Landside pilasters, standard top treatment.
- Sta. 17+91.19 to 21+51.19 - Riverside pilasters, standard top treatment.
- Sta. 21+51.19 to 41+02.63 - Standard top treatment only.

KEY	DATE	REVISION (Indicated by △)	REV. BY	CK. BY	AP. BY
12-31-45	As Built				
31/04/41	Schedule of Arch. treatment revised	WAG	142	288	
8/26/40	Stations changed	WAG	142	288	



PILASTER

LANDSIDE ELEVATION

RIVERSIDE ELEVATION SIMILAR EXCEPT
FOR HAUNCH AND LENGTH OF FLUTESSCALE: $\frac{1}{2}$ " = 1'-0"

NOTES:

- All concrete on this sheet to be Class "A".
Clean and roughen existing concrete to provide bond with new concrete.
For steel sheet piling see layouts of steel sheet piling. Sheets No. 77 to 82 incl.
Chamfer all exposed edges of concrete as indicated.
For additional architectural details see Sheets No. 29, 30 and 40.
Vertical construction joints in stem shall be spaced midway between expansion joints on all 40'-0" wall monoliths. See Sheet No. 72.

CONNECTICUT RIVER FLOOD CONTROL	
HARTFORD DIKE	
RIVERFRONT, MORGAN ST. TO STA. 96+73	
ARCHITECTURAL WALL DETAILS	
CONNECTICUT RIVER	CONNECTICUT
IN 135 SHEETS	SHEET NO. 69
SCALE: 1/2" = 1'-0"	
U.S. ENGINEER OFFICE, PROVIDENCE, R.I., MAY 1940	
SUBMITTED:	APPROVAL RECOMMENDED:
DESIGNED:	DRAWN: K.H.W.
CHECKED: WAG	FILE NO. CT-42529