
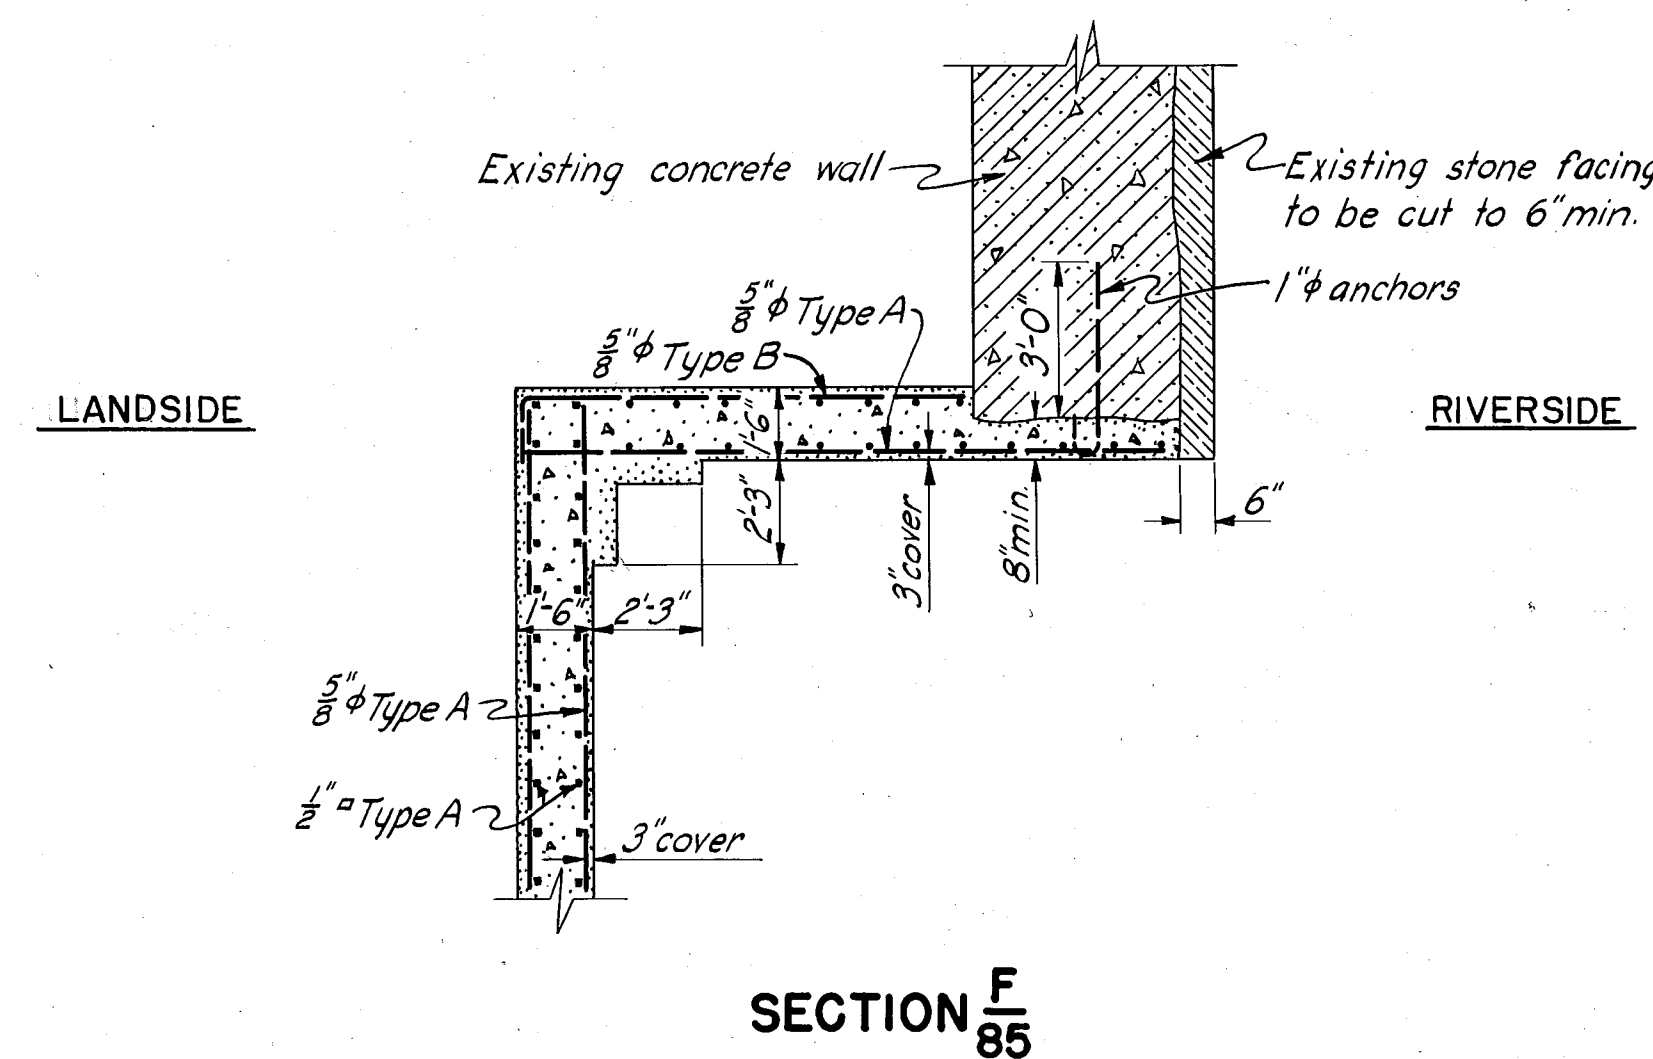
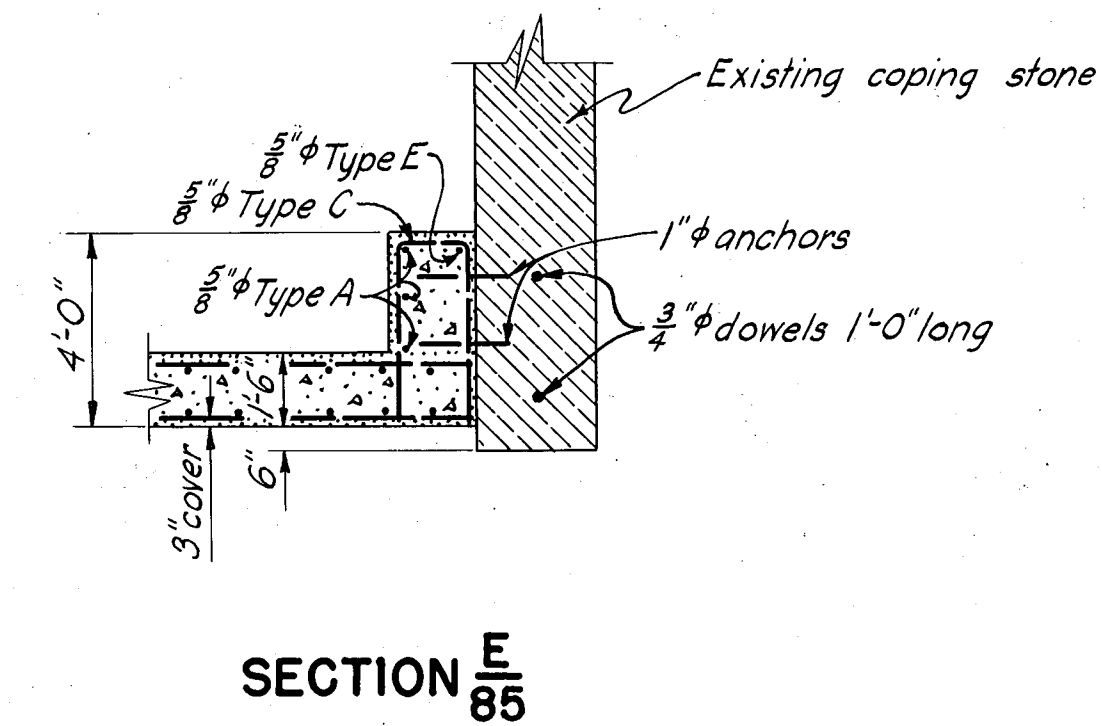
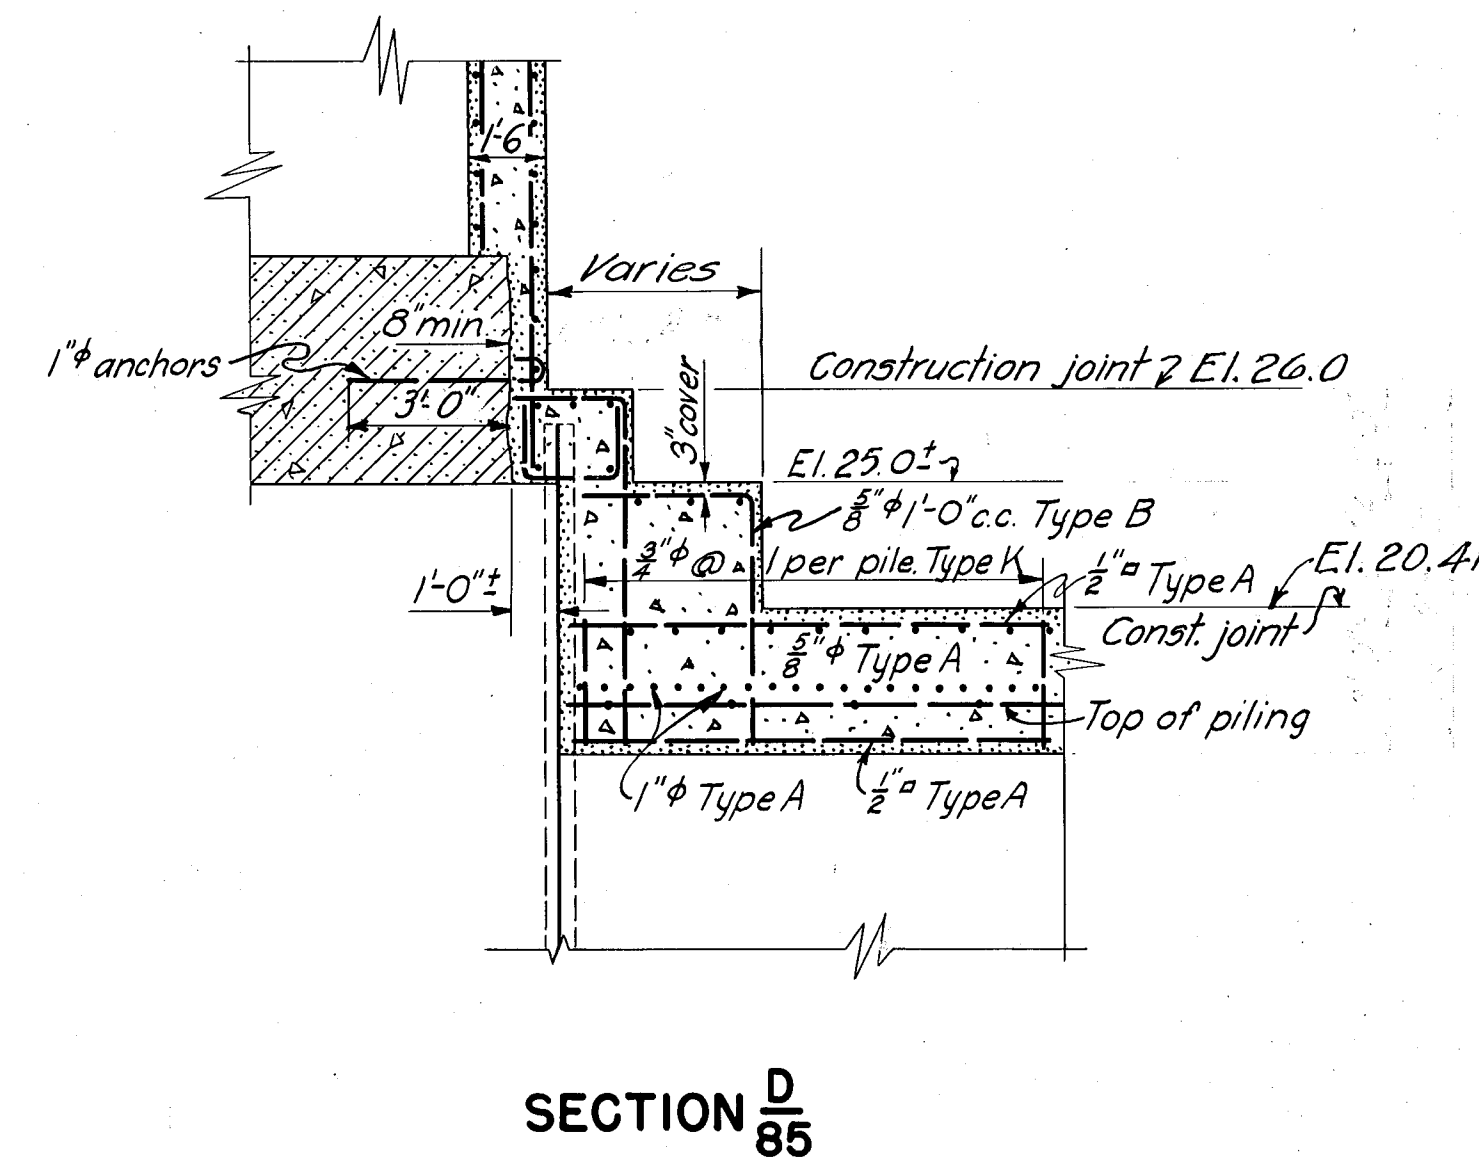


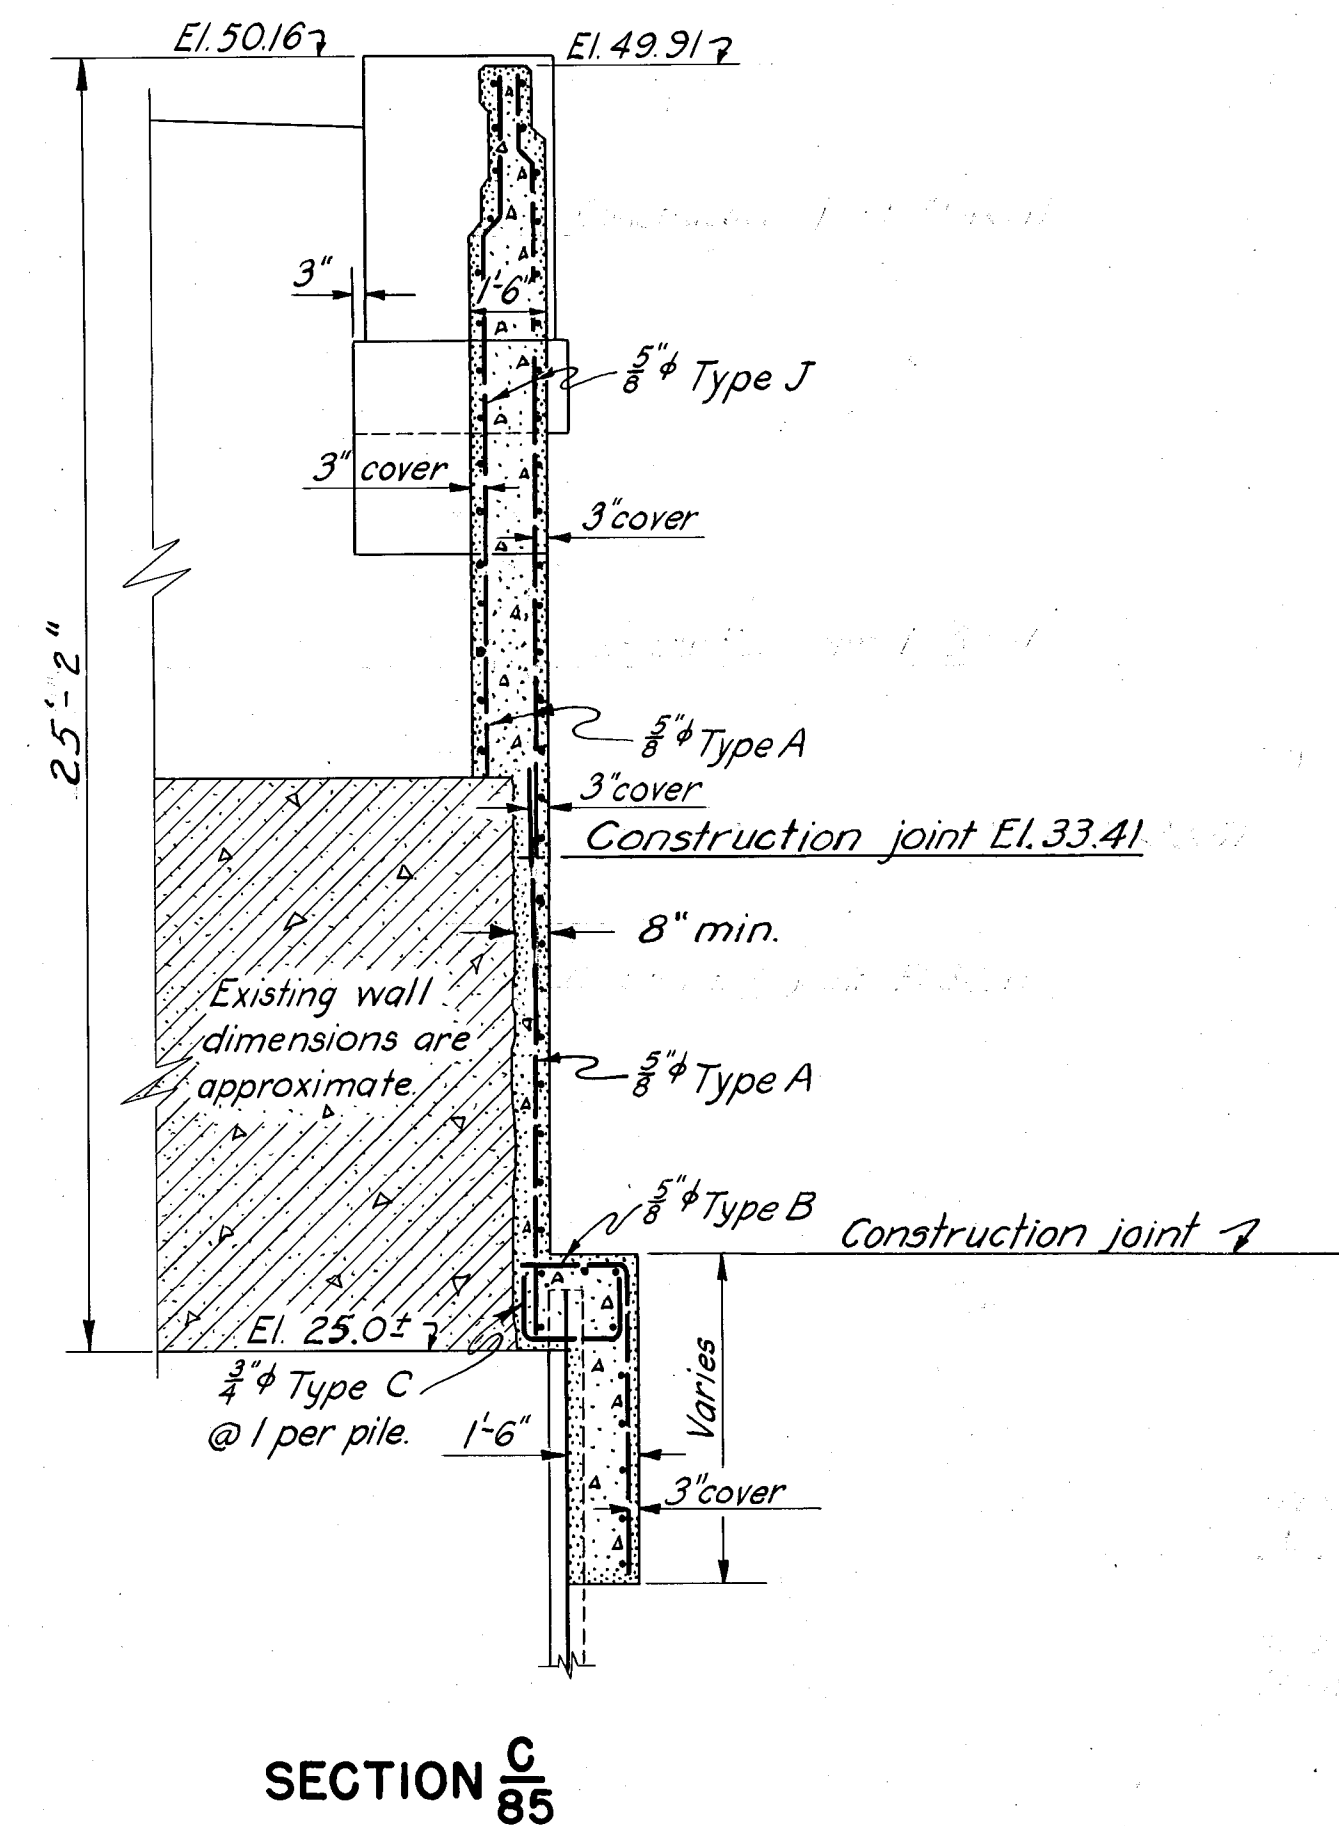

NOTES

For concrete details see Sheet No. 29.
For general notes see Sheet No. 85.

THIS SHEET SUPERSEDES SHEET NO. 86, FILE NO. CT-4-2546

CONNECTICUT RIVER FLOOD CONTROL			
HARTFORD DIKE			
RIVERFRONT, MORGAN ST. TO STA. 96+73.			
WALL - STA. 0+64.26 TO STA. 0+77.14			
STEEL REINFORCEMENT NO. 2			
CONNECTICUT RIVER		CONNECTICUT	
IN 135 SHEETS		SHEET NO. 86	
SCALE: 1/4 IN. = 1 FT.			
U.S. ENGINEER OFFICE, PROVIDENCE, R.I., AUG. 1940			
SUBMITTED:	APPROVAL:	RECOMMENDED:	APPROVED:
SENIOR ENGINEER	PRINCIPAL ENGINEER	CHIEF, F.C. ENGINEERING DIV.	DISTRICT ENGINEER
DESIGNED:	DRAWN:	TRACED:	CHECKED:
ASSOC. ENGINEER	L.V.P.	H.G.L. & J.J.B.	W.S.V.
FISCAL YEAR 1940			FILE NO. CT-4-2671

KEY	DATE	REVISION (Indicated by Δ)	REV. BY	CK. BY	AP. BY
	12-31-45	As built revisions			