
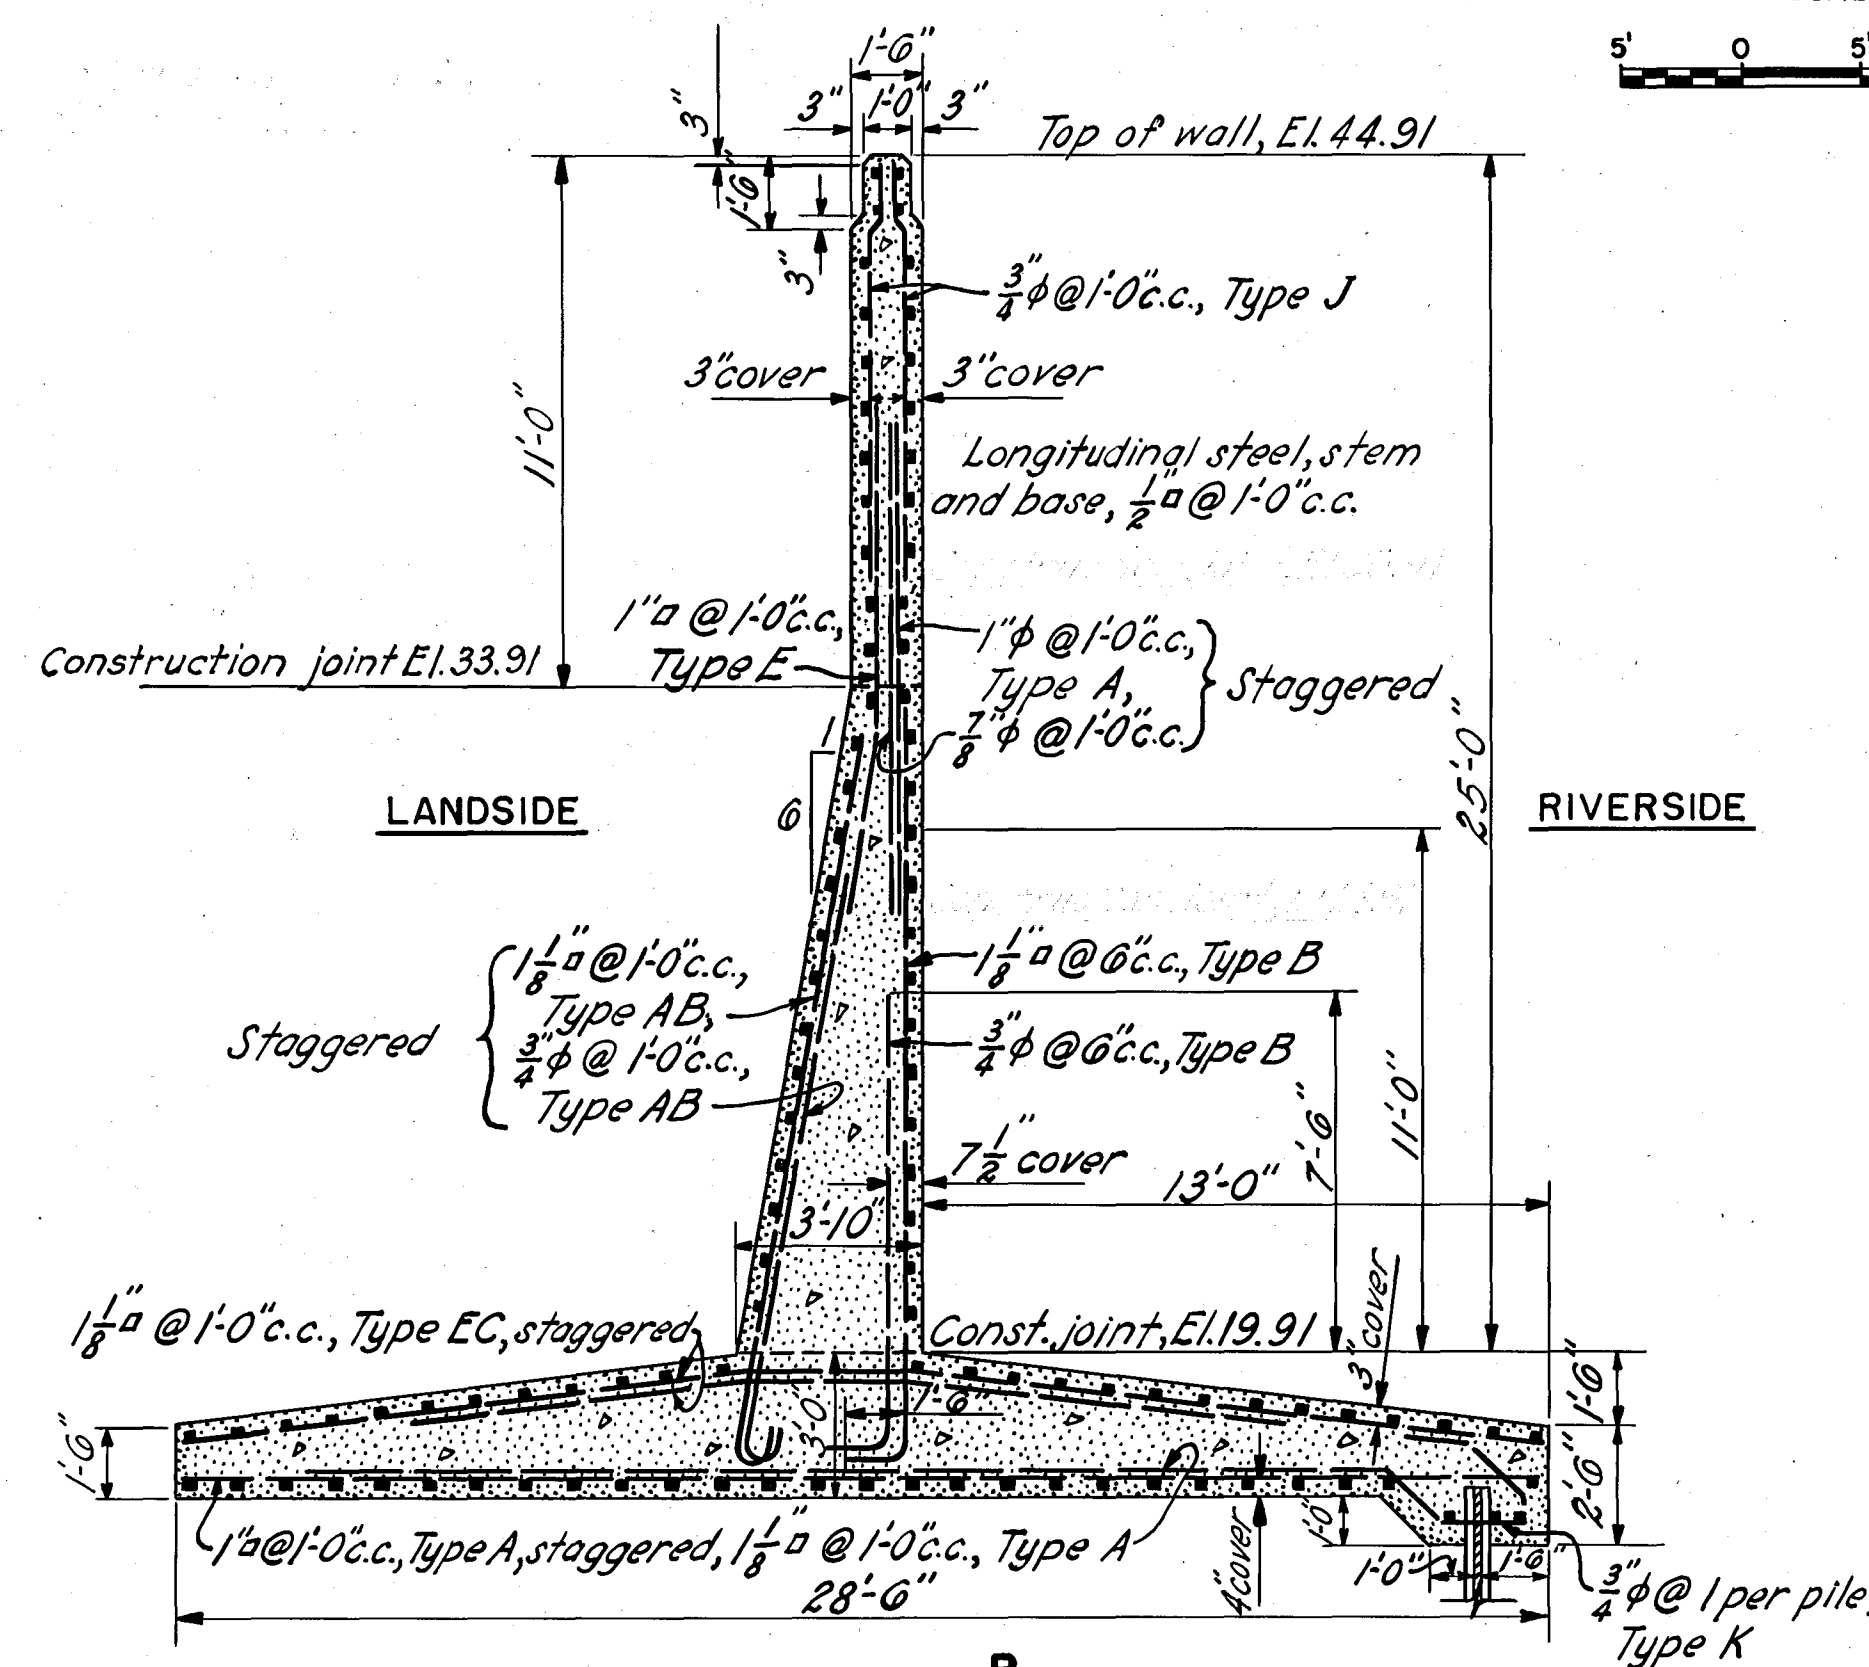
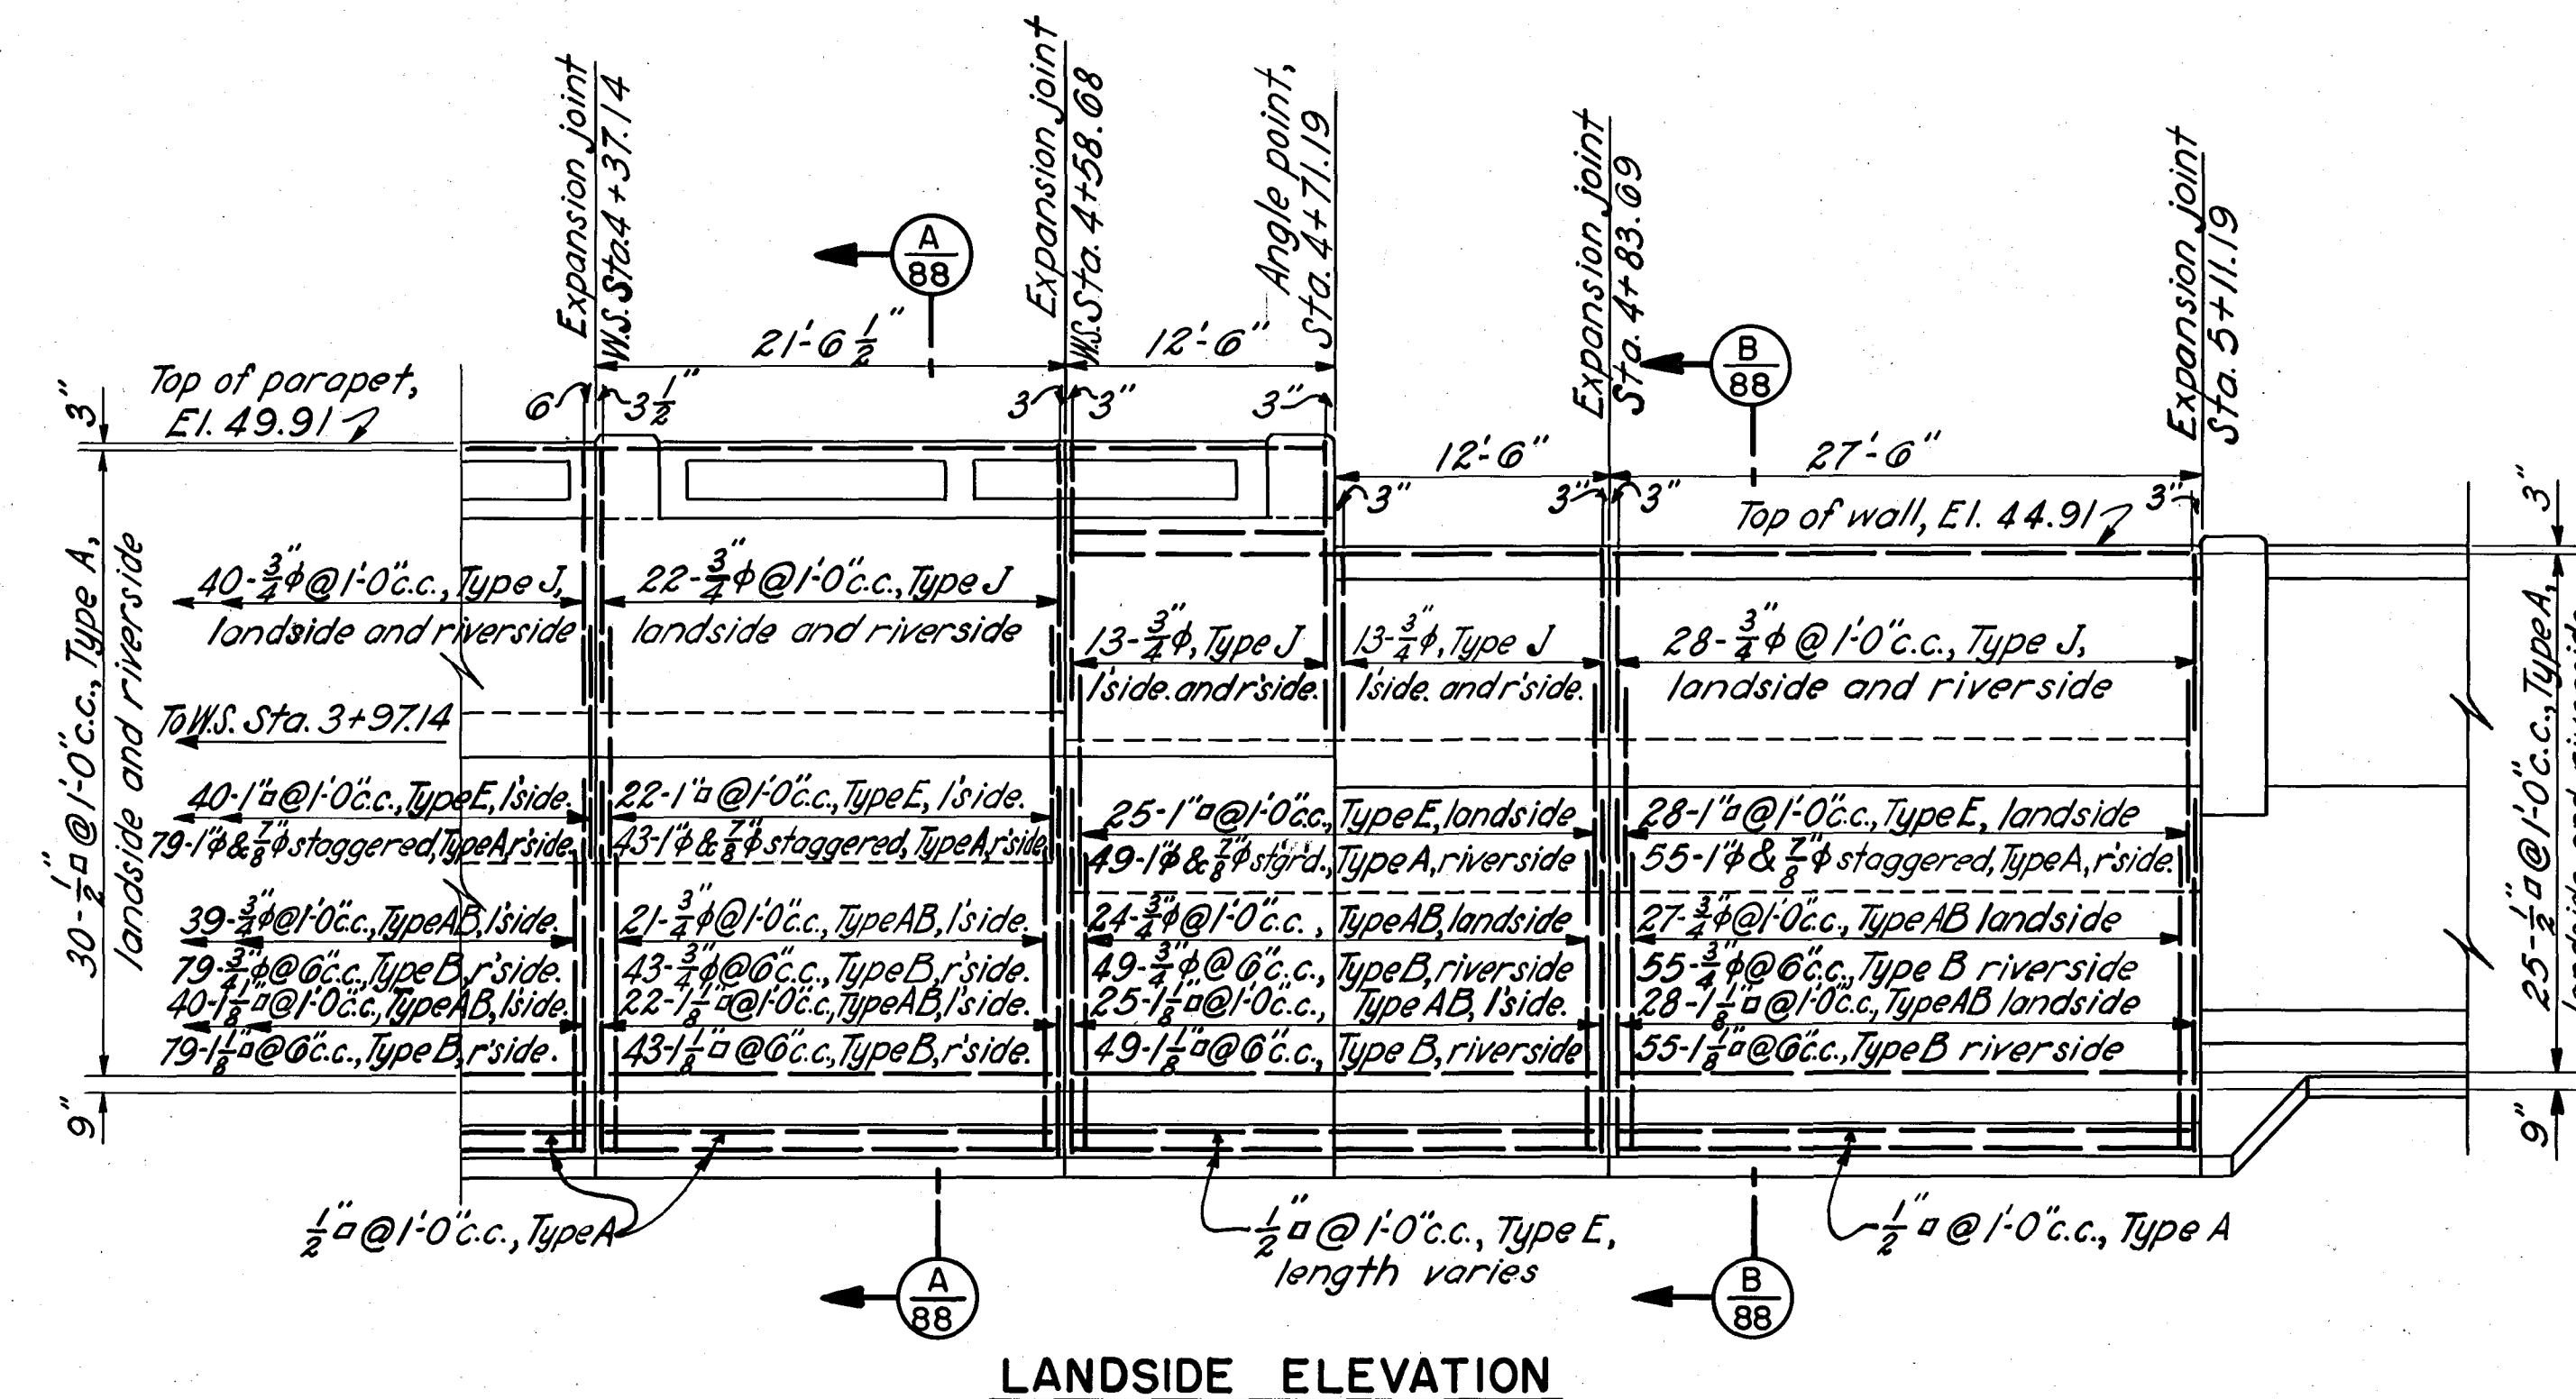
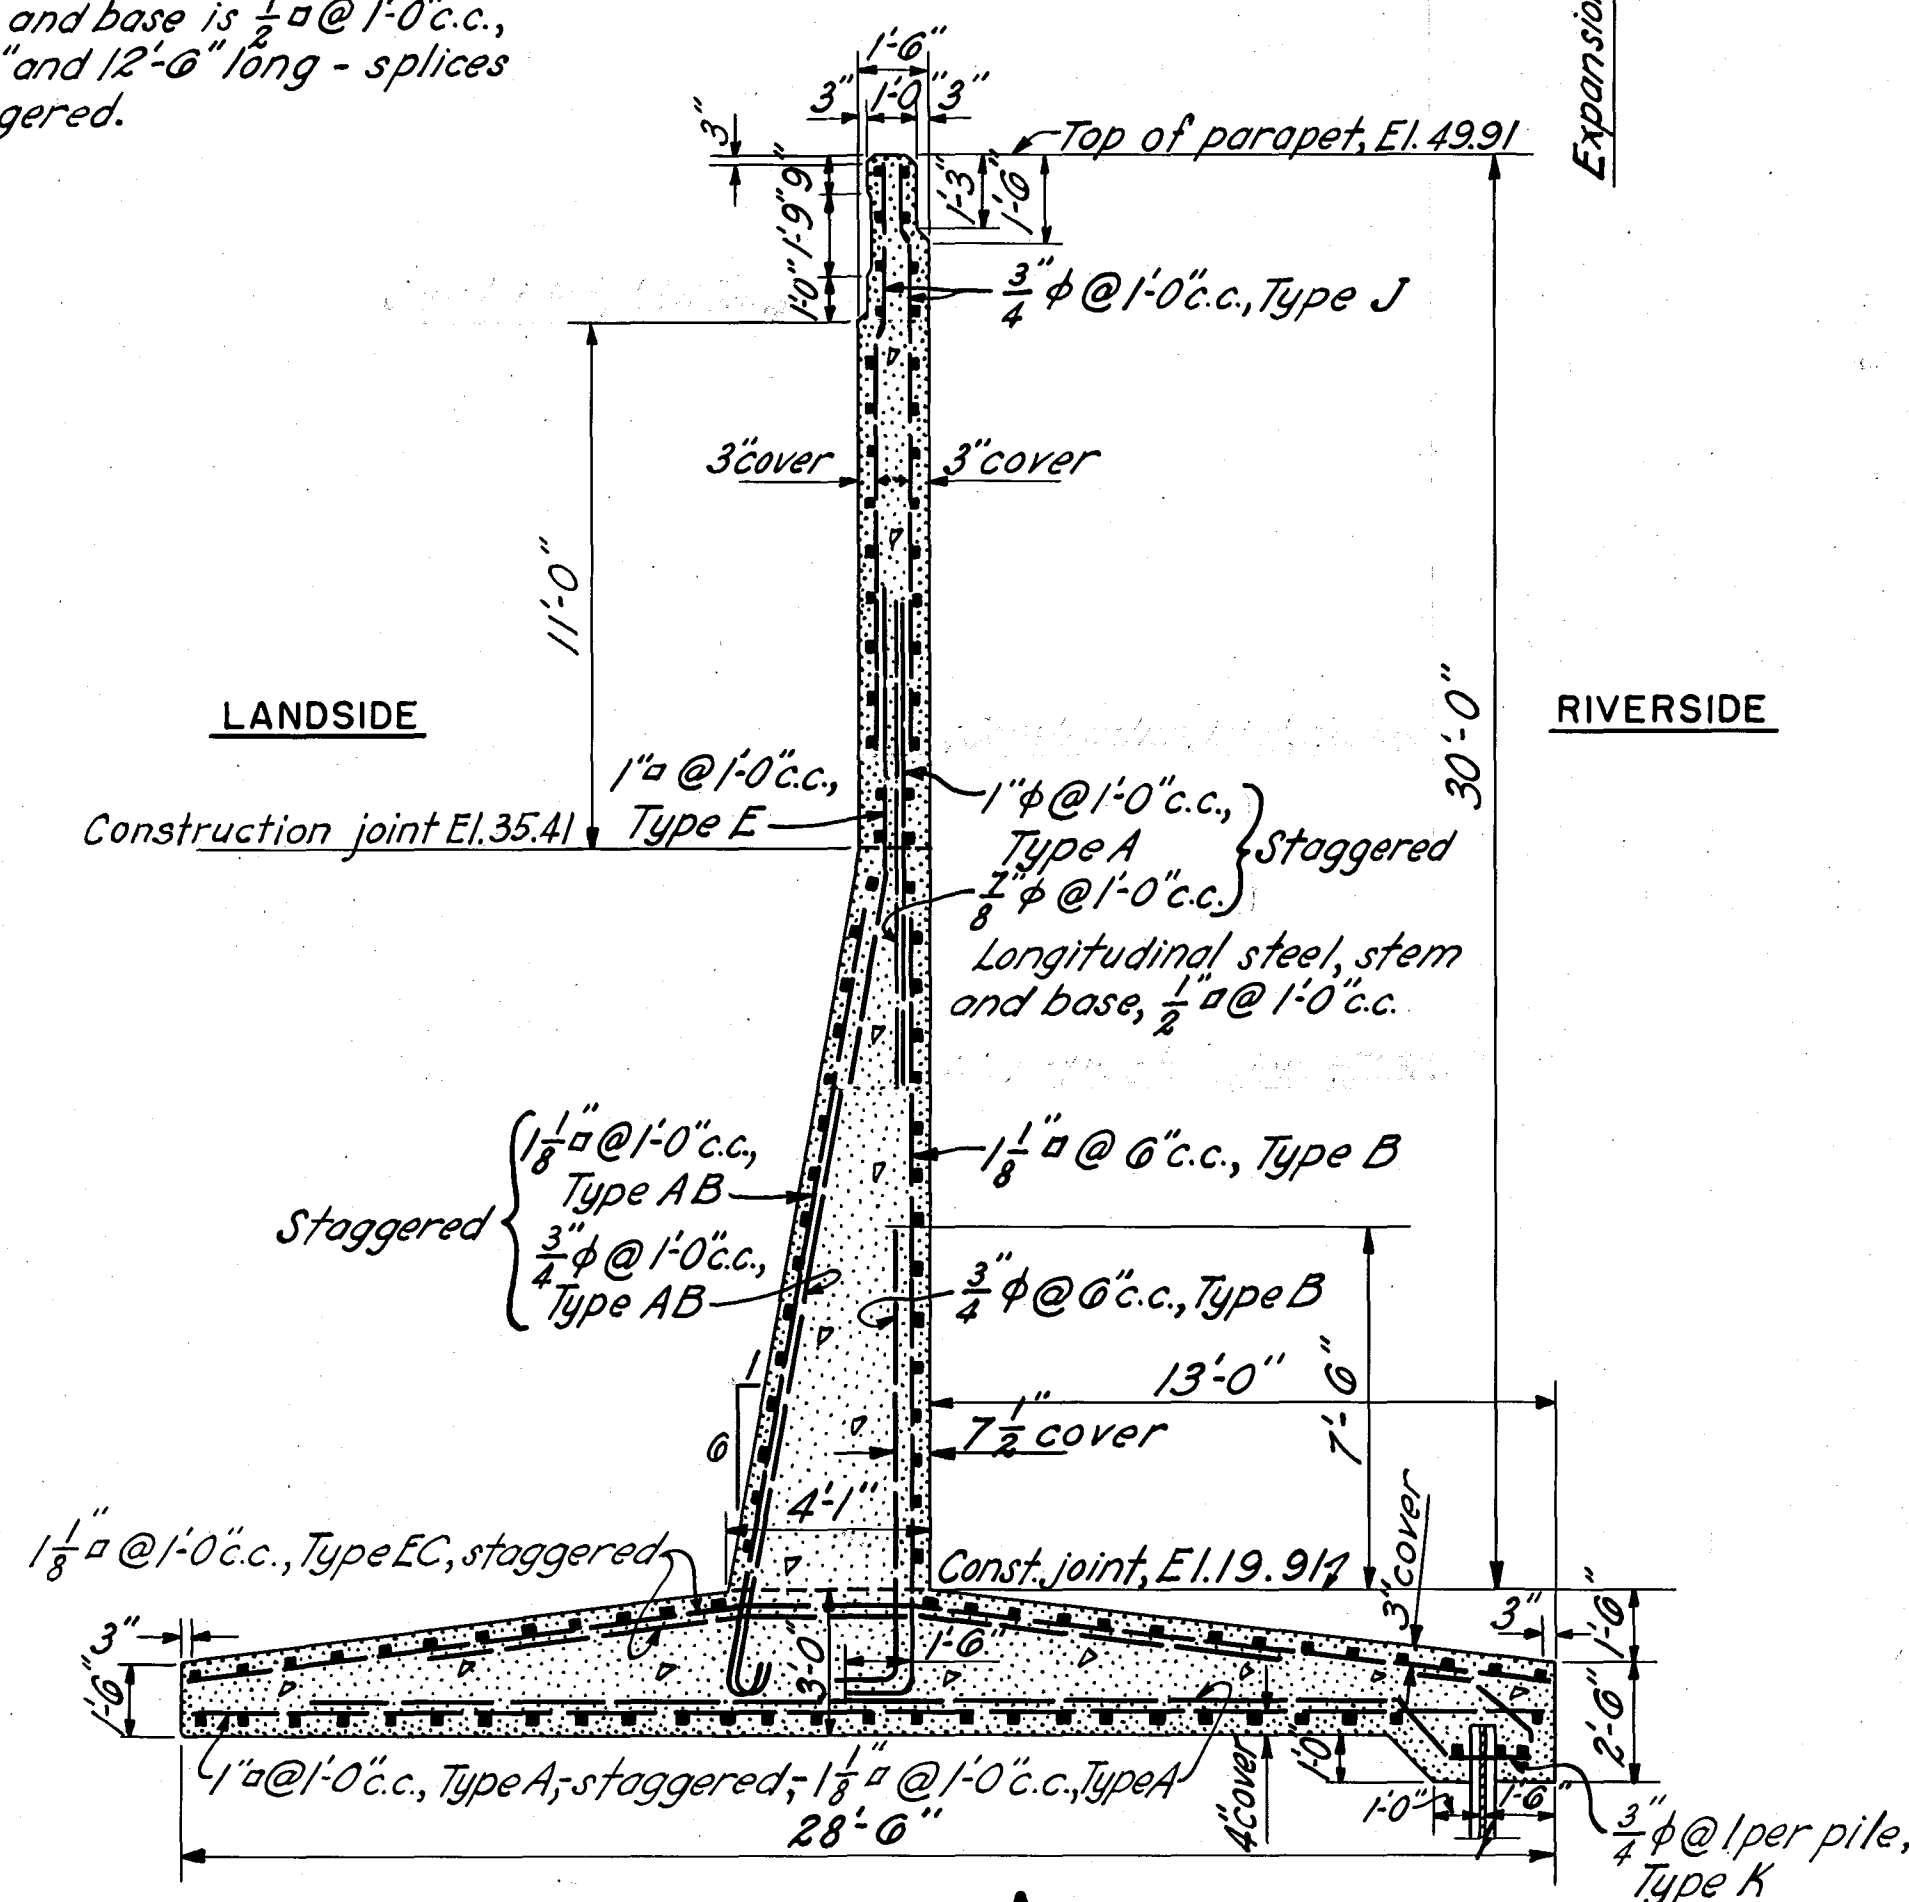


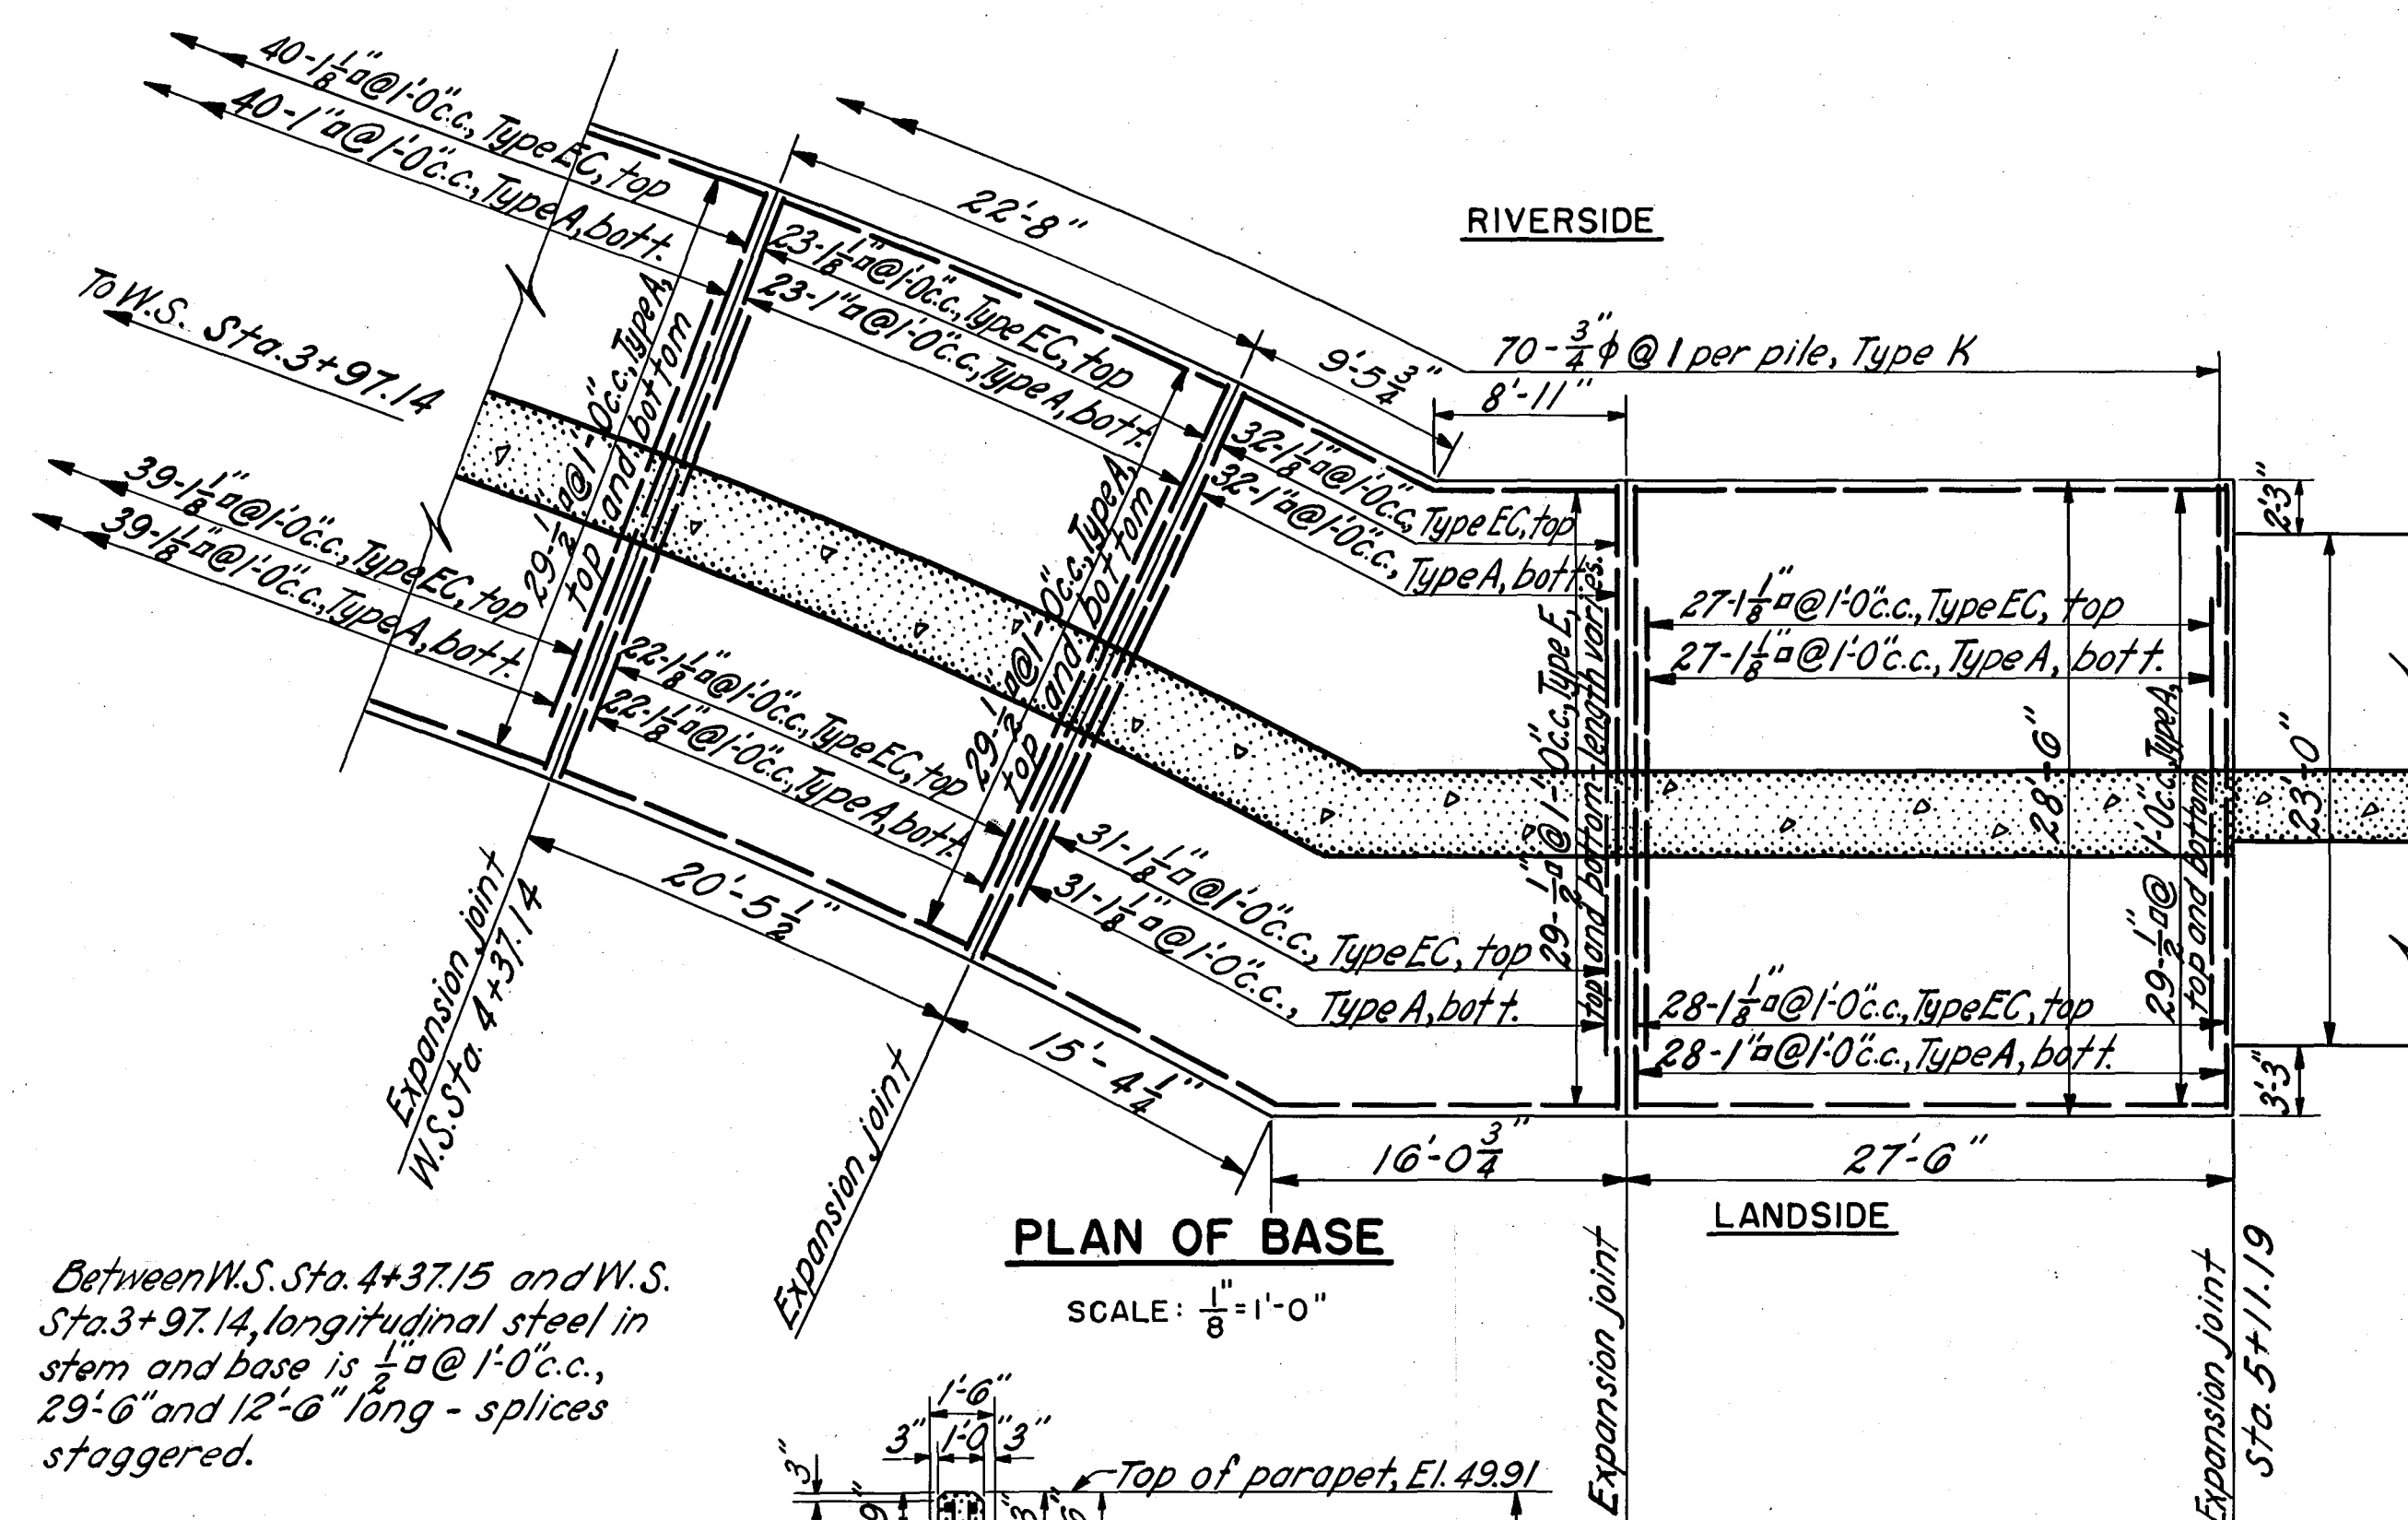

NOTES

- For concrete details, see Sheet No. 31.
The minimum cover for main steel reinforcement is 3" except where concrete is poured against earth in which case it is 4".
Bar splices are equal in length to forty diameters of the smaller bar.
Radius of bend of bars is equal to four diameters of the bar.
Payment for furnishing, bending, and placing of steel reinforcement was made under Item No. 25 Stationing from Sta. 0+11.57 to Sta. 4+71.19 is along west face of wall and is denoted by letters "W.S."

CONNECTICUT RIVER FLOOD CONTROL			
HARTFORD DIKE			
RIVERFRONT, MORGAN ST. TO STA. 96+73			
WALL-STA. 3+97.14 TO STA. 5+11.19			
STEEL REINFORCEMENT			
CONNECTICUT RIVER	CONNECTICUT	IN 135 SHEETS	
SCALE: 1/4" = 1'-0"		SHEET NO. 88	
U.S. ENGINEER OFFICE, PROVIDENCE, R.I., MAY 1940			
SUBMITTED:	APPROVAL:	RECOMMENDED:	APPROVED:
DESIGNED:	CHIEF, E.C. ENGINEERING DIV.	PRINCIPAL ENGINEER	LT. COL., CORPS OF ENGINEERS
TRACED:	P.V.S.	FISCAL YEAR 1940	FILE NO. CT-4-2548

KEY	DATE	REVISION (Indicated by Δ)	REV. BY	CK. BY	AP. BY
	12-31-45	As built revisions			