



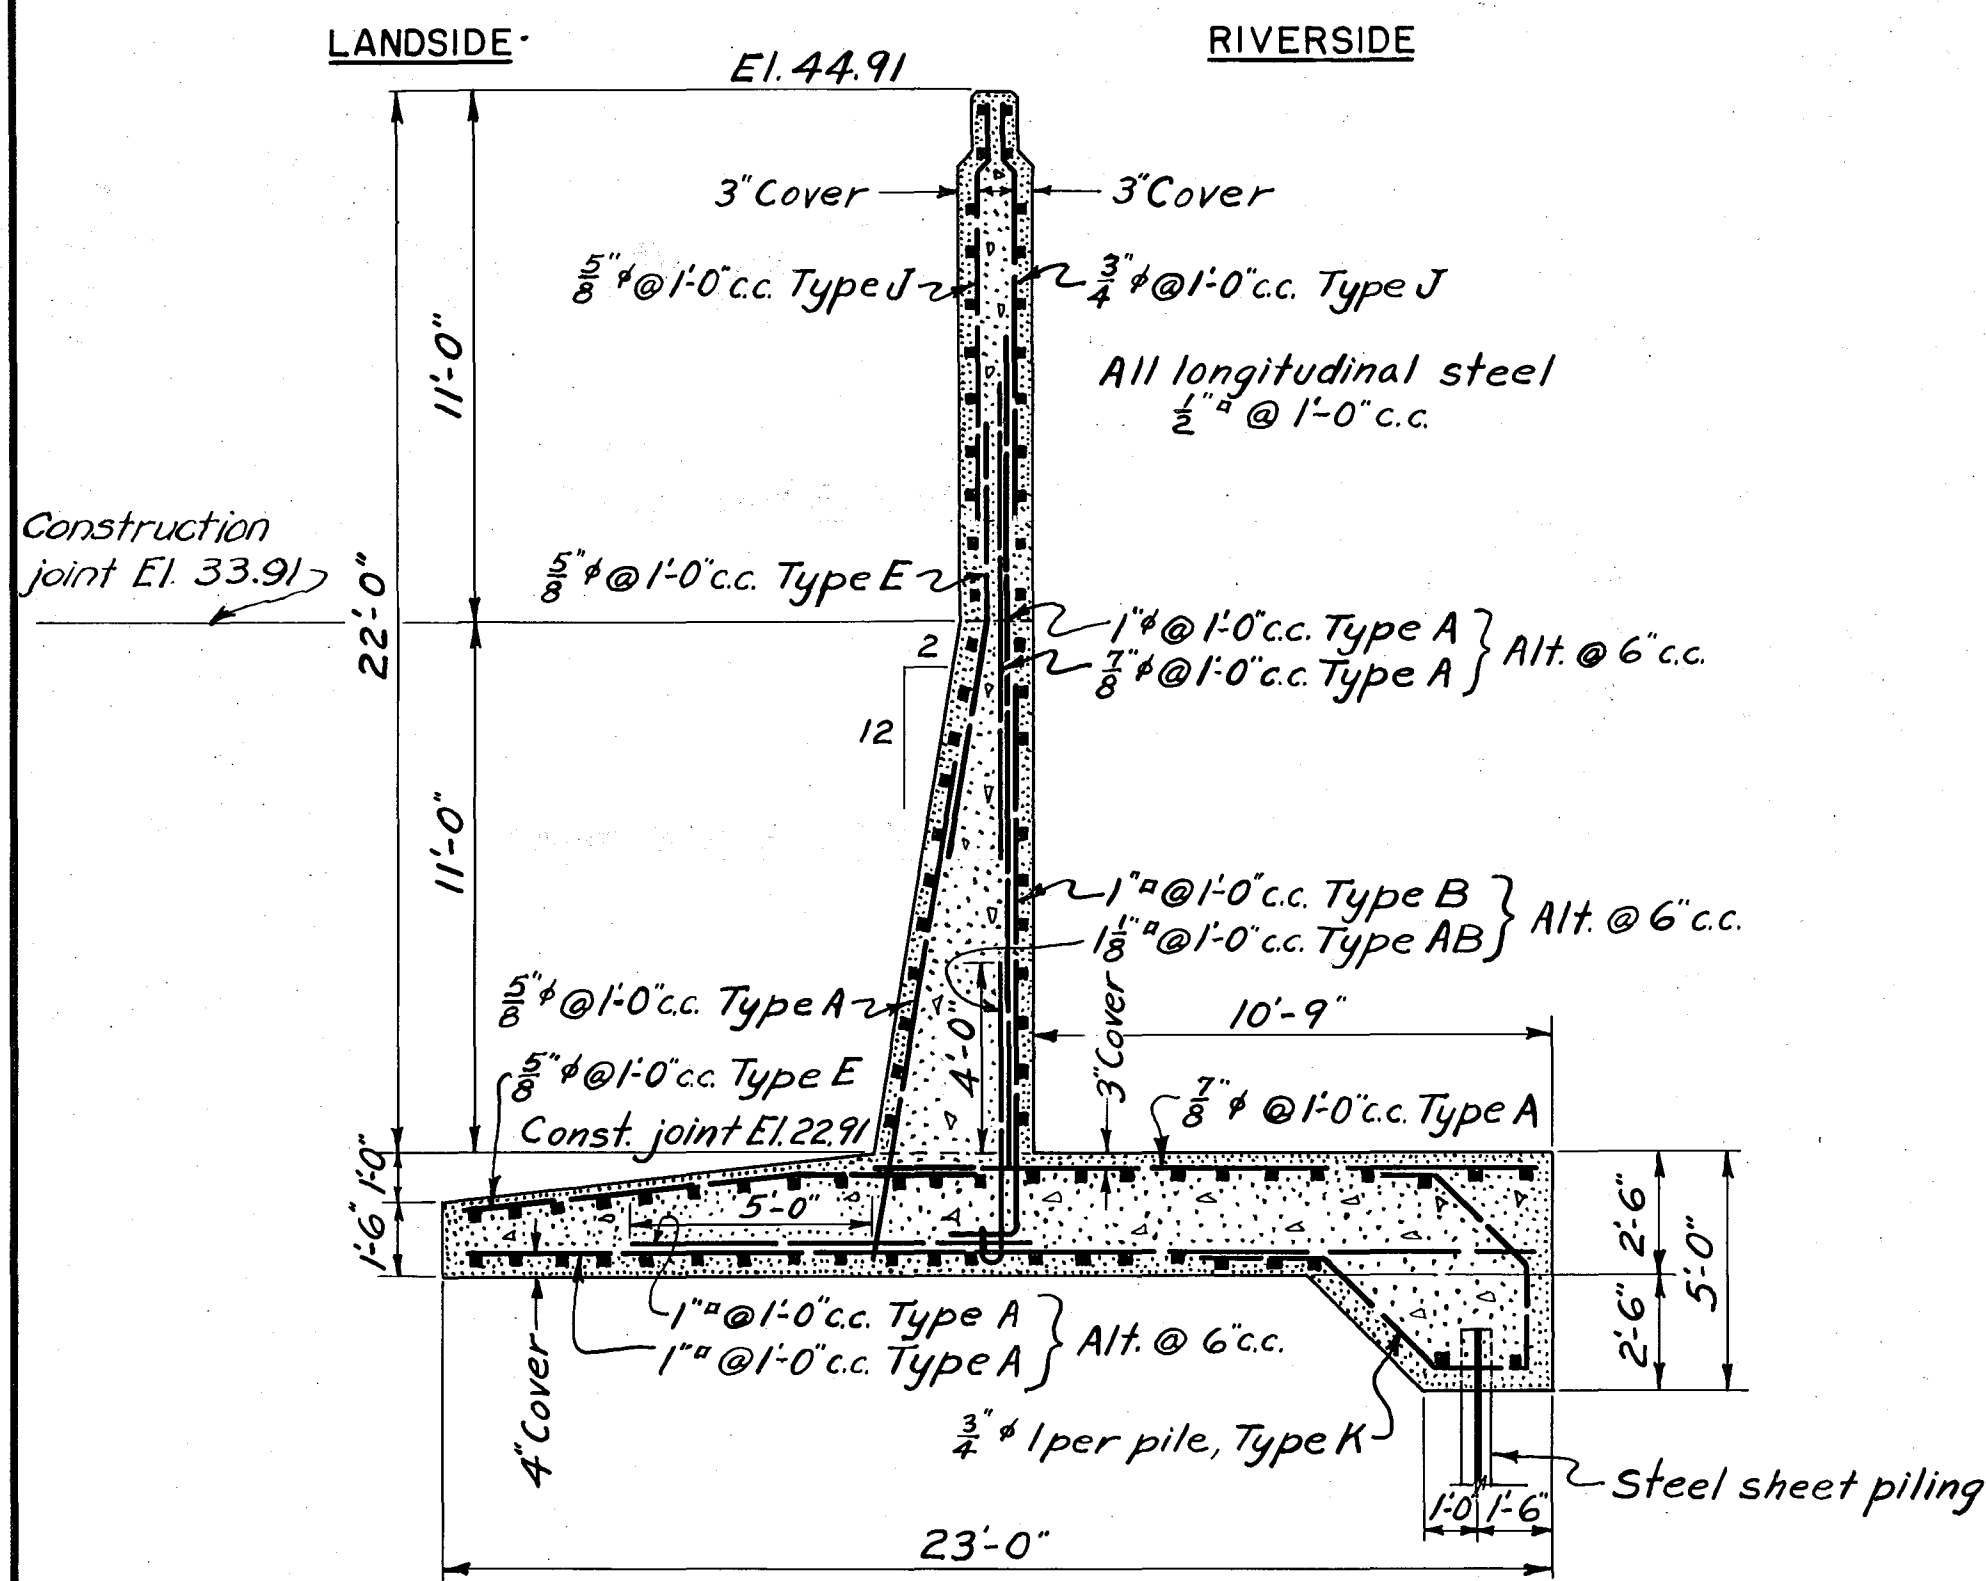


22'-0" WALL

STA. 5 + 11.19 TO STA. 7 + 91.19

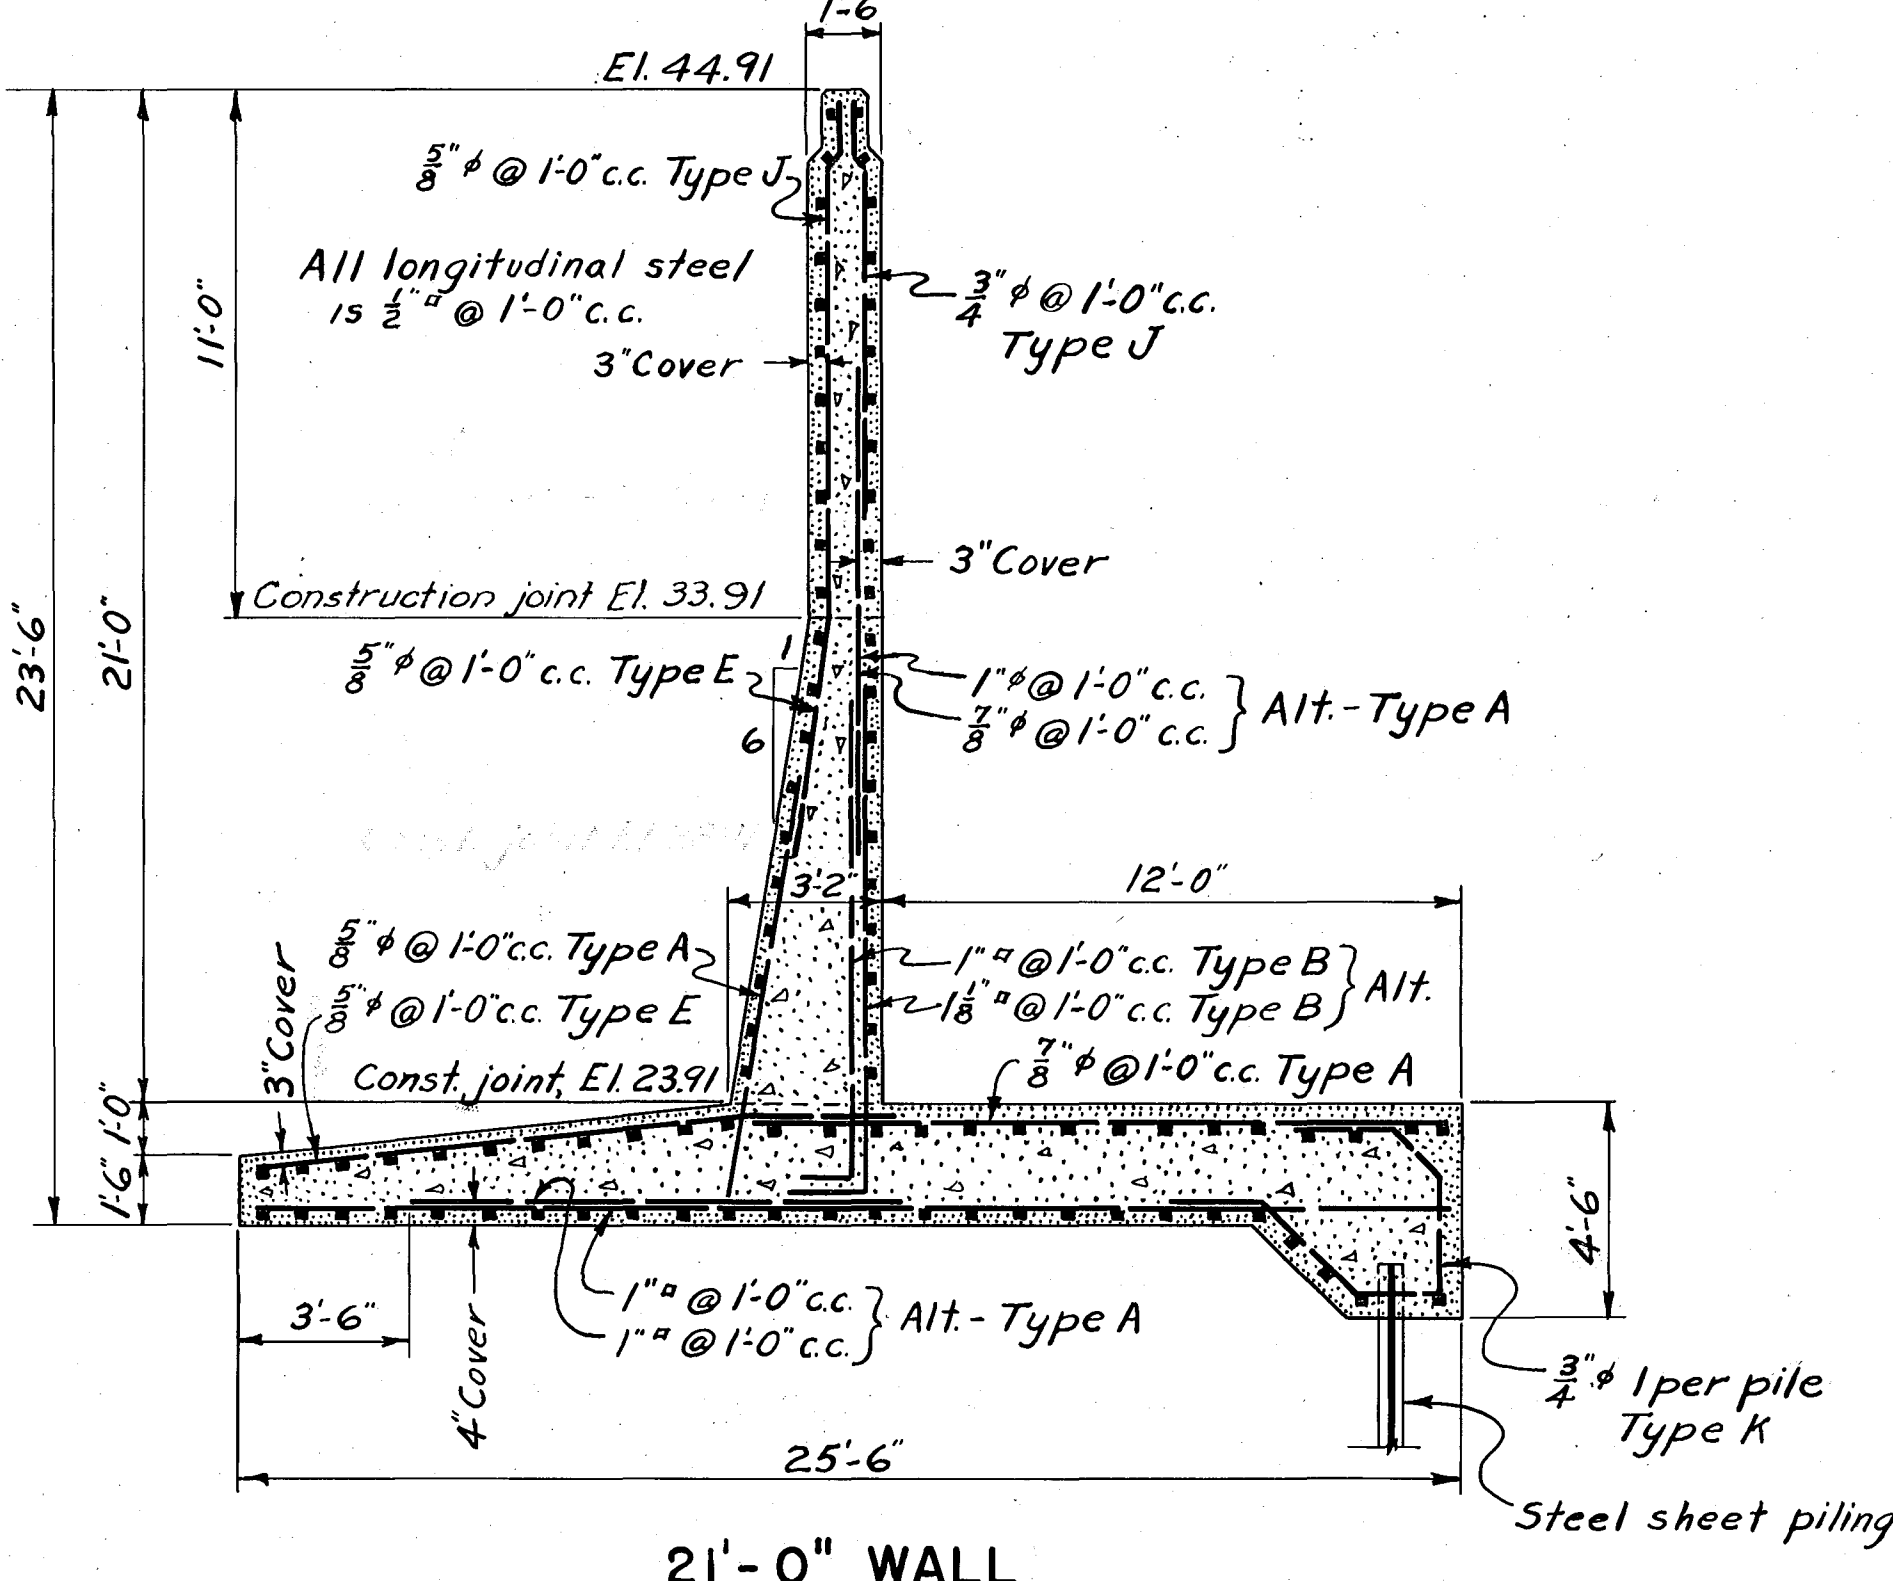


21'-0" WALL

STA. 7 + 91.19 TO STA. 9 + 11.19

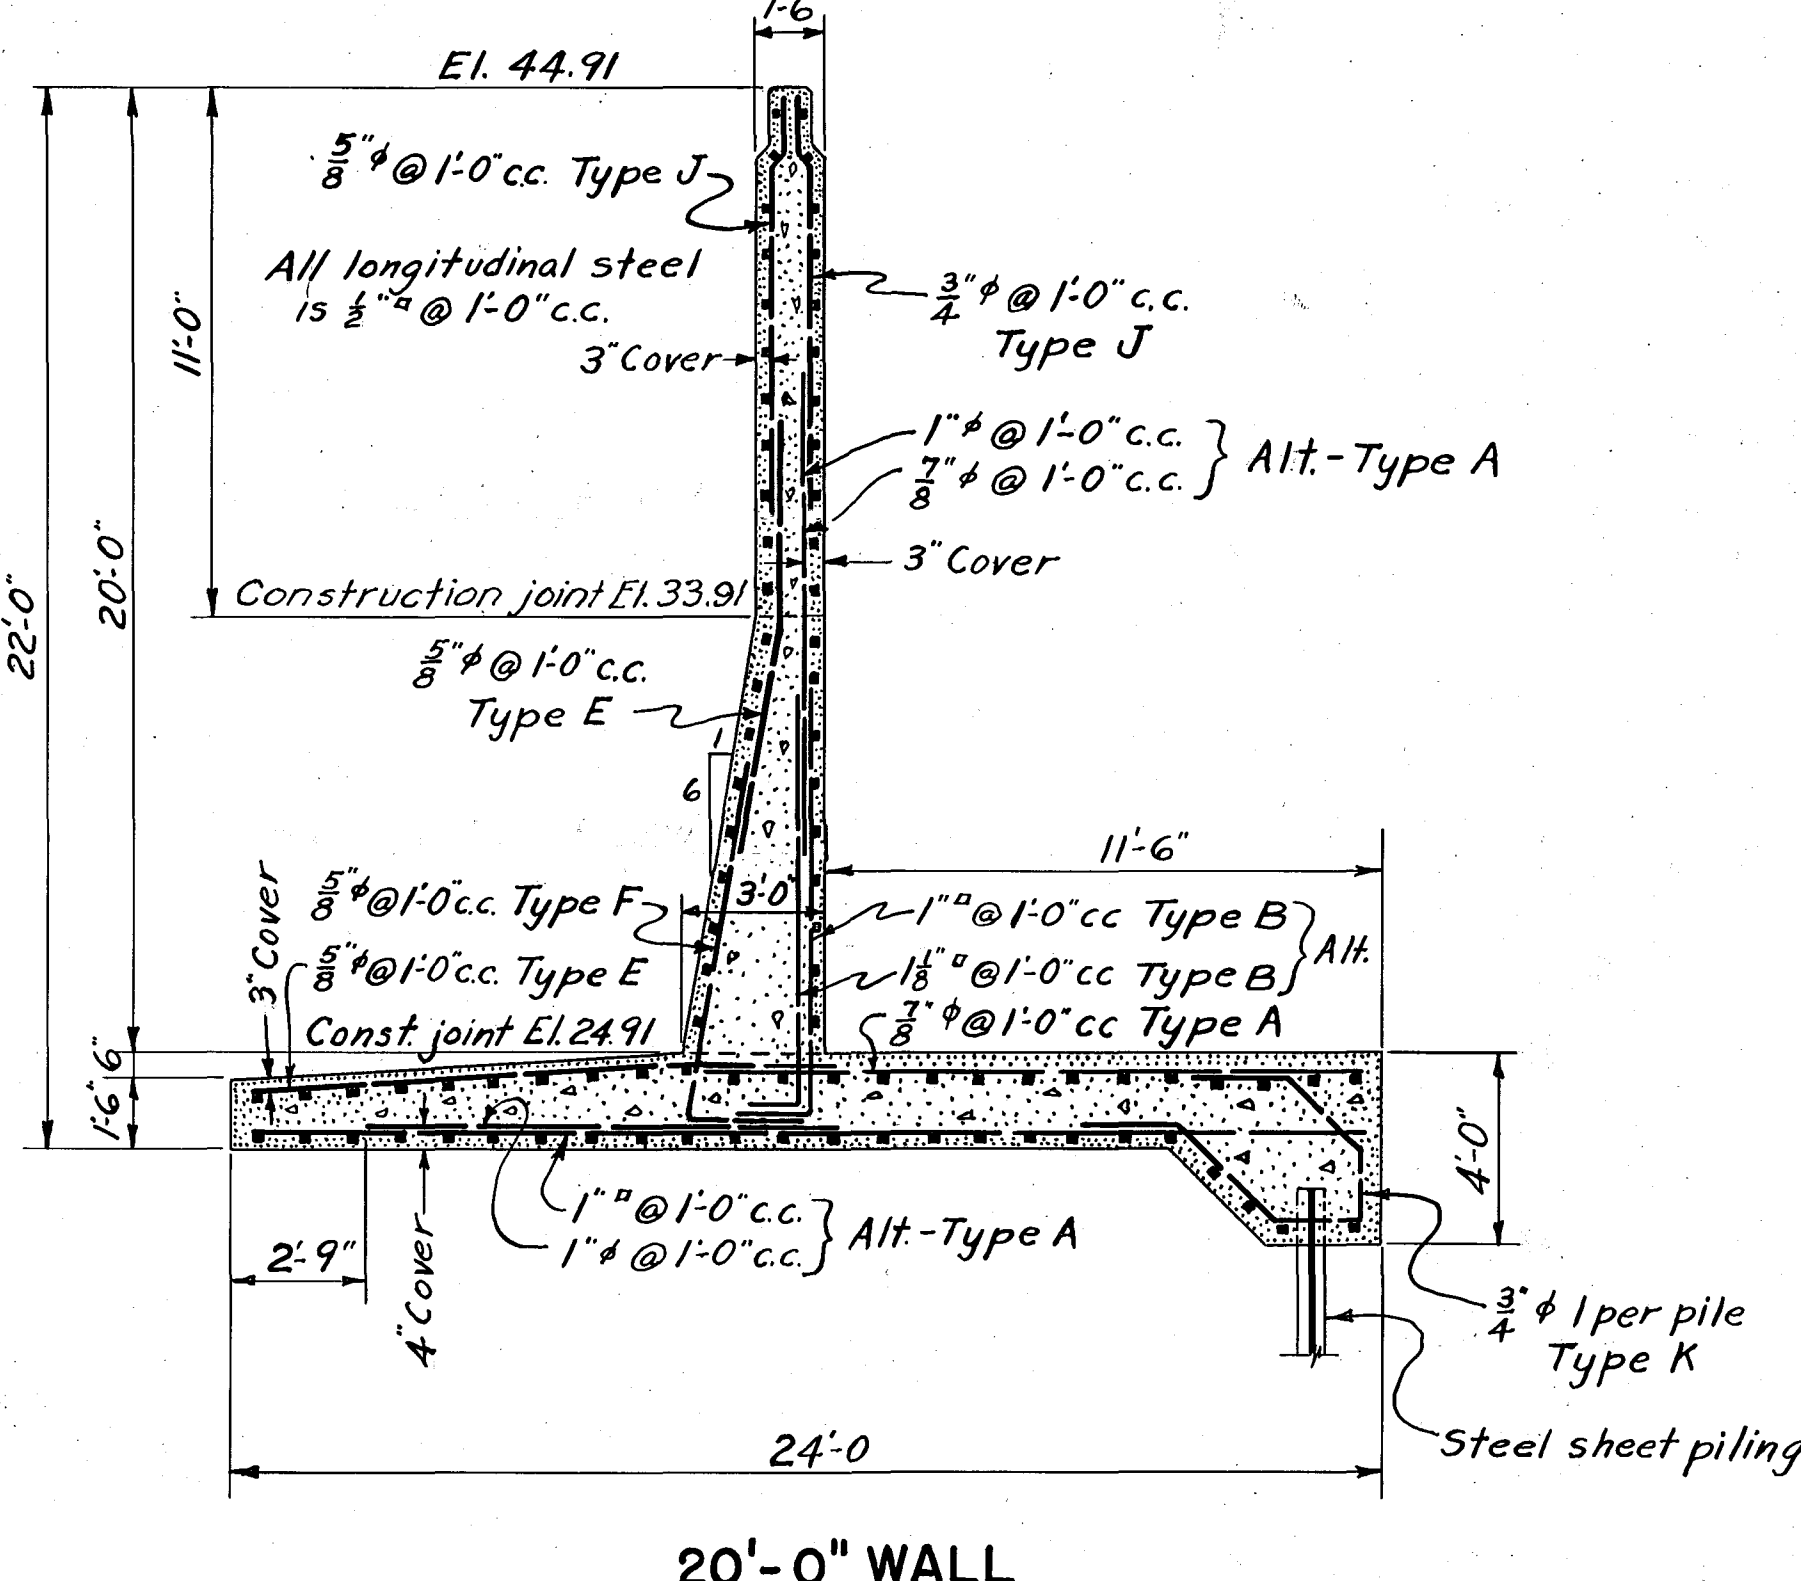

20'-0" WALL

STA. 9 + 11.19 TO STA. 9 + 91.19

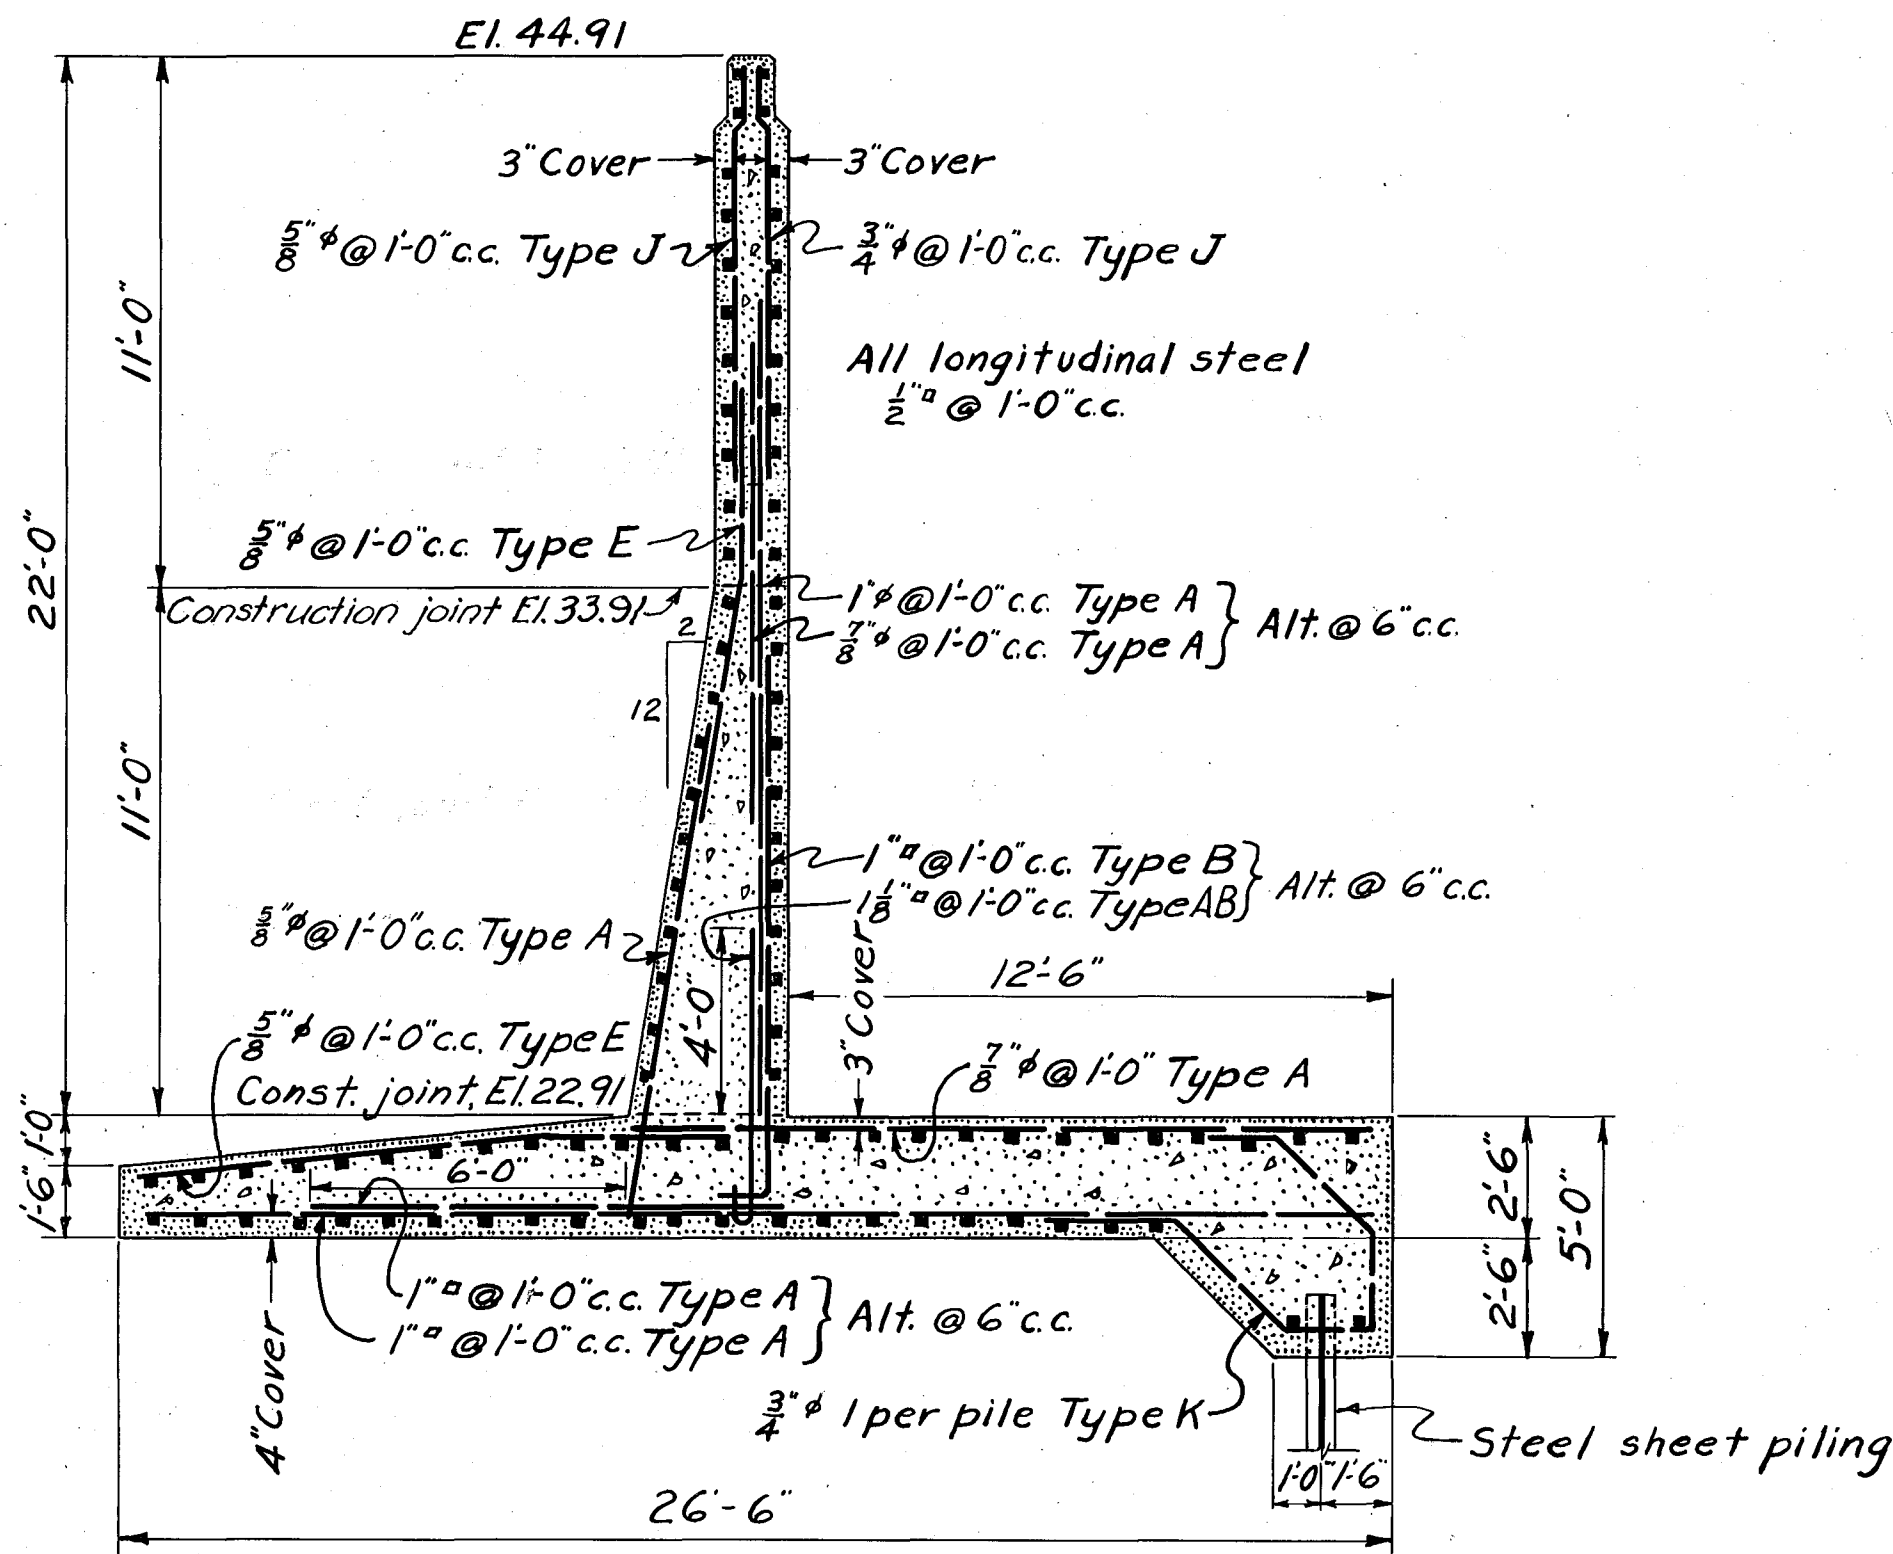

22'-0" WALL

STA. 9 + 91.19 TO STA. 10 + 31.19

NOTES

- For concrete details see Sheet No. 70.
- For bar type schedule see Sheet No. 85.
- The minimum cover for main steel reinforcement is 3" except where concrete is poured against earth, in which case it is 4".
- Bar splices are equal in length to 40 diameters of the smaller bar.
- Radius of bend of bars are equal to 4 diameters of the bar.
- Payment for furnishing, bending, and placing of steel reinforcement was made under Item No. 25.

CONNECTICUT RIVER FLOOD CONTROL
HARTFORD DIKE
RIVERFRONT, MORGAN ST. TO STA. 96+73
WALL- STA. 5 + 11.19 TO STA. 10+31.19
STEEL REINFORCEMENT

CONNECTICUT RIVER IN 135 SHEETS SCALE: 1/4 IN. = 1 FT. SHEET NO. 89

U.S. ENGINEER OFFICE, PROVIDENCE, R.I., MAY 1940

SUBMITTED: APPROVAL: RECOMMENDED: APPROVED:
SENIOR ENGINEER PRINCIPAL ENGINEER LT. COL. CORPS OF ENGINEERS
HEAD, DESIGN SECTION CHIEF, F.C. ENGINEERING DIV. DISTRICT ENGINEER
DESIGNED: DRAWN: U.M.S. & J.A.C. FISCAL YEAR 1940
ASSOC. ENGINEER CHECKED: W.H.T. FILE NO. CT-4-2549

KEY	DATE	REVISION (Indicated by Δ)	REV. BY	CK. BY	AP. BY
	12-31-45	As built revisions			